


FED. ROAD DIST. NO	STATE	FEDERAL AID PROJ. NO.	FISCAL YEAR	SHEET NO.	TOTAL SHEETS
HAWAII	HAW.	ER-14(1)	2006	27	34

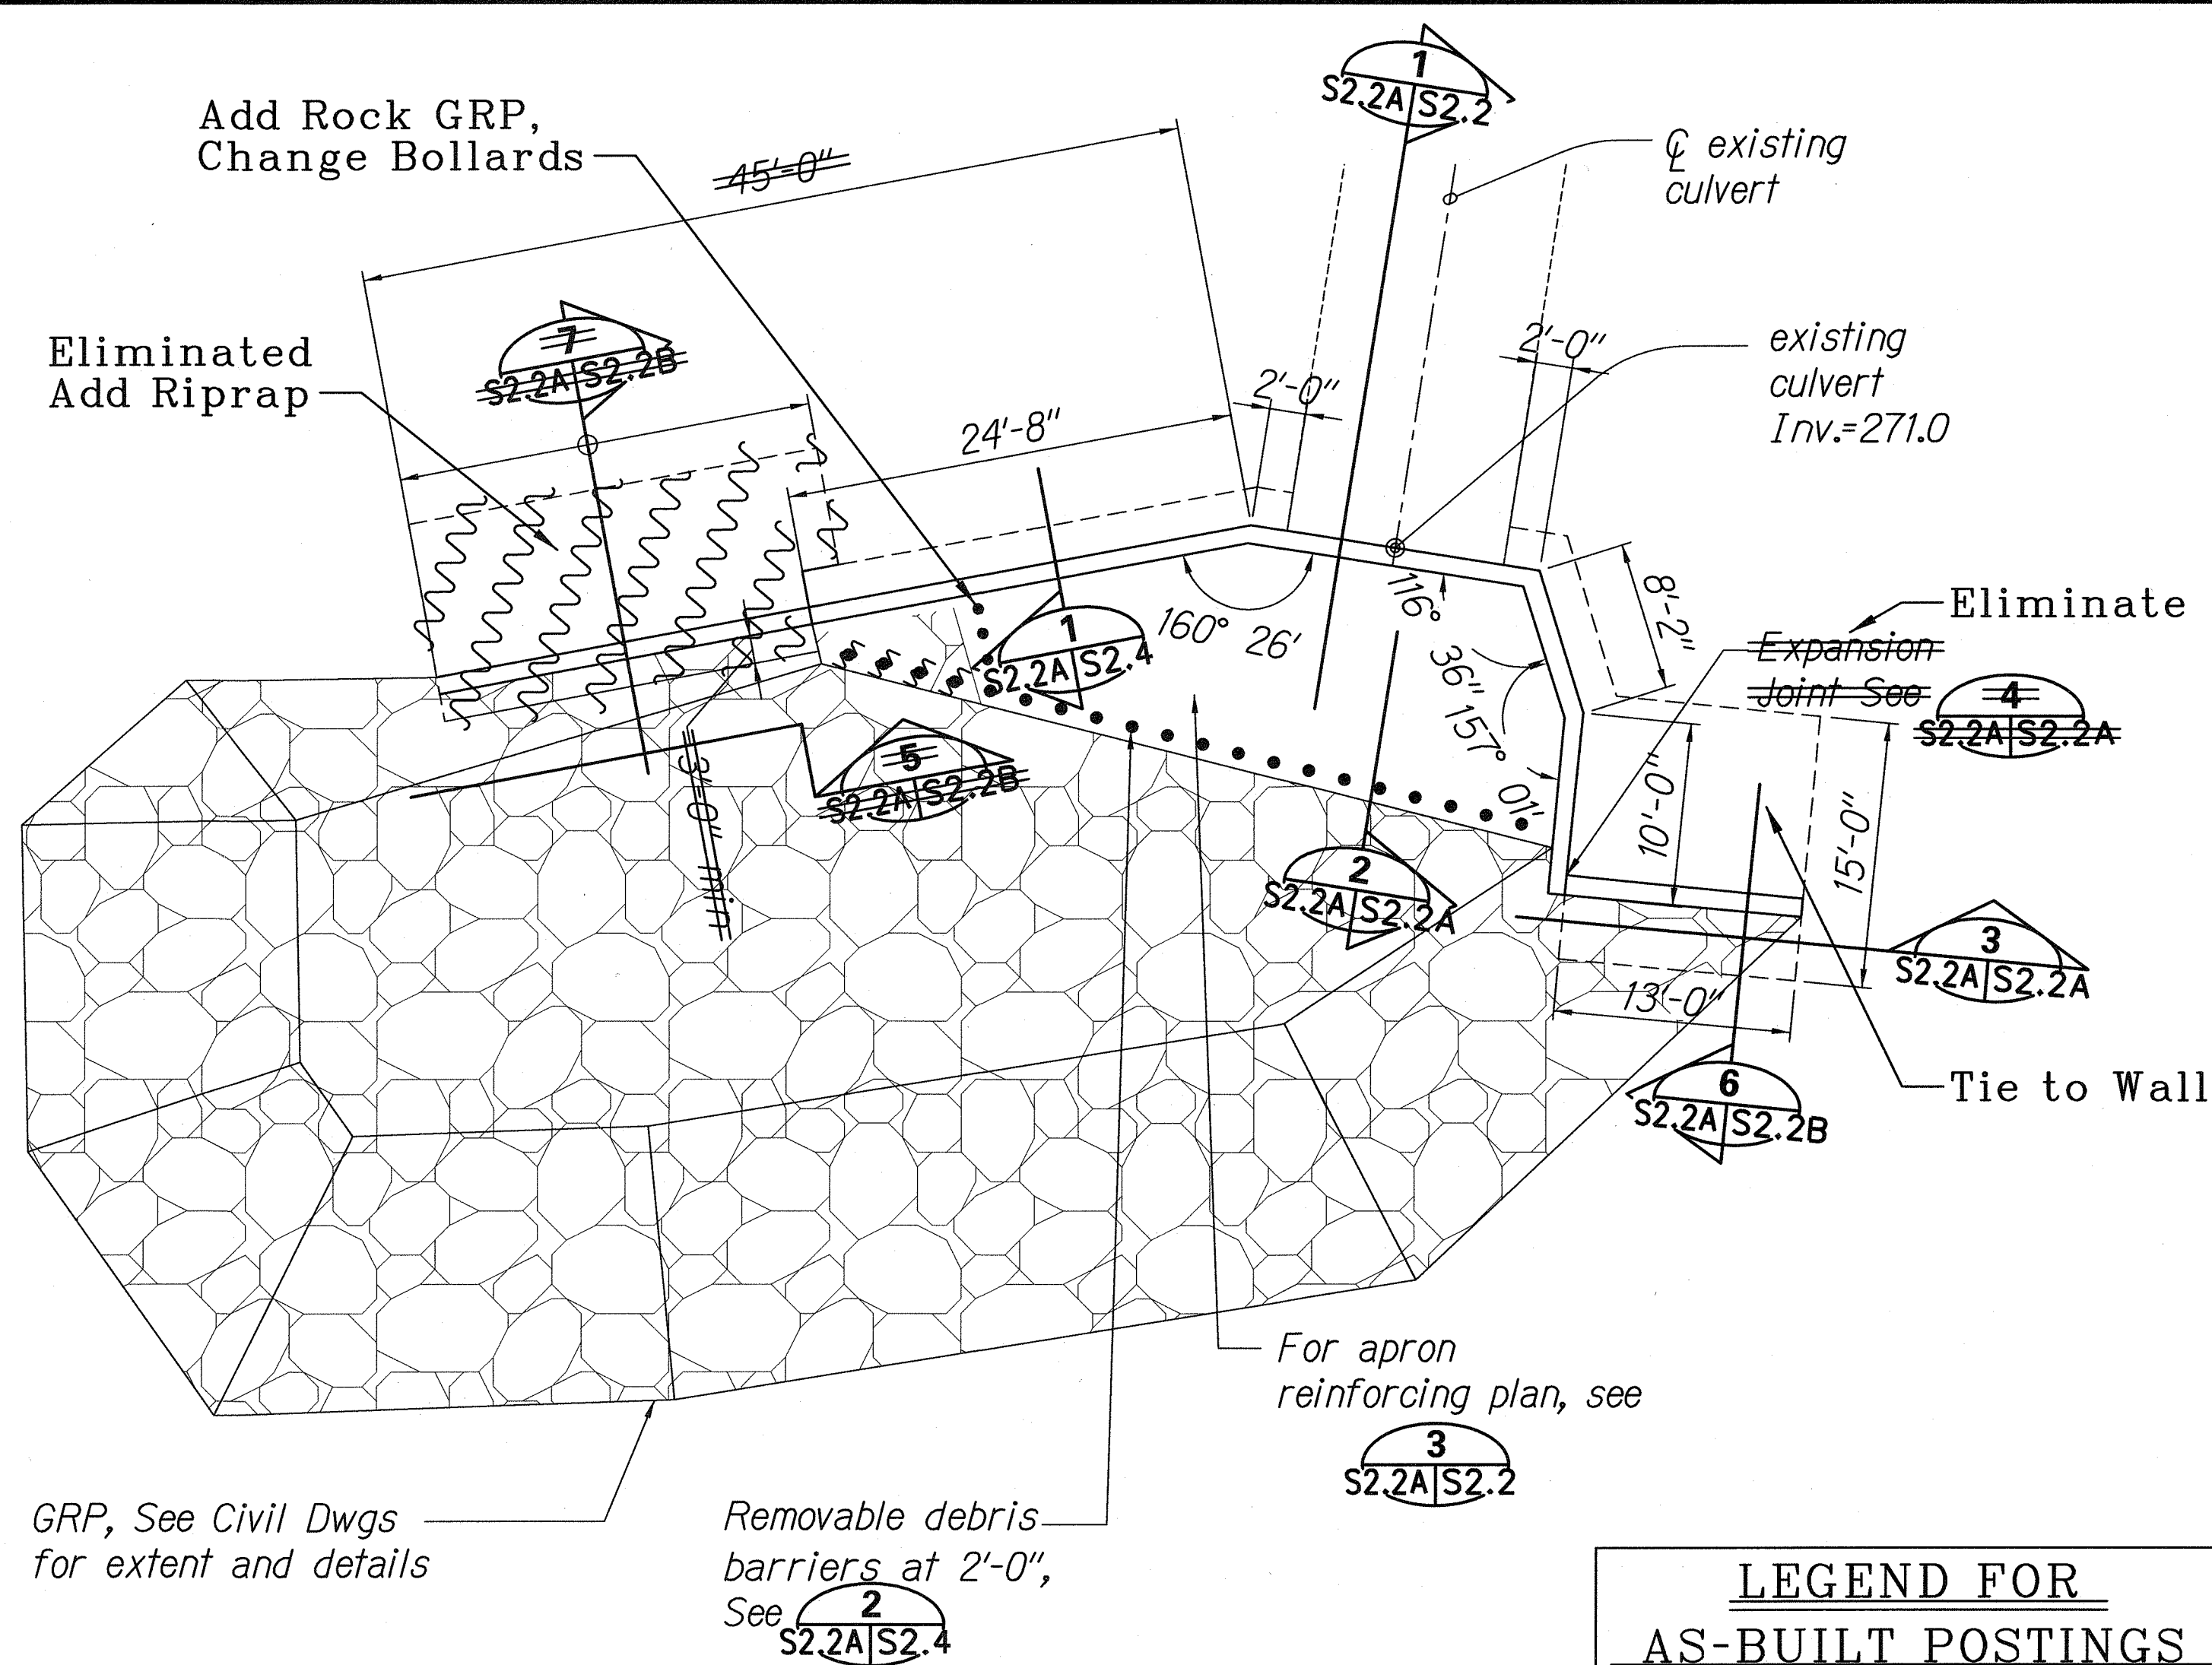


INLET STRUCTURE PLAN - VIEW

Scale: 1/8" = 1'-0"

1
S2.1/S2.2A


LEGEND FOR AS-BUILT POSTINGS	
	Squiggly line for as-built deletion
	Double line for as-built deletion
	Text for as-built posting

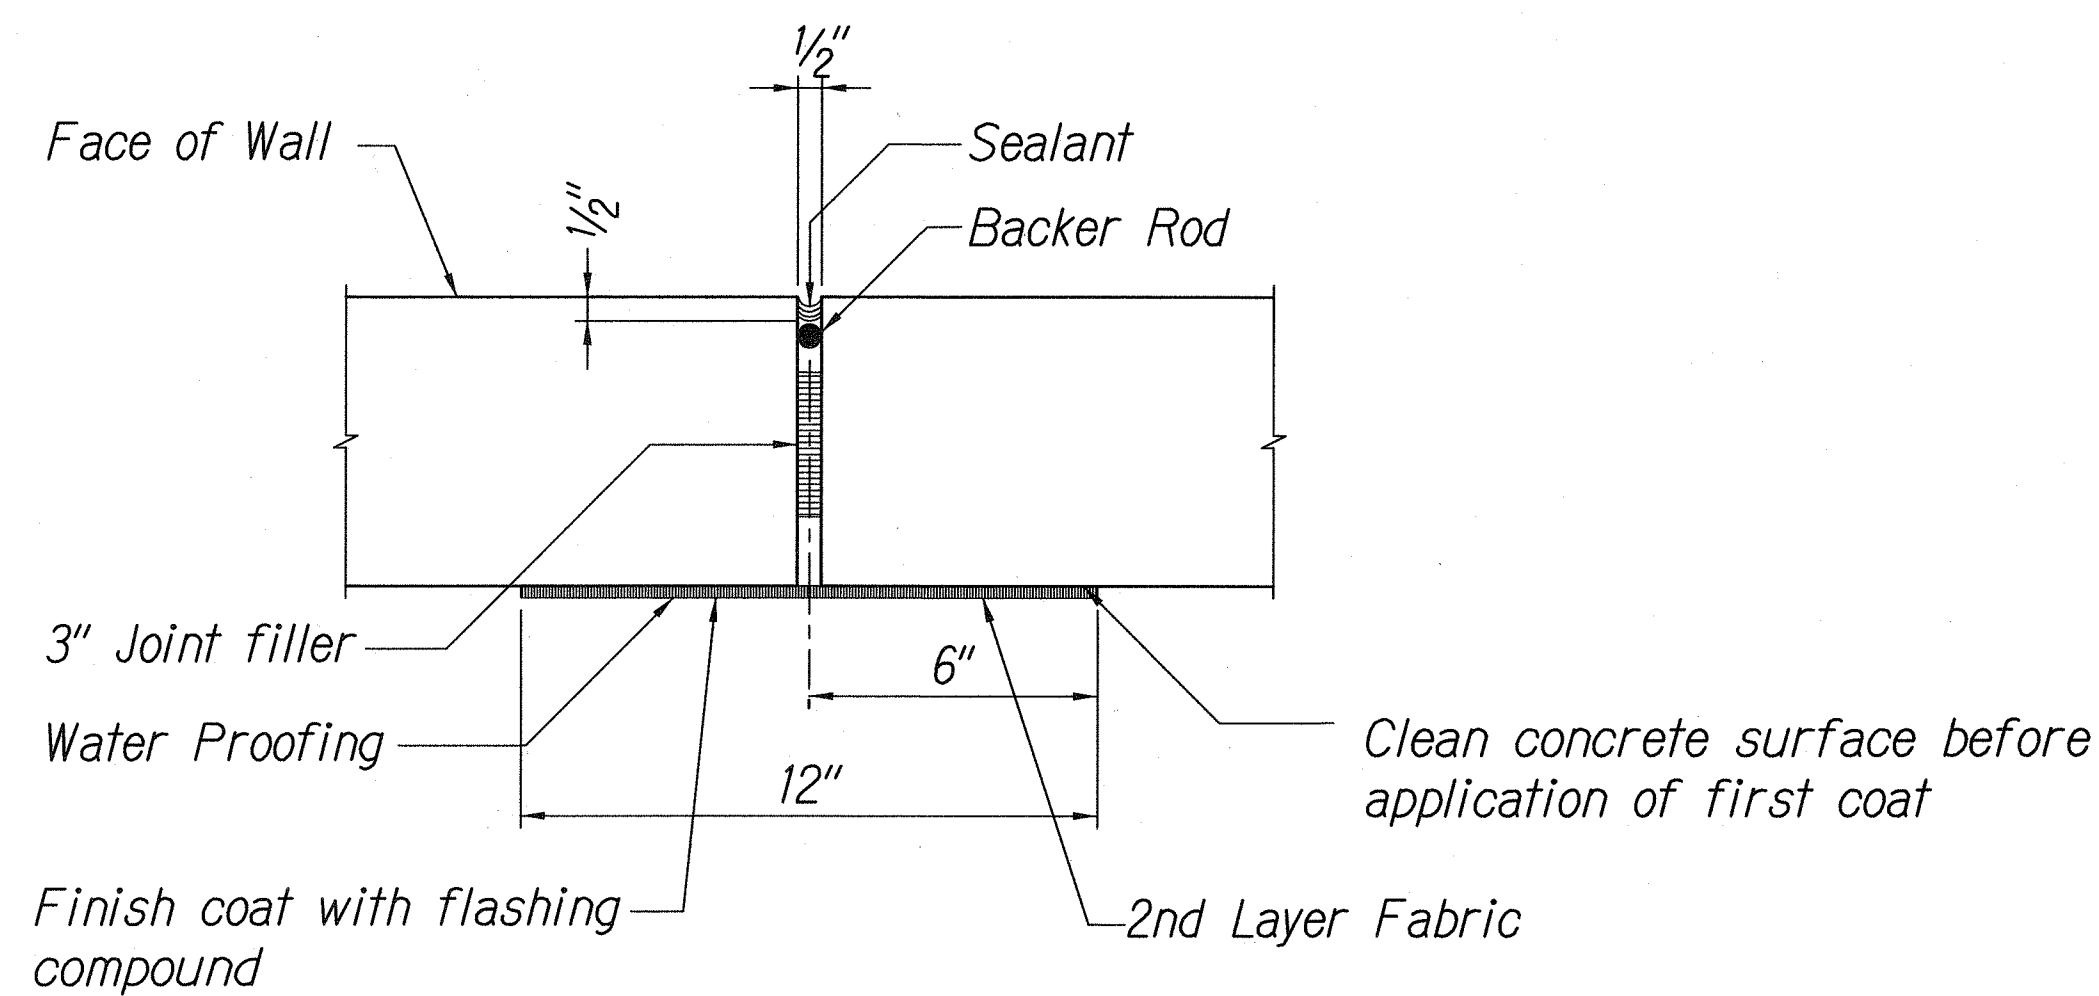

EXPANSION JOINT DETAIL

Not to Scale


4
S2.2A/S2.2A

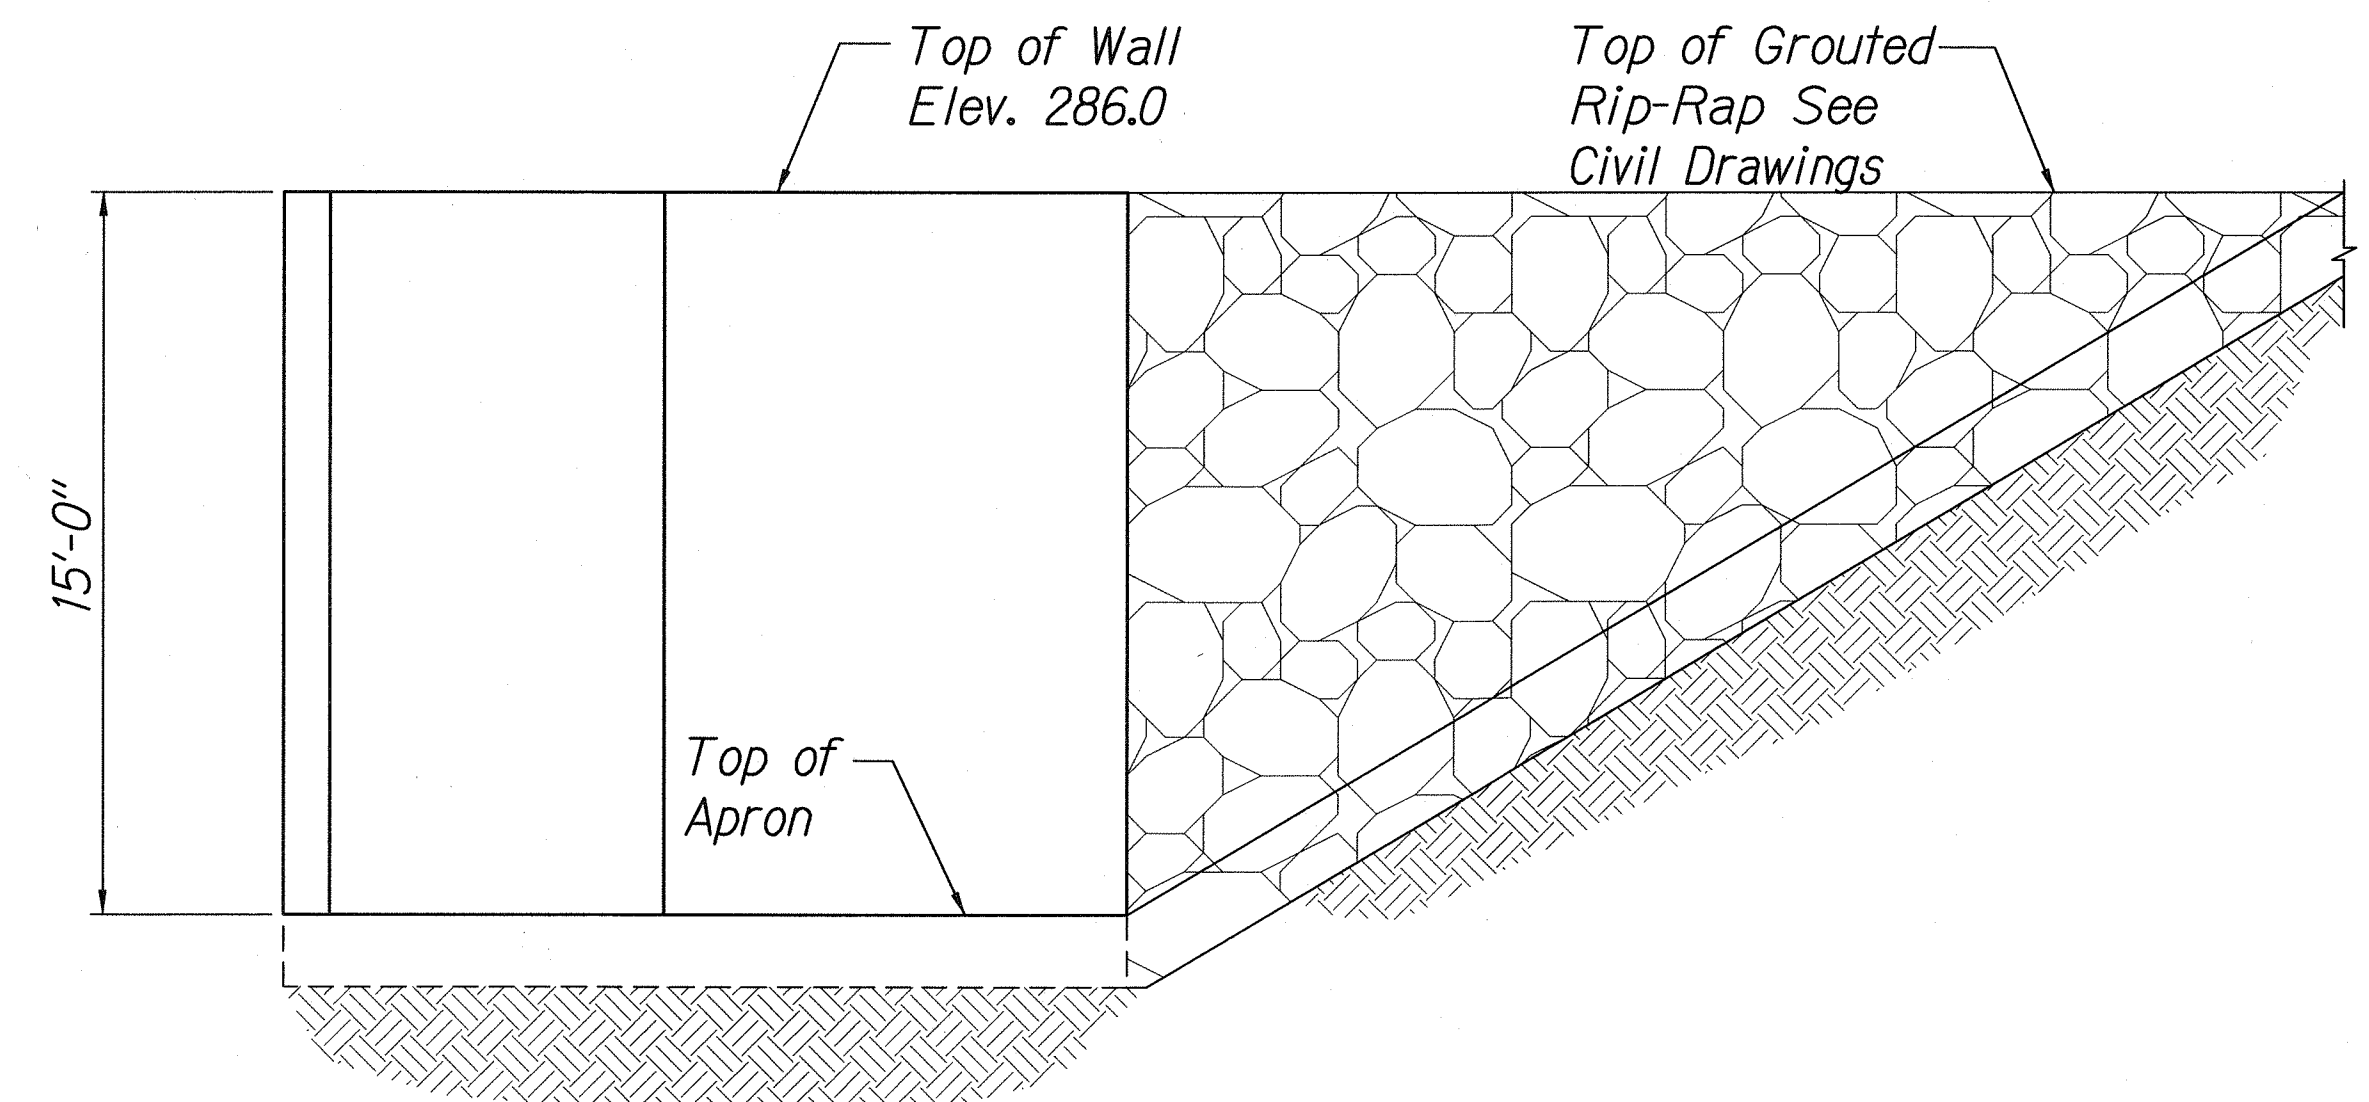

WINGWALL ELEVATION

Scale: 1/4" = 1'-0"

2
S2.2A/S2.2A

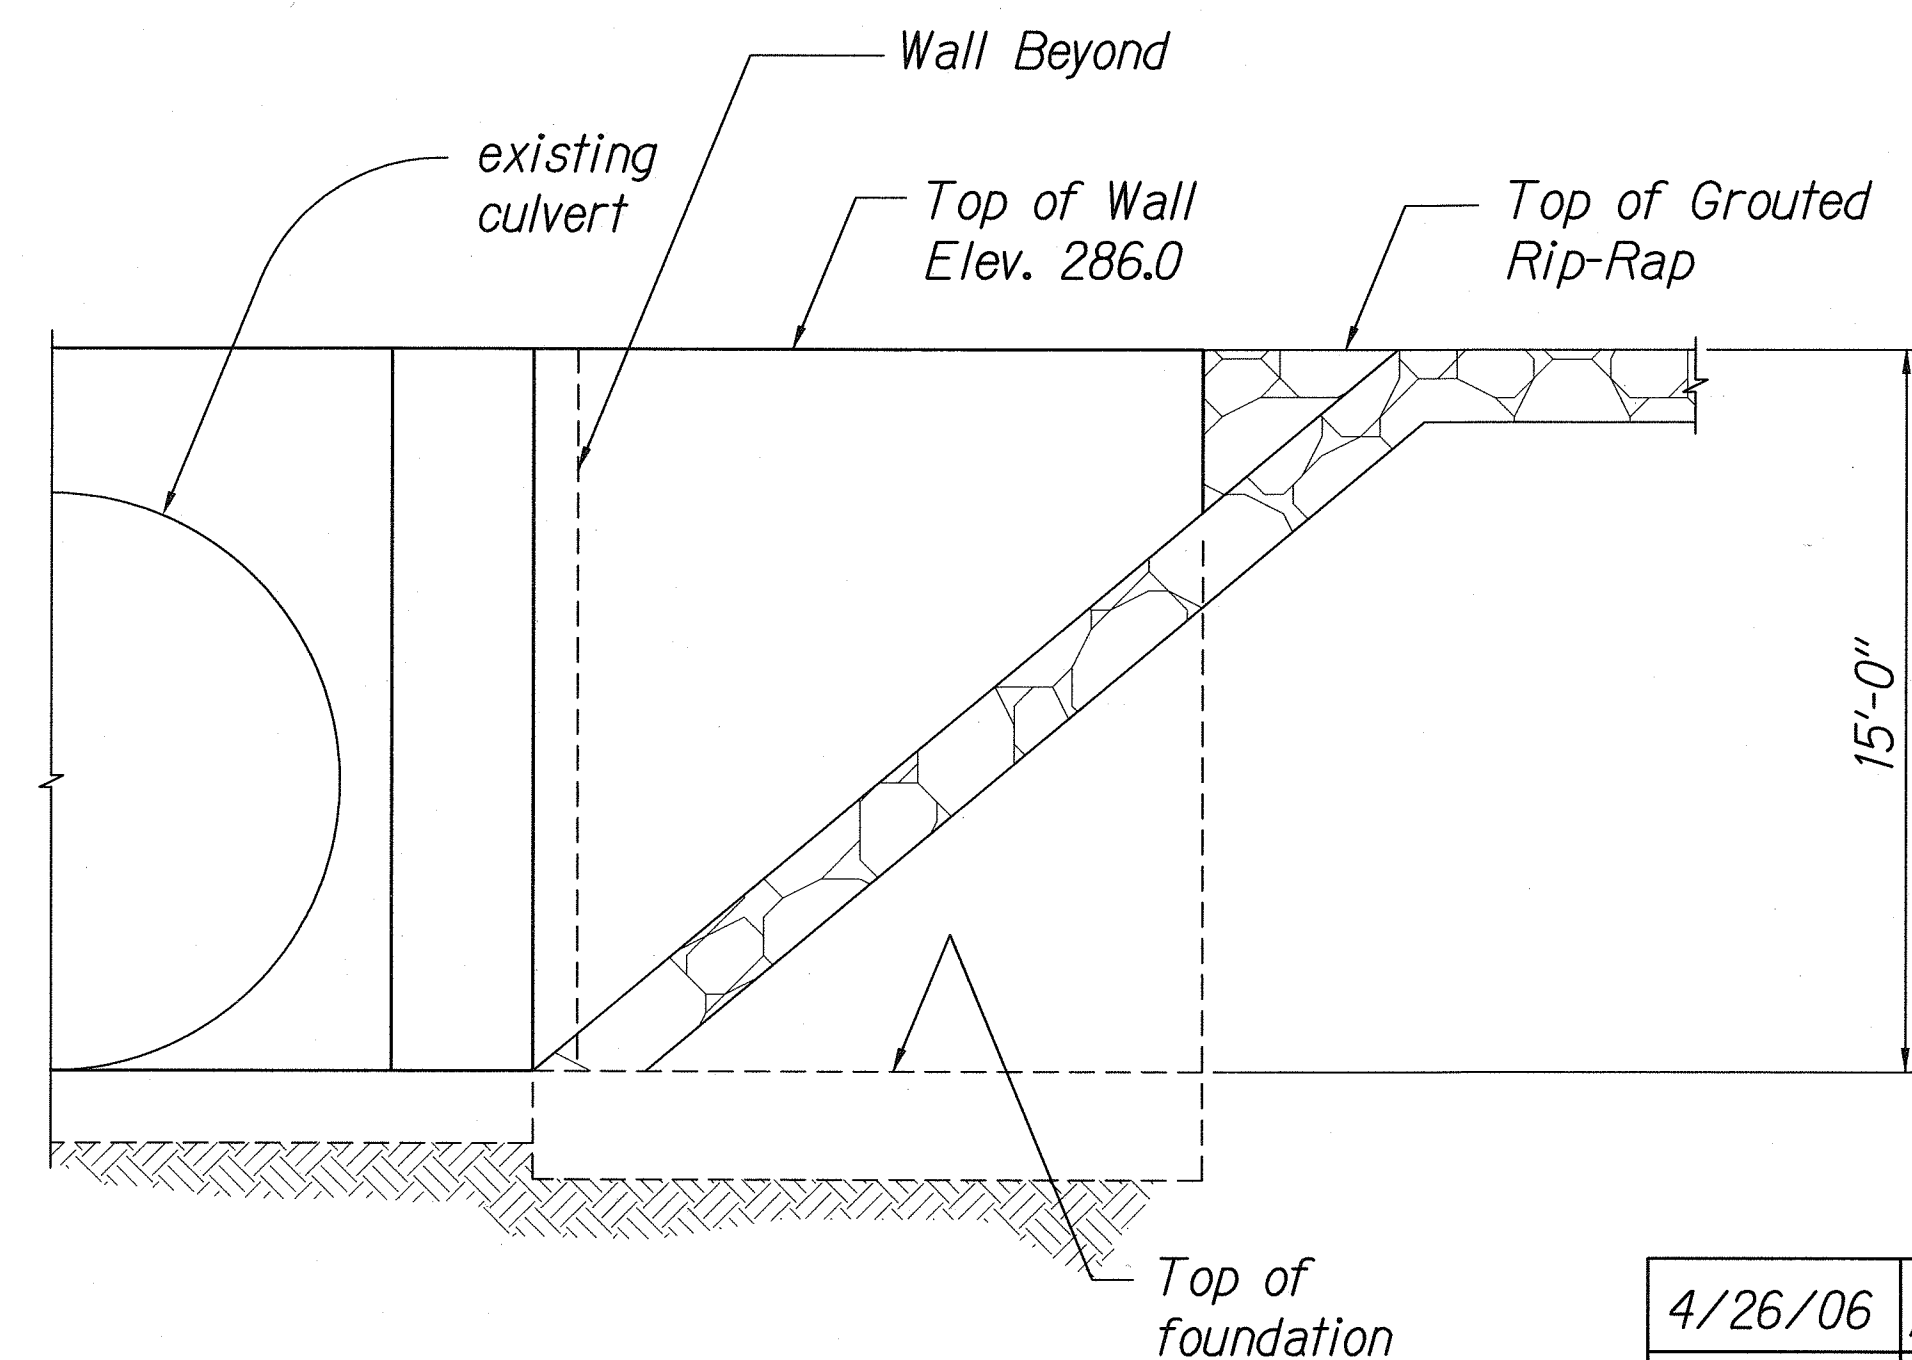

WINGWALL ELEVATION

Scale: 1/4" = 1'-0"

3
S2.2A/S2.2A

4/26/06	Added Sheet for Inlet Structure
Date	Revision
STATE OF HAWAII DEPARTMENT OF TRANSPORTATION HIGHWAYS DIVISION	
CULVERT INLET STRUCTURE PLAN AND ELEVATIONS	
Kuhio Highway Emergency Repairs Vicinity of MP 21.7 (Wailapa Stream) FEDERAL AID PROJECT NO. ER-14(1)	
Scale: As shown	Date: April 2006
SHEET No. S2.2A OF 34 SHEETS	

"AS-BUILT"

ADD. 27S-1

ORIGINAL PLAN	SURVEY PLOTTED BY	DATE
NOTE BOOK	DRAWN BY	
	CHECKED BY	
	CHECKED BY	

