



FED. ROAD DIST. NO.	STATE	FEDERAL AID PROJ. NO.	FISCAL YEAR	SHEET NO.	TOTAL SHEETS
HAWAII	HAWAII	ER-14(1)	2006	8	34

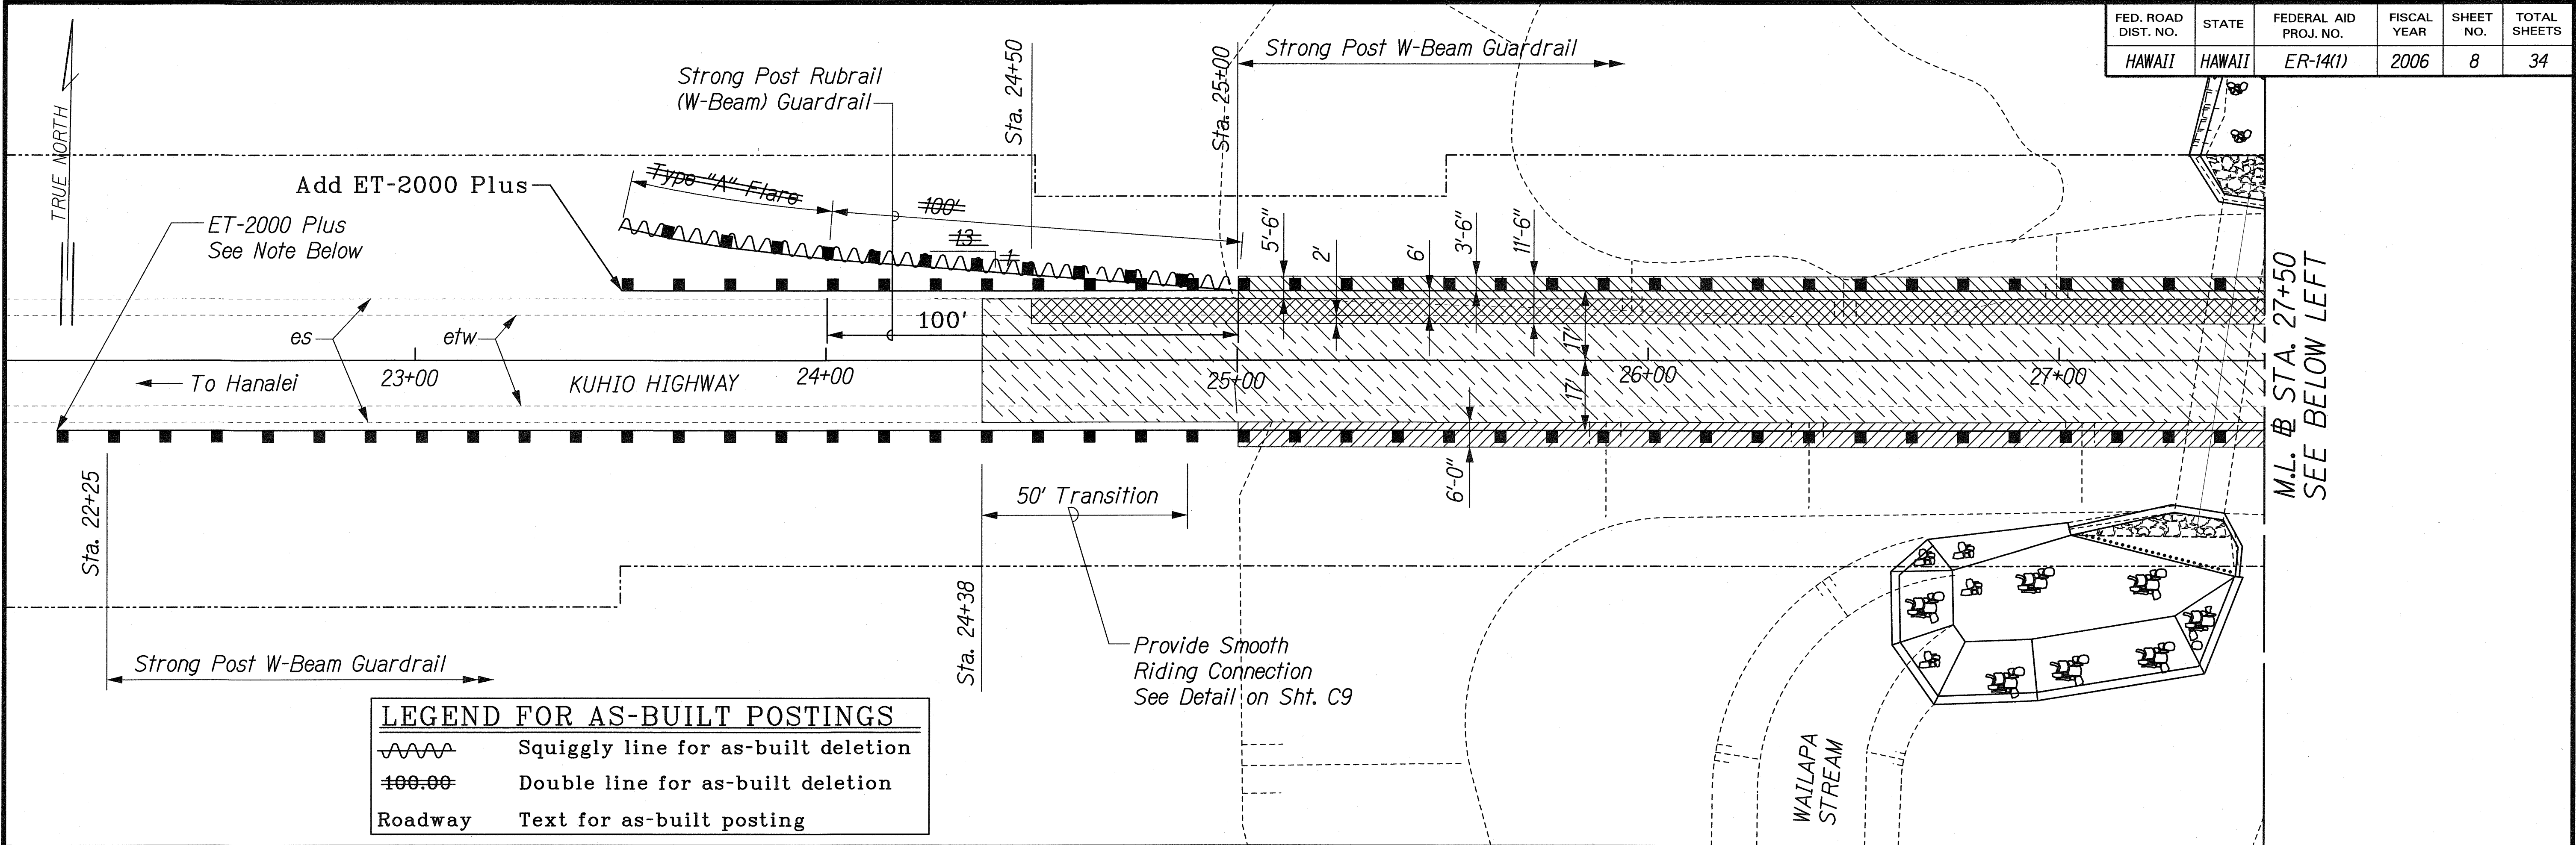

LEGEND FOR AS-BUILT POSTINGS	
	Squiggly line for as-built deletion
	Double line for as-built deletion
Roadway	Text for as-built posting

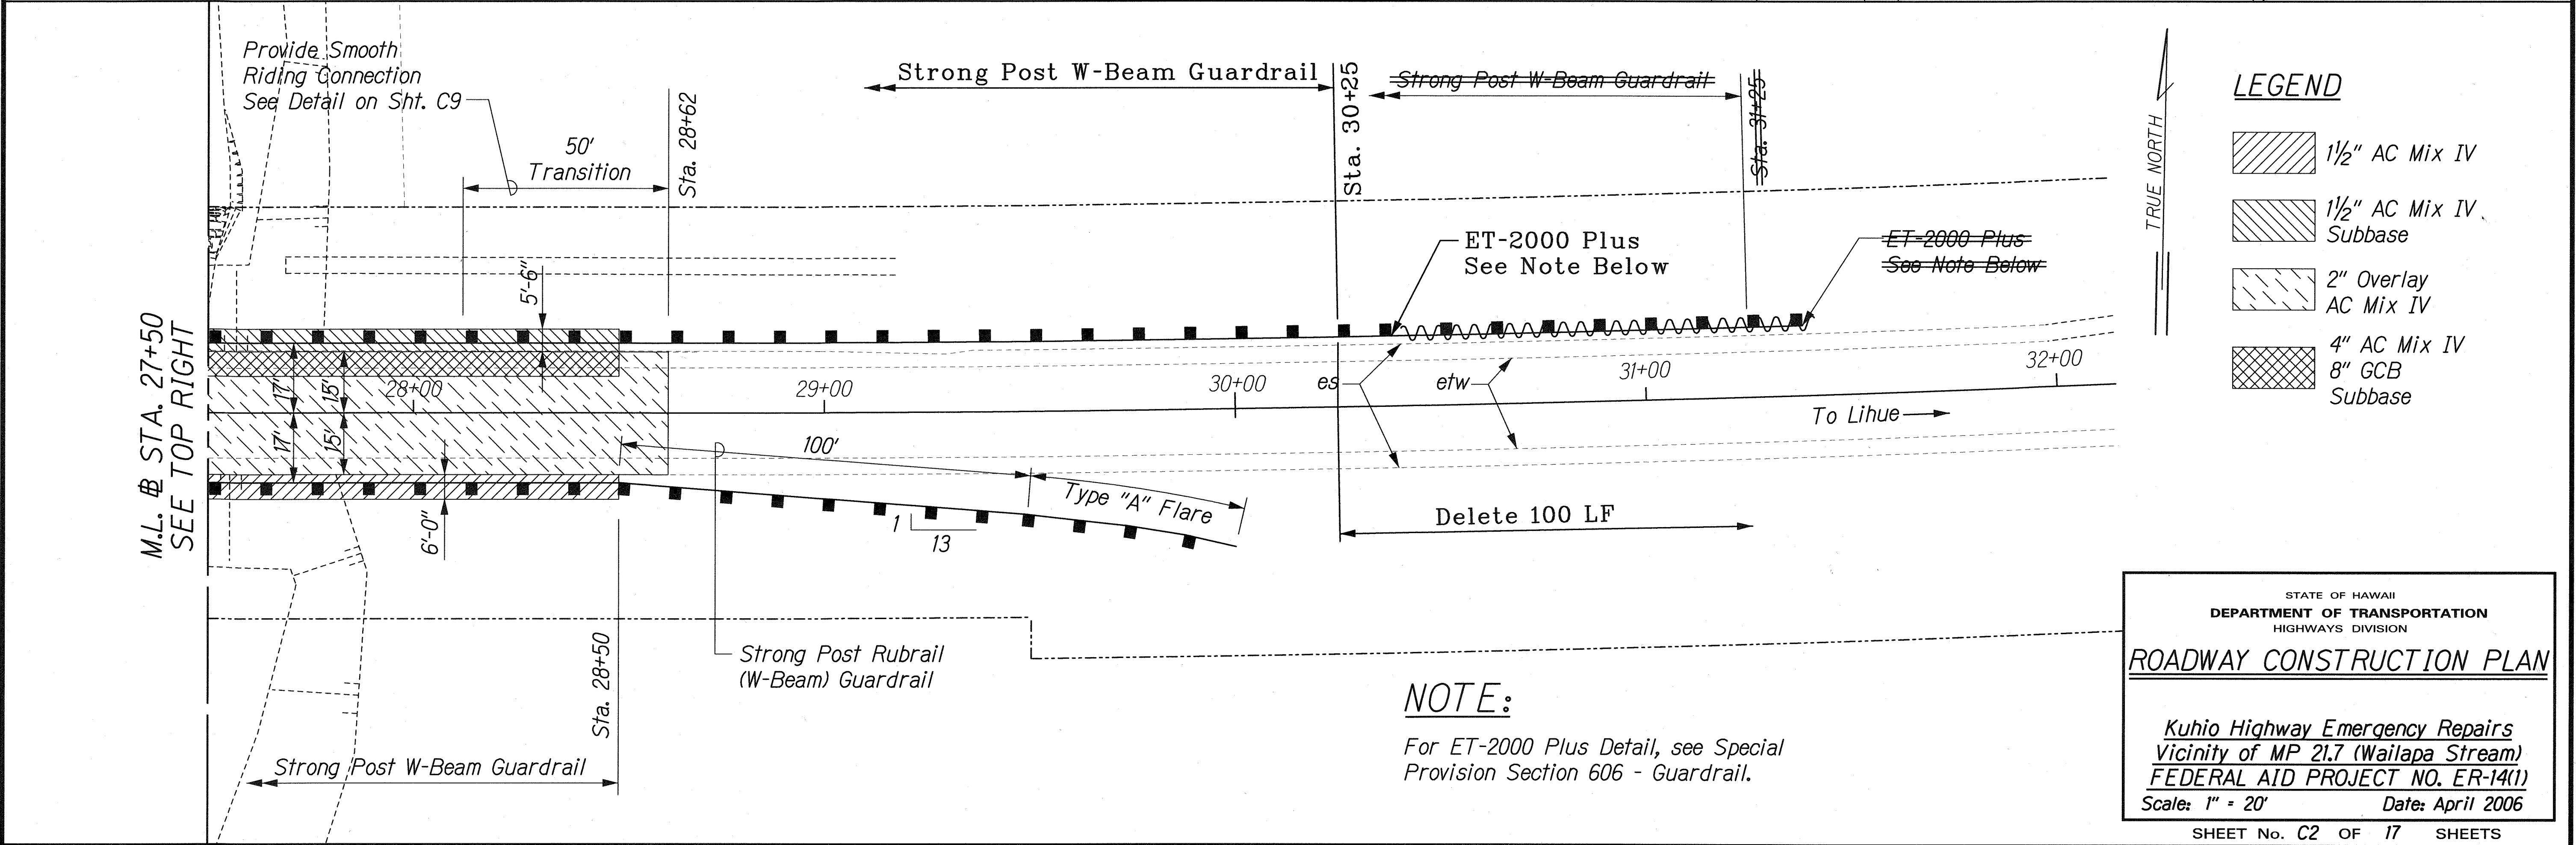

LEGEND

- 1 1/2" AC Mix IV
- 1 1/2" AC Mix IV Subbase
- 2" Overlay AC Mix IV
- 4" AC Mix IV 8" GCB Subbase

NOTE:

For ET-2000 Plus Detail, see Special Provision Section 606 - Guardrail.

STATE OF HAWAII
DEPARTMENT OF TRANSPORTATION
HIGHWAYS DIVISION

ROADWAY CONSTRUCTION PLAN

Kuhio Highway Emergency Repairs
Vicinity of MP 21.7 (Wailapa Stream)
FEDERAL AID PROJECT NO. ER-14(1)
Scale: 1" = 20' Date: April 2006

SHEET No. C2 OF 17 SHEETS

"AS-BUILT"

SURVEY PLOTTED BY	DATE
DRAWN BY	
DESIGNED BY	
QUANTITIES BY	
CHECKED BY	
NO.	