


FED. ROAD DIST. NO.	STATE	FEDERAL AID PROJ. NO.	FISCAL YEAR	SHEET NO.	TOTAL SHEETS
HAWAII	HAWAII	ER-14(1)	2006	31	34

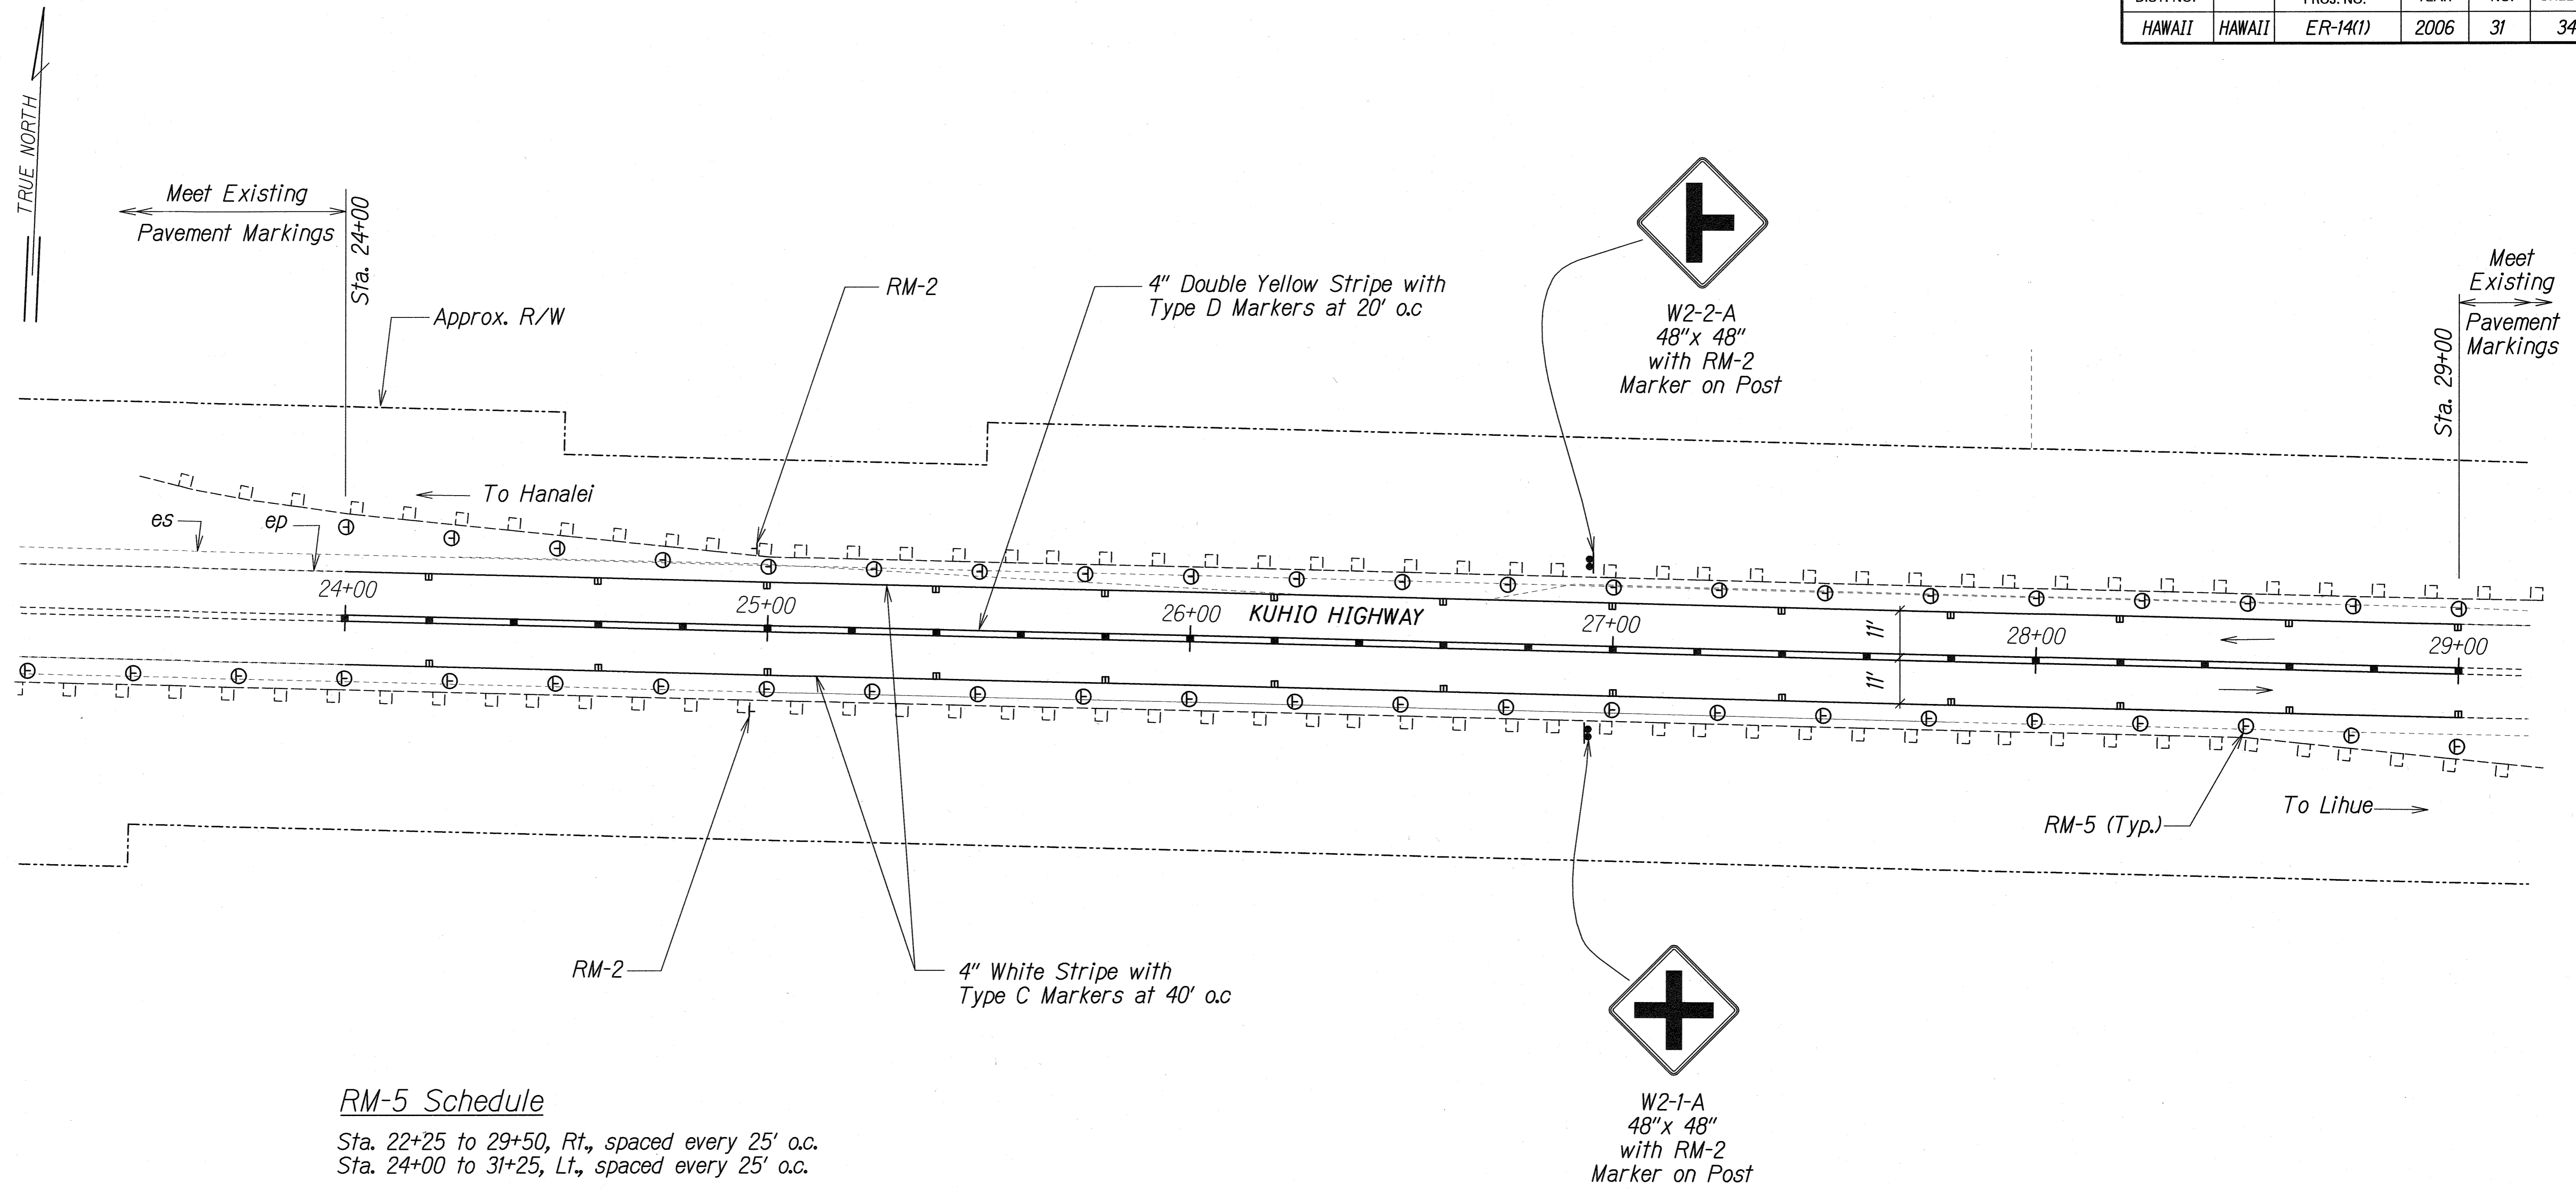

RM-5 Schedule

Sta. 22+25 to 29+50, Rt., spaced every 25' o.c.  
 Sta. 24+00 to 31+25, Lt., spaced every 25' o.c.

SURVEY PLOTTED BY	DATE
DRAWN BY	
DESIGNED BY	
QUANTITIES BY	
CHECKED BY	
ORIGINAL PLAN	
NOTE BOOK	
No.	

LEGEND FOR AS-BUILT POSTINGS	
	Squiggly line for as-built deletion
	Double line for as-built deletion
Roadway	Text for as-built posting

4/26/06	Replaced OM-2V Markers with RM-2 Markers. Revised RM-5 Schedule.
Date	Revision

STATE OF HAWAII  
 DEPARTMENT OF TRANSPORTATION  
 HIGHWAYS DIVISION

**SIGNING AND PAVEMENT MARKINGS PLAN**

*Kuhio Highway Emergency Repairs  
 Vicinity of MP 21.7 (Wailapa Stream)  
 FEDERAL AID PROJECT NO. ER-14(1)*

Scale: 1" = 20'      Date: April 2006