
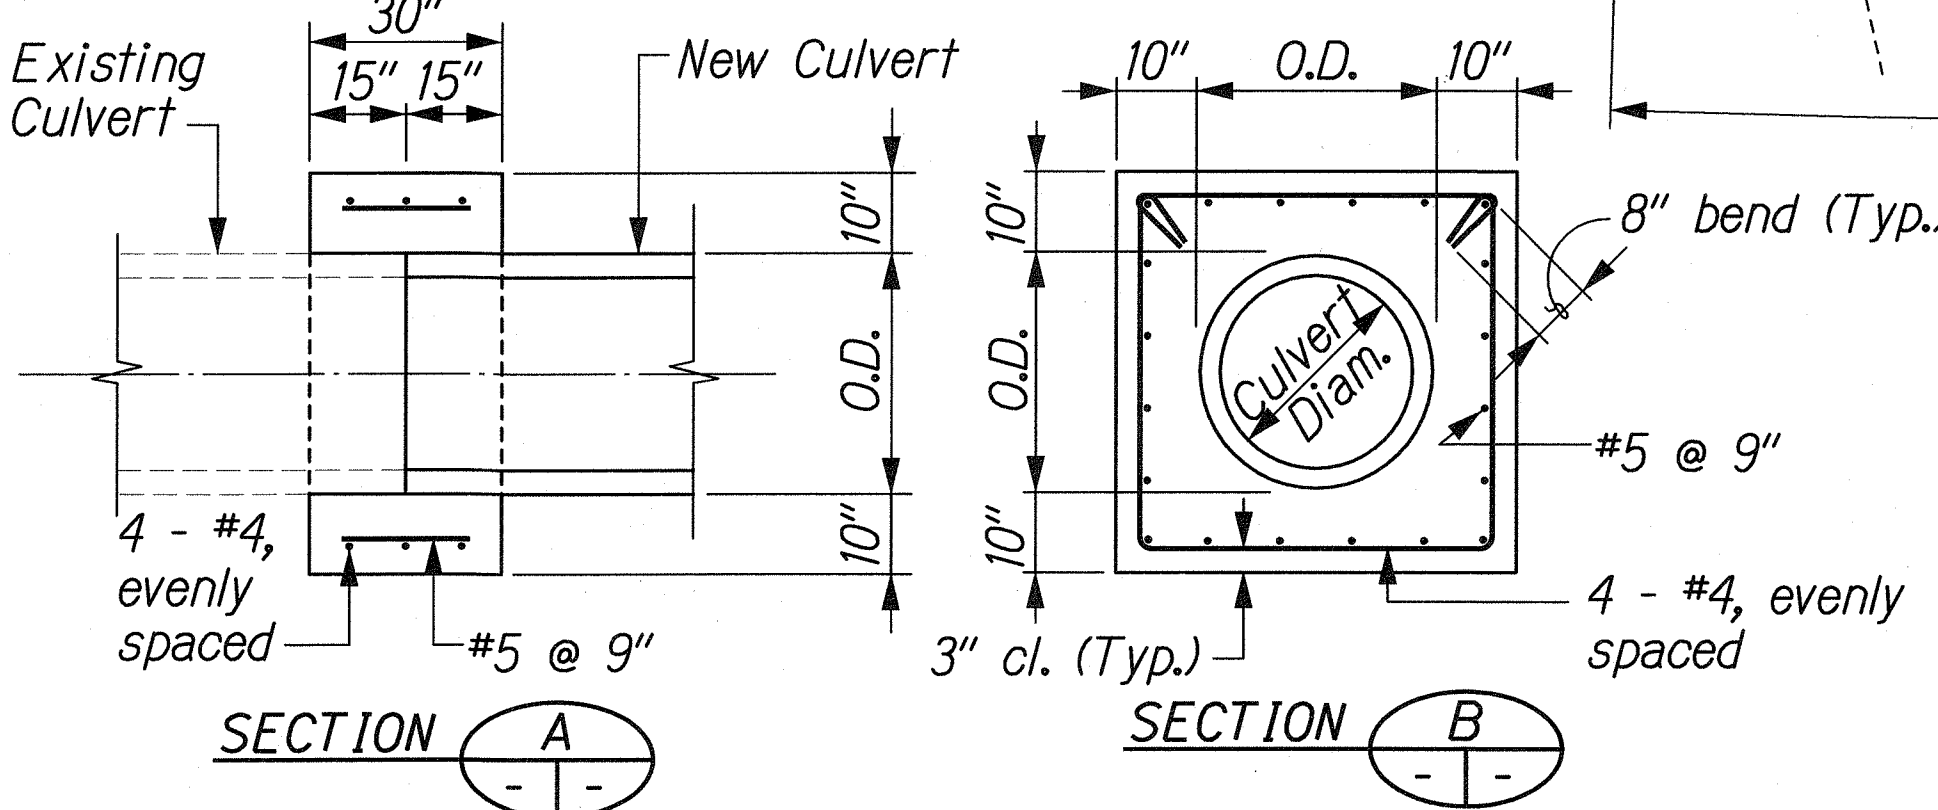
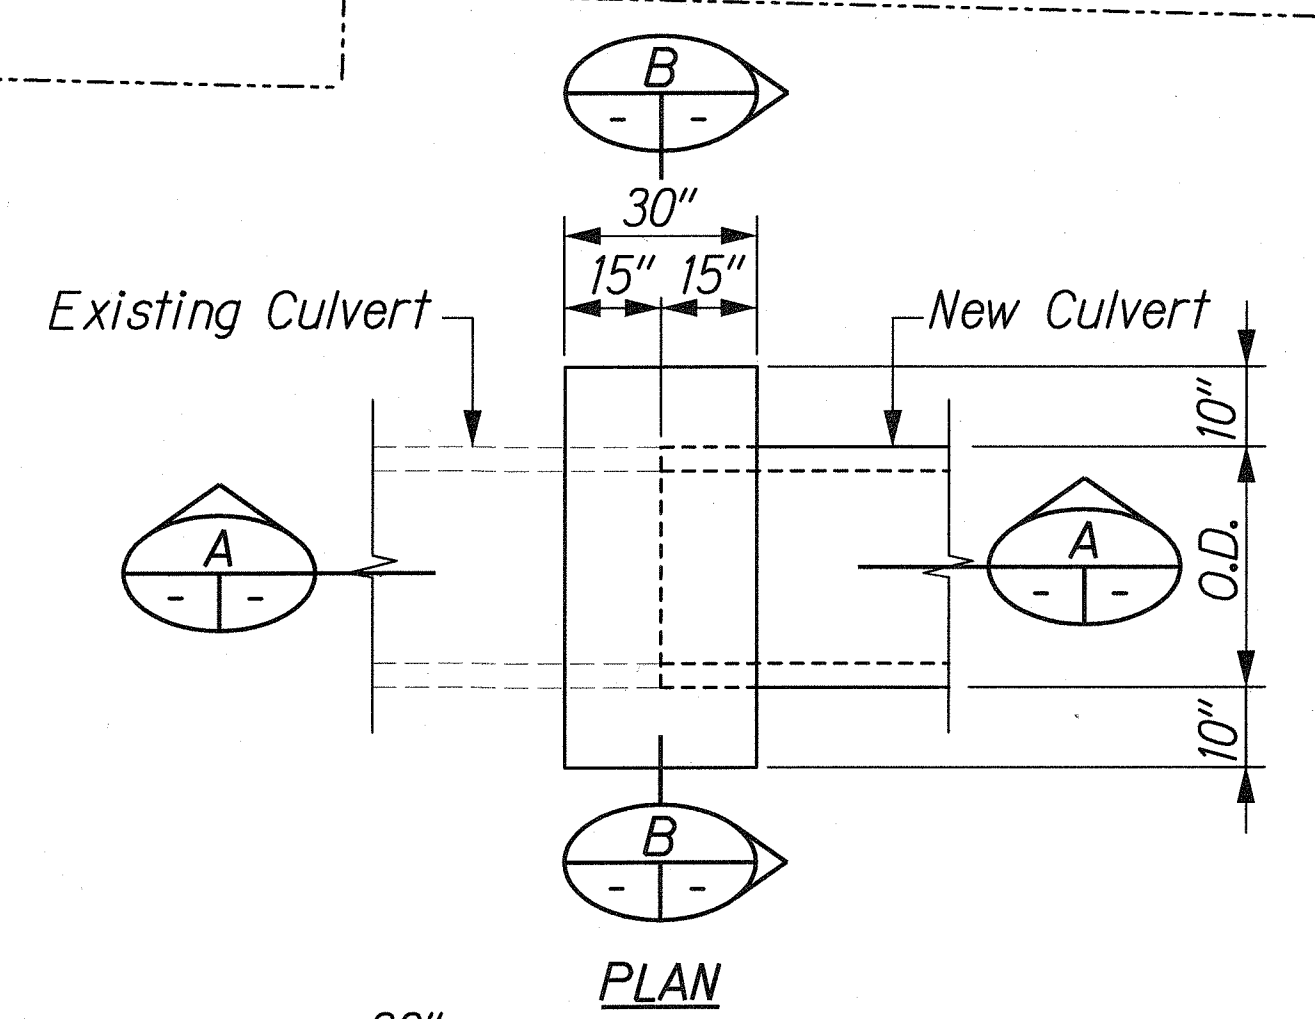


FED. ROAD DIST. NO.	STATE	FEDERAL AID PROJ. NO.	FISCAL YEAR	SHEET NO.	TOTAL SHEETS
HAWAII	HAWAII	ER-14(1)	2006	7	34

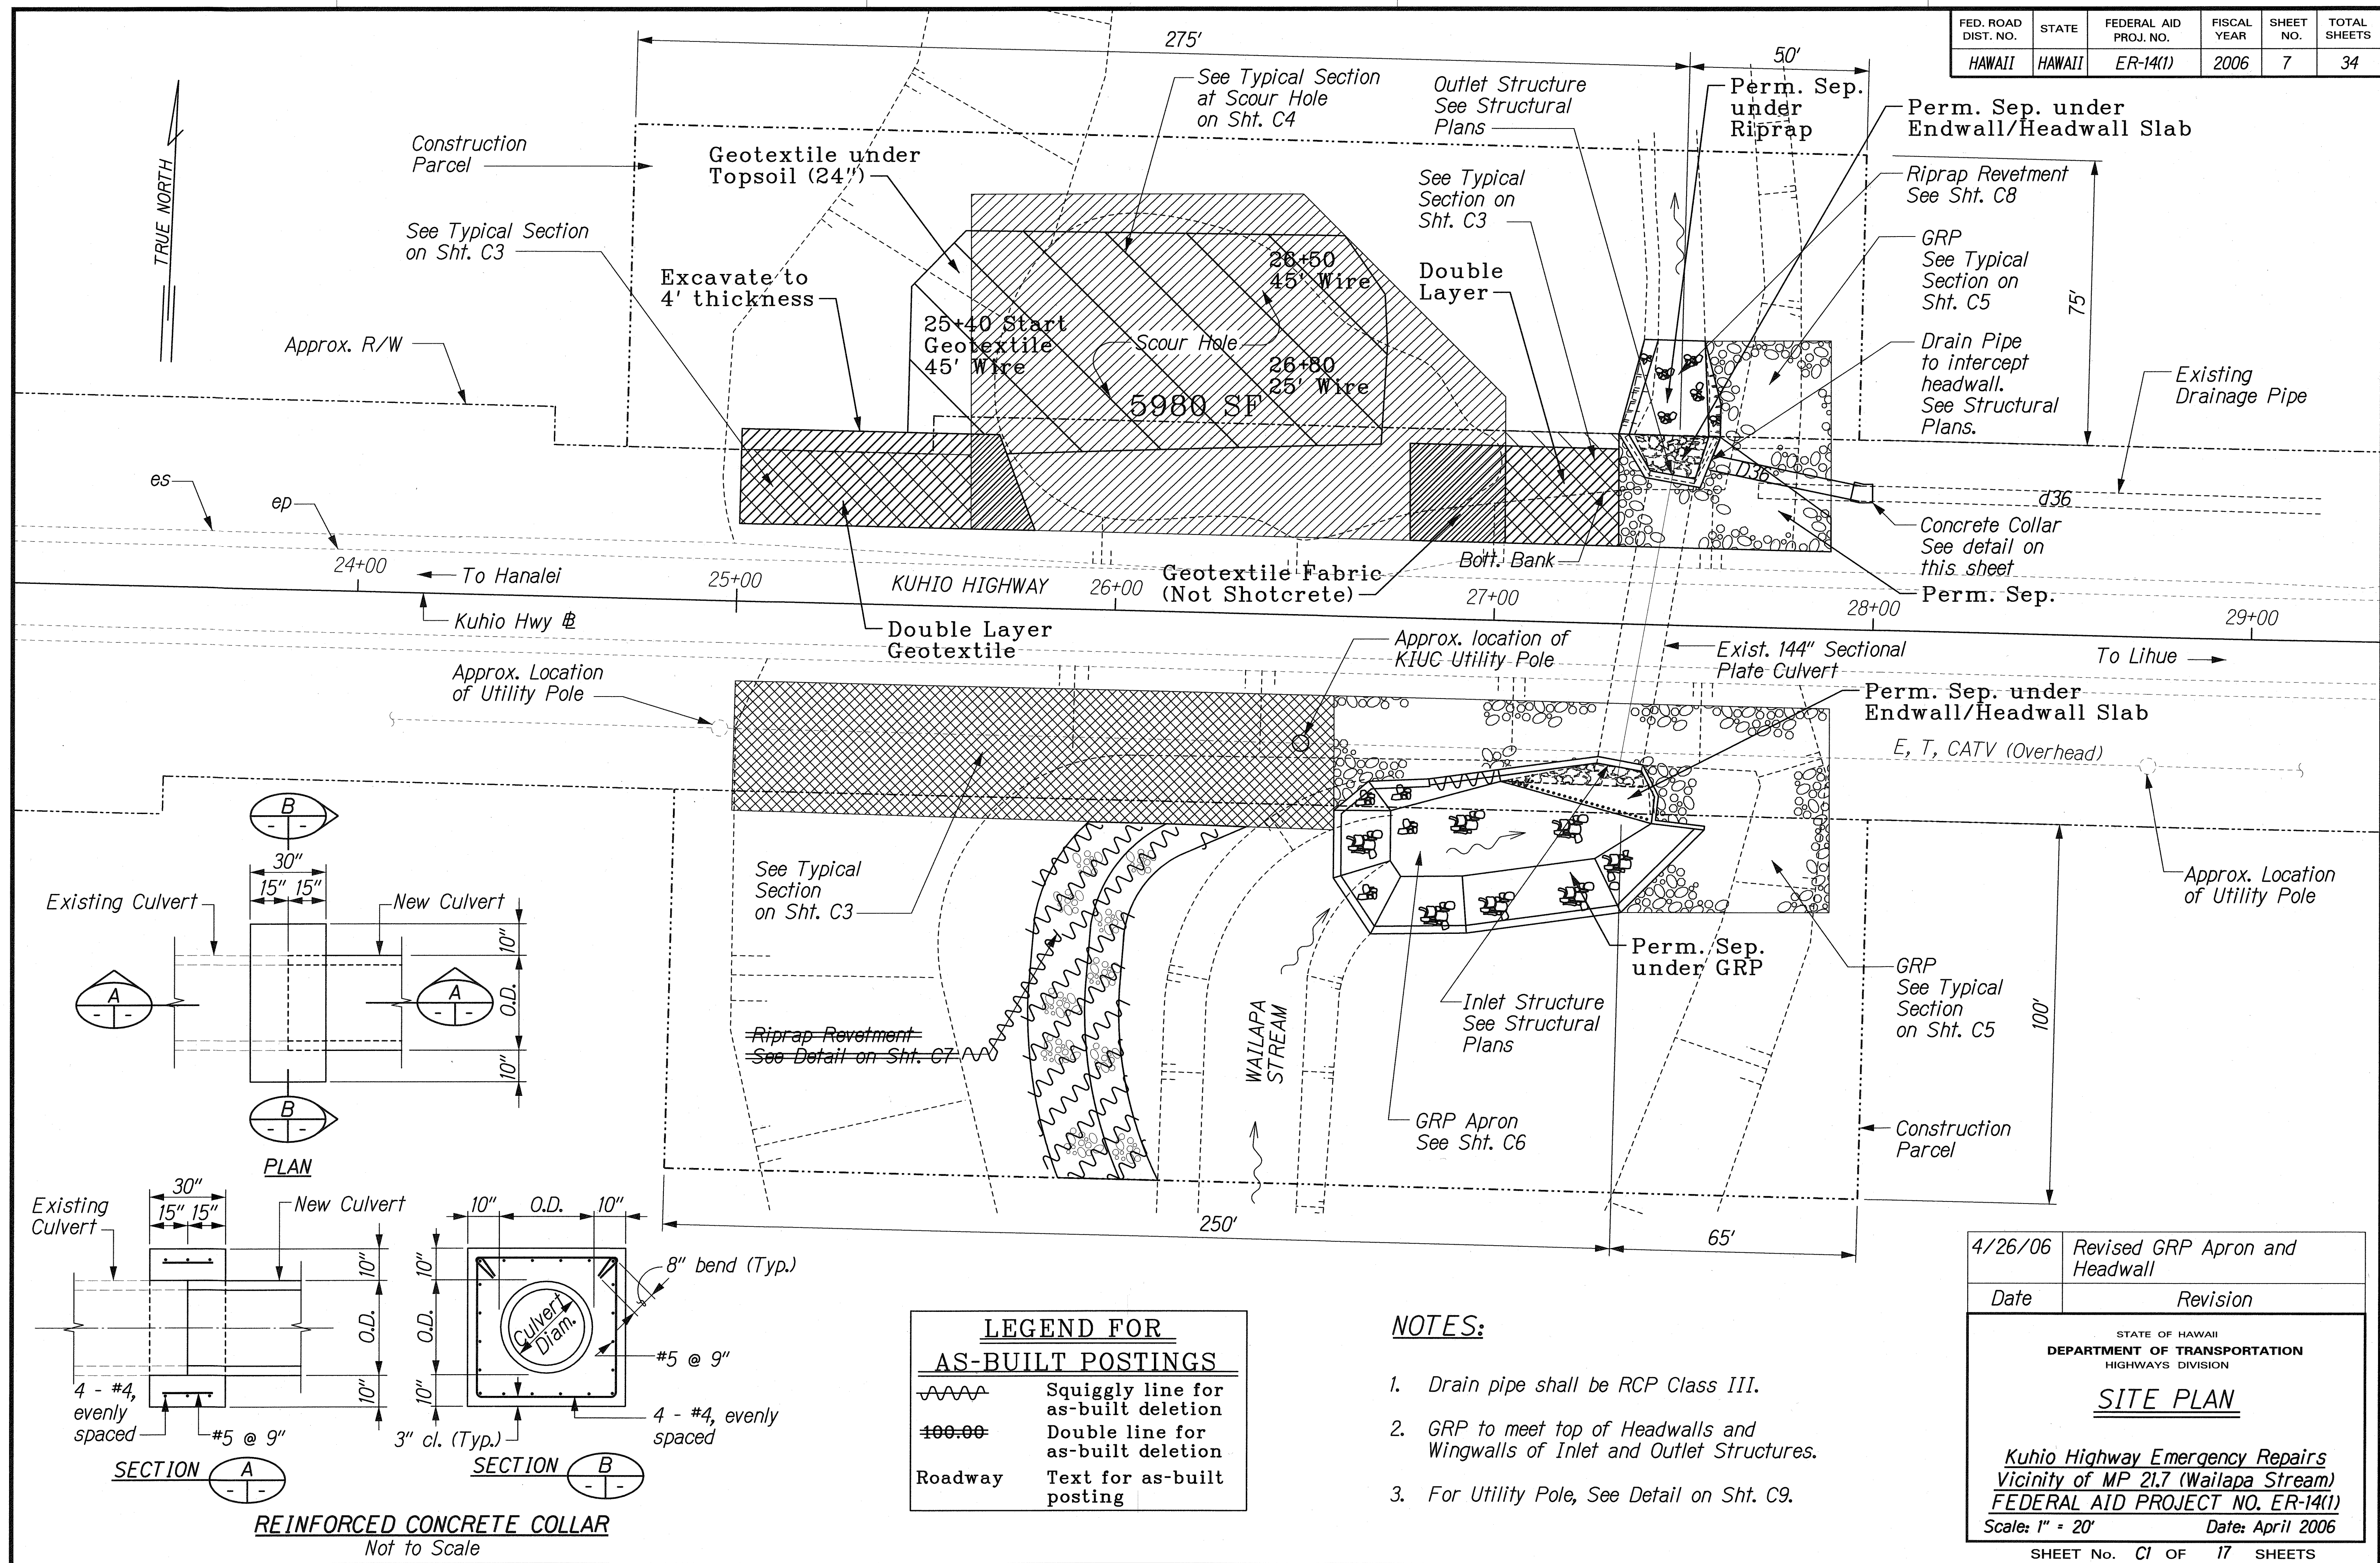

REINFORCED CONCRETE COLLAR
Not to Scale

LEGEND FOR AS-BUILT POSTINGS	
	Squiggly line for as-built deletion
	Double line for as-built deletion
Roadway	Text for as-built posting

NOTES:

1. Drain pipe shall be RCP Class III.
2. GRP to meet top of Headwalls and Wingwalls of Inlet and Outlet Structures.
3. For Utility Pole, See Detail on Sht. C9.

4/26/06	Revised GRP Apron and Headwall
Date	Revision

STATE OF HAWAII
DEPARTMENT OF TRANSPORTATION
HIGHWAYS DIVISION

SITE PLAN

*Kuhio Highway Emergency Repairs
Vicinity of MP 21.7 (Wailapa Stream)*
FEDERAL AID PROJECT NO. ER-14(1)
Scale: 1" = 20' Date: April 2006

SHEET No. **CI** OF 17 SHEETS

"AS-BUILT"

ADD 7