


FED. ROAD DIST. NO.	STATE	FED. AID PROJ. NO.	FISCAL YEAR	SHEET NO.	TOTAL SHEETS
HAWAII	HAW.	STP-056-1(49)	2006	21	31

NOTE:
All Holes are
3/4" Dia.

W6x8.5
Structural
Shape


**LEGEND FOR
AS-BUILT POSTINGS**

~~~~~ Squiggly line for  
as-built deletion  
= Double line for  
as-built deletion  
Text for as-built  
posting

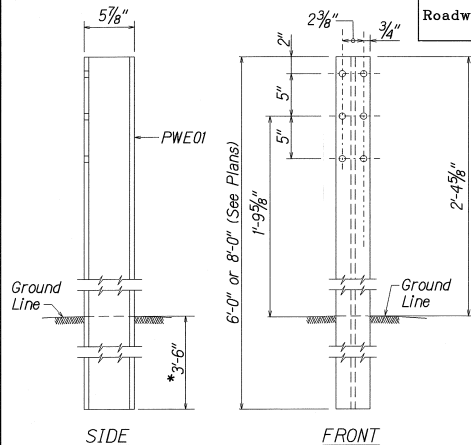


**W-BEAM STRONG POST (PWE01)**


\*5'-6" for 8' post.

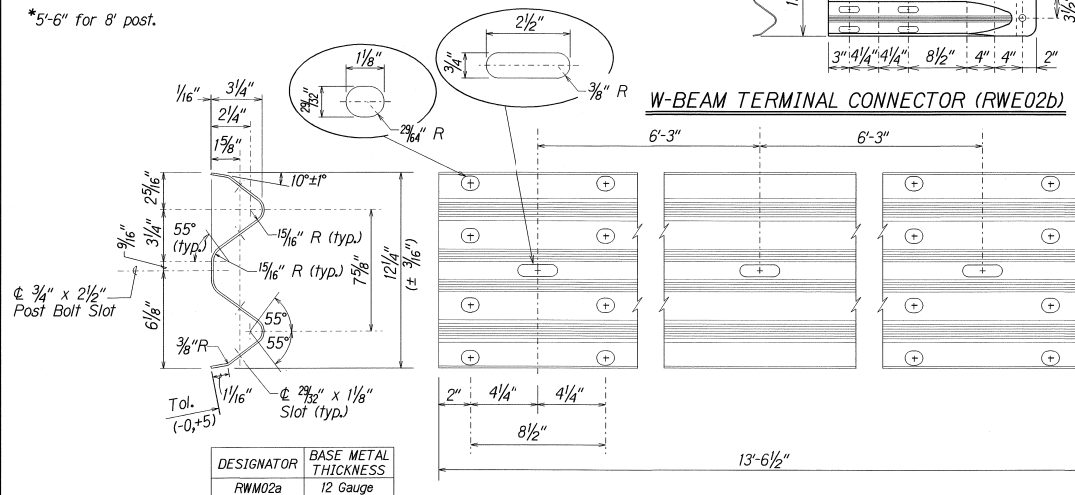



**2 SPACE W-BEAM GUARDRAIL (RWM02a)**

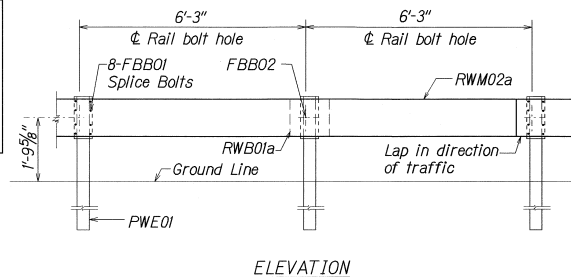


**STRONG POST W-BEAM GUARDRAIL WITH  
RECYCLED OFFSET BLOCK OR PLASTIC BLOCKOUT**

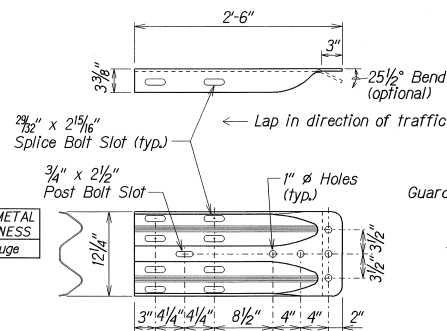


**W-BEAM TERMINAL CONNECTOR (RWE02b)**

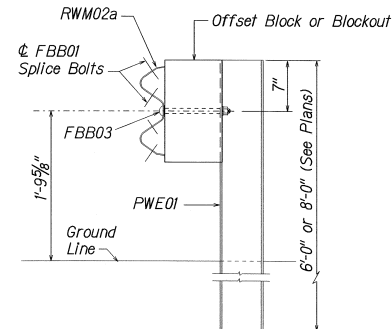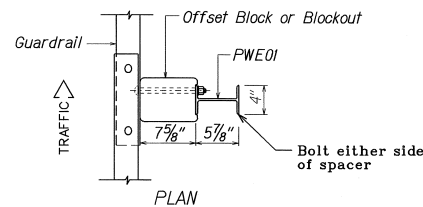

**STRONG POST W-BEAM GUARDRAIL  
(SGR04a)**

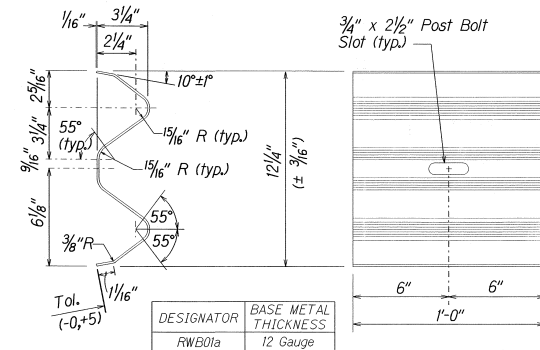

**W-BEAM BACK-UP-PLATE (RWB01a)**

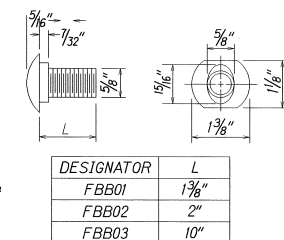

**GUARDRAIL BOLTS AND  
RECESSED NUT**

STATE OF HAWAII  
DEPARTMENT OF TRANSPORTATION  
HIGHWAYS DIVISION

**STRONG POST W-BEAM GUARDRAIL**

KUHIO HIGHWAY  
Guardrail and Shoulder Improvements  
at Various Locations  
Fed. Aid Project No. STP-056-1(49)

Scale: Not to Scale Date: Oct. 2005

SHEET No. 2 OF 6 SHEETS

"AS-BUILT"