



INDEX TO DRAWINGS	
SHEET NO.	DESCRIPTION
1	TITLE SHEET
2	STANDARD PLANS SUMMARY
3	GENERAL NOTES & LEGEND
4 - 5	WATER POLLUTION AND EROSION CONTROL NOTES
6 - 16	ROADWAY PLAN
17	PORTABLE PHYSICAL BARRIER
18	A.C. PAVEMENT UNDER FLEAT-350
19	GUARDRAIL DETAILS AT OBSTRUCTION
20	GUARDRAIL DETAILS & NOTES
21	STRONG-POST W-BEAM GUARDRAIL
22 - 23	MODIFIED TYPE "A-1" DETAILS & NOTES
24	FLEAT-350 DETAILS & NOTES
25	ET-2000 PLUS
26 - 29	WAIKALUA BRIDGE LAYOUT PLAN, DETAILS & NOTES
30	LOW SPEED UNDIVIDED HIGHWAY WORK ZONE SIGNING PLAN, DETAILS & NOTES
31	HIGH SPEED UNDIVIDED HIGHWAY WORK ZONE SIGNING PLAN, DETAILS & NOTES

STATE OF HAWAII  
DEPARTMENT OF TRANSPORTATION  
HIGHWAYS DIVISION  
HONOLULU, HAWAII  
PLANS FOR  
**KUHIO HIGHWAY**  
**GUARDRAIL AND SHOULDER IMPROVEMENTS**  
**AT VARIOUS LOCATIONS**  
**FEDERAL AID PROJECT NO. STP-056-1(49)**  
DISTRICTS OF LIHUE, KAWAIHAU AND HANAIEI  
ISLAND OF KAUAI

FED. ROAD DIST. NO.	STATE	FED. AID PROJ. NO.	FISCAL YEAR	SHEET NO.	TOTAL SHEETS
HAWAII	HAW.	STP-056-1(49)	2006	1	31

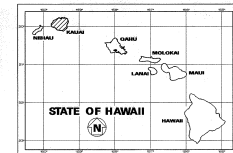

**PROJECT LOCATION**

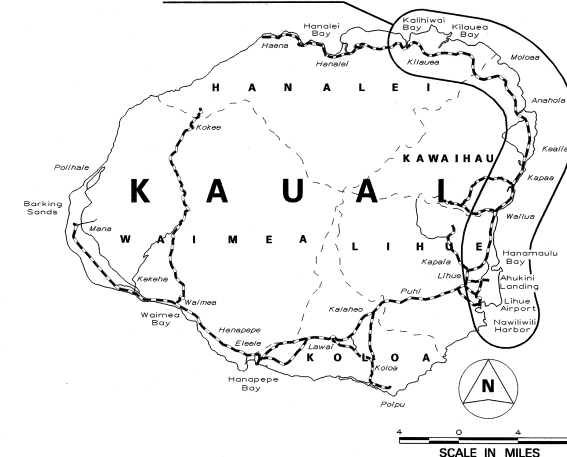

--- FEDERAL AID PROJECTS PREVIOUSLY CONSTRUCTED OR UNDER CONSTRUCTION

MILE POST 0.00 TO MILE POST 28.11

**DESIGN DESIGNATION**

	KAPULE HIGHWAY TO KUAMOO ROAD	KAWAIHAU ROAD TO MALIHUNA ROAD	KOLO ROAD TO KALIHUWAI ROAD
ADT (2005)	31,400	14,500	12,700
ADT (2025)	37,700	20,700	19,800
DHV	3,020	1,660	1,980
D	60/40	50/50	55/45
T	2.0%	2.0%	2.0%
V	35 - 50 M.P.H.	35 - 50 M.P.H.	35 - 50 M.P.H.

CHANGES MADE DURING CONSTRUCTION HAVE BEEN INCORPORATED ON THESE PLANS EXCEPT CHANGES IN THE ORIGINAL THEORETICAL QUANTITIES. FOR ACTUAL QUANTITIES, REFER TO PROJECT LEDGER AND/OR COMPUTATION BOOK.

9/25/05

DEPARTMENT OF TRANSPORTATION  
STATE OF HAWAII

APPROVED:  
10-17-05  
DIR. OF TRANSPORTATION DATE

DESIGNED BY  
MANAGED BY  
241-3016  
OCT 2005  
DATE

