
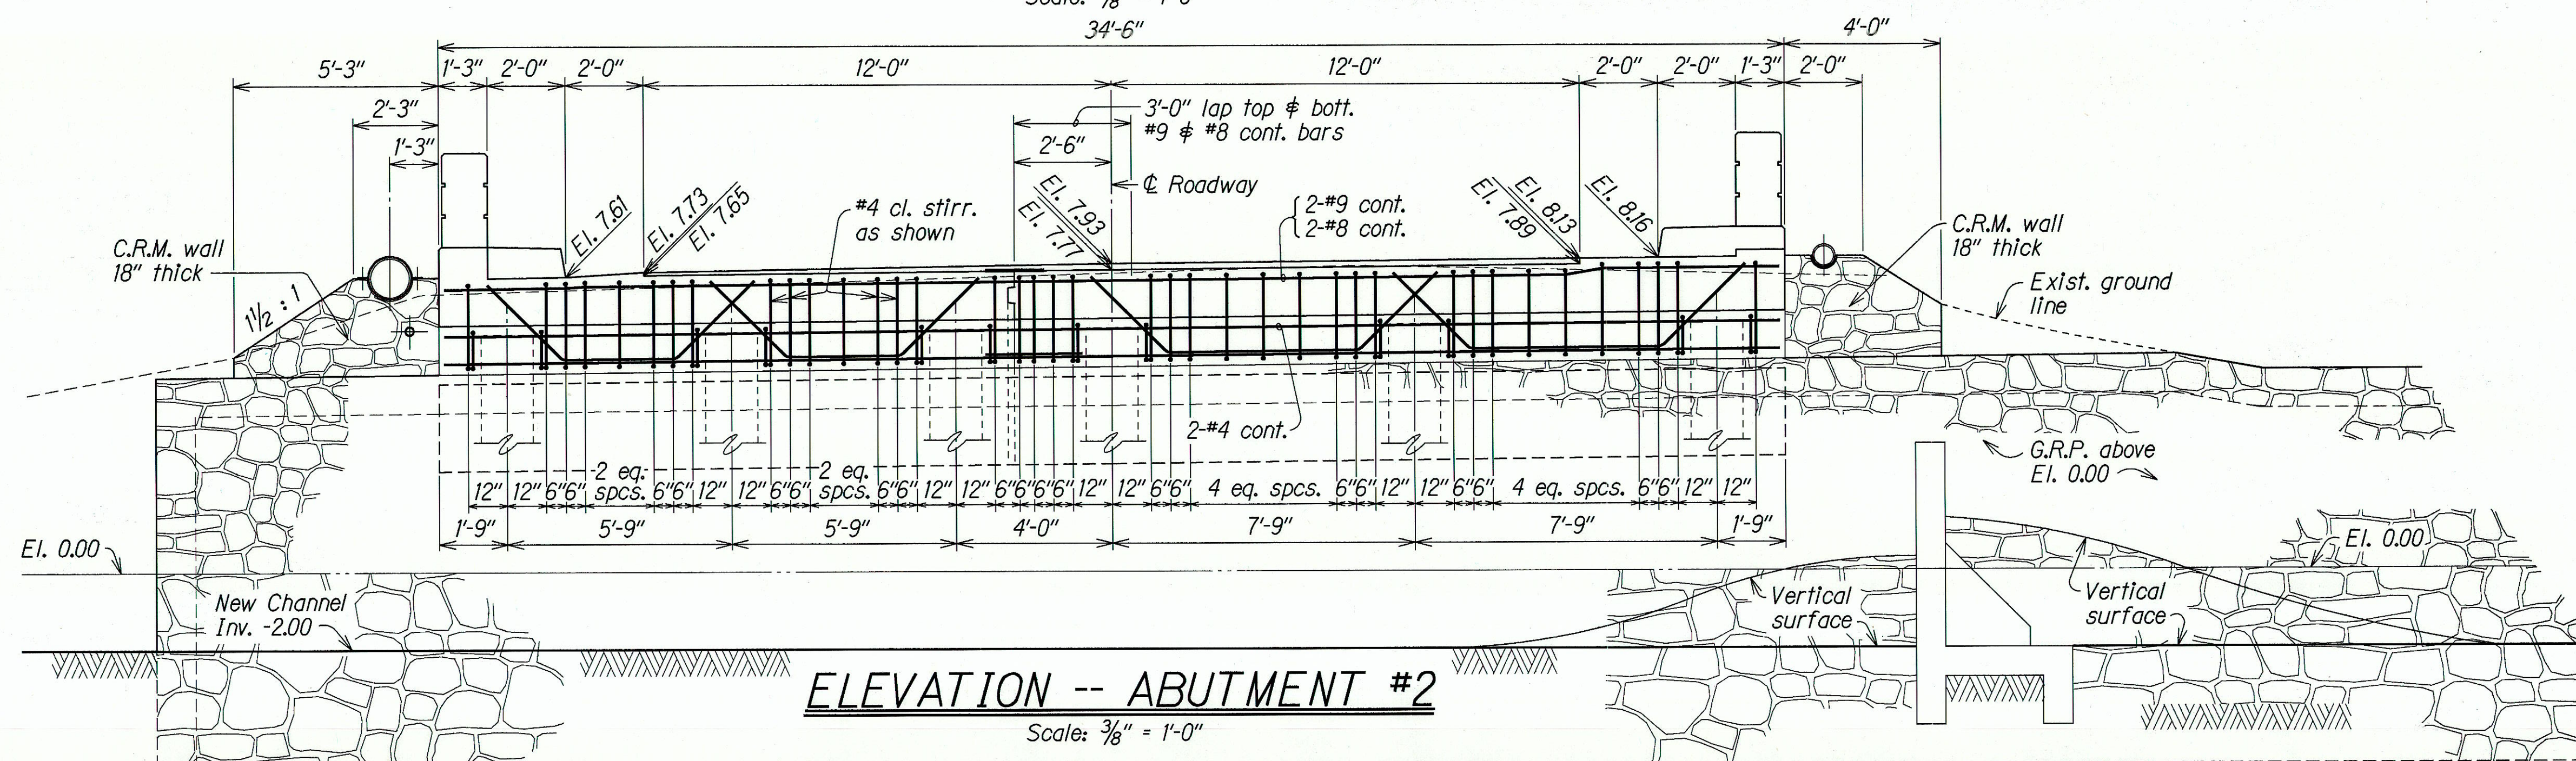
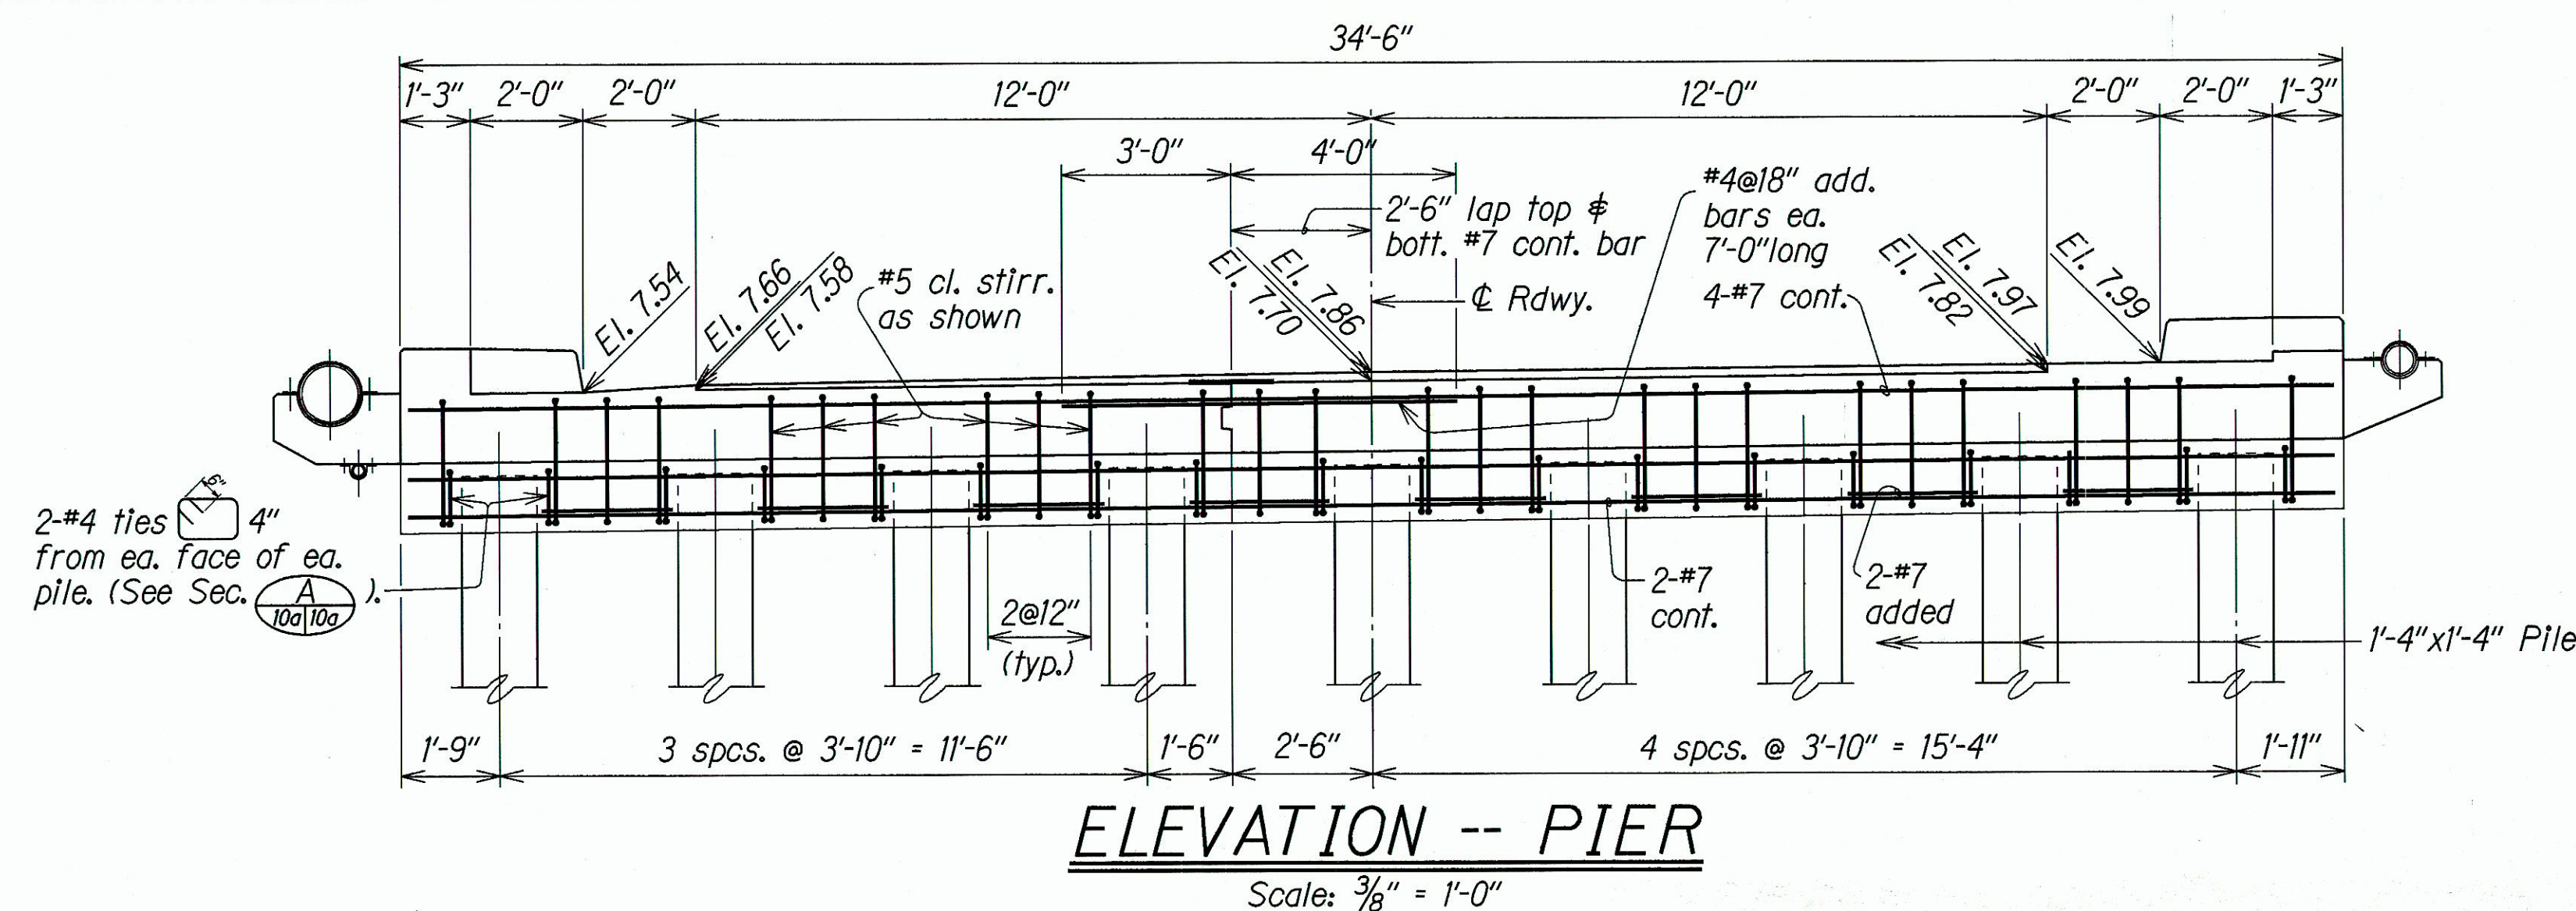


FED. ROAD DIST. NO.	STATE	PROJ. NO.	FISCAL YEAR	SHEET NO.	TOTAL SHEETS
HAWAII	HAW.	04-23-0068.2	1990		

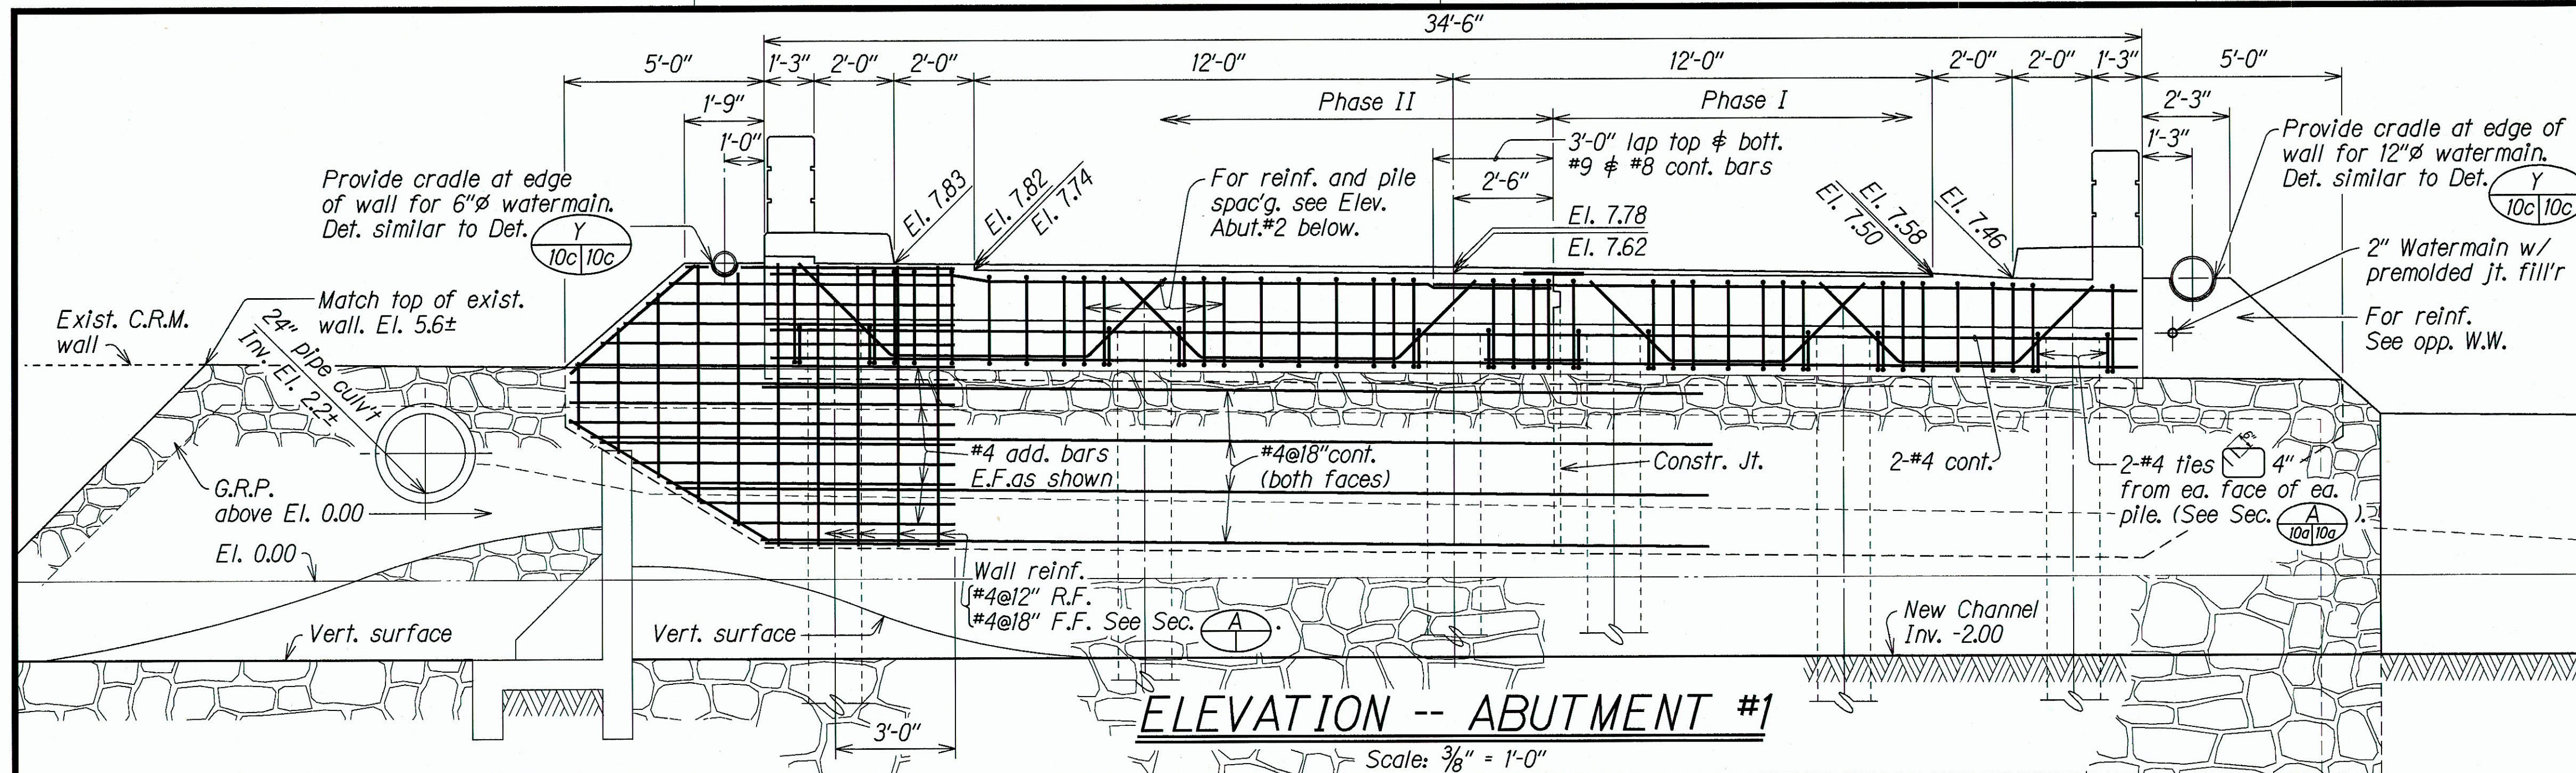

NOTE: (REPRODUCED SH)
THIS DRAWING HAS NOT BEEN
CHECKED FOR ACCURACY
S.M. YONG

ADVANCE PRINTS
SUBJECT TO CHANGE JUN 21, 1990

STATE OF HAWAII
DEPARTMENT OF TRANSPORTATION
HIGHWAYS DIVISION
ELEVATION--ABUTMENT NOS. 1 & 2
AND ELEVATION--PIER
WAIPOULI CANAL BRIDGE--STA. 31+89.57
CONSTRUCTION OF CANALS AT WAIPOULI,
KAWAII, KAUAI
Proj. No. 04-23-0068.2
Date: Mar 1992

Scale: As Noted SHEET No. 10b OF SHEETS

JUN 21 1990

ORIGINAL PLAN	DATE: JUN 1990
DESIGNED BY	
CHECKED BY	
IN CHARGE BY	
NOTED BY	
WAIPOULI	