


FED. ROAD DIST. NO.	STATE	FED-AID PROJ. NO.	FISCAL YEAR	SHEET NO.	TOTAL SHEETS
HAWAII	HAW.	56A-03-21	2022	10	11

TRUE NORTH
SCALE : 1" = 20'

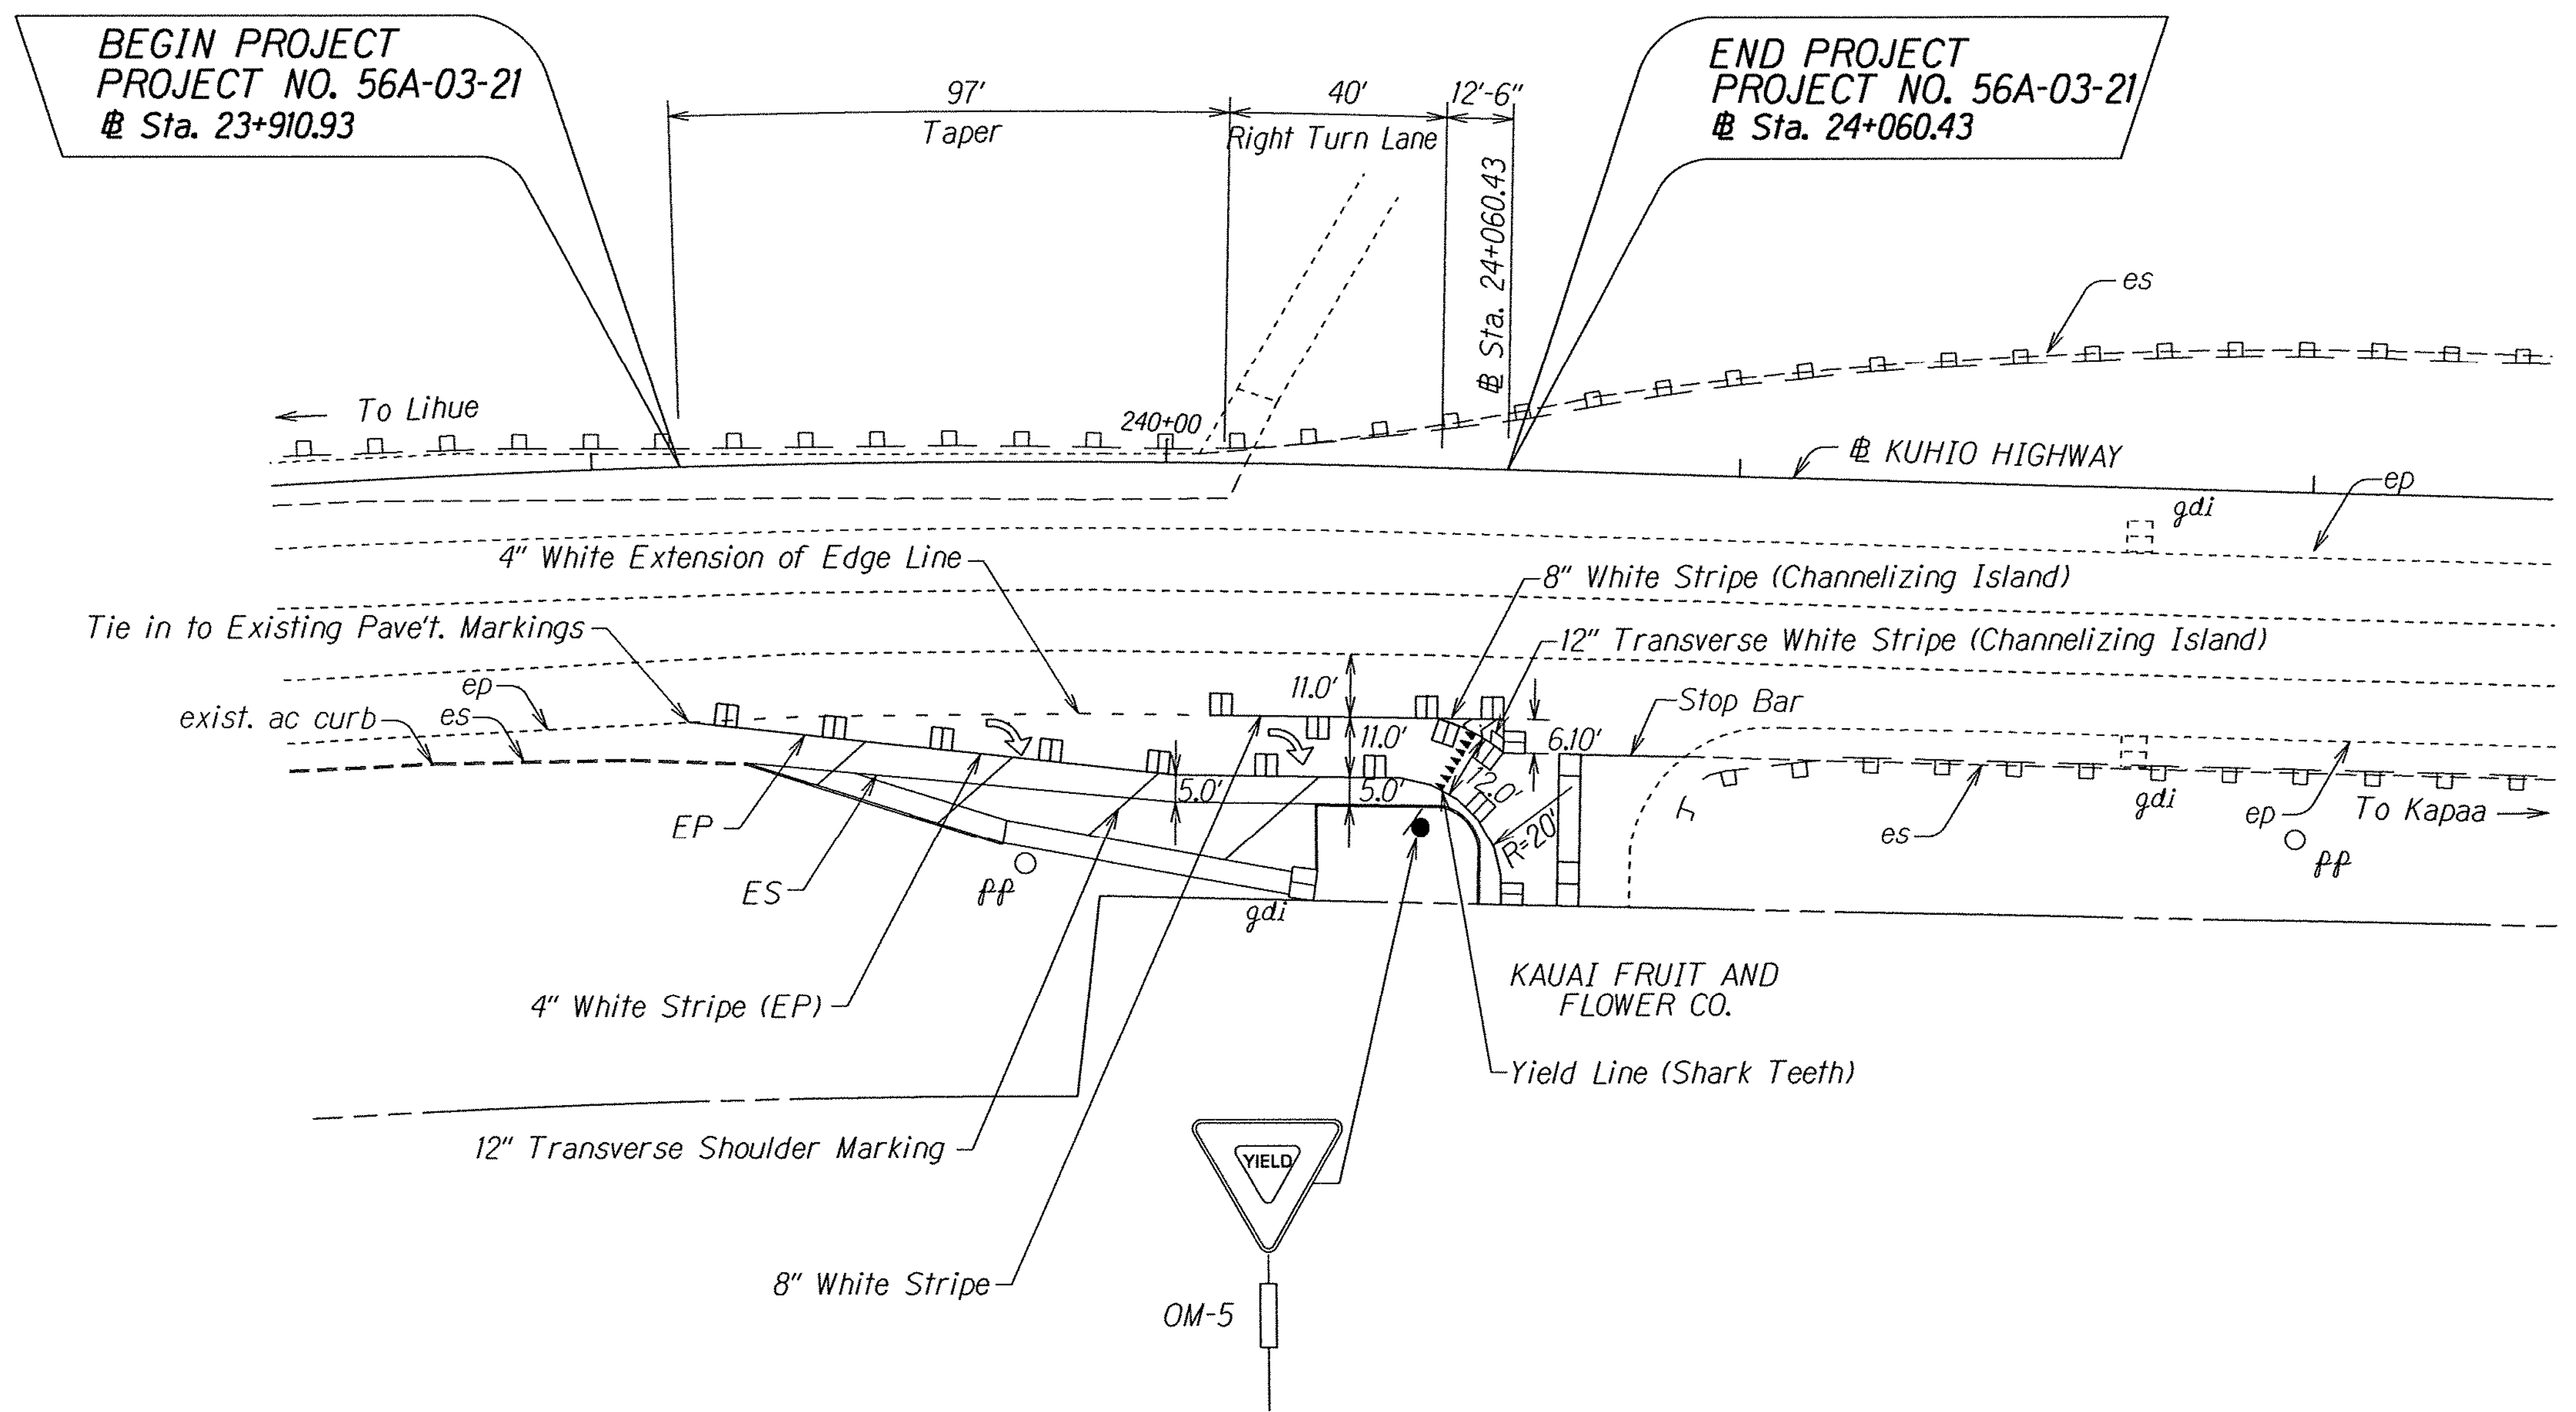

DESIGNED BY	DATE
DRAWN BY	
CHECKED BY	
IN CHARGE	
NOTED	
DATE	
BY	
NO.	

STATE OF HAWAII
DEPARTMENT OF TRANSPORTATION
HIGHWAYS DIVISION

PAVEMENT MARKING
TRAFFIC SIGNING PLAN

KUHIO HIGHWAY DRAINAGE IMPVT.
Vicinity of Kapule Highway
Project No. 56A-03-21

Scale: 1" = 20' Date: September 2021