

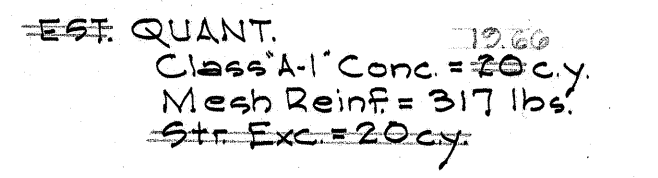
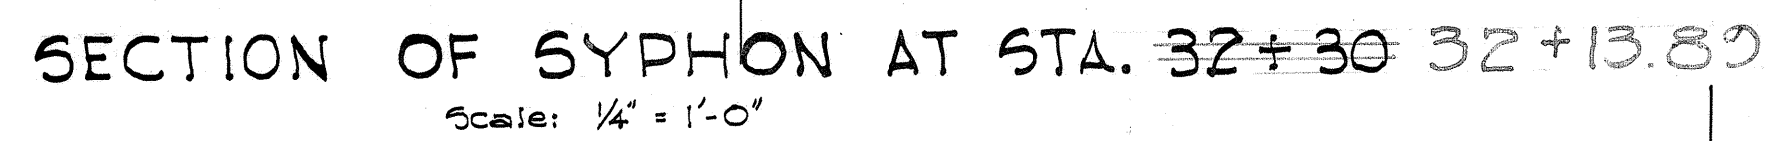


EST. QUANT. 7.04
Class "B1" Conc. = 33 cy.
Str. Exc. = 87 cy. 89 cy.
24" E.S. R.C.C. Pipe = 84 lin. ft.

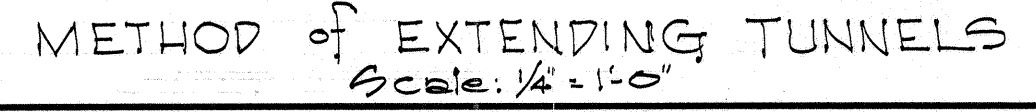

NOTE: Tractor Crossing shall conform to Pavt. grade crown and shoulder slope.

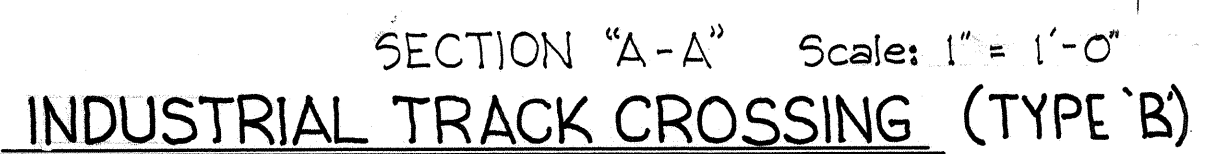

TERRITORIAL HIGHWAY DEPARTMENT
TERRITORY OF HAWAII
DETAIL OF SYPHON, INDUSTRIAL
TRACK CROSSING, AND TRACTOR
CROSSING.
PROJECT NO. 5254 (1)
Scale: As Noted
Feb. 1934.
SHEET NO OF SHEETS