


25-46

FED. ROAD DIST. NO.	STATE	FED. AID PROJ. NO.	FISCAL YEAR	SHEET NO.	TOTAL SHEETS
HAWAII	HAW	5254(1)	1954	9	32


PLAN	DATE	BY	CHECKED
DESIGNED			
PLOTTED			
NOTE BOOK, CHECKED			
NO. OF VMS CHECKED			

PROFILE	DATE	BY	CHECKED
DESIGNED			
PLOTTED			
NOTE BOOK, CHECKED			
NO. OF VMS CHECKED			

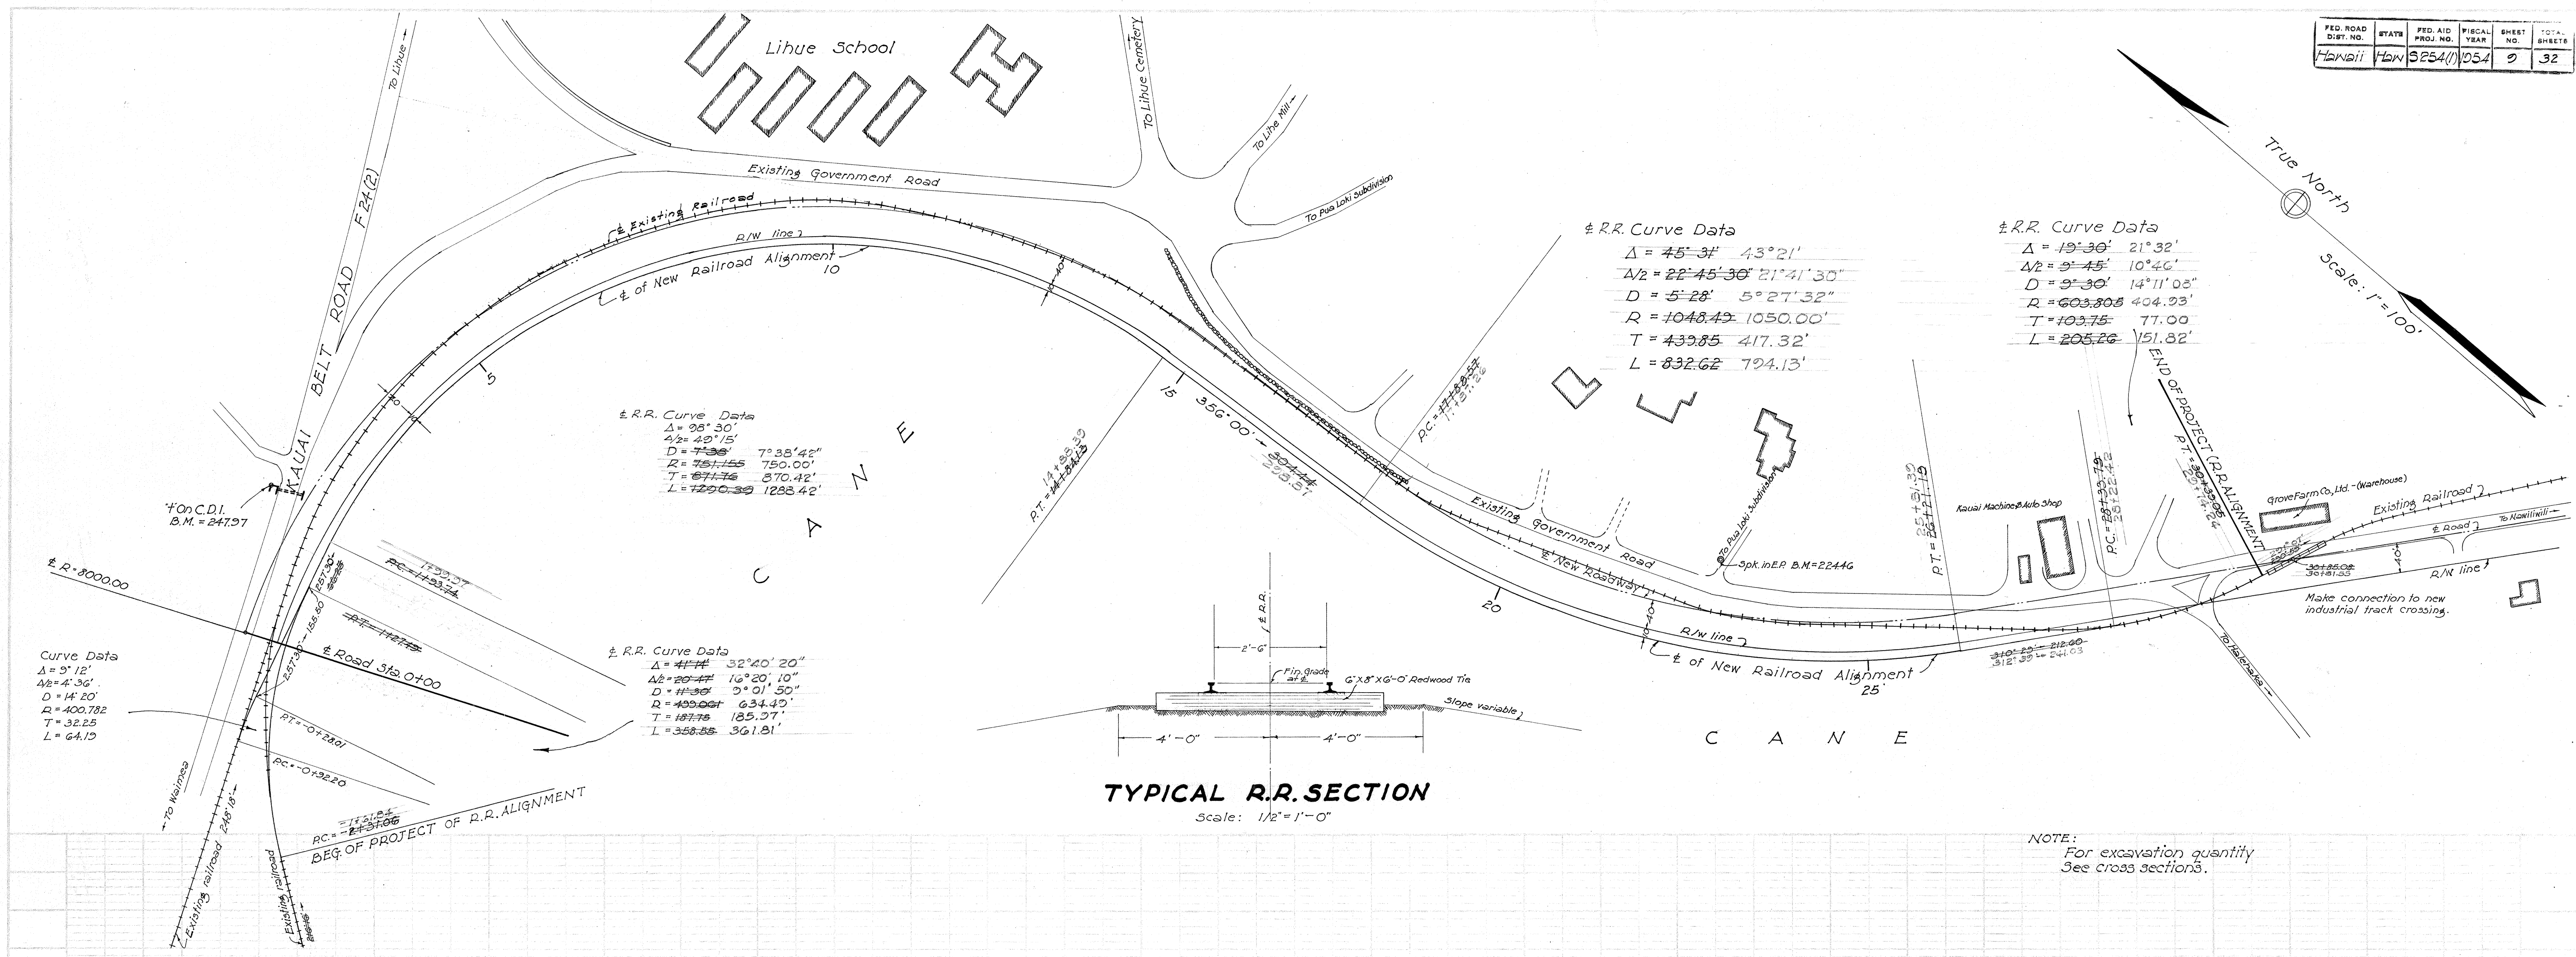

TYPICAL R.R. SECTION
Scale: 1/2" = 1'-0"

NOTE:
For excavation quantity
See cross sections.

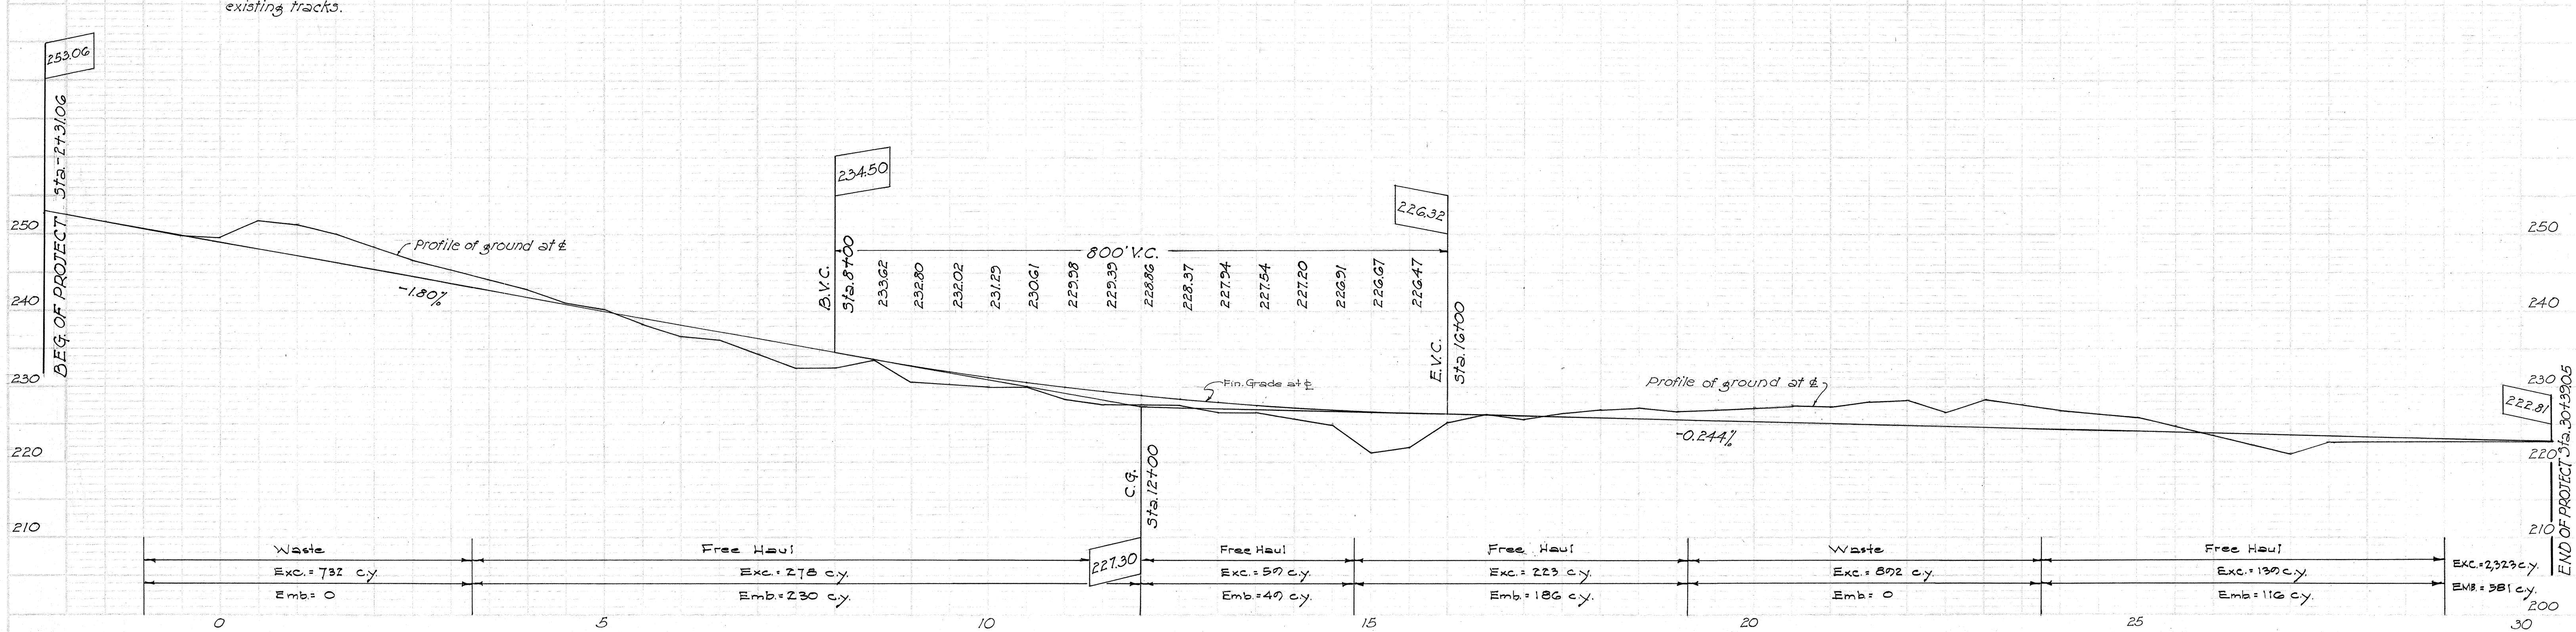

5668.9