

TERRITORY OF HAWAII
TERRITORIAL HIGHWAY DEPARTMENT
HONOLULU T. H.

PLANS OF
WILCOX ROAD

FEDERAL AID SECONDARY PROJECT NO. S 254(I)
DISTRICT OF LIHUE
ISLAND OF KAUAI



INDEX TO DRAWINGS	
SHEET NO.	DESCRIPTIONS
1	Title Sheet
2	Typical Section
3-6	Plan and Profile
7	Detail of Connection
8	Soil Profile
9	Realignment of Rail Road
10	Detail of Railway Signal (Flashing Light Type)
11	Detail of Syphon, Tractor Crossing, & Ind. Track Crossing
12-16	Standard Details
17-34	Cross Sections

FED. ROAD DIST. NO.	STATE	FED. AID PROJ. NO.	FISCAL YEAR	SHEET NO.	TOTAL SHEETS
Hawaii	Haw.	S 254(I)	1954	1	34

CONVENTIONAL SIGNS

Telephone Line	—○—○—○—
Electric Line	—●—●—●—
Existing Road	—+—+—+—
Railroad	—+—+—+—
Culvert	—+—+—+—
Stonewall	—+—+—+—
Fire Hydrant	—+—+—+—
Sidewalk	—+—+—+—
Fence Line	—+—+—+—
Buildings	—+—+—+—

SCALES	
PLAN	1 INCH = 100 FT.
PROFILE	HOR. 1 INCH = 100 FT.
	VER. 1 INCH = 10 FT.
CROSS SECTION	HOR. 1 INCH = 10 FT.
	VER. 1 INCH = 10 FT.

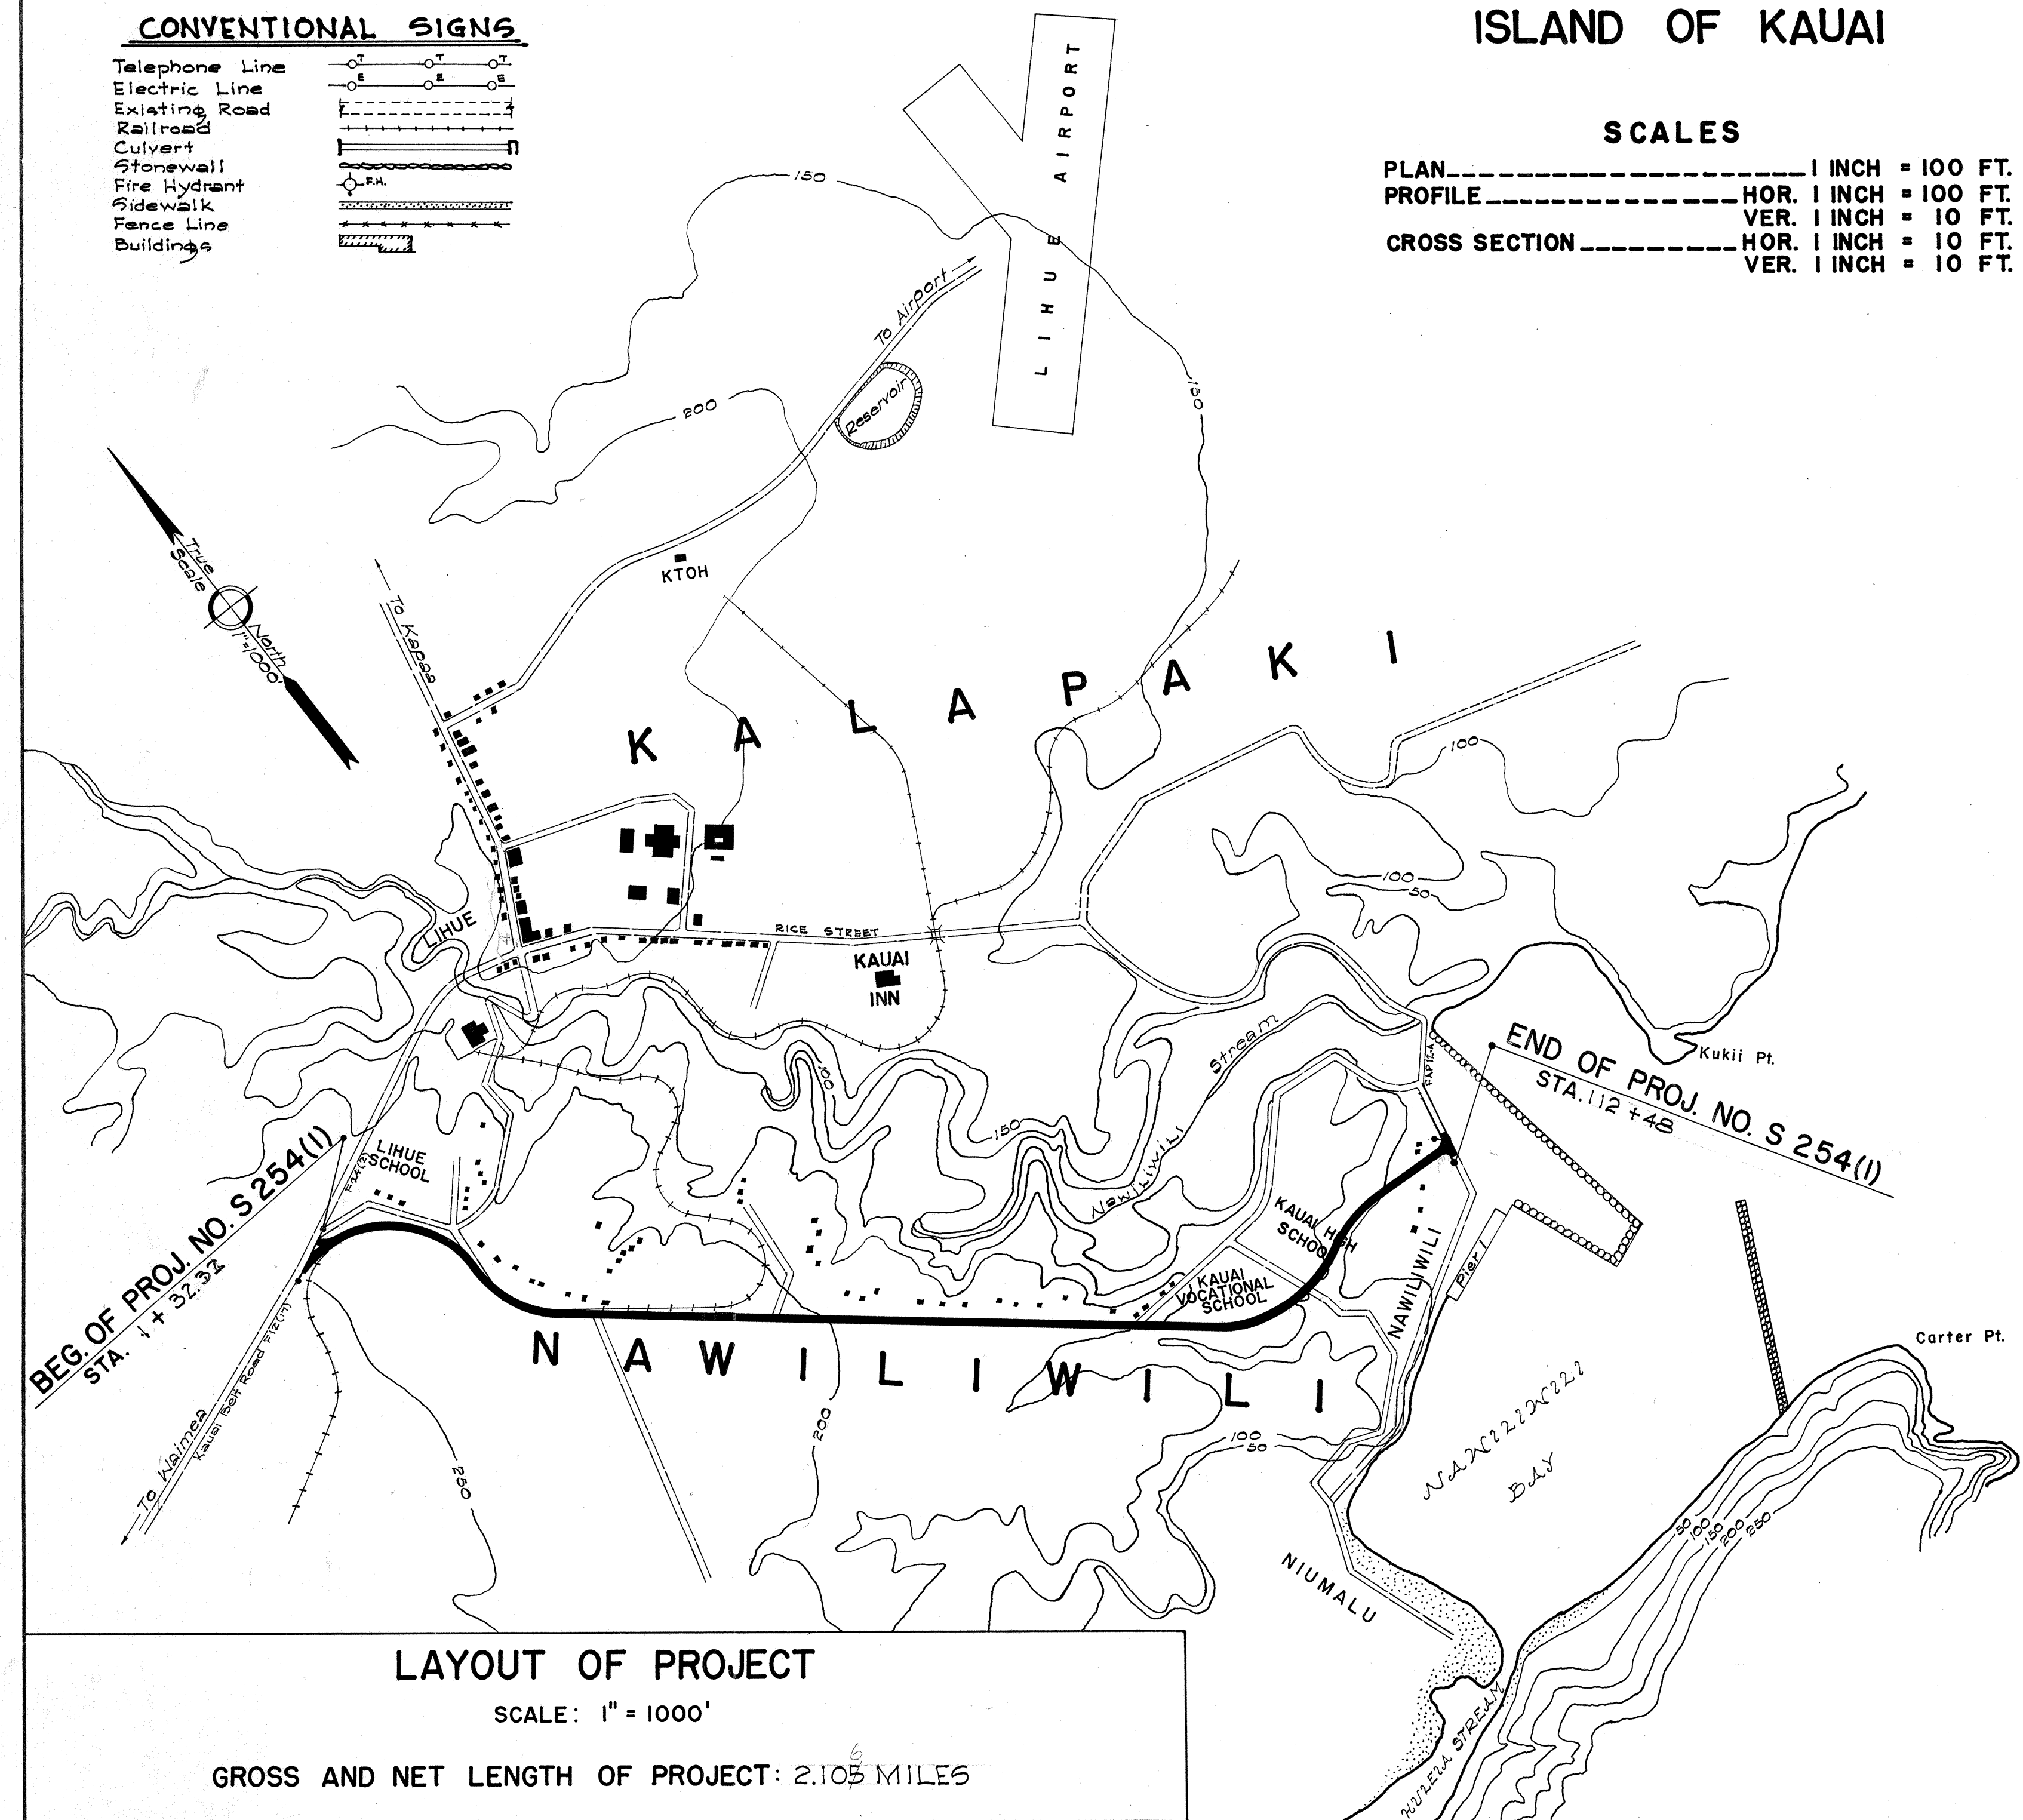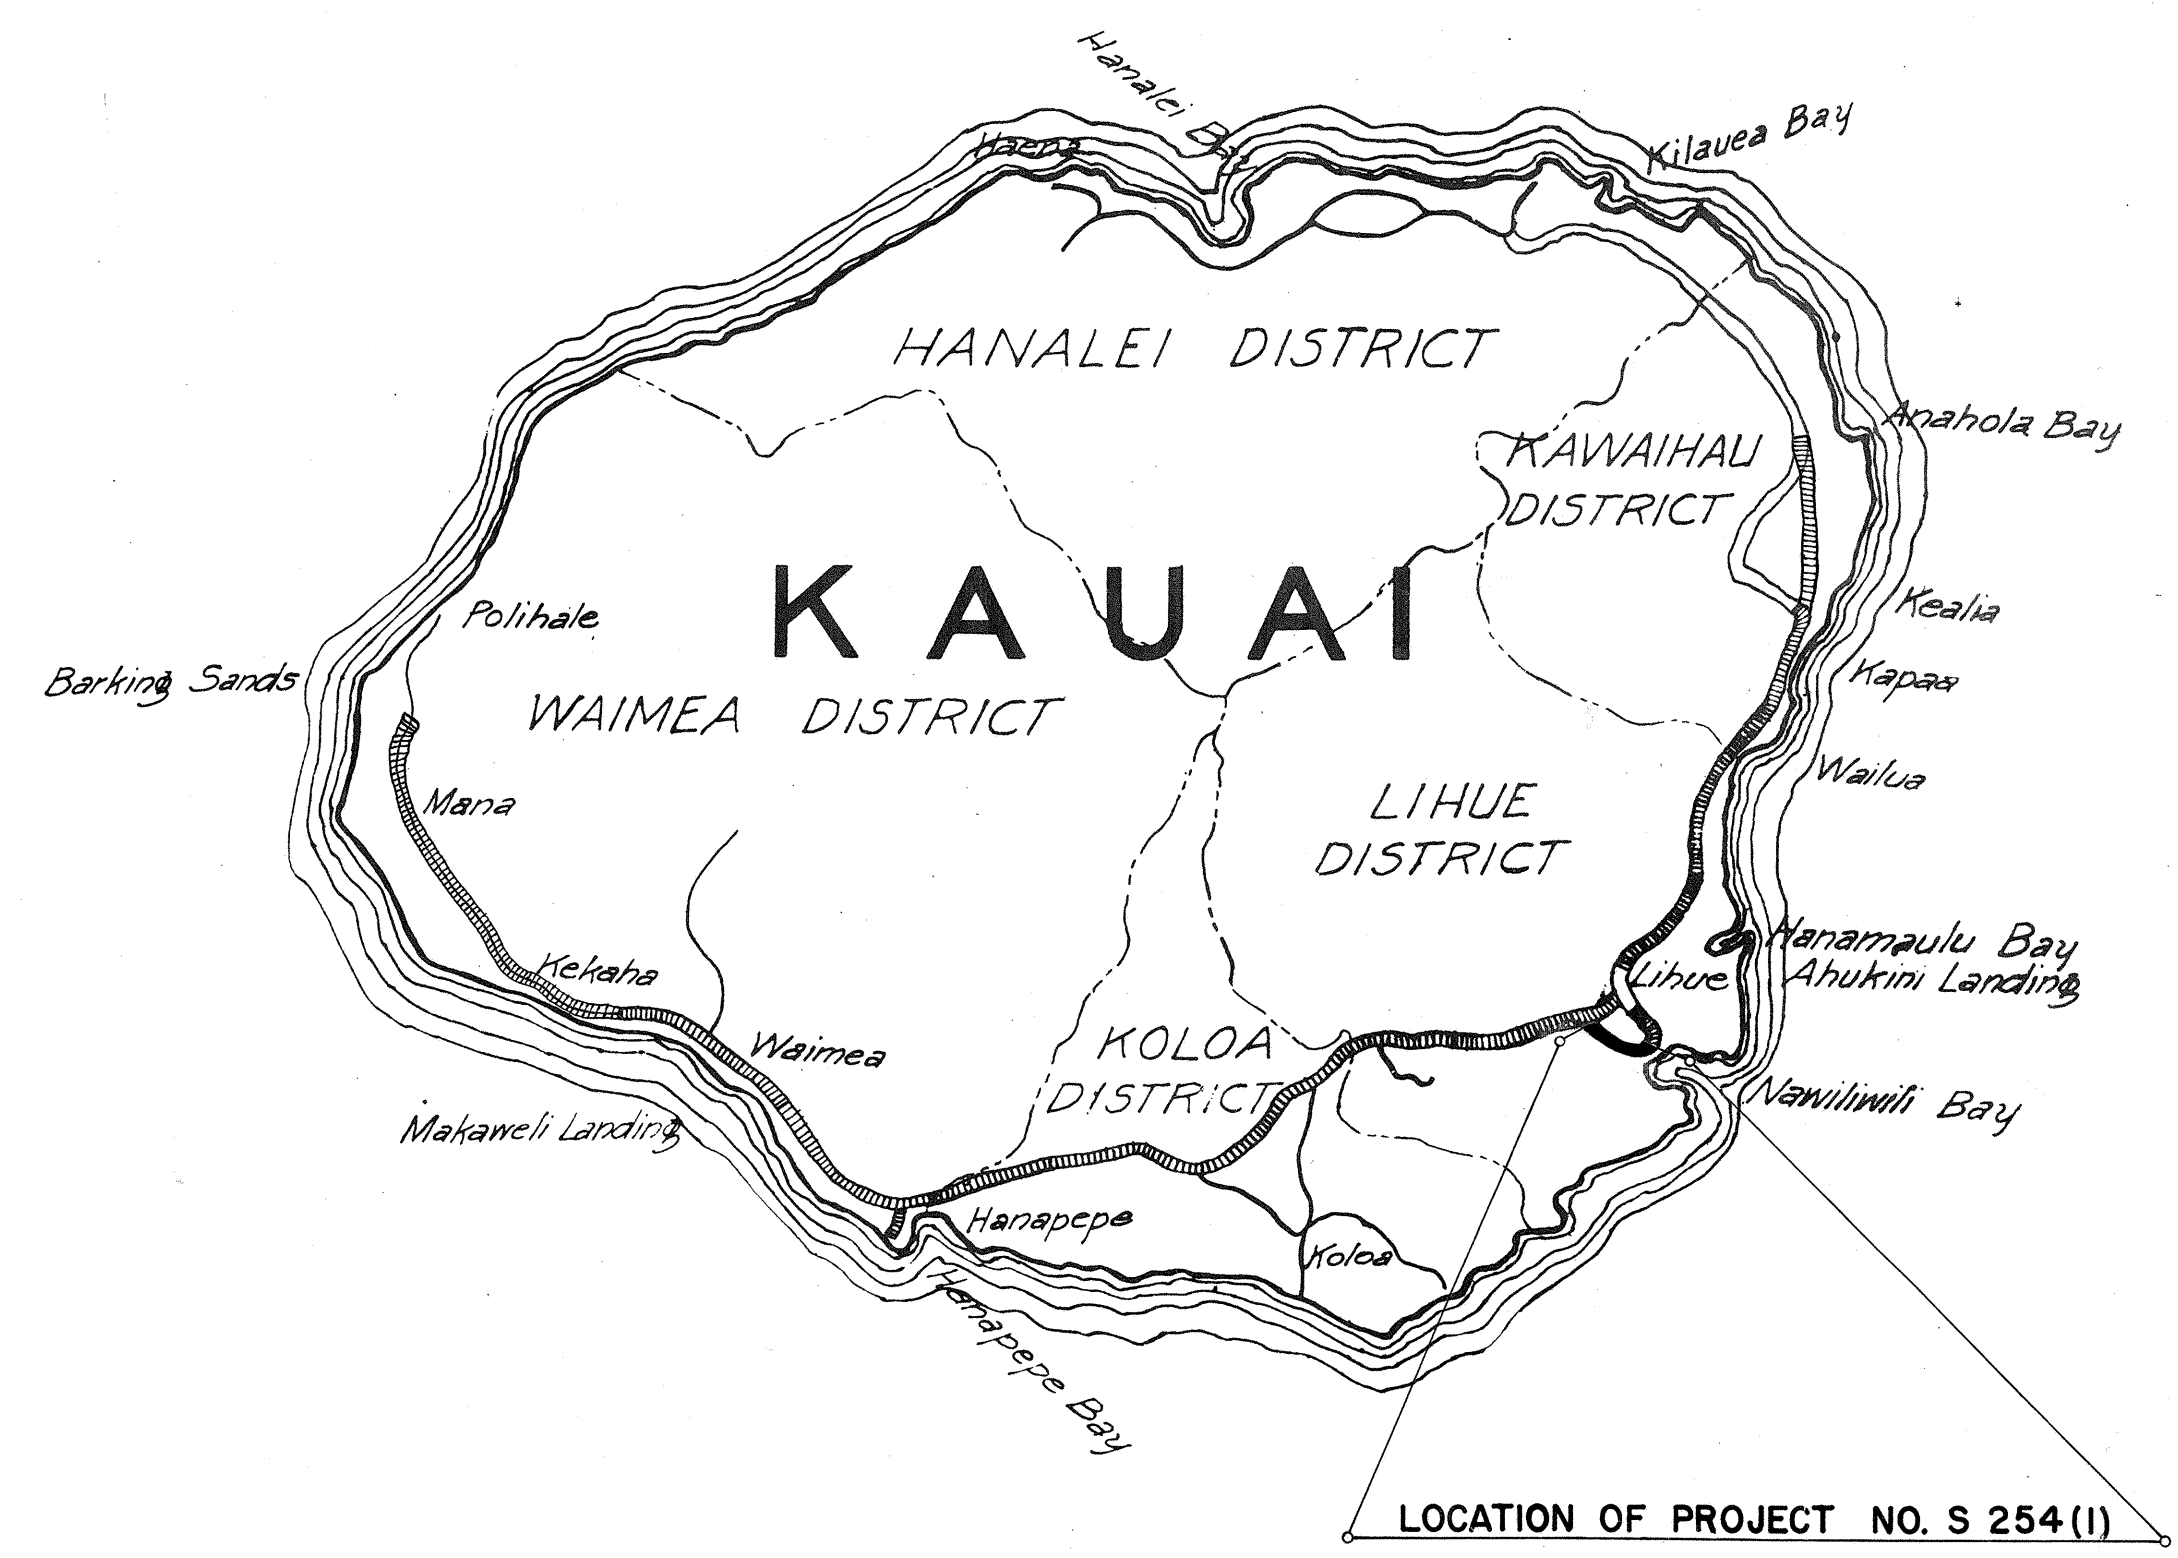

NOTE

ALL CHANGES MADE DURING CONSTRUCTION
HAVE BEEN NOTED IN RED ON THESE
SHEET AND CHECKED BY

John L. Schuman
PROJECT ENGINEER
DATE June 15, 1955

LAYOUT OF PROJECT

SCALE: 1" = 1000'

GROSS AND NET LENGTH OF PROJECT: 2.105 MILES

APPROVED: DATE 4/14/54
Ben E. Hutton
TERRITORIAL HIGHWAY ENGINEER

DEPARTMENT OF COMMERCE
BUREAU OF PUBLIC ROADS
APPROVED: DISTRICT ENGINEER DATE