

INDEX TO DRAWINGS	
SHEET NO.	DESCRIPTION
1	TITLE SHEET
2	TYPICAL SECTION
3-4	PLAN
5-6	DRAINAGE DETAIL
7	PROJECT INFORMATION SIGN

April 1971

Date

548-2456

Phone-Loc

R. Tsuzuki

PS&E By

Kauai District

Designed By

STATE OF HAWAII

DEPARTMENT OF TRANSPORTATION

HIGHWAYS DIVISION

"AS-BUILT"



PLANS FOR

NAWILIWILI ROAD RECONSTRUCTION

PROJECT NO. 58A-01-71

DISTRICT OF LIHUE

ISLAND OF KAUAI

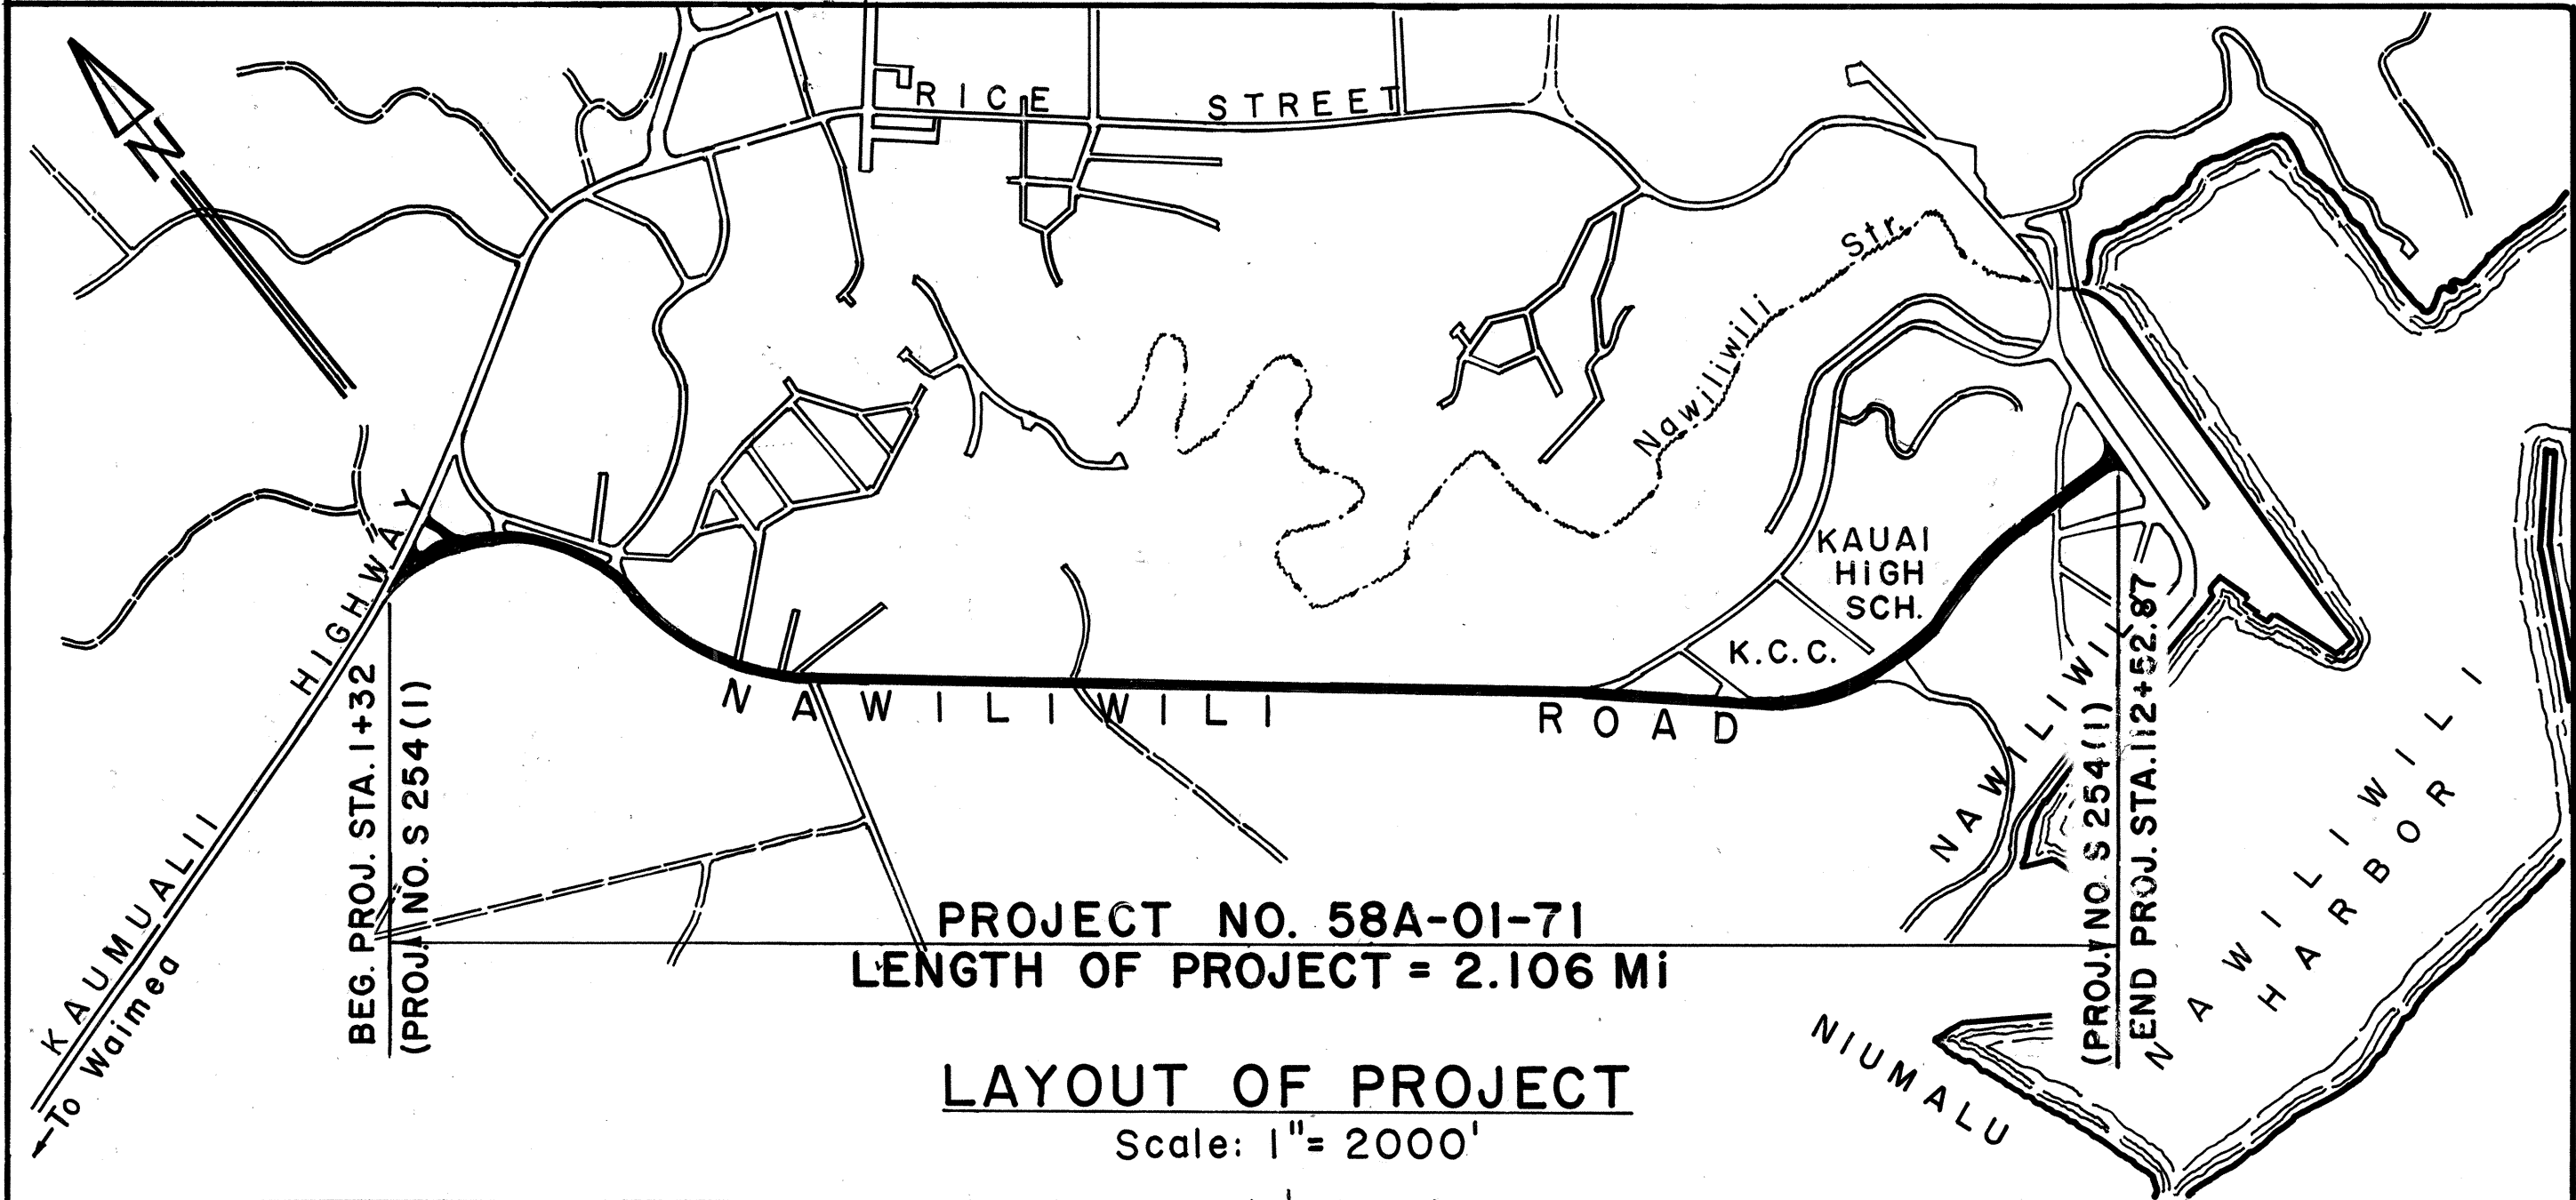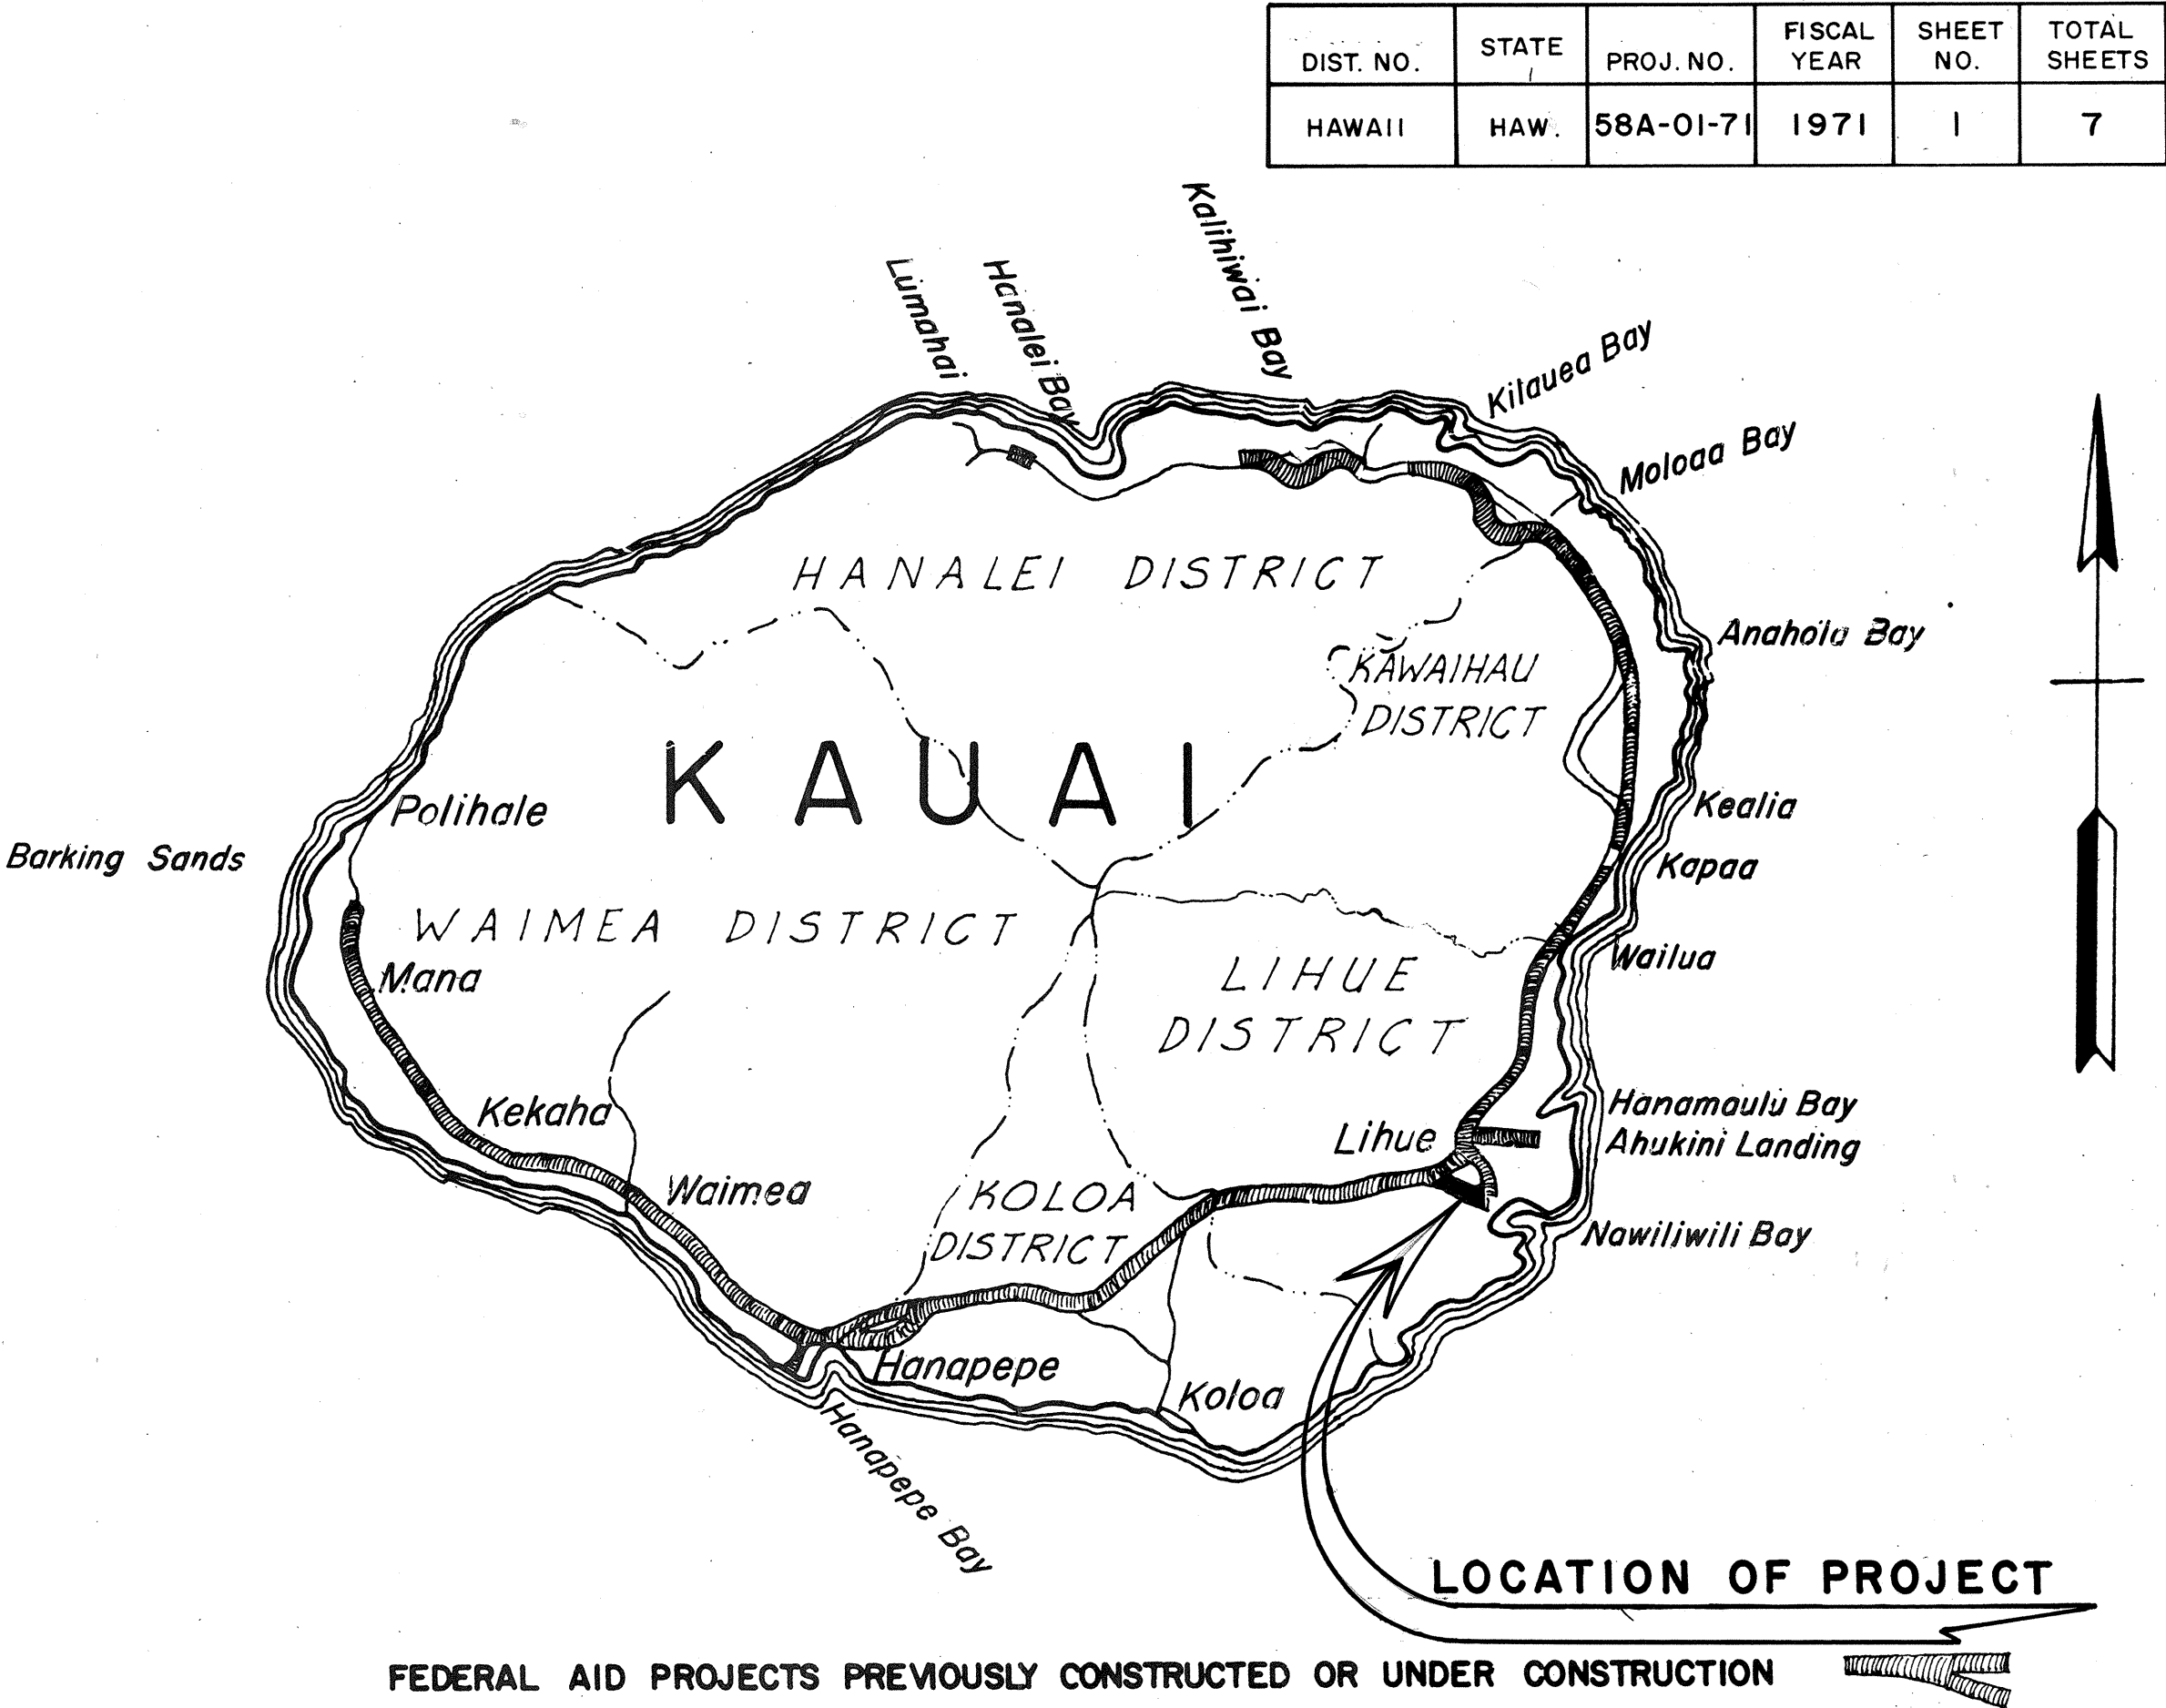

NO CHANGES WERE MADE DURING CONSTRUCTION ON THESE PLANS EXCEPT CHANGES IN THE ORIGINAL THEORETICAL QUANTITIES. FOR ACTUAL QUANTITIES, REFER TO PROJECT LEDGER AND/OR COMPUTATION BOOK.

Donald Nagamine

RESIDENT ENGINEER

7-14-81

DATE

DEPARTMENT OF TRANSPORTATION

STATE OF HAWAII

APPROVED:

6. Alvey Knight

5/11/71

for DIR. OF TRANSPORTATION

DATE