
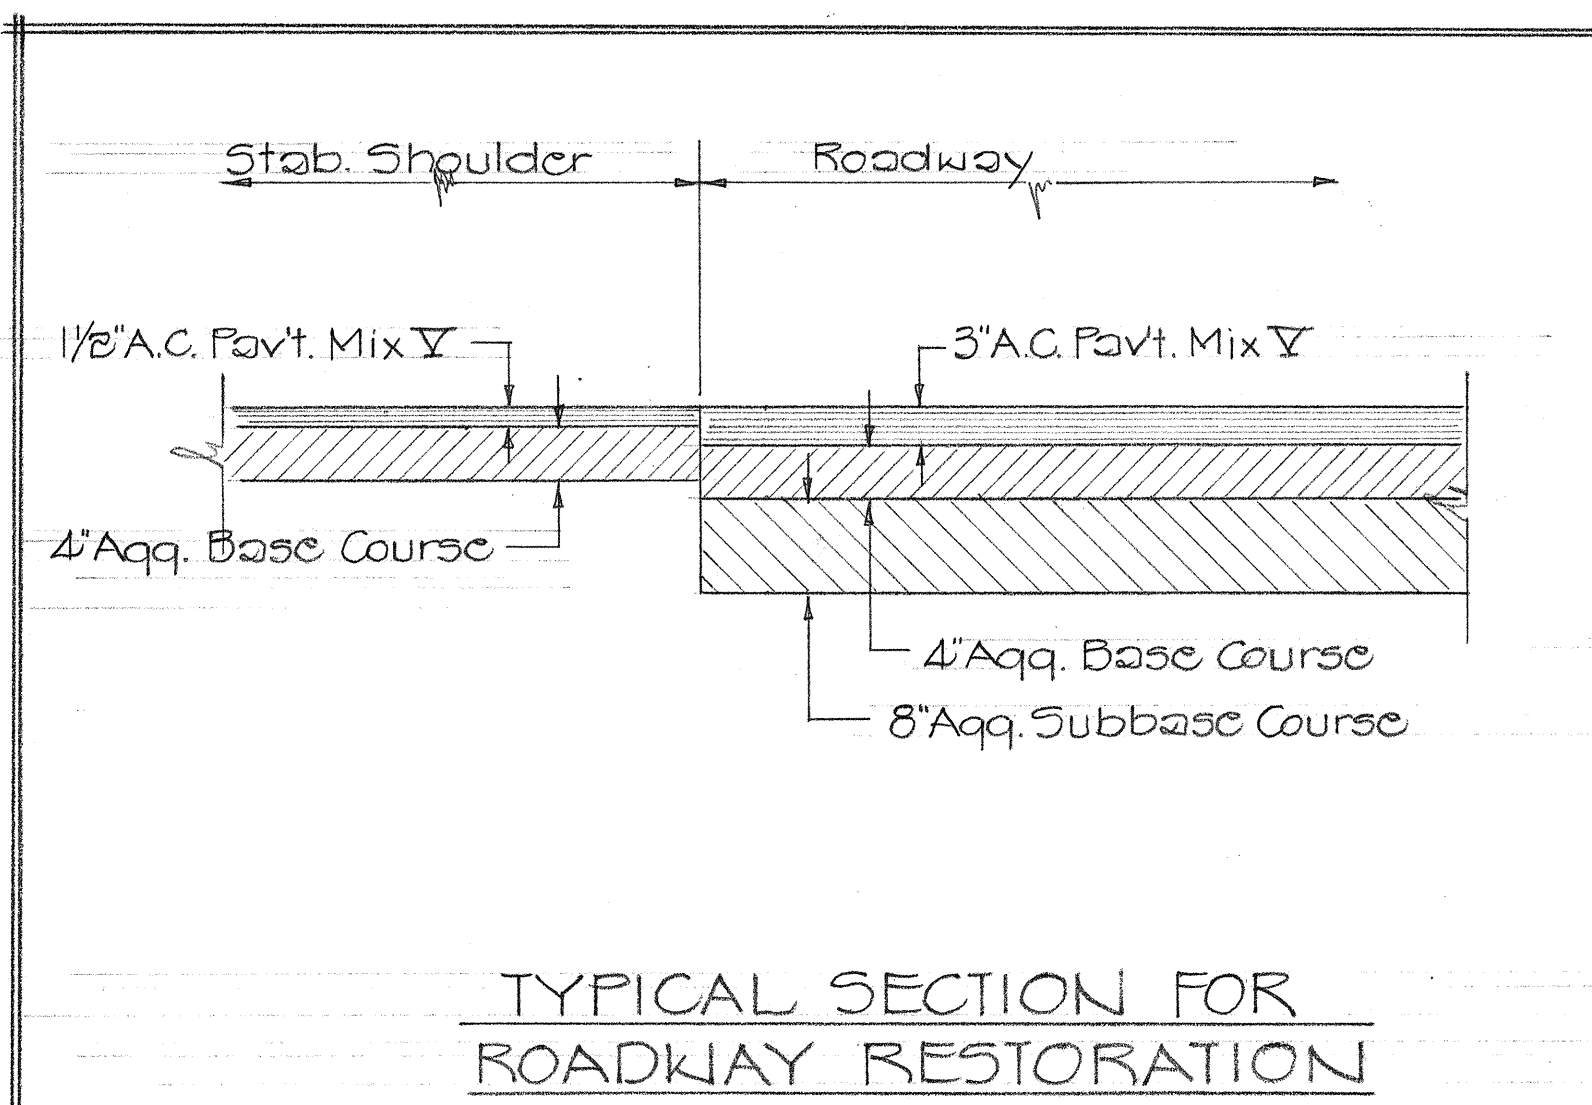
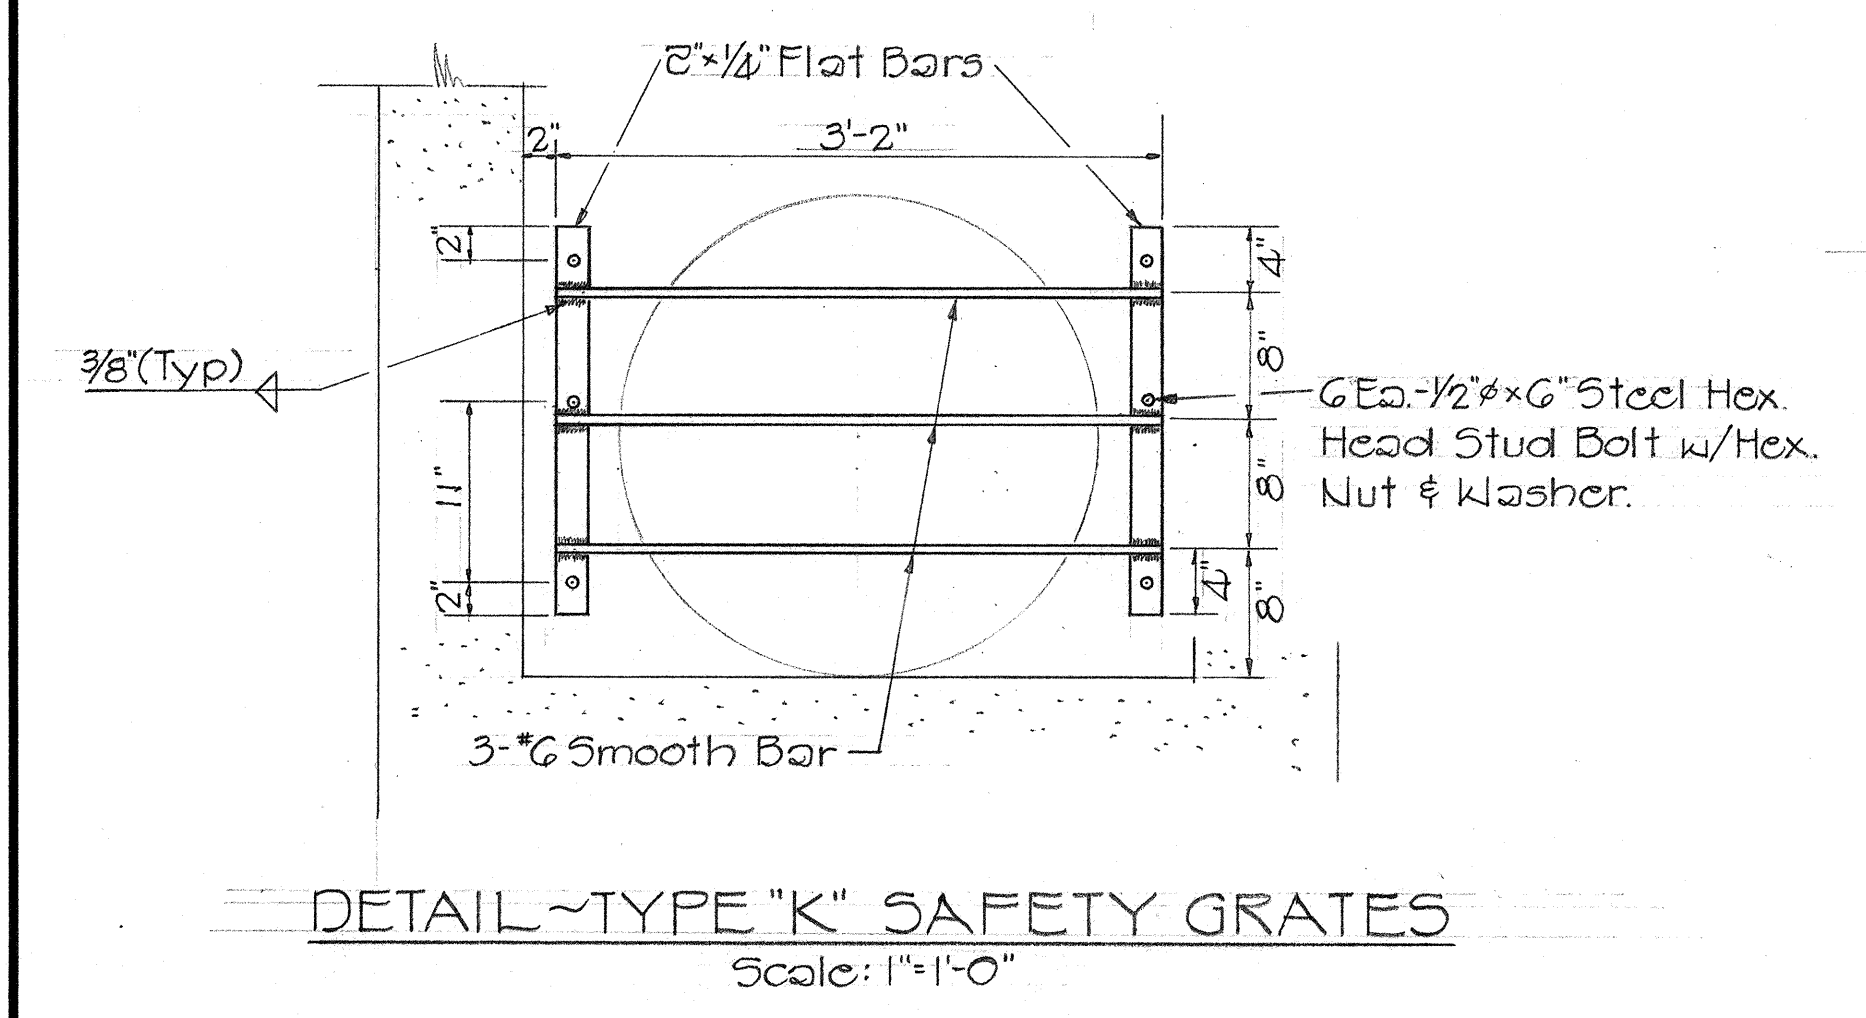
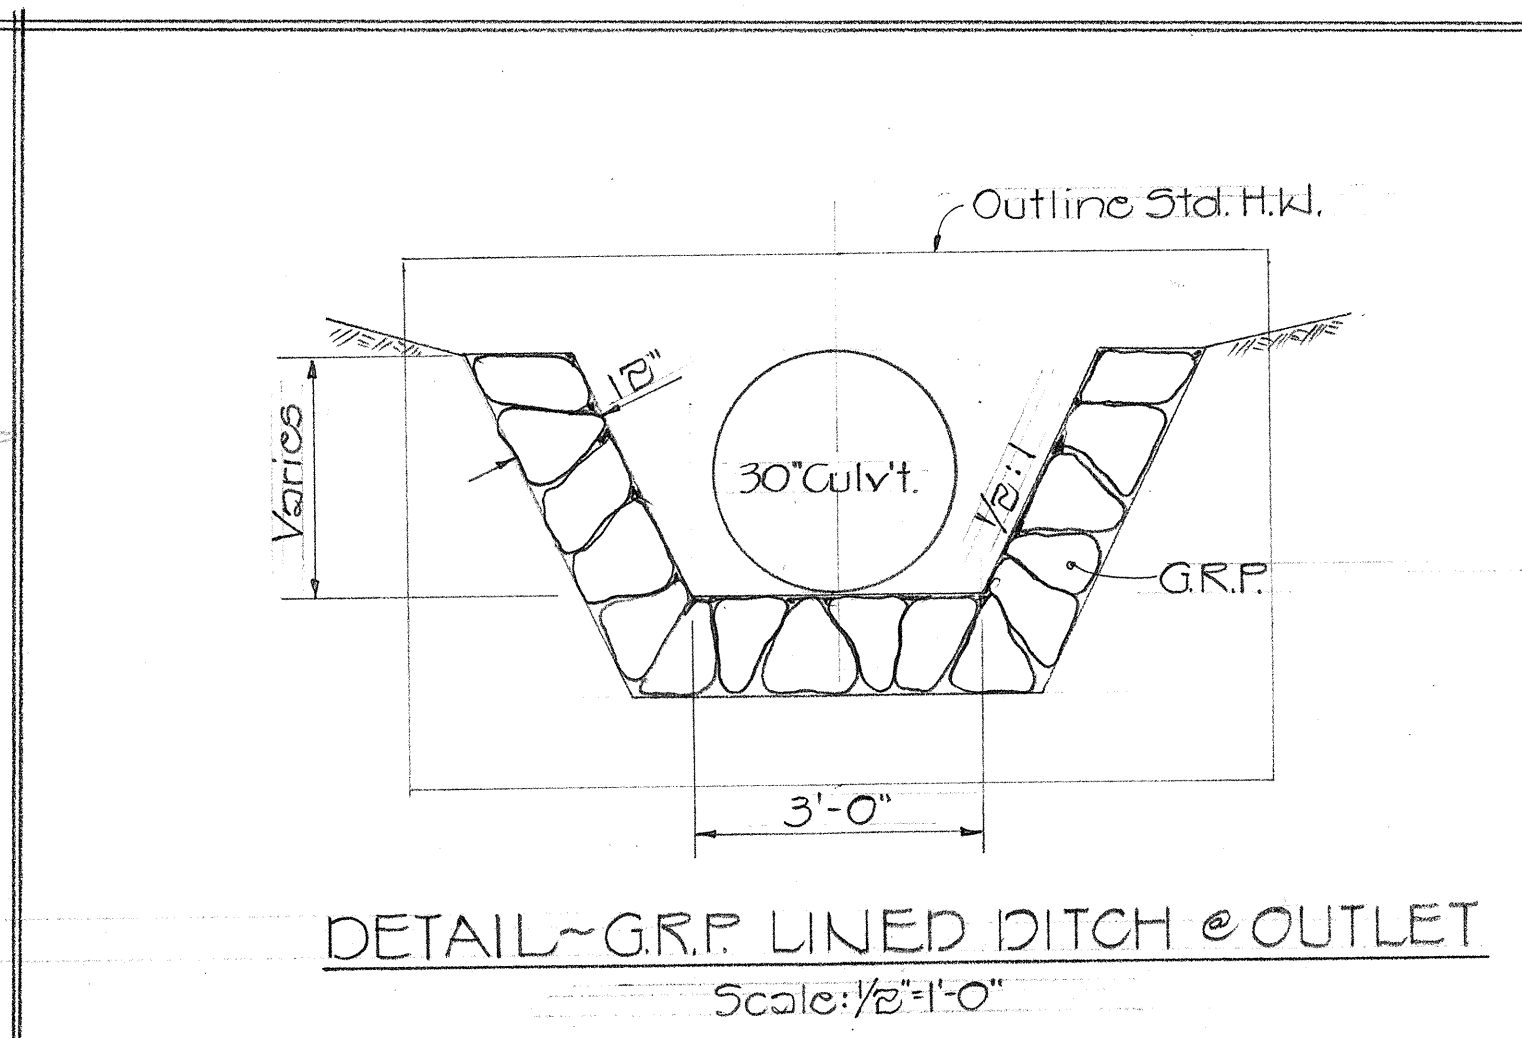
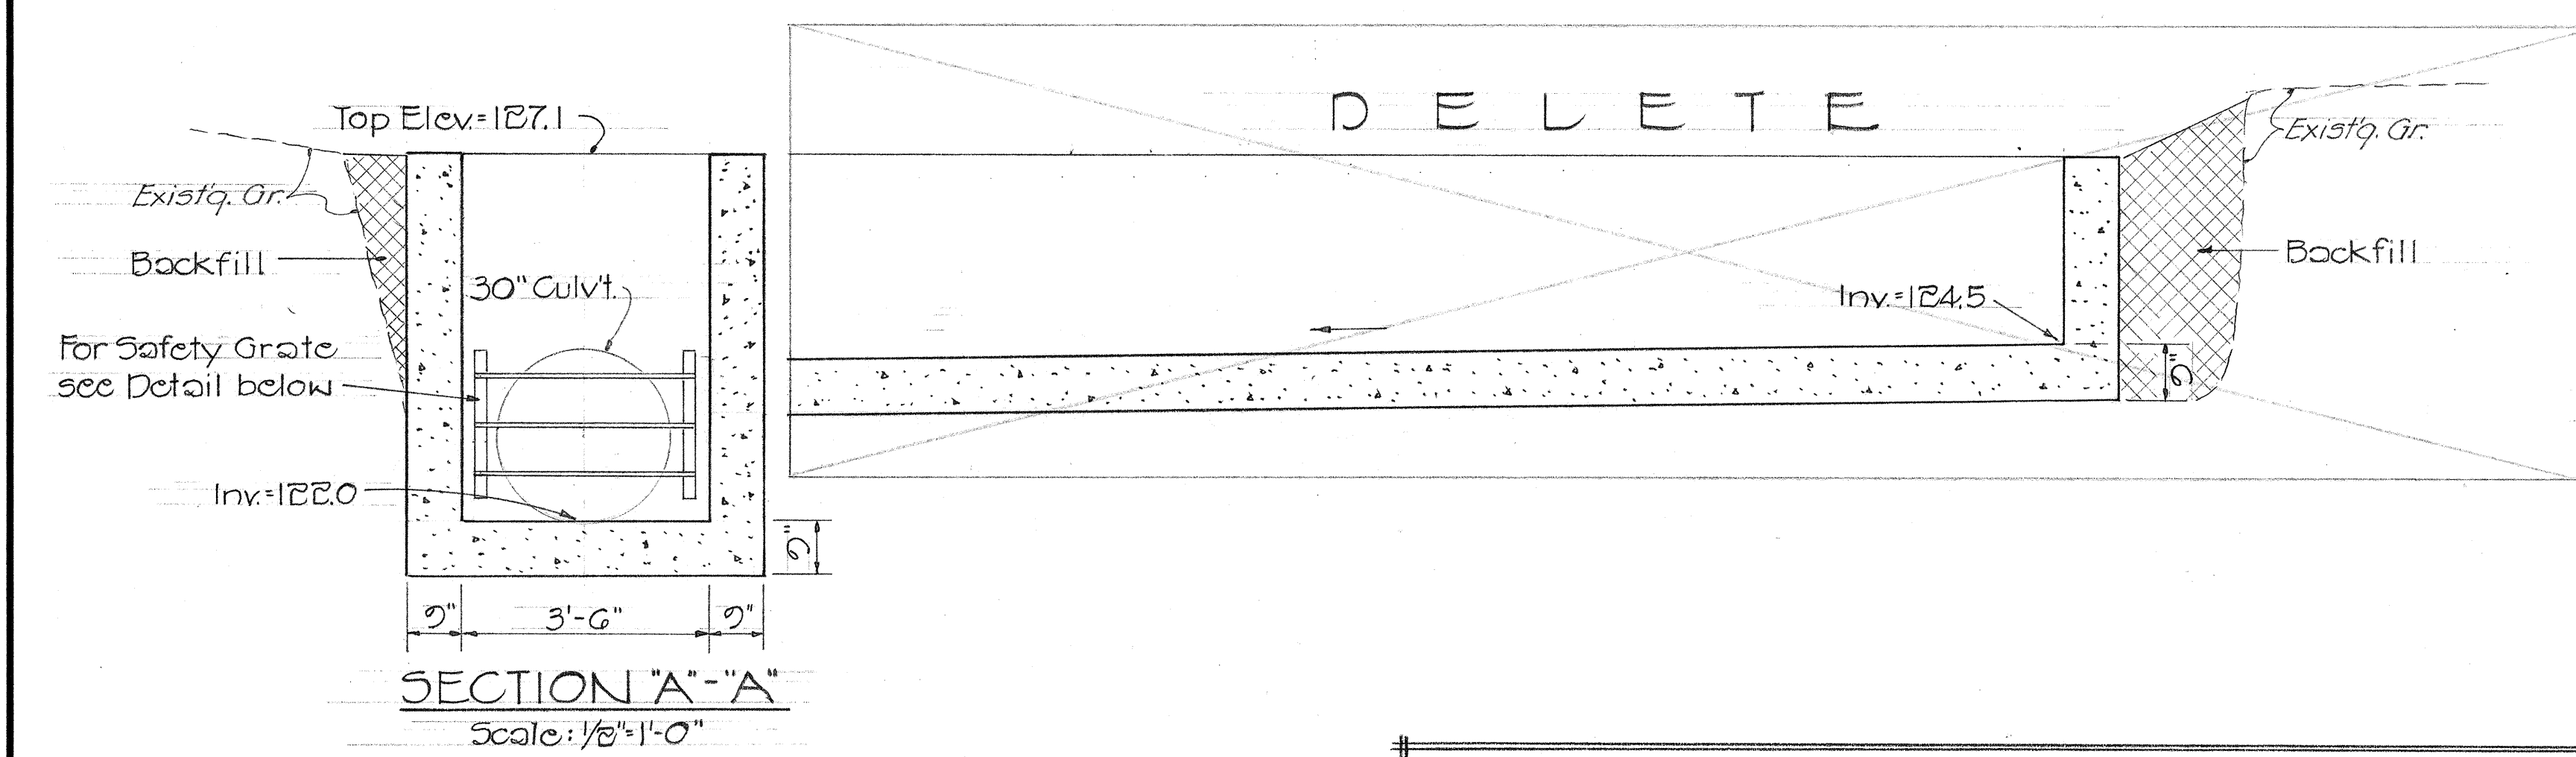
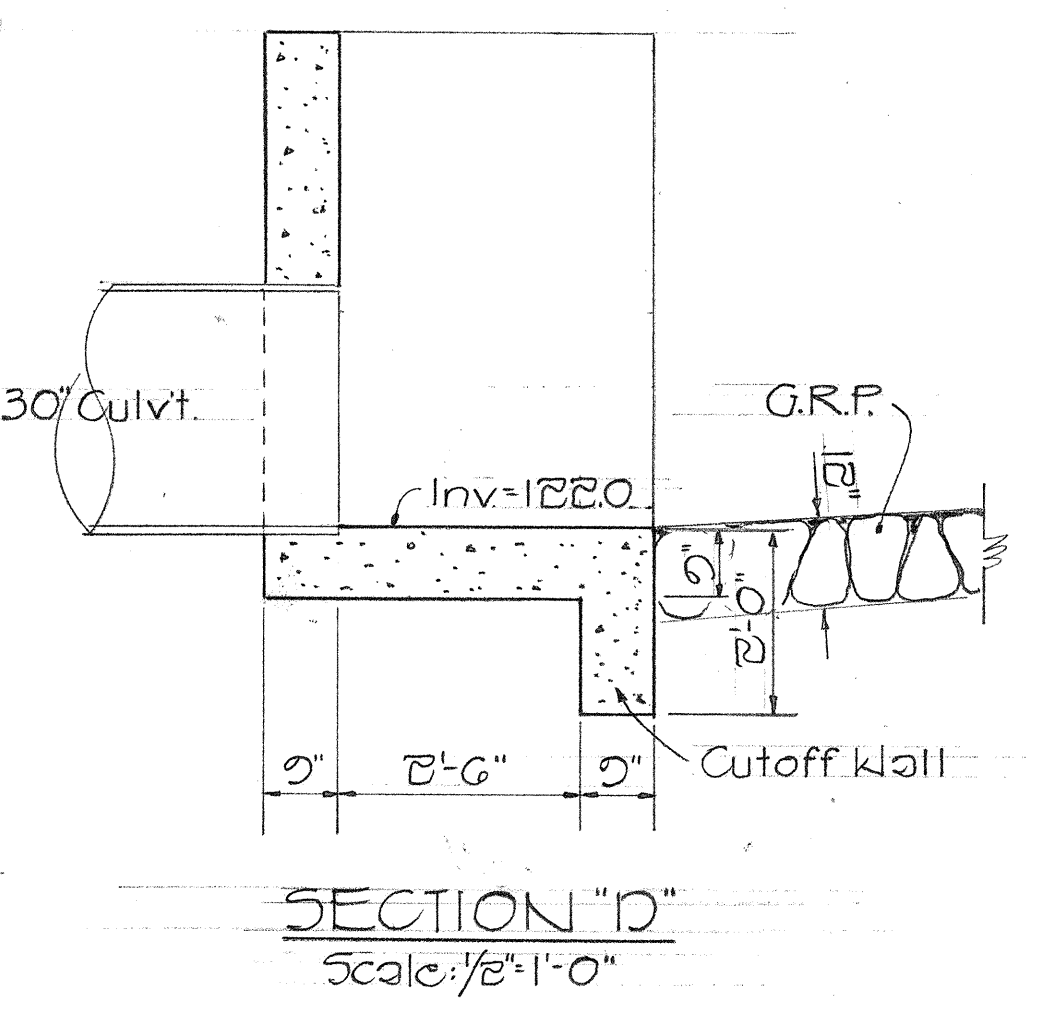
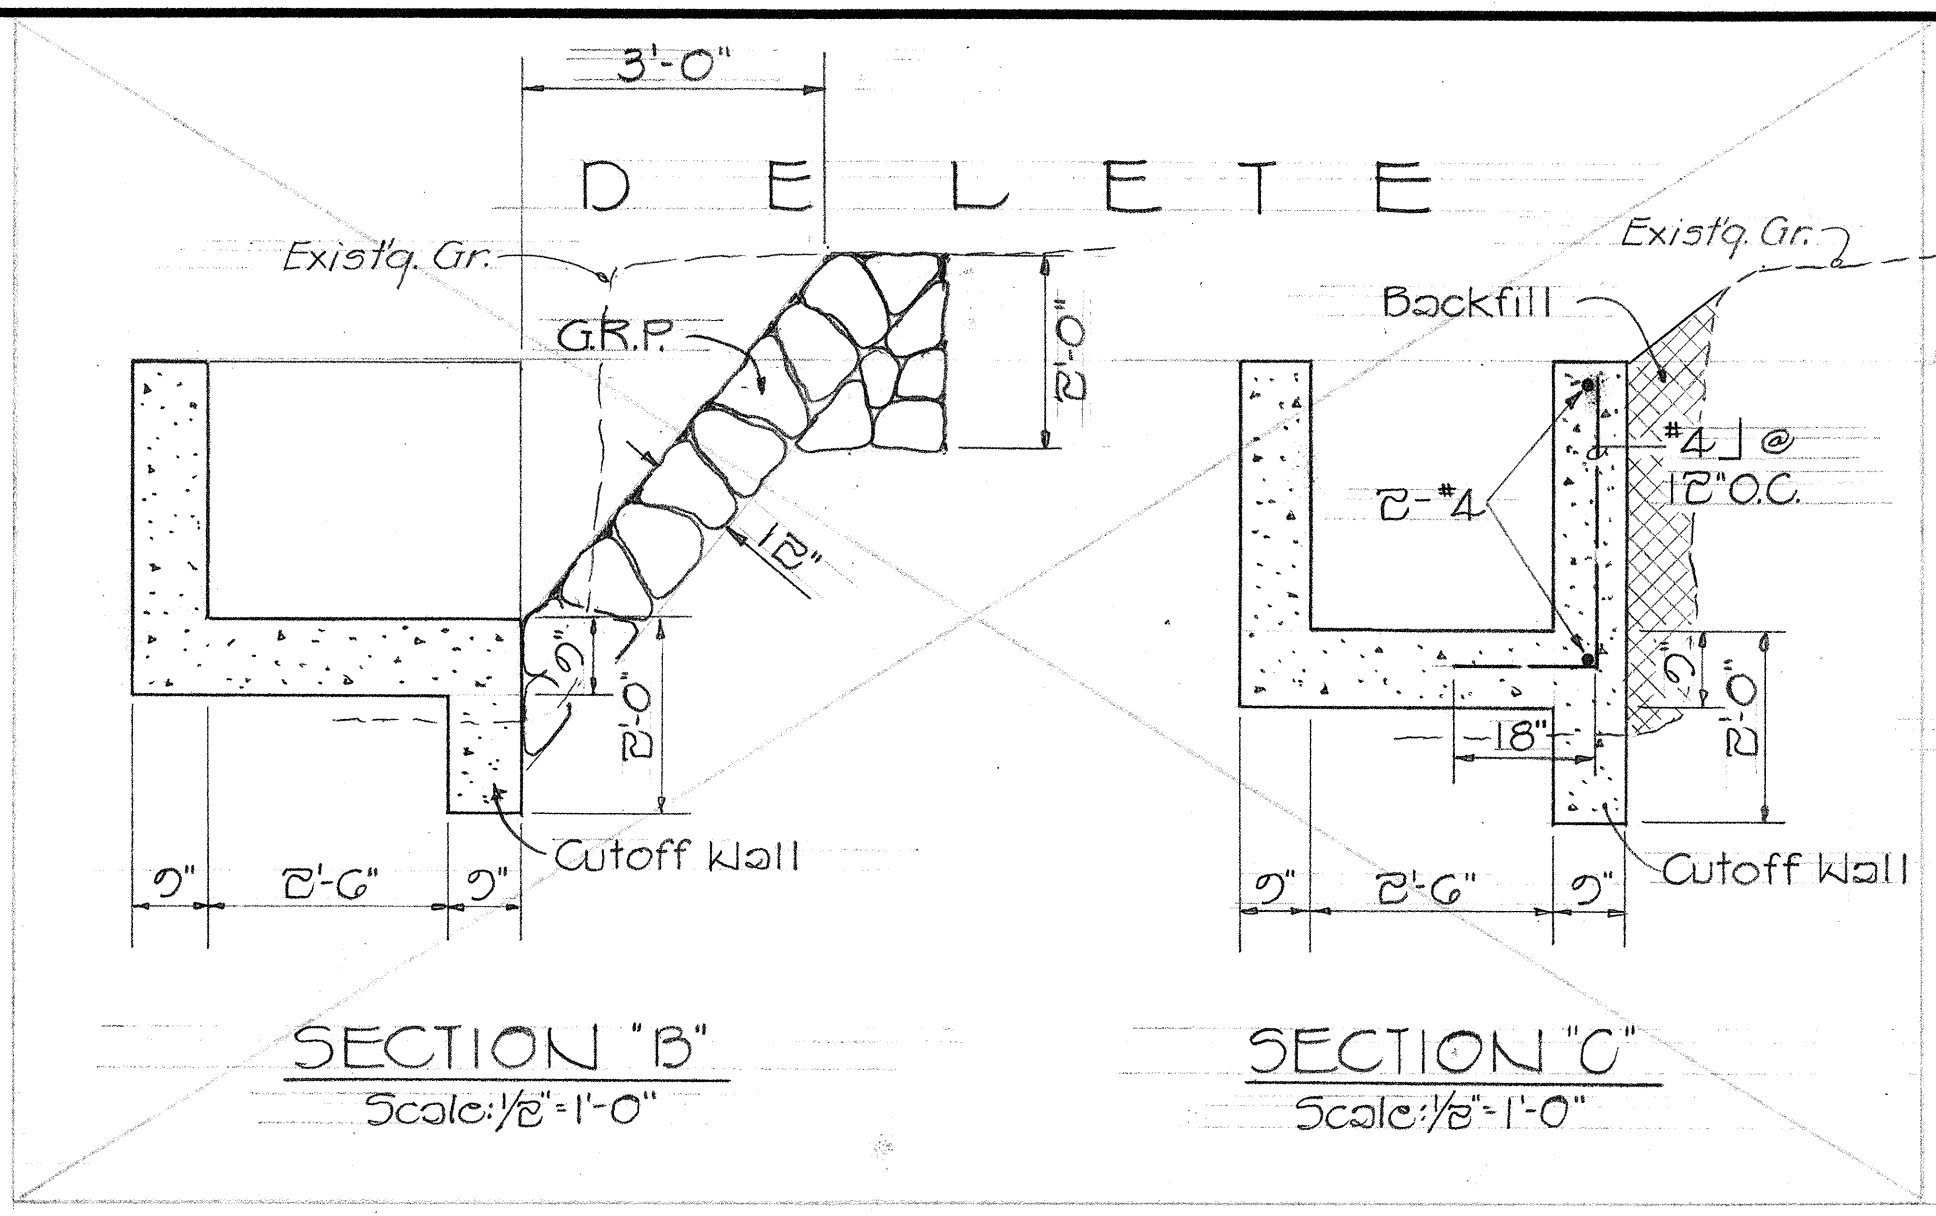


DIST. NO.	STATE	PROJ. NO.	FISCAL YEAR	SHEET NO.	TOTAL SHEETS
HAWAII	HAW.	58A-01-75	1976	3	3

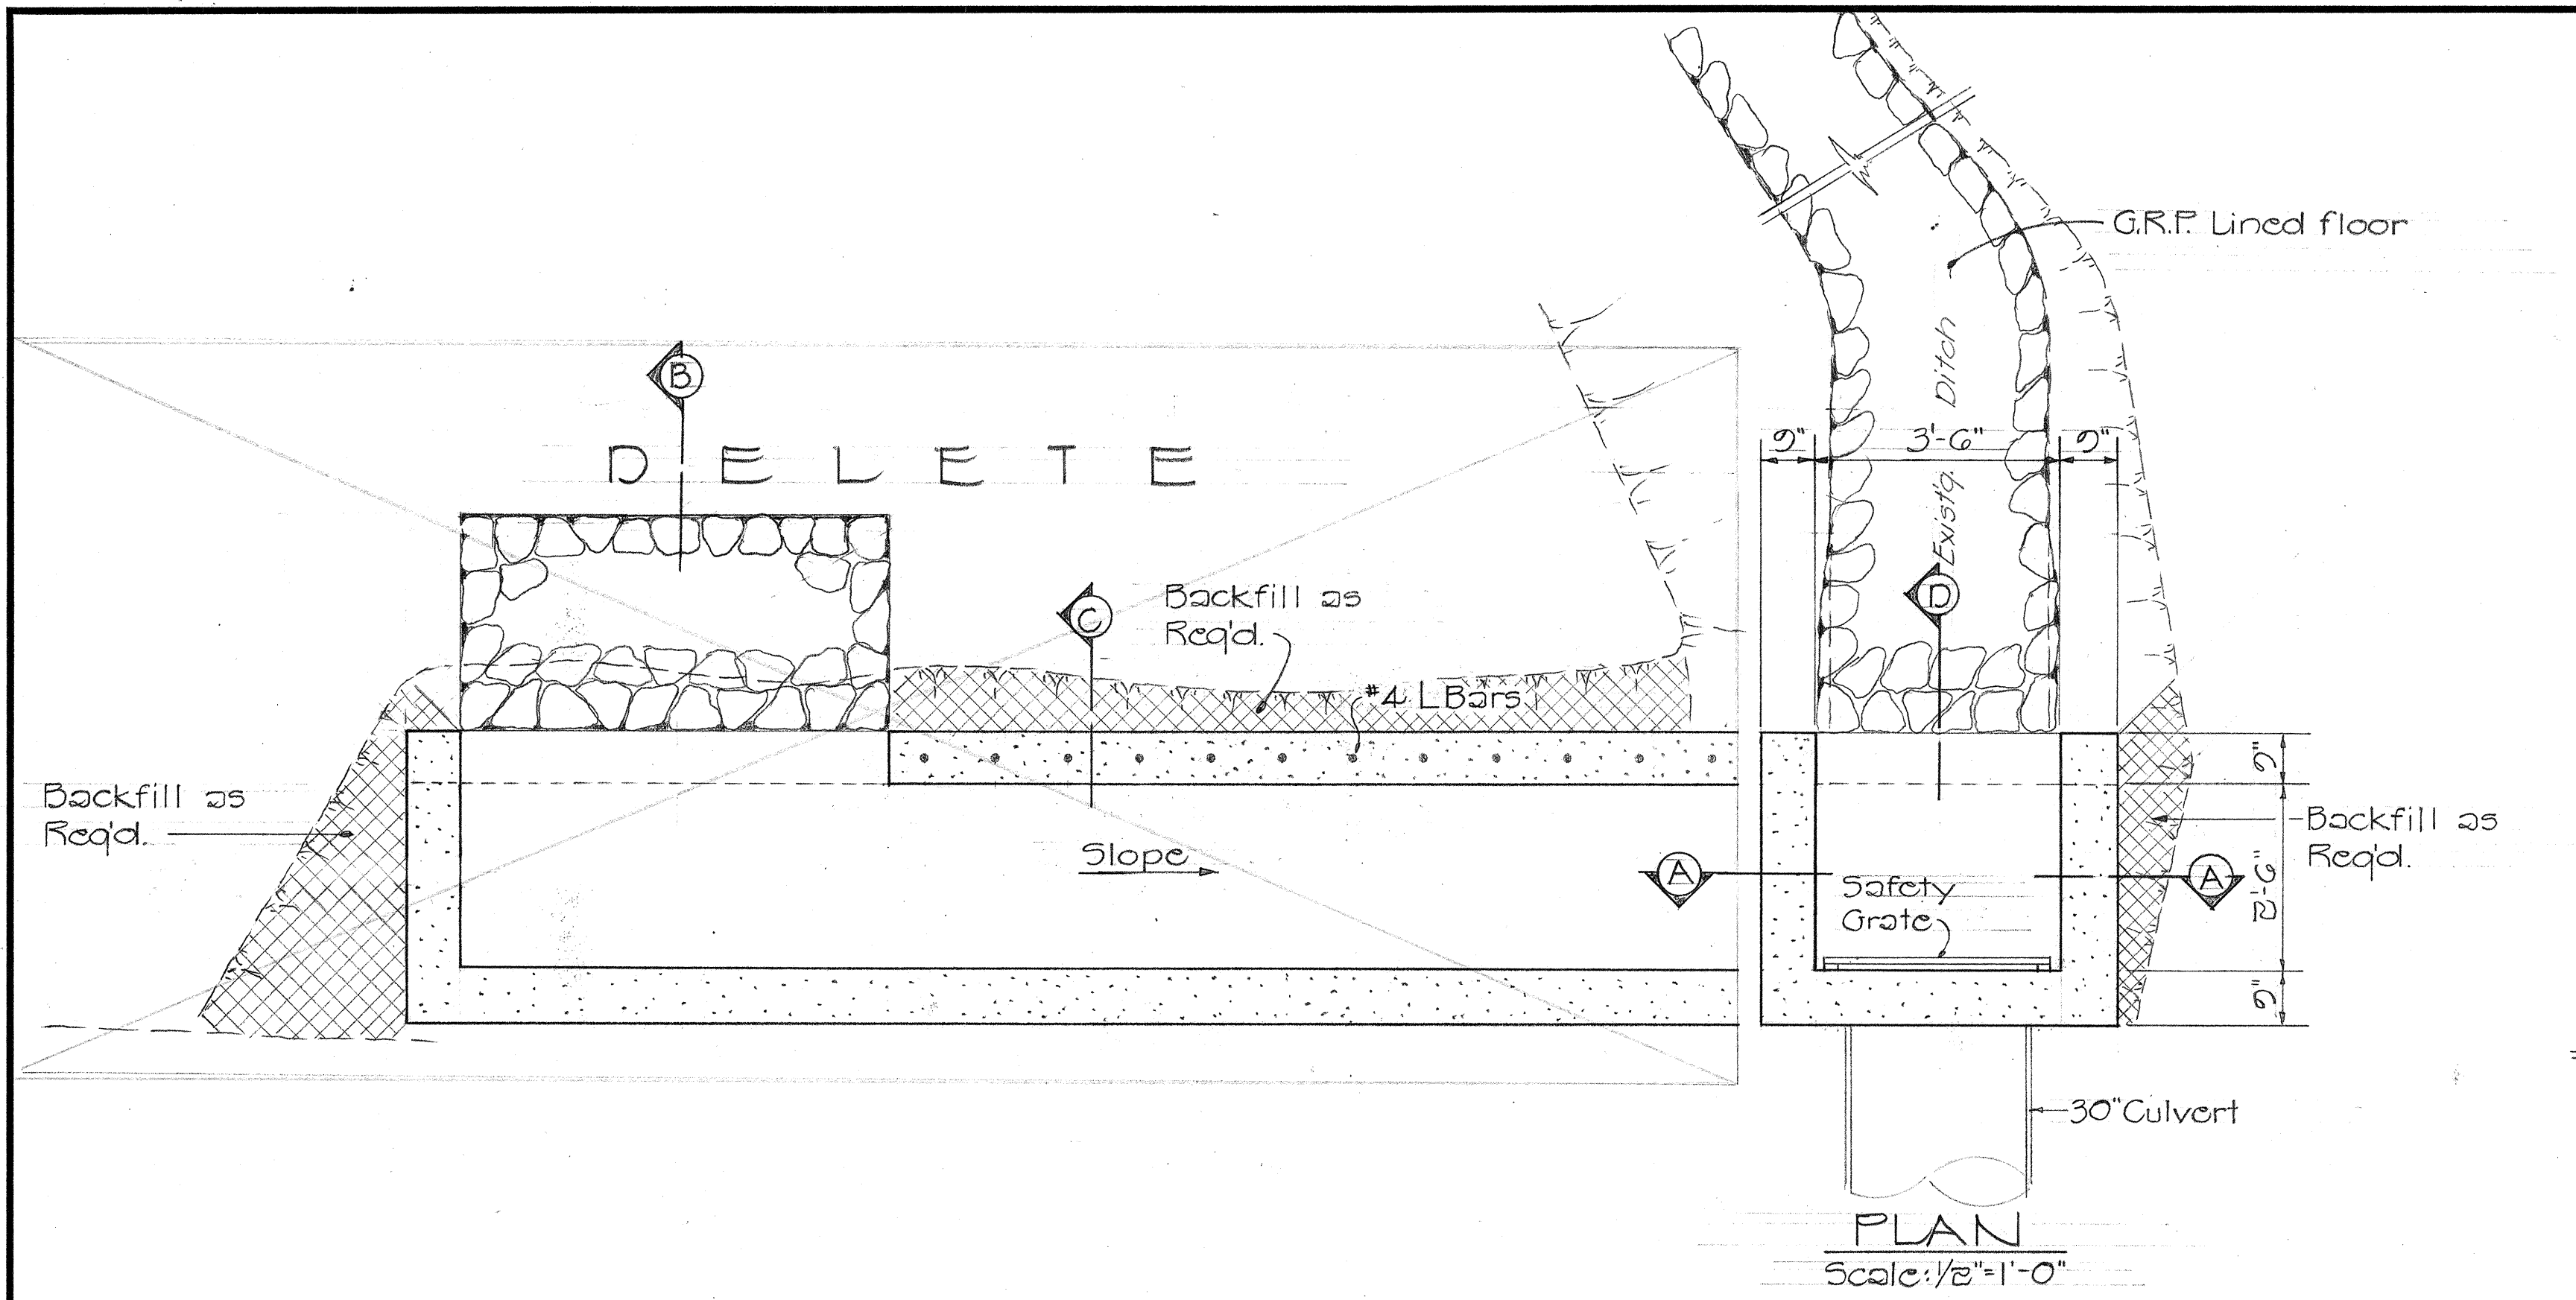

DATE	_____
DESIGNED BY	_____
DRAWN BY	_____
CHECKED BY	_____
IN CHARGE	_____
NOTED BY	_____
REVISIONS	_____
ORIGINAL	_____

STATE OF HAWAII

DEPARTMENT OF TRANSPORTATION

HIGHWAYS DIVISION

NAWILIWILI ROAD DRAIN IMPROVEMENTS

VICINITY OF KAUAI COMMUNITY COLLEGE

PROJ. No. 58A-01-75

DETAILS~INLET & OUTLET STRUCTURE

Scale: As Shown

Dec. 1975

SHEET No. 1 OF 1 SHEETS