INDEX TO DRAWINGS	
SHEET NO.	DESCRIPTION
	TITLE SHEET
2	PLAN & PROFILE
3	INLET & OUTLET STRUCTURES
1	
Marting in the second s	



STATE OF HAWAII

DEPARTMENT OF TRANSPORTATION HIGHWAYS DIVISION


"AS BUILT"

PLANS FOR

NAWILIWILI ROAD, DRAIN IMPROVEMENTS, VICINITY OF KAUAI COMMUNITY COLLEGE


> PROJECT NO. 58A-01-75 DISTRICT OF LIHUE

ISLAND OF KAUAI

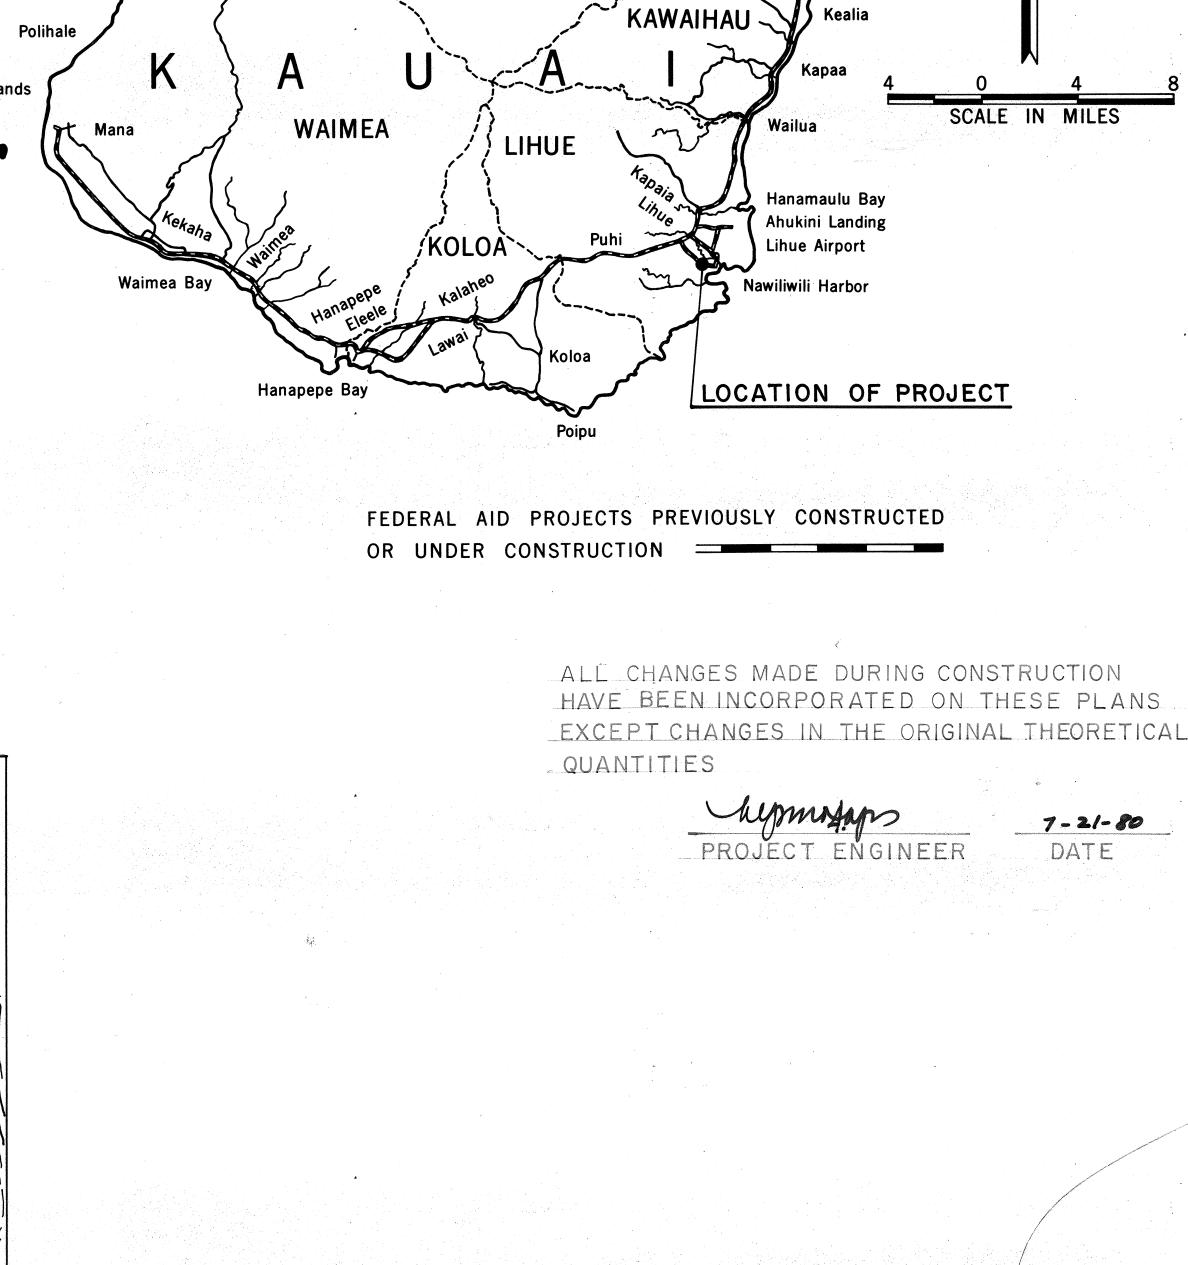

HANALEI

AUAI DISTRICT DESIGNED BY

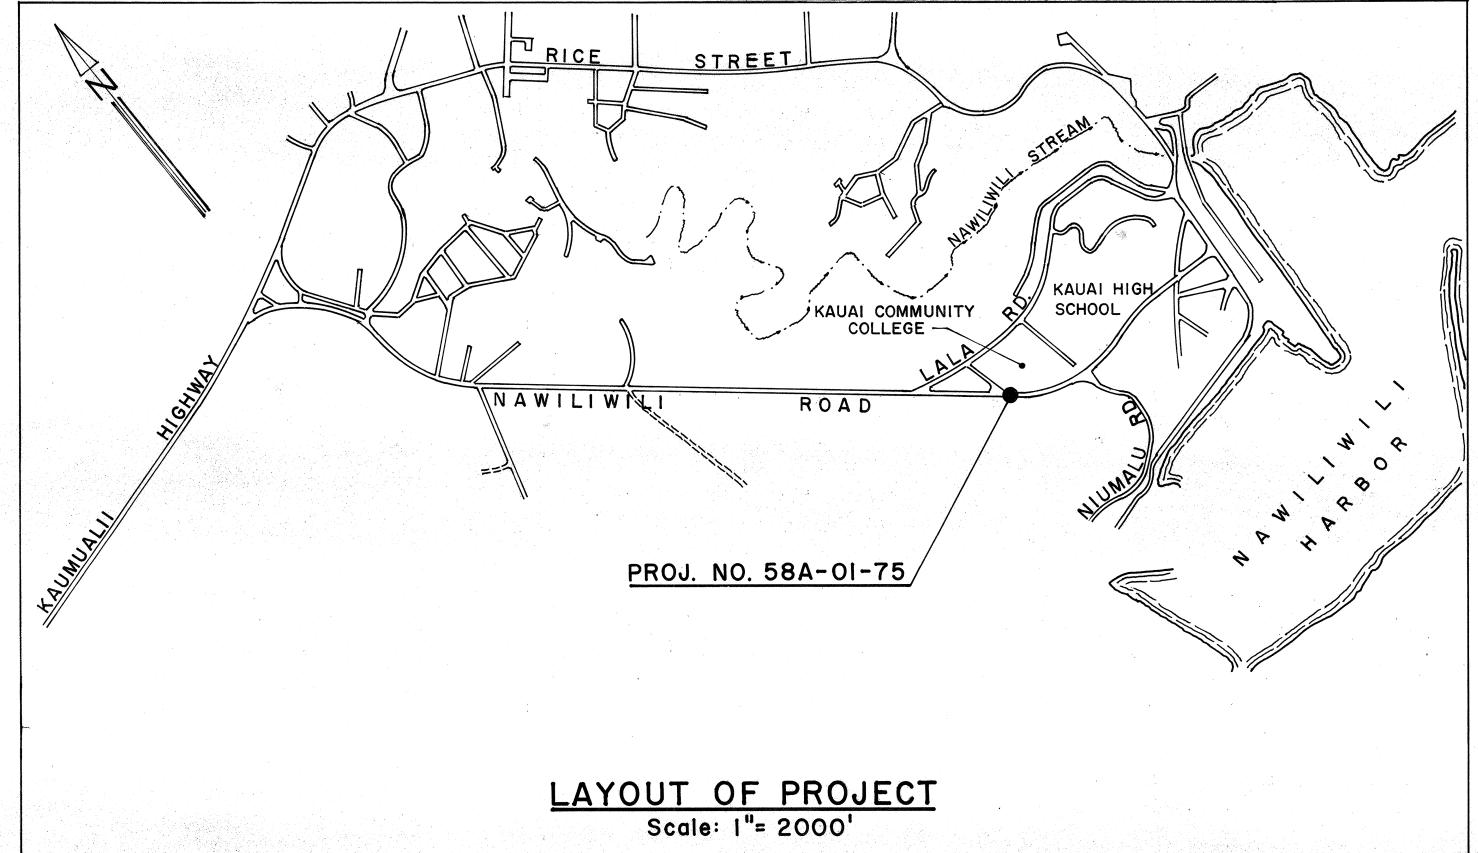

DEPARTMENT OF TRANSPORTATION STATE OF HAWAII

7-21-80

FISCAL SHEET YEAR NO.