



FED. ROAD DIST. NO.	STATE	FED. AID PROJ. NO.	FISCAL YEAR	SHEET NO.	TOTAL SHEETS
HAWAII	HAW.	STP-058-1(2)	1992	3	17

GENERAL NOTES


1. All construction work shall be done in accordance with these plans, all applicable sections of the Standard Specifications for Road and Bridge Construction, dated 1985 as amended, of the State Highways Division, Dept. of Transportation & the project's Special Provisions, unless otherwise specified.
2. The Contractor shall provide, install and maintain all necessary signs, lights, flares, temporary concrete guardrails, barricades, markers, cones and other protective facilities and shall take all necessary precautions for the protection & for the convenience & safety of public traffic. All such protective facilities & precautions to be taken shall conform with the "Rules and Regulations Governing the Use of Traffic Control Devices at Work Sites On or Adjacent to Public Streets and Highways" adopted by the Highway Safety Coordinator & the U.S. Federal Highway Administration's "Manual on Uniform Traffic Control Devices for Streets and Highways, Part VI - Traffic Controls for Highway Construction and Maintenance Operations", dated 1978 & Revision No. 4 dated March 1986.
3. Full compensation for all additional materials & labor, not specifically shown or called for which are necessary to complete the construction of the project, shall be considered incidental to the various contract items in the proposal & no additional compensation will be allowed therefor.
4. The underground pipes, cables or ductlines known to exist by the Engineer from his search of records are indicated on the plans. The Contractor shall verify the location and depth of the facilities and exercise proper care in excavating in the area. Wherever connections of new utilities to existing utilities are shown on the plans, the Contractor shall expose the existing utility lines at the proposed connections to verify their locations and depths prior to excavation for the new lines.
5. All lanes shall be open to traffic during the morning peak hours from 6:00 a.m. to 8:30 a.m. and during the afternoon peak hours from 3:30 p.m. to 5:30 p.m. and during off-work hours.
6. The Contractor shall remove all silt and debris resulting from his work and deposited in drainage facilities, roadways and other areas. The costs incurred for any necessary remedial action by the Engineer shall be payable by the Contractor.
7. The Contractor, at his own expense, shall keep the project area and surrounding area from dust nuisance. The work shall be in conformance with the Air Pollution Control Standards and Regulations of the State Department of Health.
8. All exposed areas shall be sodded or planted immediately after the grading work has been completed.
9. Adjustments of manhole, catch basin, valve box, street monument, etc. frames and covers shall not be measured for payment separately but shall be considered incidental to various items of work.
10. There are no known natural, historic or archaeological sites within the project area. In the event that sites are uncovered during construction, the Contractor shall halt work in the area and immediately notify the Engineer. The Engineer shall contact and advise the finding to the Historic Sites Office of the State Department of Land and Natural Resources. Work shall resume after their review and determination.

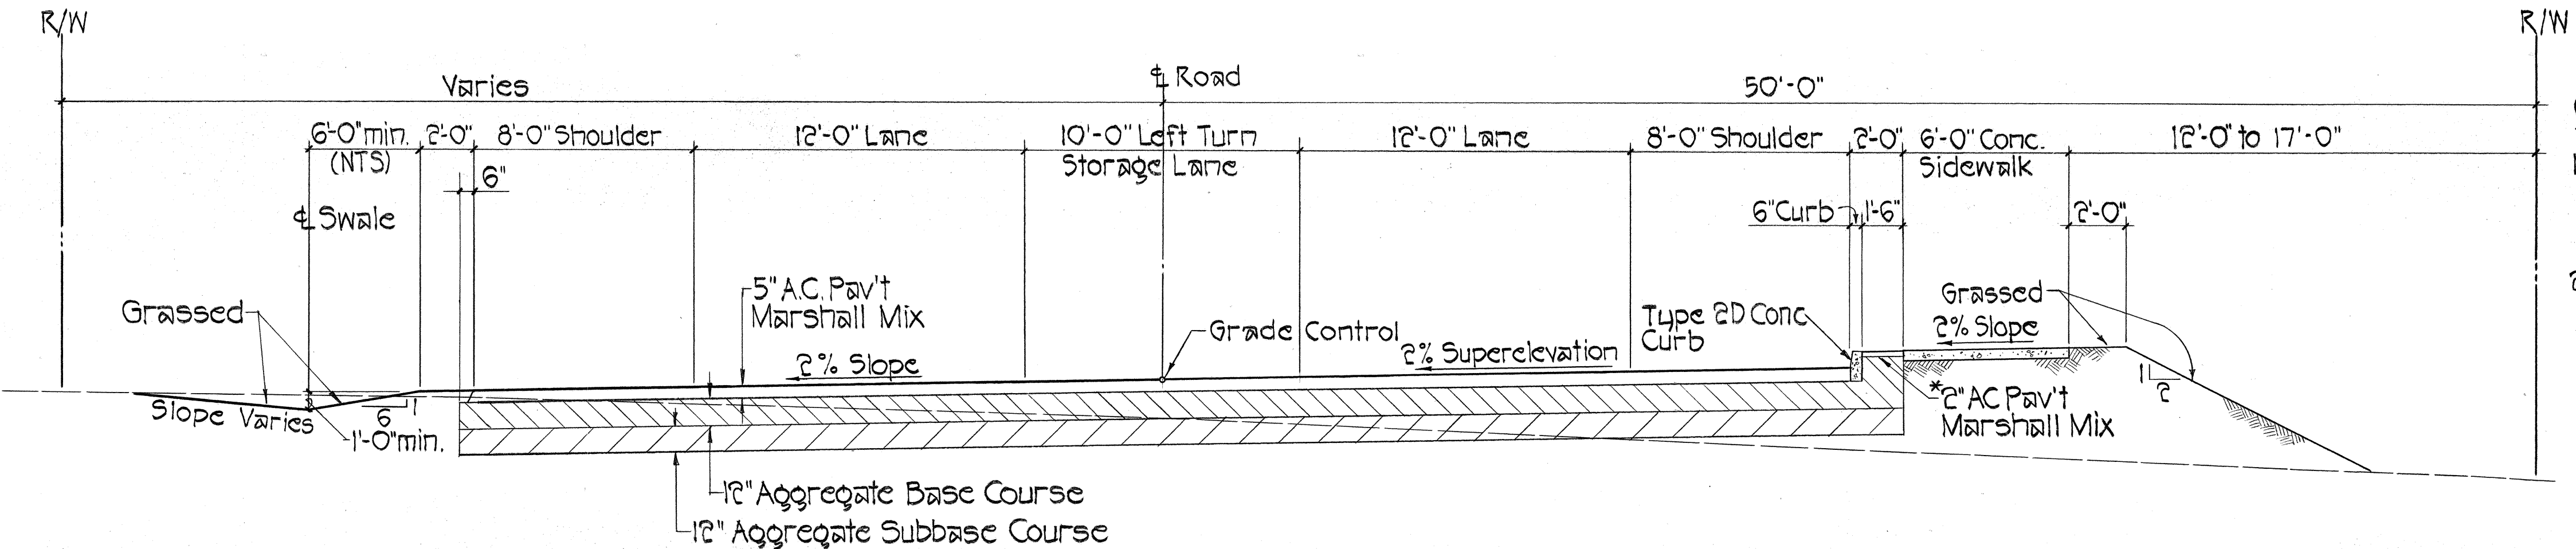

STA. 1+90 TO STA. 4+35.99  
TYPICAL SUPERELEVATION SECTION  
Scale: 1/4" = 1'-0"

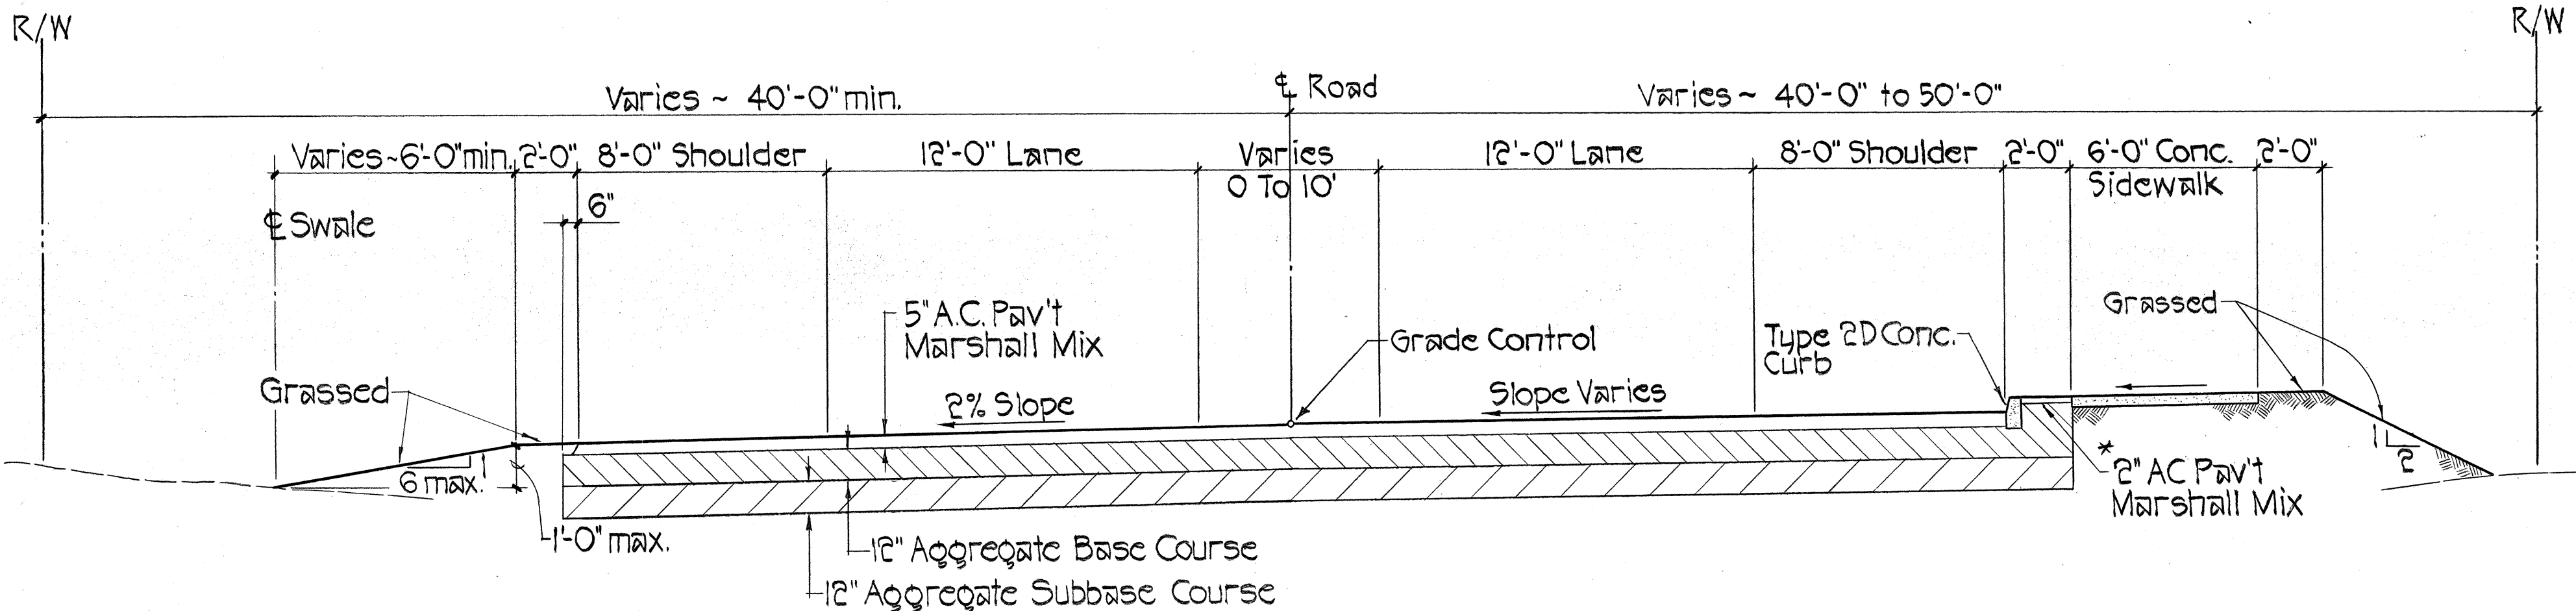


STA. 0+00 TO STA. 1+90 AND STA. 4+35.99 TO STA. 6+25.99  
TYPICAL SUPERELEVATION RUNOFF SECTION  
Scale: 1/4" = 1'-0"

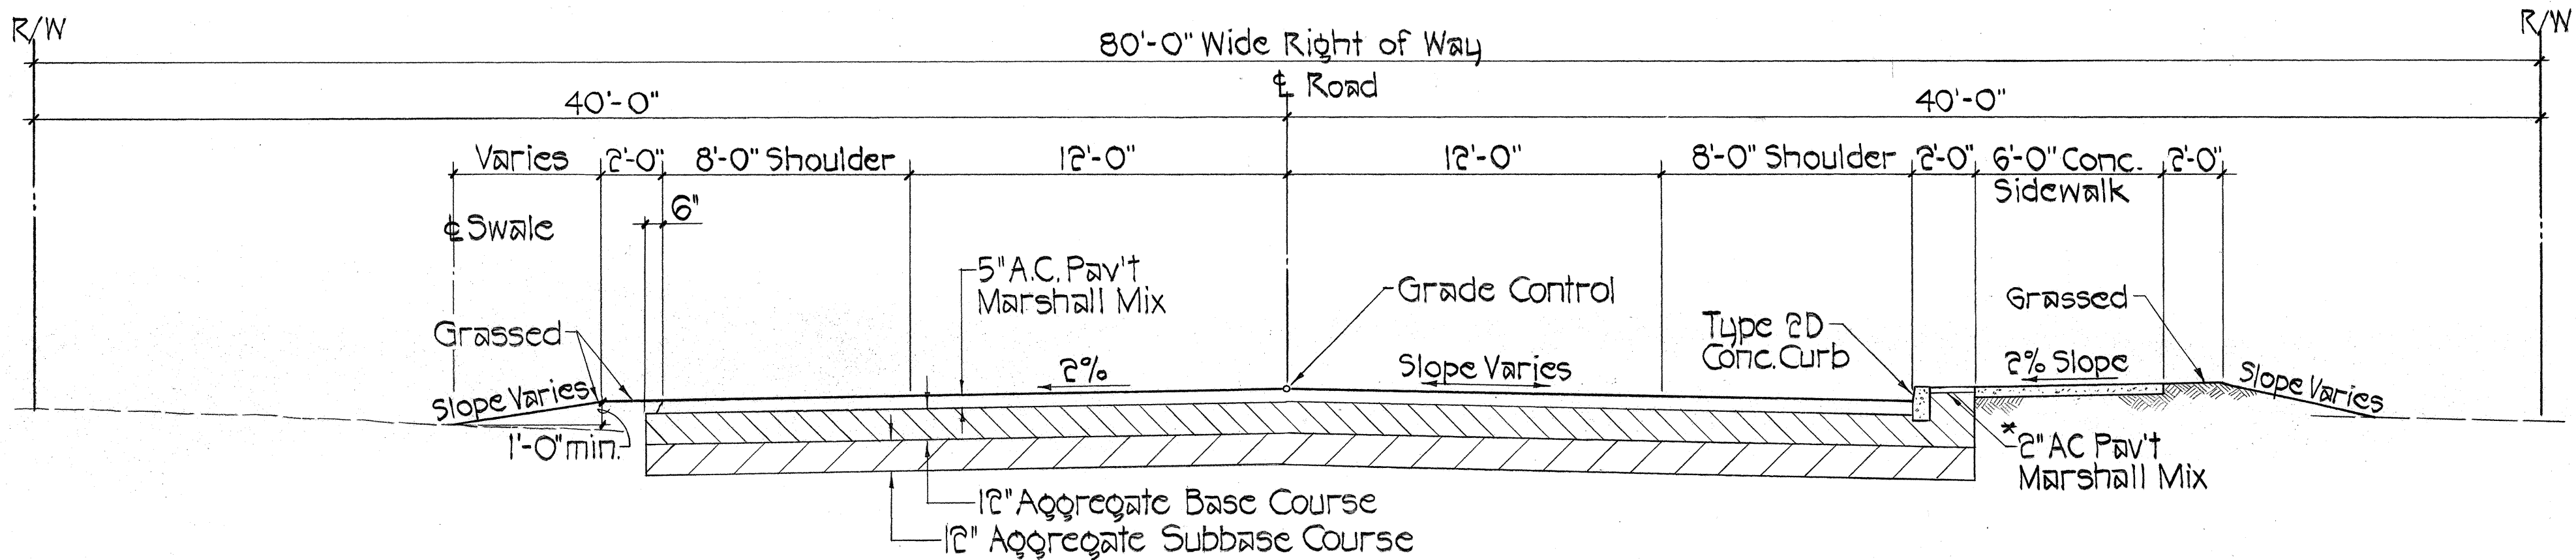

STA. 108+43± TO STA. 0+00 AND STA. 6+25.99 TO STA. 7+25.99  
TYPICAL TANGENT ROAD SECTION  
Scale: 1/4" = 1'-0"

DATE	_____
SURVEY PLOTTED BY	_____
DRAWN BY	_____
CHECKED BY	_____
ORIGINAL PLAN	_____
NOTE BOOK	_____
NO.	_____

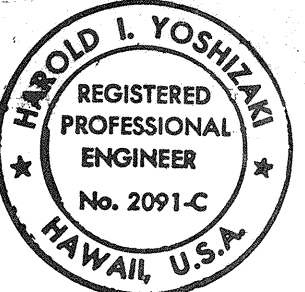

THIS WORK WAS PREPARED BY ME OR UNDER MY SUPERVISION.  
Harold L. Yoshizaki  
SHIMABUKURO, ENDO & YOSHIZAKI, INC.  
1124 12th Avenue  
Honolulu, Hawaii 96816

5/27/92	*Add. 2" AC Pav't w/ Base & Subbase Course
DATE	REVISION
STATE OF HAWAII DEPARTMENT OF TRANSPORTATION HIGHWAYS DIVISION TYPICAL ROAD SECTIONS & GENERAL NOTES WAAPA ROAD & NAWILIWILI ROAD INTERSECTION IMPROVEMENTS F.A. PROJECT NO. STP-058-1(2) SCALE: AS SHOWN DATE: MARCH 1992 SHEET NO. 1 OF 1 SHEETS	