
	PAVEMENT MARKING SUMMARY	
	DESCRIPTION	QUANTITY
	PAVEMENT MARKERS	
	TYPE A	400 EA.
	TYPE C	860 EA.
	TYPE D	270 EA.
	TYPE H	350 EA.
	TYPE J	390 EA.
*	TAPE - TYPE I OR THERMOPLASTIC EXTRUSION	
	4-INCH PAVEMENT STRIPE (WHITE)	
	4-INCH PAVEMENT STRIPE (YELLOW)	1,460 L.F.
	8-INCH PAVEMENT STRIPE (WHITE)	1,770 L.F.
	12-INCH PAVEMENT STRIPE (WHITE)	
4	12-INCH PAVEMENT STRIPE (YELLOW)	
	DOUBLE 4-INCH PAVEMENT STRIPE (YELLOW)	3,920 L.F.
	PARKING STALLS	
**	TAPE — TYPE II OR THERMOPLASTIC EXTRUSION	
	4-INCH PAVEMENT STRIPE (WHITE)	21,100 L.F.
	4-INCH PAVEMENT STRIPE (YELLOW)	4,440 L.F.
	8-INCH PAVEMENT STRIPE (WHITE)	1,440 L.F.
	12-INCH PAVEMENT STRIPE (WHITE)	250 L.F.
	12-INCH PAVEMENT STRIPE (YELLOW)	940 L.F.
	DOUBLE 4-INCH PAVEMENT STRIPE (YELLOW)	2,730 L.F.
***	TAPE - TYPE III OR THERMOPLASTIC EXTRUSION	,
	4-INCH PAVEMENT STRIPE (WHITE)	3,930 L.F.
	4-INCH PAVEMENT STRIPE (YELLOW)	1,080 L.F.
	8-INCH PAVEMENT STRIPE (WHITE)	
	12-INCH PAVEMENT STRIPE (WHITE)	700 L.F.
	CROSSWALK MARKINGS	8 LANES
	PAVEMENT ARROW	104 EA.
	PAVEMENT WORD	

Notes:

- \* Tape, Type I or Thermoplastic Extrustion (No passing zones, channelizing lines, solid lines or pavement arrows)
- \*\* Tape, Type II or Thermoplastic Extrustion (Transverse median markings, transverse shoulder markings, channelizing islands, or edge striping)

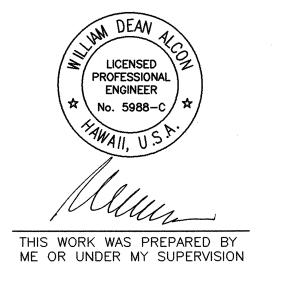


STATE OF HAWAII
DEPARTMENT OF TRANSPORTATION
HIGHWAYS DIVISION

## PAVEMENT MARKING SUMMARY

NAWILIWILI ROAD RESURFACING
Kaumualii Highway to Waapa Road
Federal Aid Proj. No. NH-058-1(3)

Date: Nov. 2000

SHEET No. 1 OF 1 SHEETS

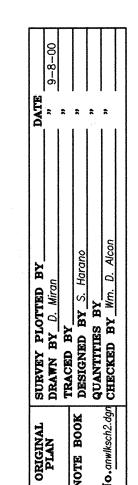

FISCAL SHEET TOTAL YEAR NO. SHEETS

FED. AID PROJ. NO.

HAW. NH-058-1(3) 2001

FED. ROAD DIST. NO.

<sup>\*\*\*</sup> Tape, Type III or Thermoplastic Extrustion (Guide Lines, stop lines, extension of edge lines, or crosswalk markings)