



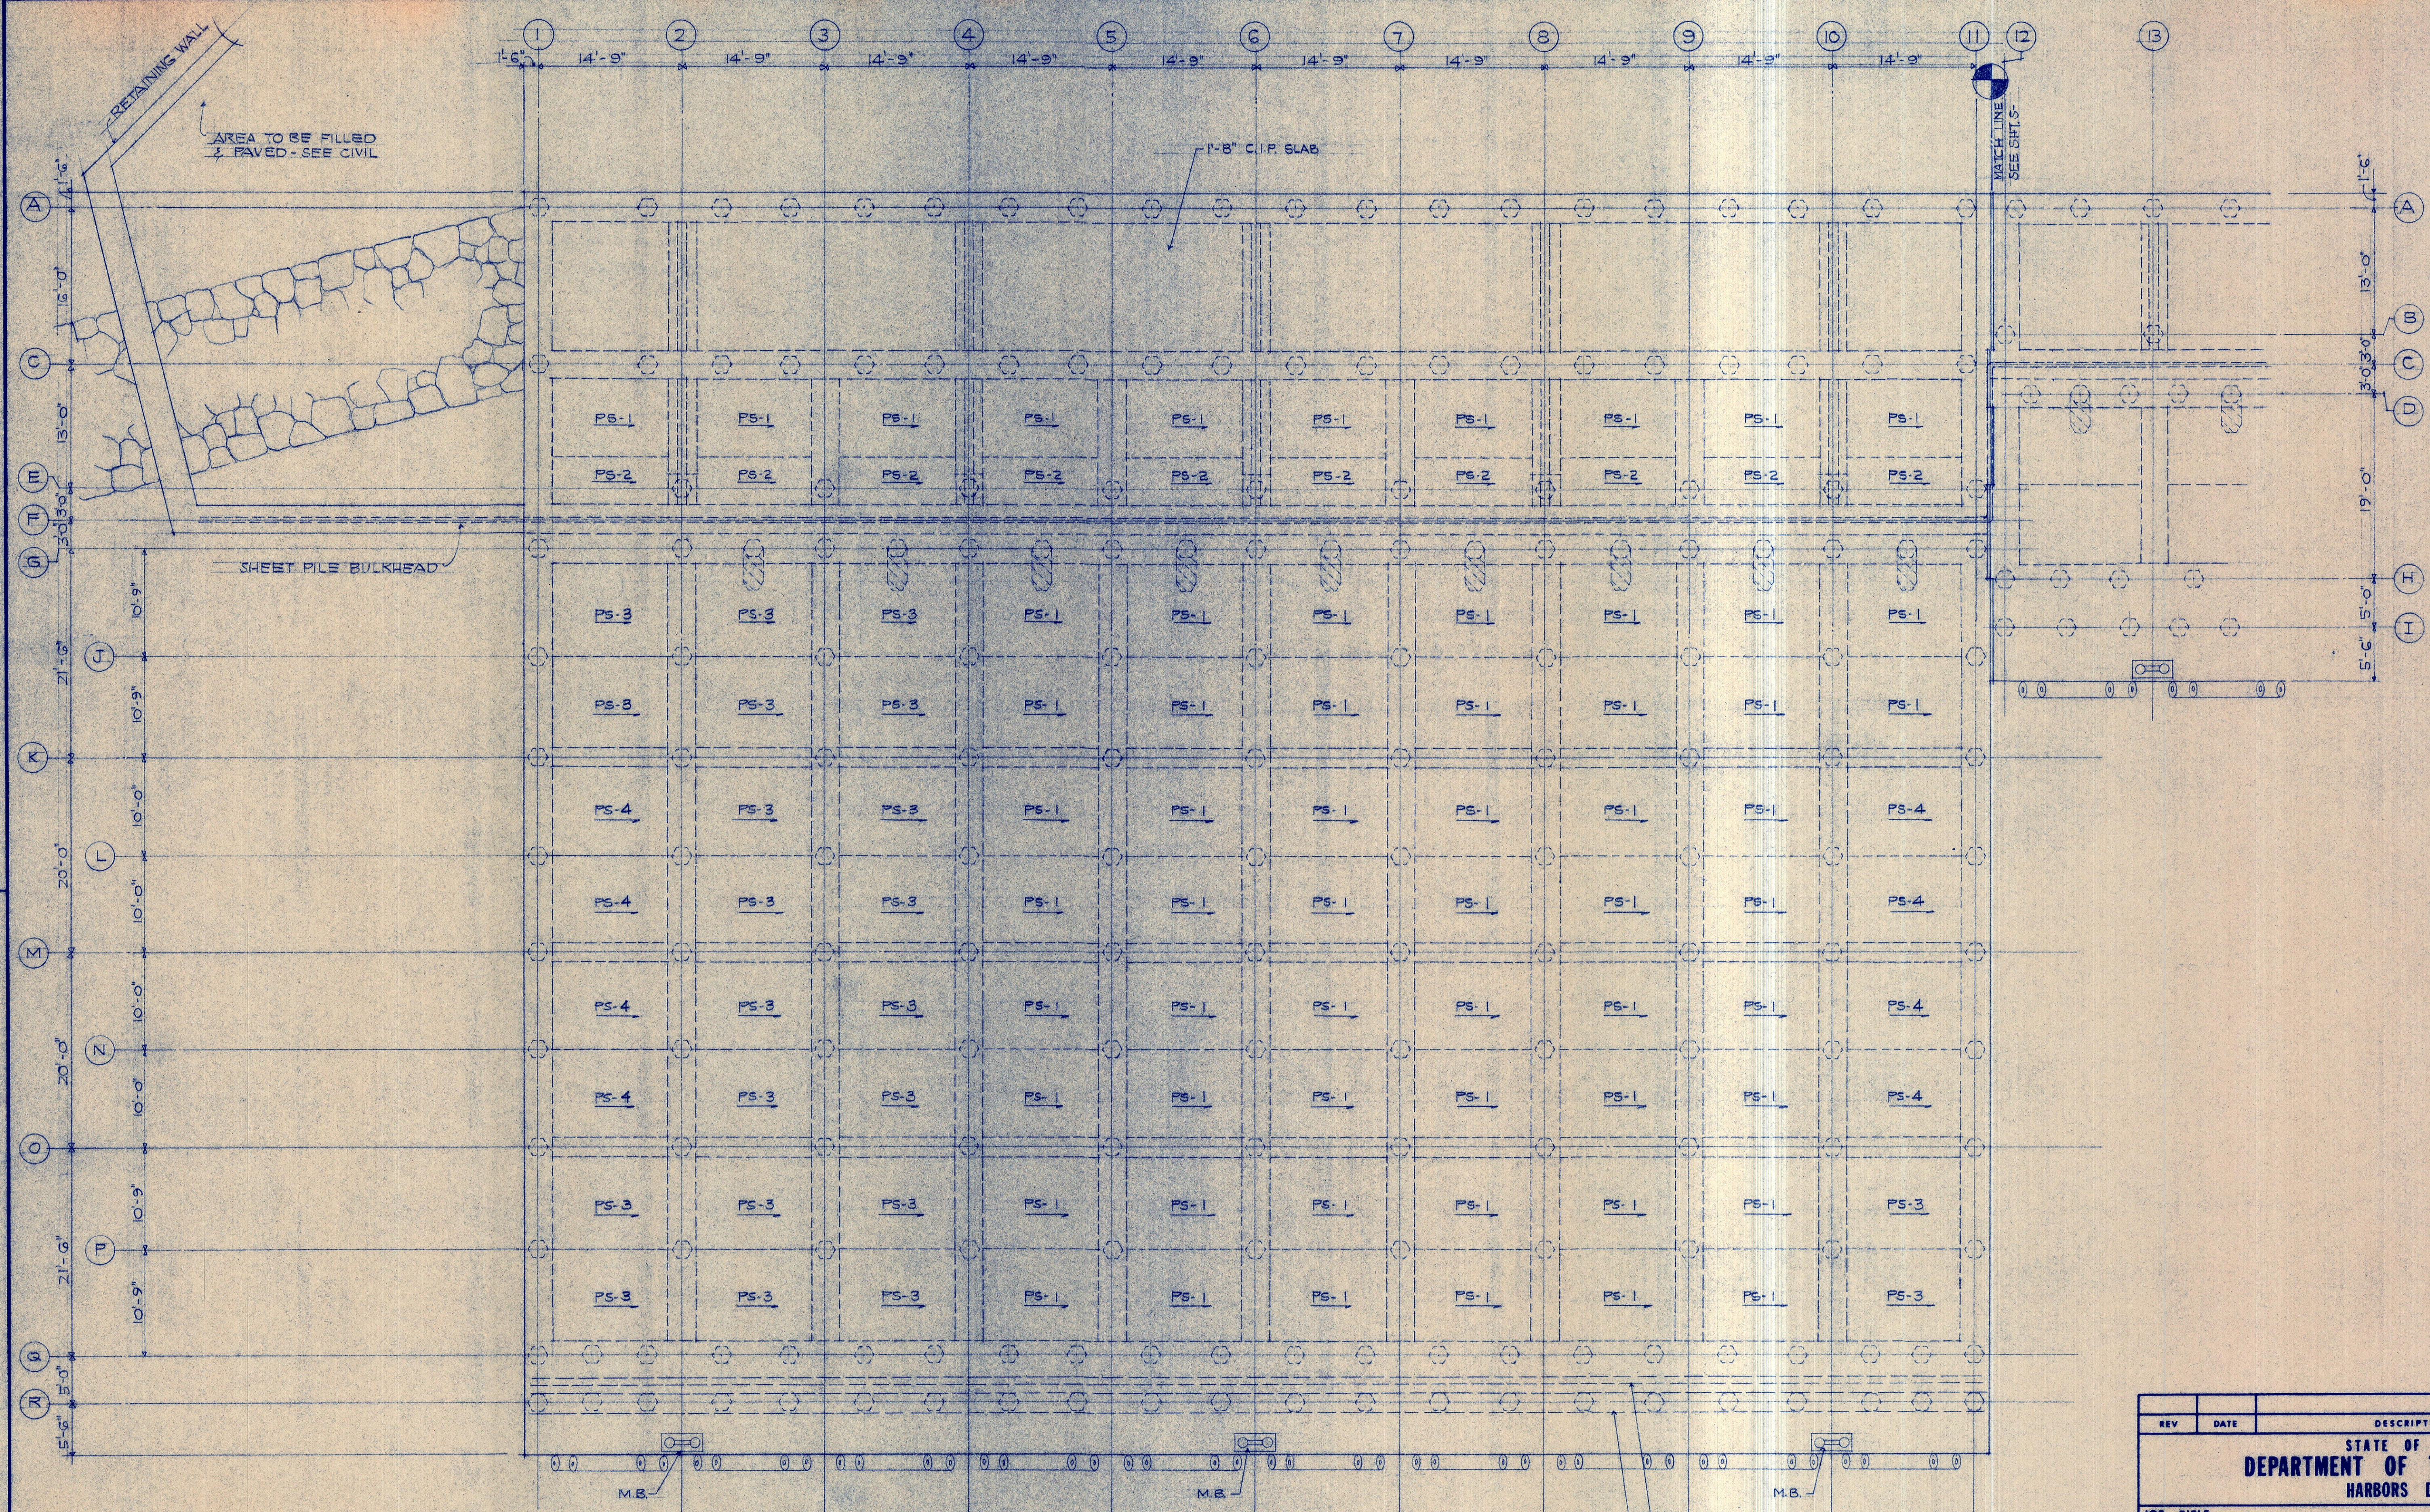

PARTIAL PIER DECK FRAMING PLAN
SCALE 1/8" = 1'-0"

*show sheets
of water hatch plan
see 1/16 to deck plan
and all
subsequent sheet.*

REV	DATE	DESCRIPTION	BY	APPROVED
STATE OF HAWAII DEPARTMENT OF TRANSPORTATION HARBORS DIVISION				
JOB TITLE PIER 3				
LOCATION NAWILIWILI HARBOR KAUAI				
SHEET TITLE PARTIAL PIER DECK FRAMING PLAN - BENTS 1 TO 12				
SUBMITTED BY:			RECOMMENDED BY:	
SECTION HEAD			ASSISTANT CHIEF FOR ENGINEERING	
DESIGNED BY: J.W.			APPROVED BY:	
DRAWN BY: H.I., M.M.			CHIEF, HARBORS DIVISION	
CHECKED BY: T.N., R.J.			JOB NUMBER	
DATE:			H.C. 7157-A	
SCALE: AS NOTED			OF 5 SHEETS	

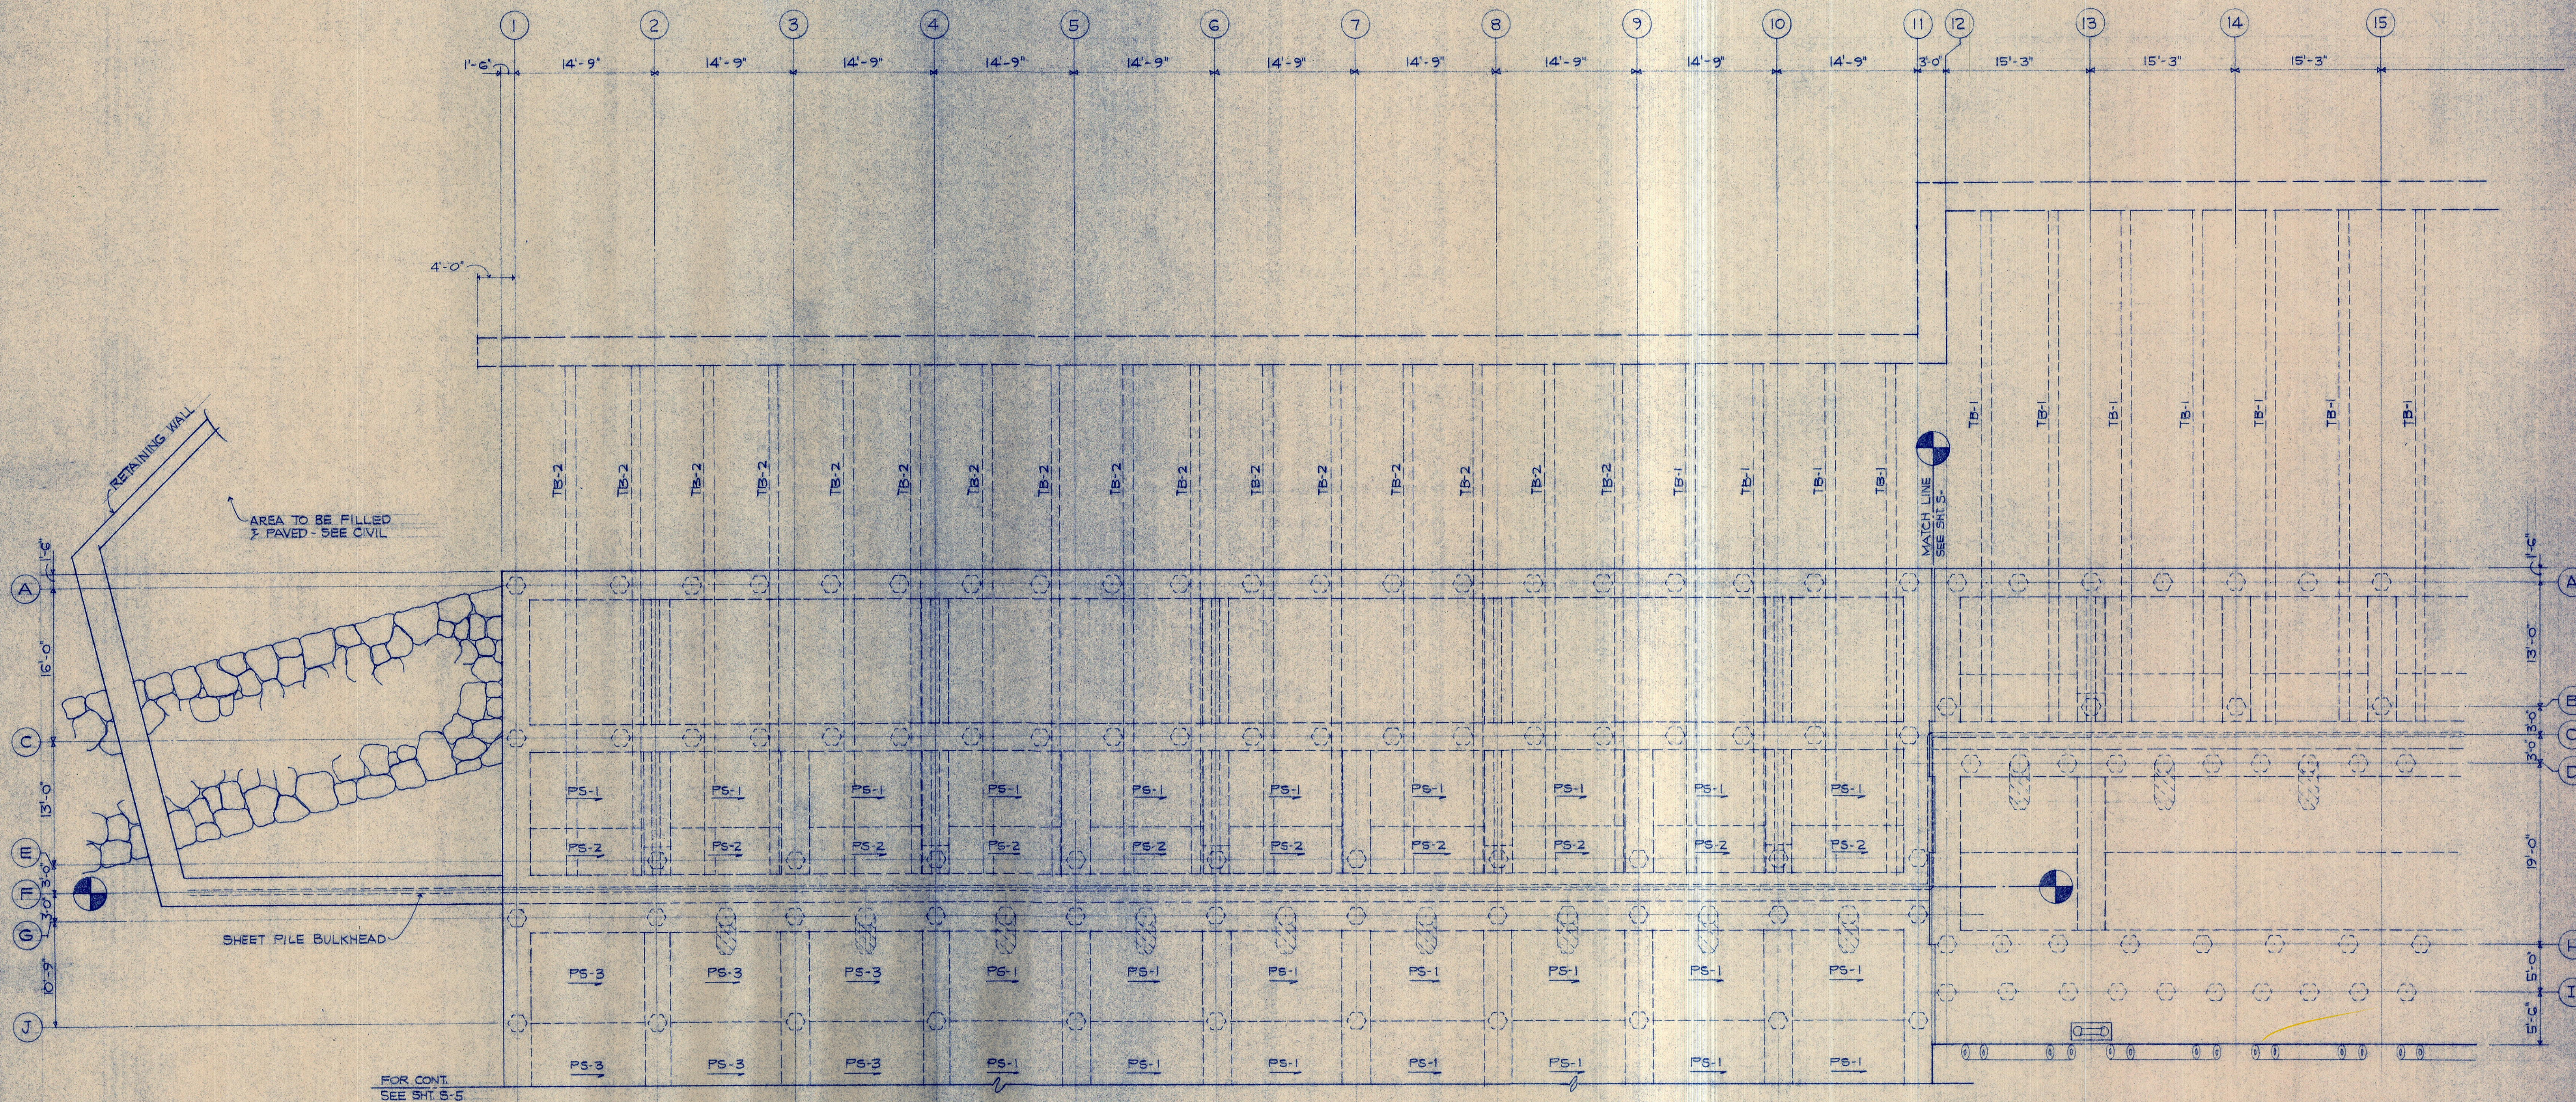

REV	DATE	DESCRIPTION	BY	APPROVED
STATE OF HAWAII DEPARTMENT OF TRANSPORTATION HARBORS DIVISION				
JOB TITLE PIER 3				
NAWILIWILI HARBOR KAUAI				
SHEET TITLE PARTIAL PIER DECK FRAMING PLAN ~ BENTS 1 TO 12				
SUBMITTED BY:			RECOMMENDED BY:	
SECTION HEAD			ASSISTANT CHIEF FOR ENGINEERING	
DESIGNED BY: J.W.		APPROVED BY:		SHEET
DRAWN BY: H.J., M.M.		CHIEF, HARBORS DIVISION		
CHECKED BY: T.N., R.T.		JOB NUMBER		
DATE:		H.C. 7157-A		
SCALE: AS NOTED		OF 5 SHEETS		