


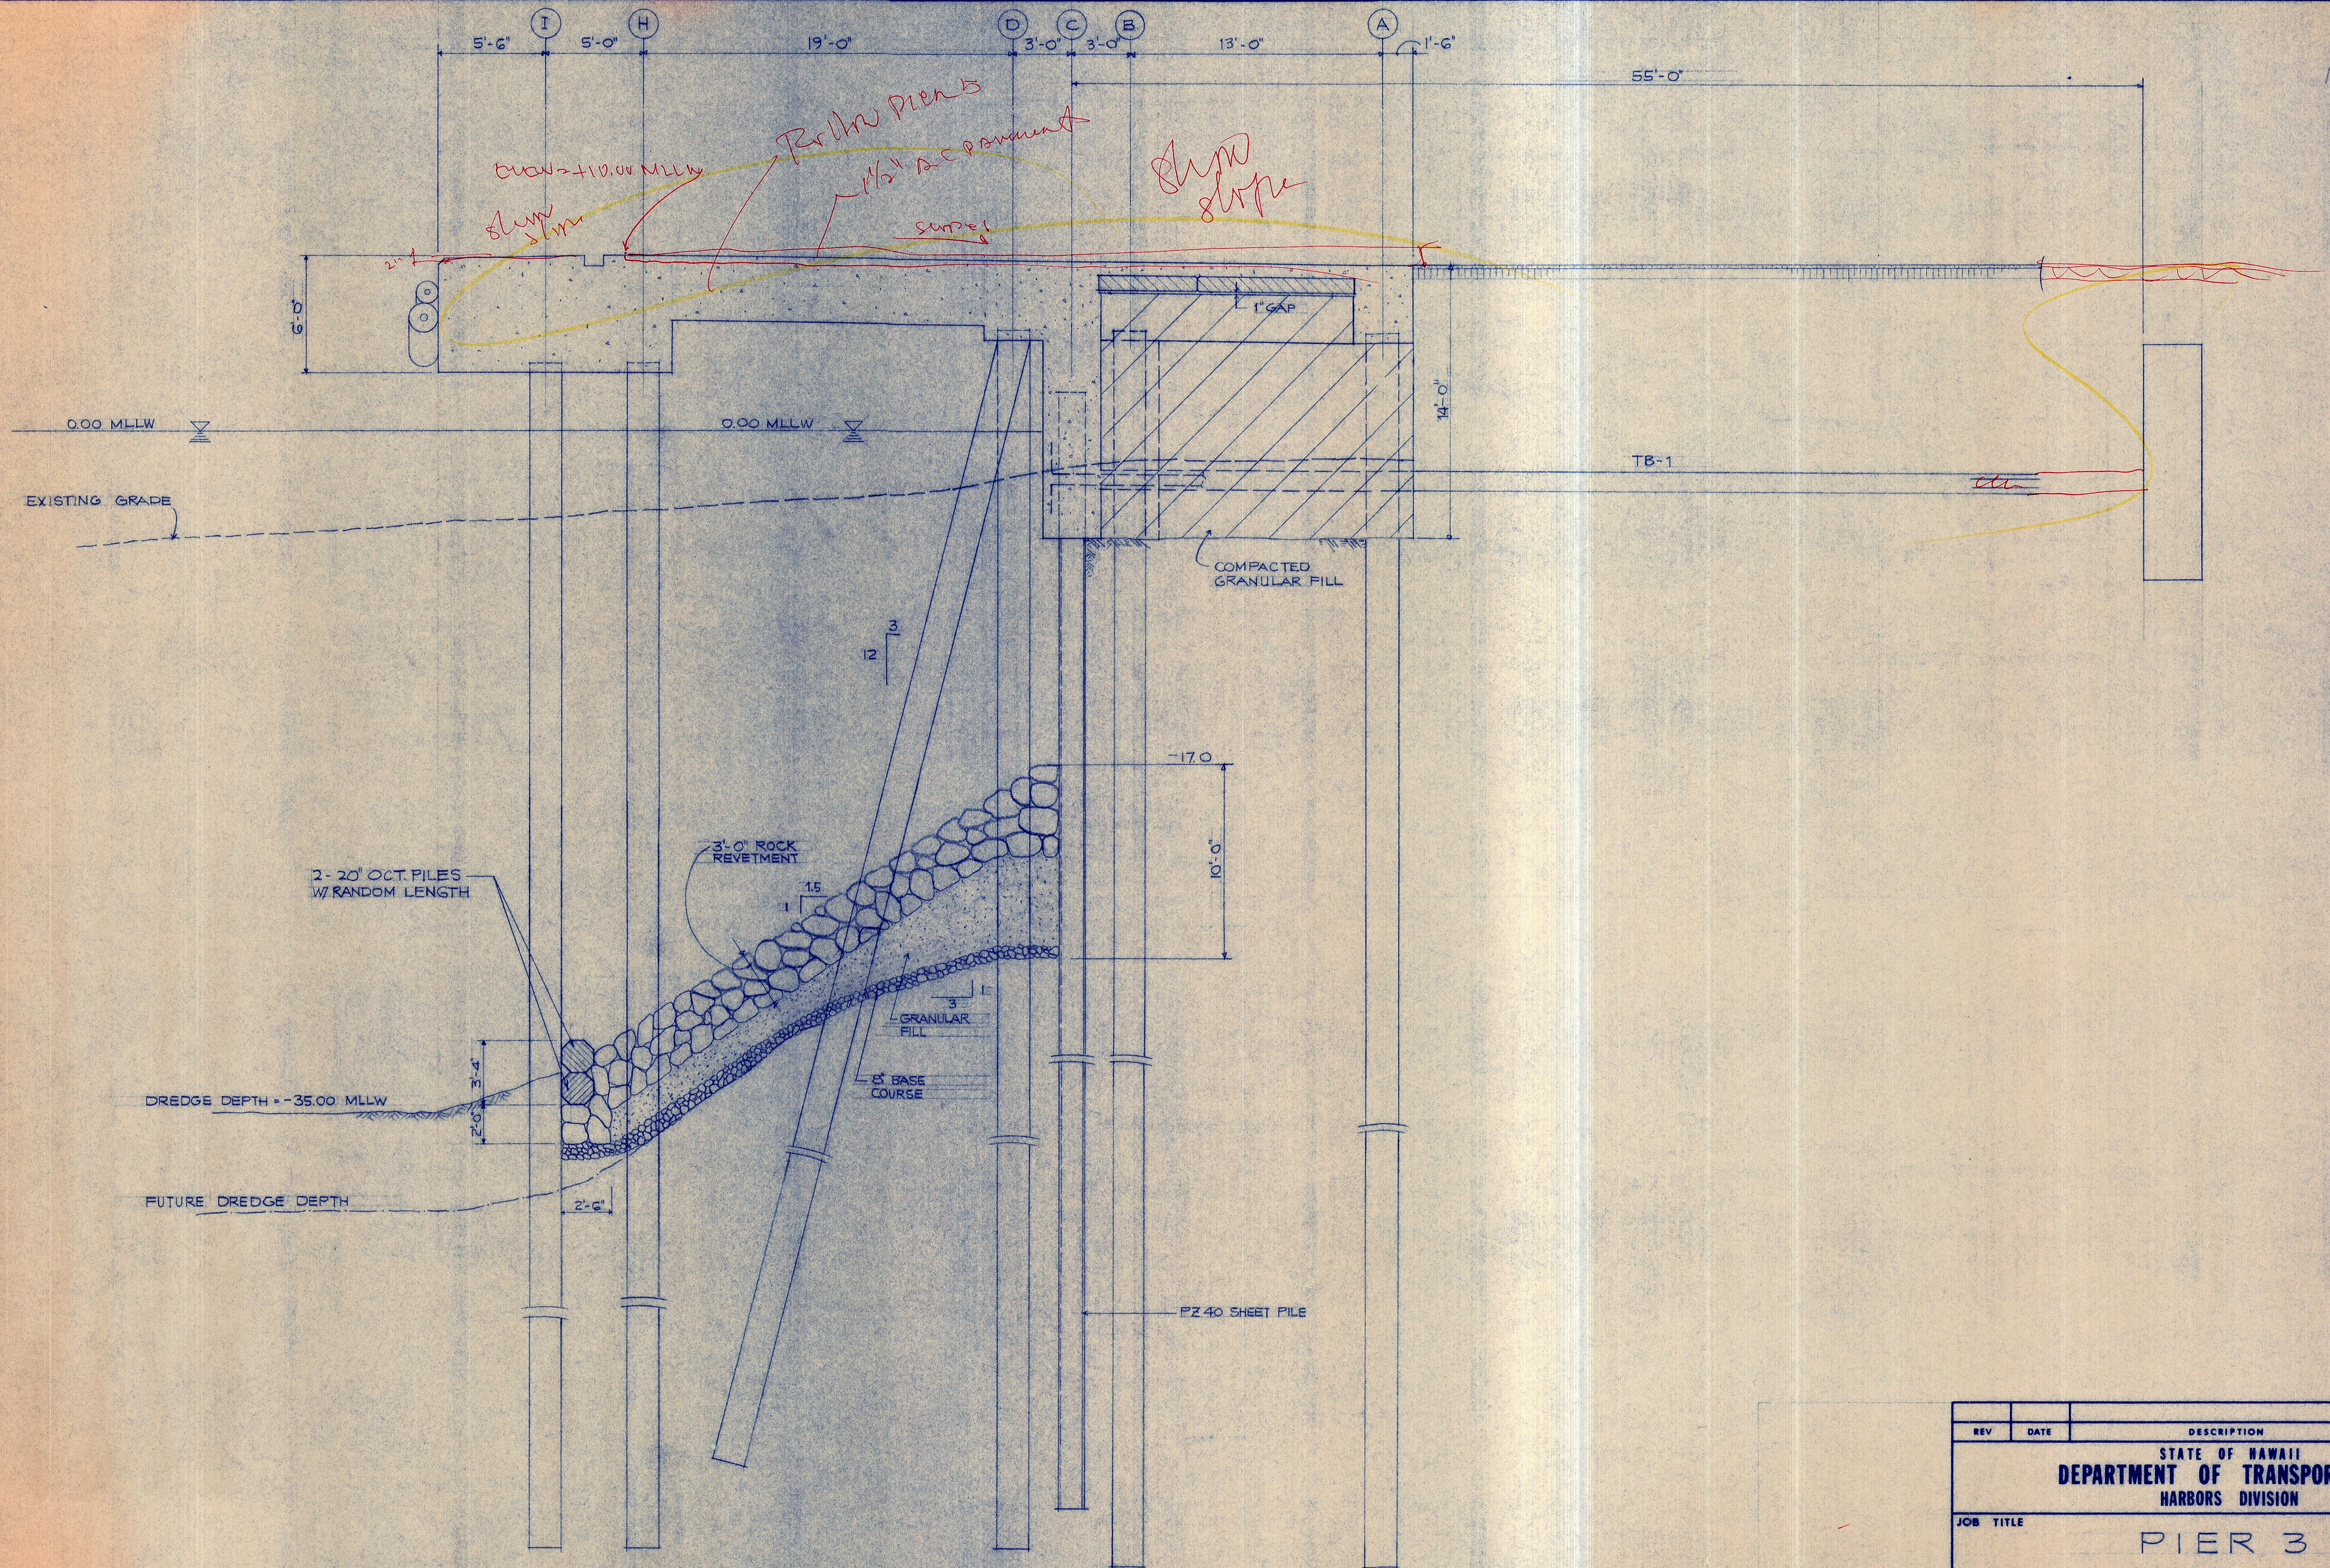

TYPICAL DECK CROSS SECTION A
5-13

SCALE 1/4" = 1'-0"

REV	DATE	DESCRIPTION	BY	APPROVED
STATE OF HAWAII DEPARTMENT OF TRANSPORTATION HARBORS DIVISION				
JOB TITLE KAUAI PIER 3				
SHEET TITLE TYPICAL DECK CROSS SECTION (TYP. DECK AT HEAVY LIFT AREA)				
SUBMITTED BY:			RECOMMENDED BY:	
SECTION HEAD			ASSISTANT CHIEF FOR ENGINEERING	
DESIGNED BY: J.W.		APPROVED BY:		
DRAWN BY: M.M., H.C.		CHIEF, HARBORS DIVISION		
CHECKED BY: T.N., R.T.		JOB NUMBER		
DATE:		H.C. 7157-A		
SCALE: AS NOTED		OF _____ SHTS.		