


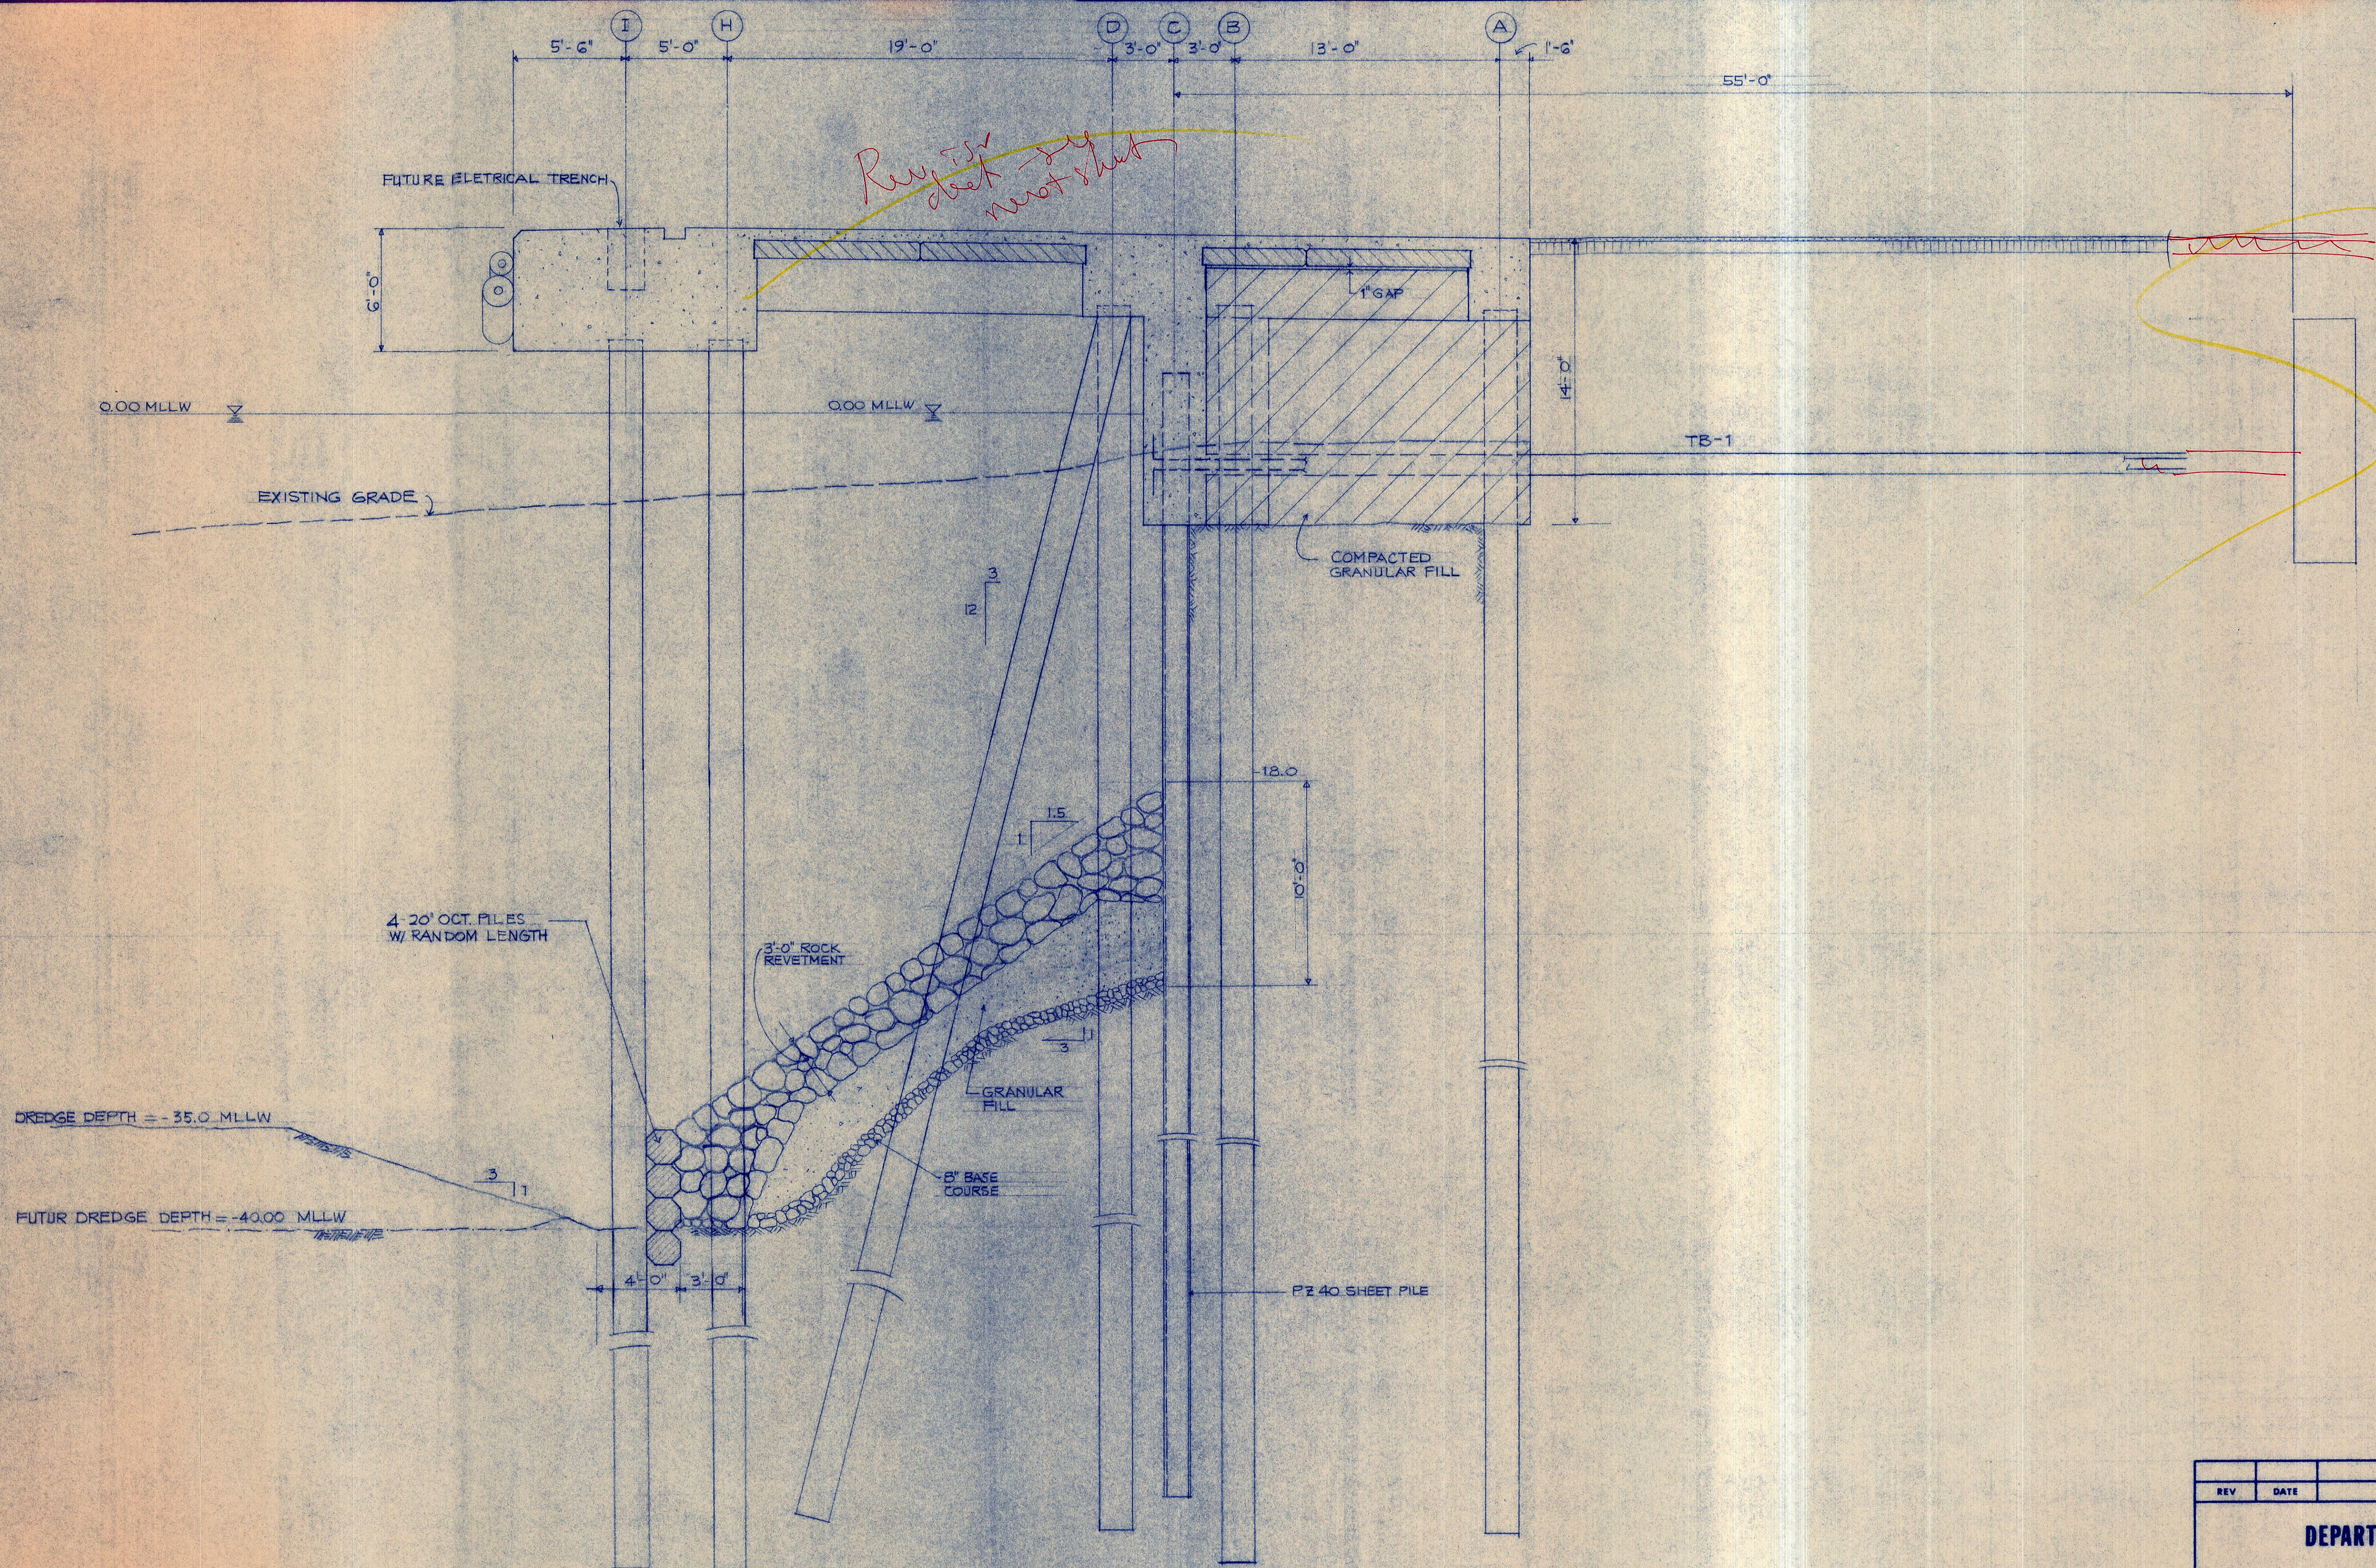

TYPICAL DECK CROSS SECTION A
SCALE 1/4" = 1'-0"

REV	DATE	DESCRIPTION	BY	APPROVED
STATE OF HAWAII DEPARTMENT OF TRANSPORTATION HARBORS DIVISION				
JOB TITLE KAUAI				
SHEET TITLE TYPICAL DECK CROSS SECTION (TYPICAL DECK)				
SUBMITTED BY:			RECOMMENDED BY:	
SECTION HEAD		ASSISTANT CHIEF FOR ENGINEERING		
DESIGNED BY: J.W.	APPROVED BY:		SHEET	
DRAWN BY: M.M., H.C.	CHIEF, HARBORS DIVISION			
CHECKED BY: T.N., R.T.	JOB NUMBER			
DATE:	H.C. 7157-A			
SCALE: AS NOTED		OF SHTS.		