
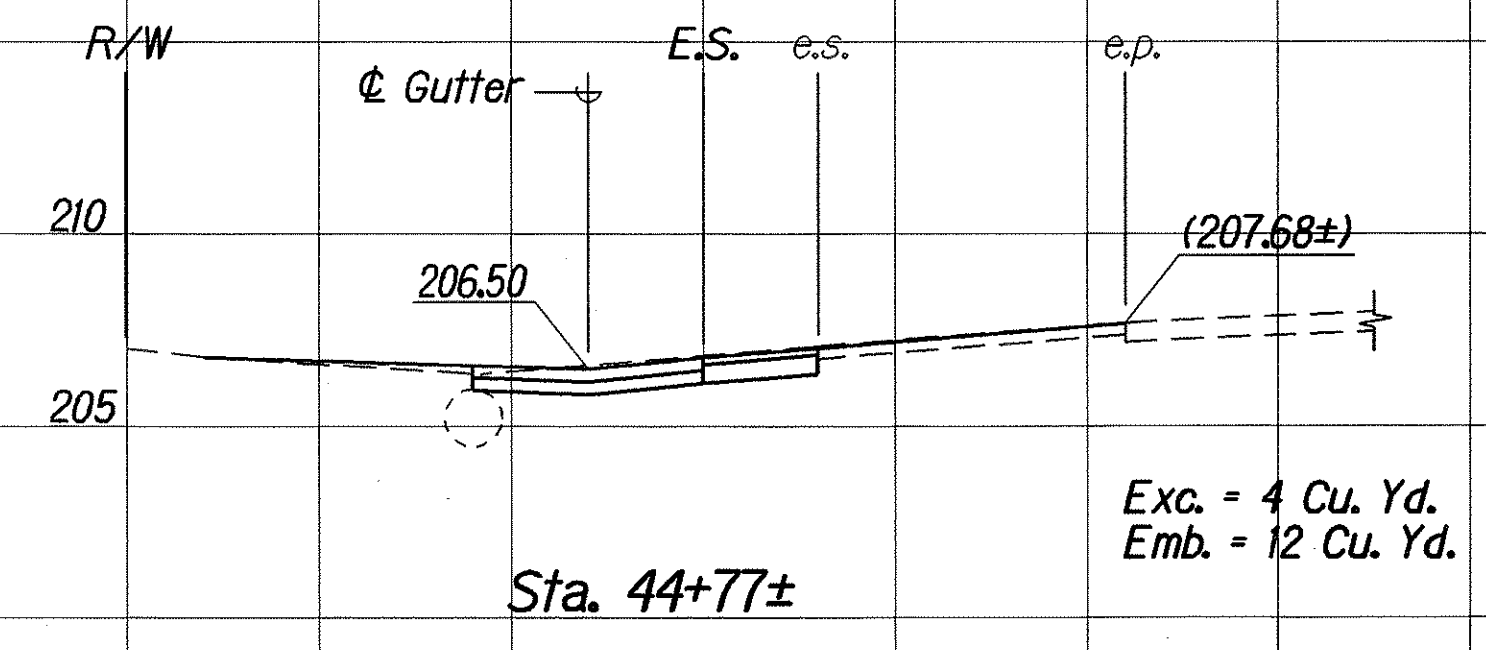
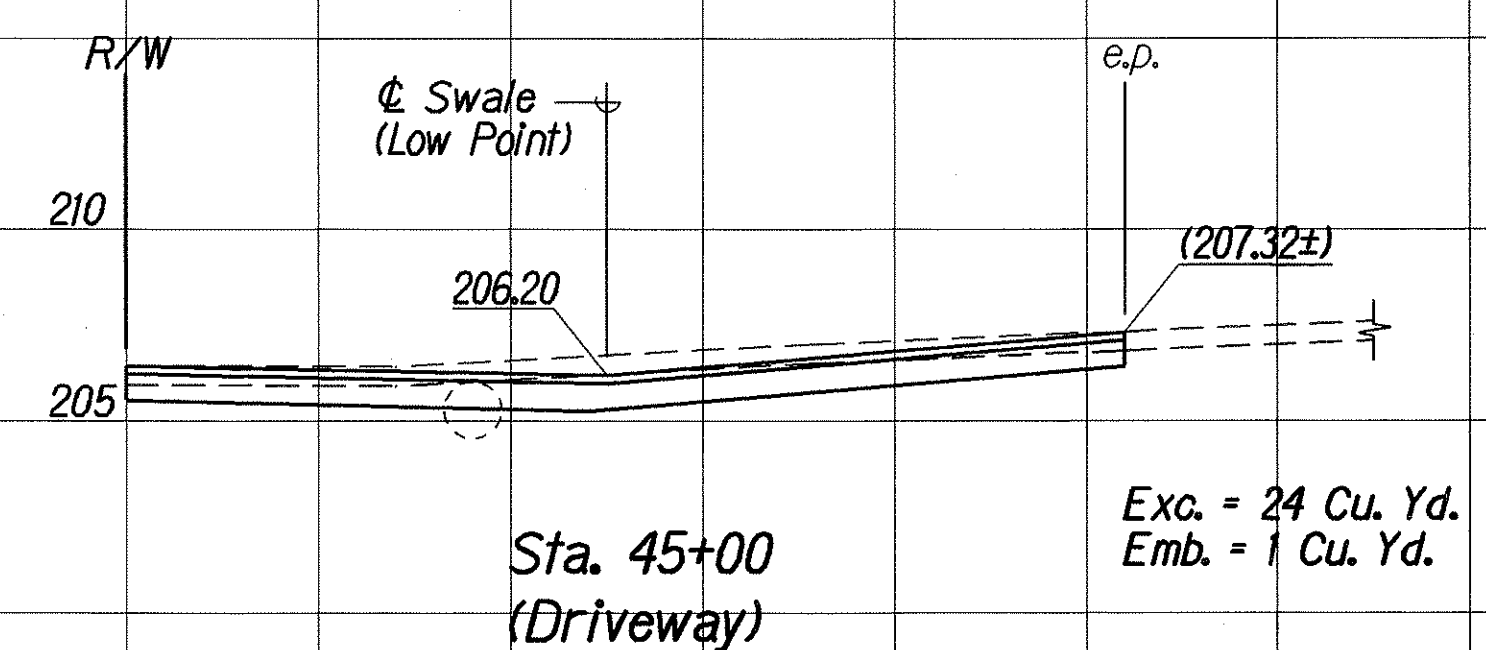
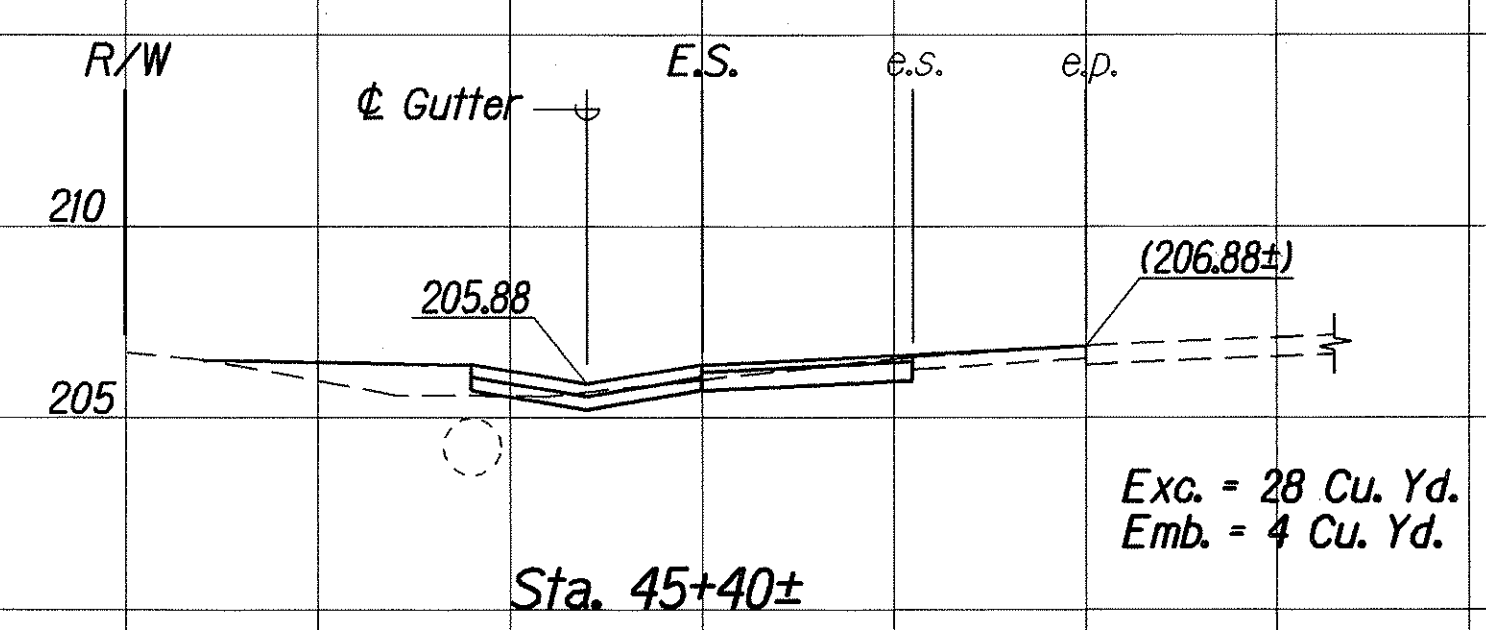
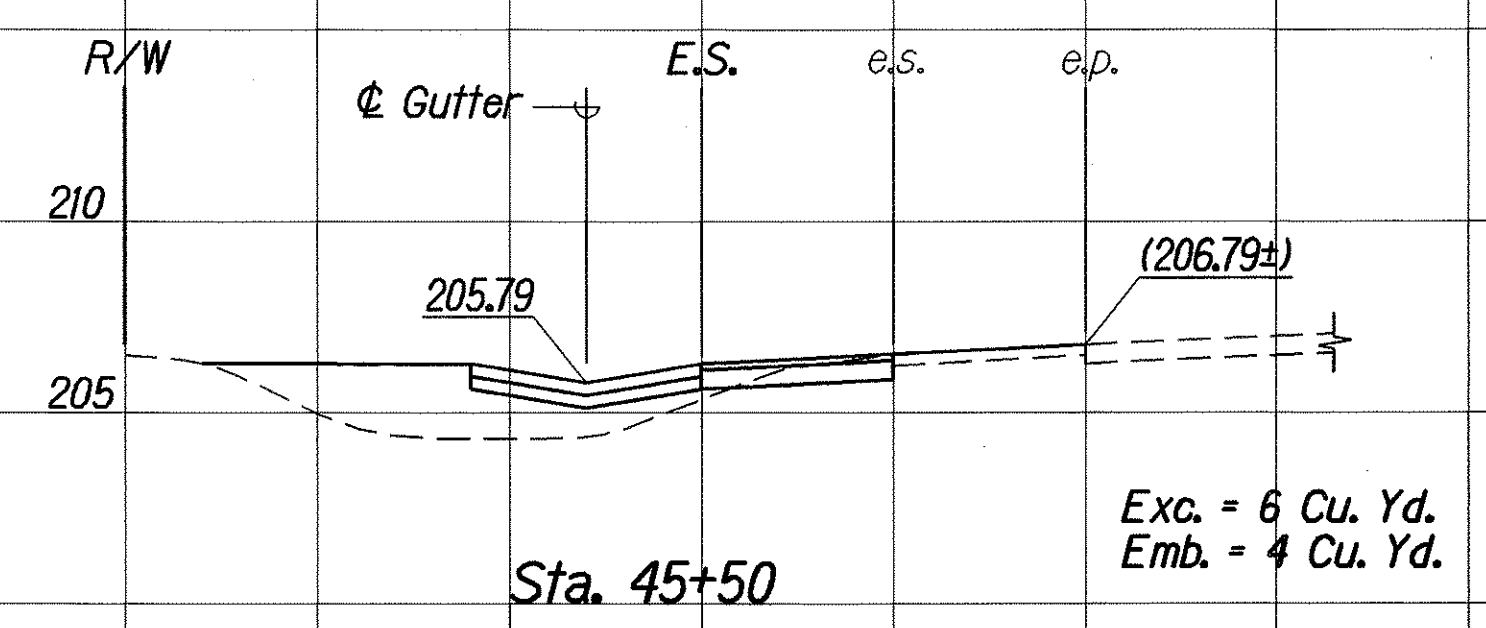
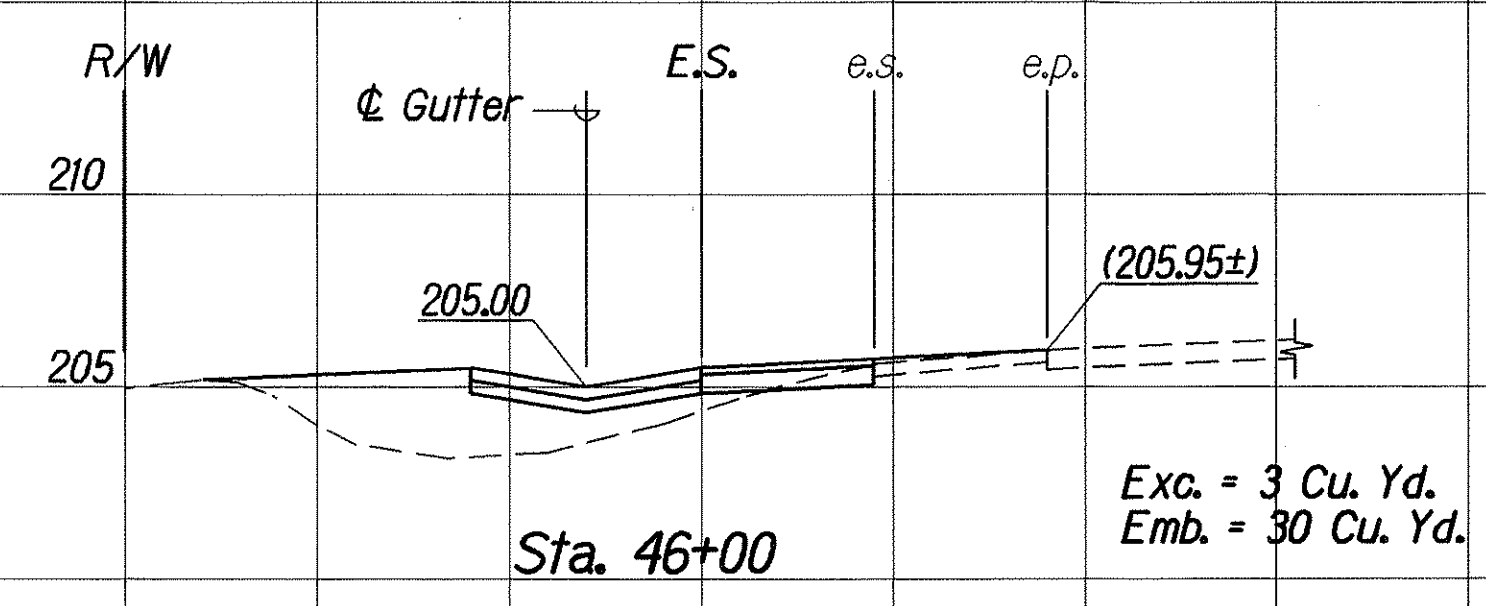
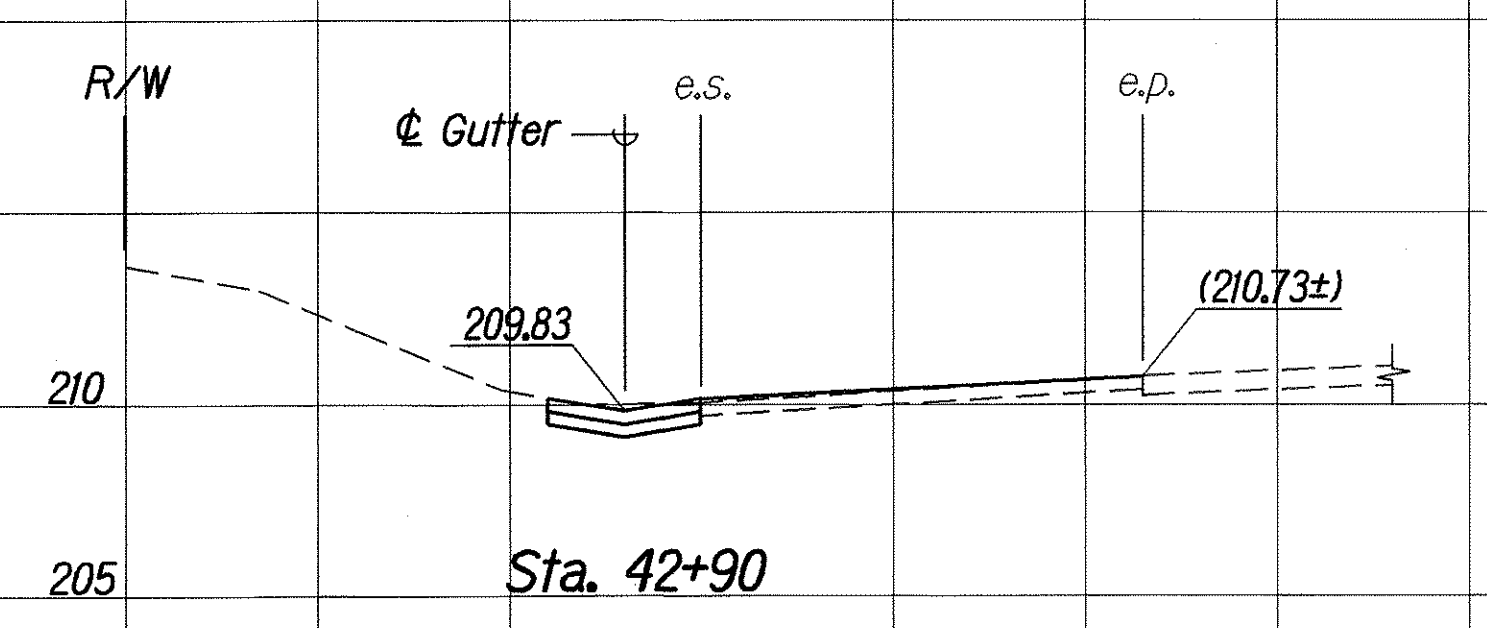
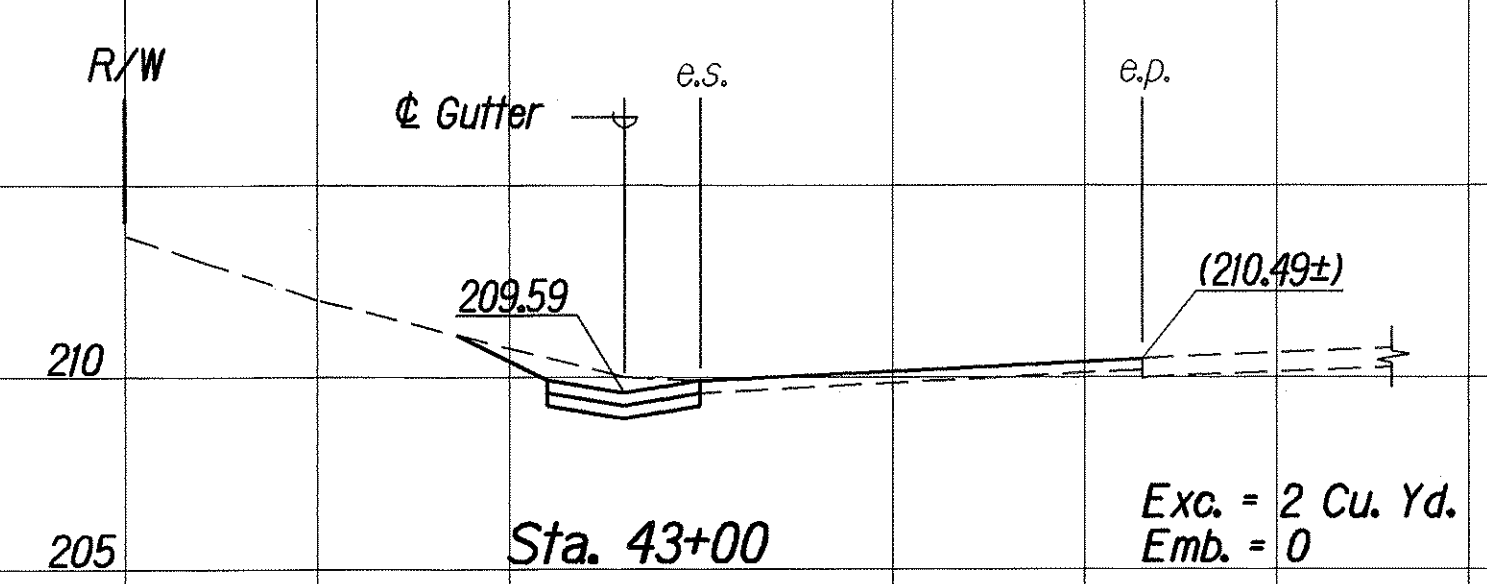
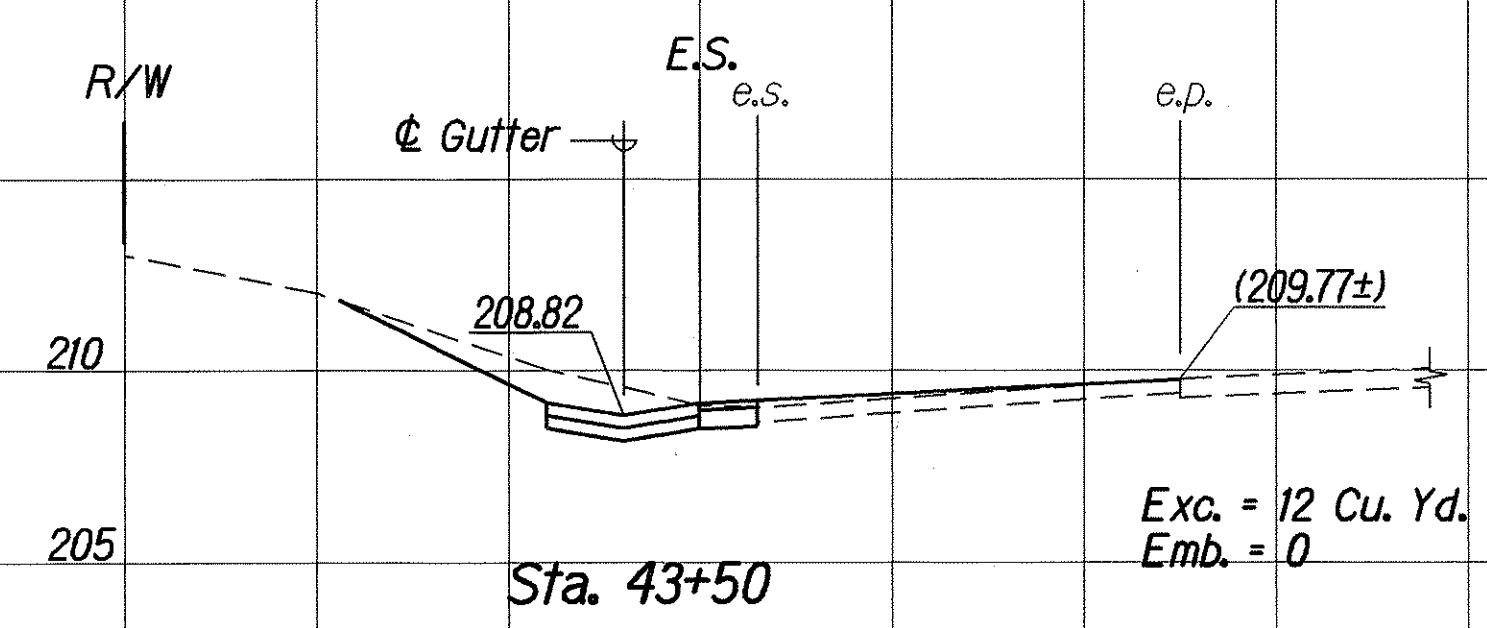
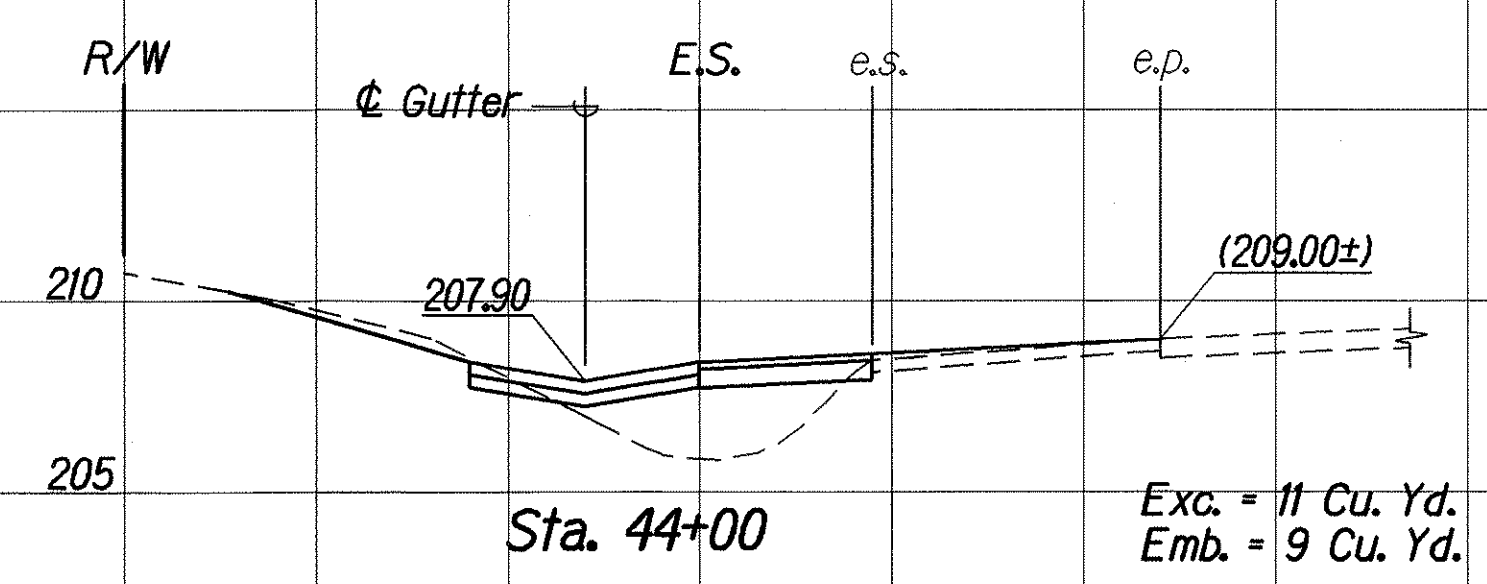




FED. ROAD DIST. NO.	STATE	FED. AID PROJ. NO.	FISCAL YEAR	SHEET NO.	TOTAL SHEETS
HAWAII	HAW.	CMAQ-058-1(4)	2005	23	23

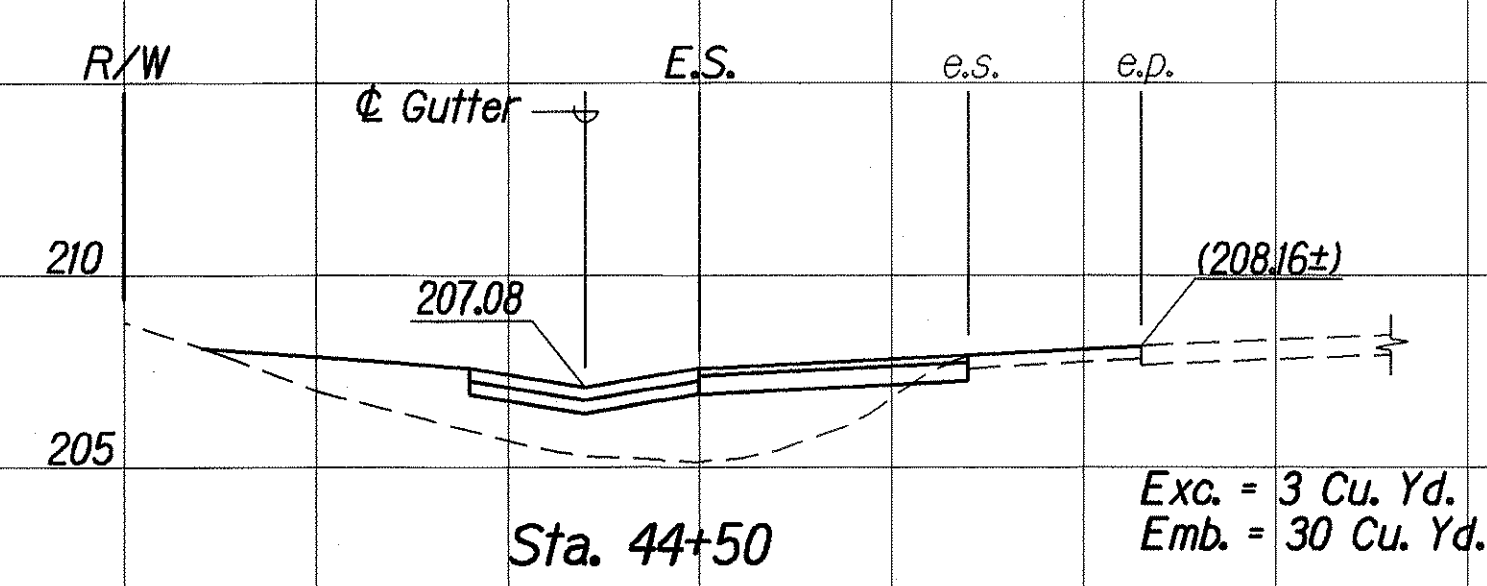

SCALES: Hor. 1" = 5'
Vert. 1" = 5'

EARTHWORK VOLUMES:
Exc. = 110 Cu. Yd.
EMB. = 120 Cu. Yd.

NOTE: (xxx.xx±) denotes approximate existing pavement elevation.

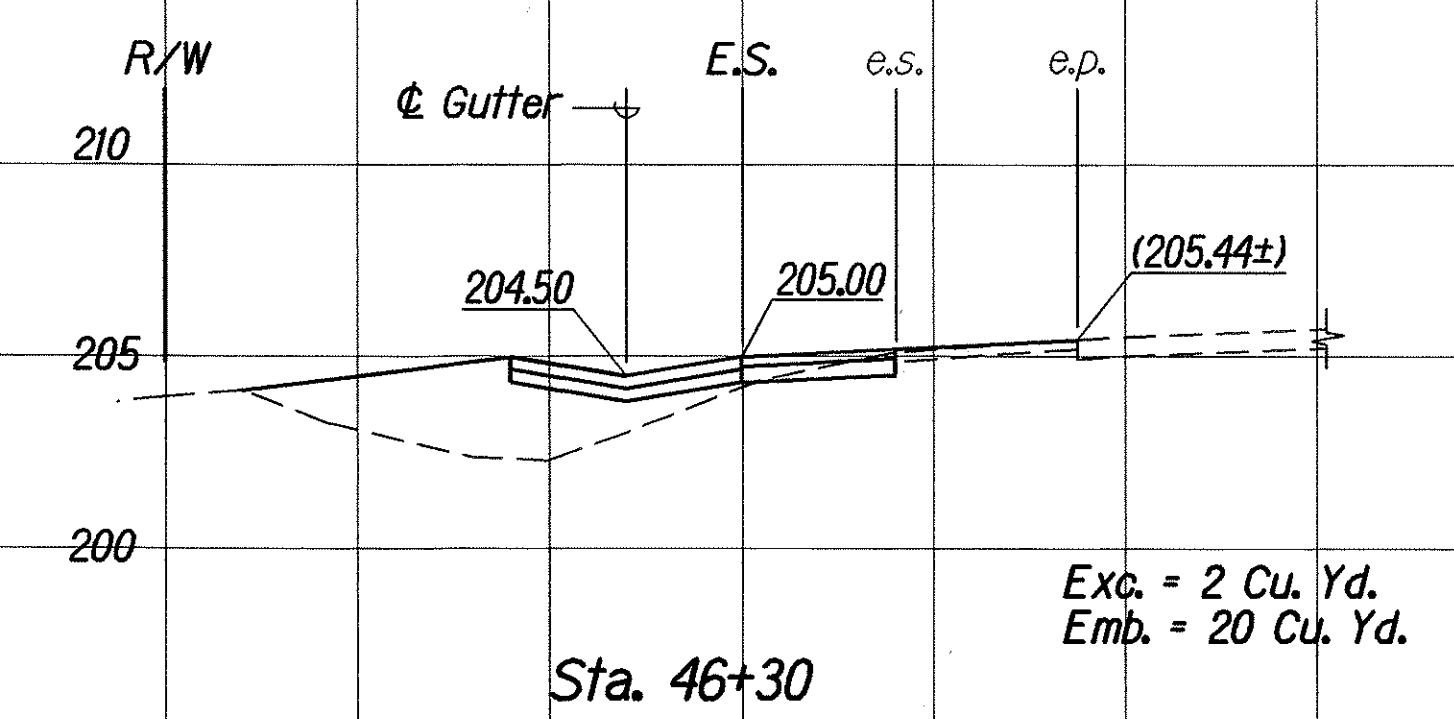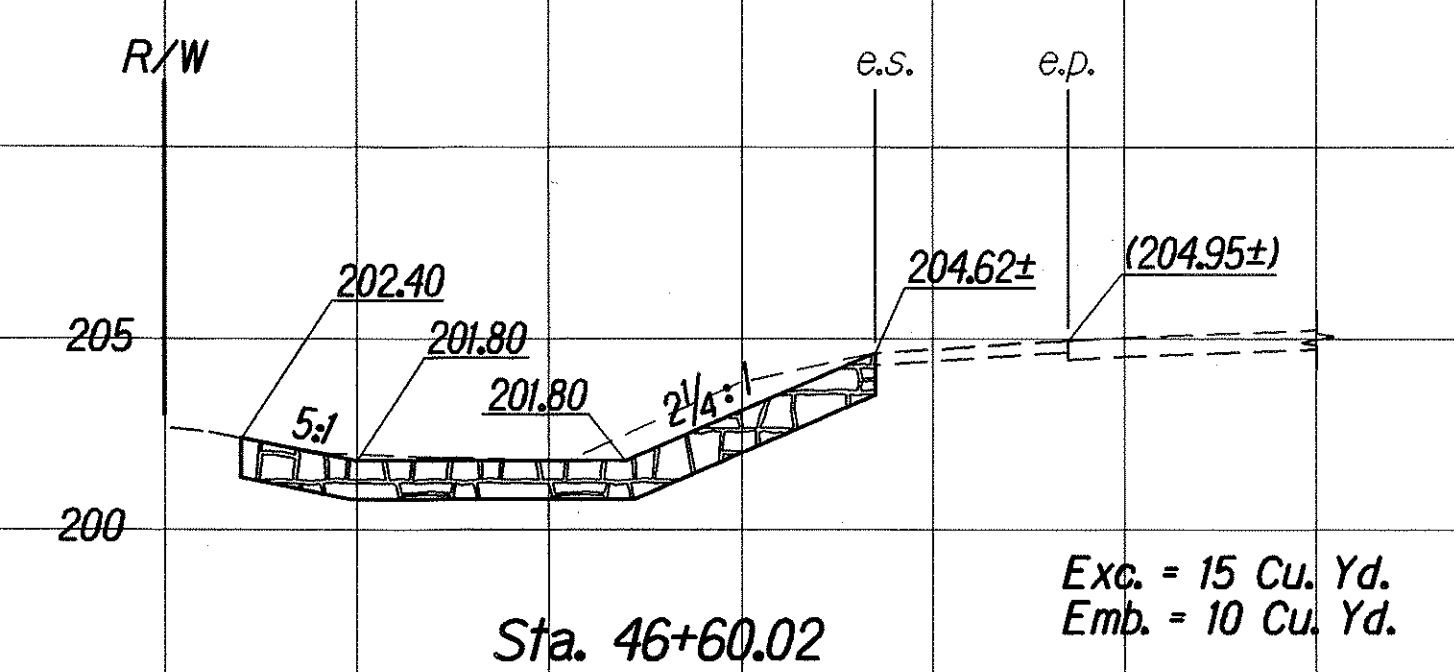

CROSS SECTIONS FOR GUTTER & SHOULDER WORK
SHOWN ON PLAN SHT. #16 & #17

ORIGINAL PLAN	DATE	1/20
SURVEY PLOTTED BY		
DRAWN BY		
DESIGNED BY		
QUANTITIES BY		
CHECKED BY		