

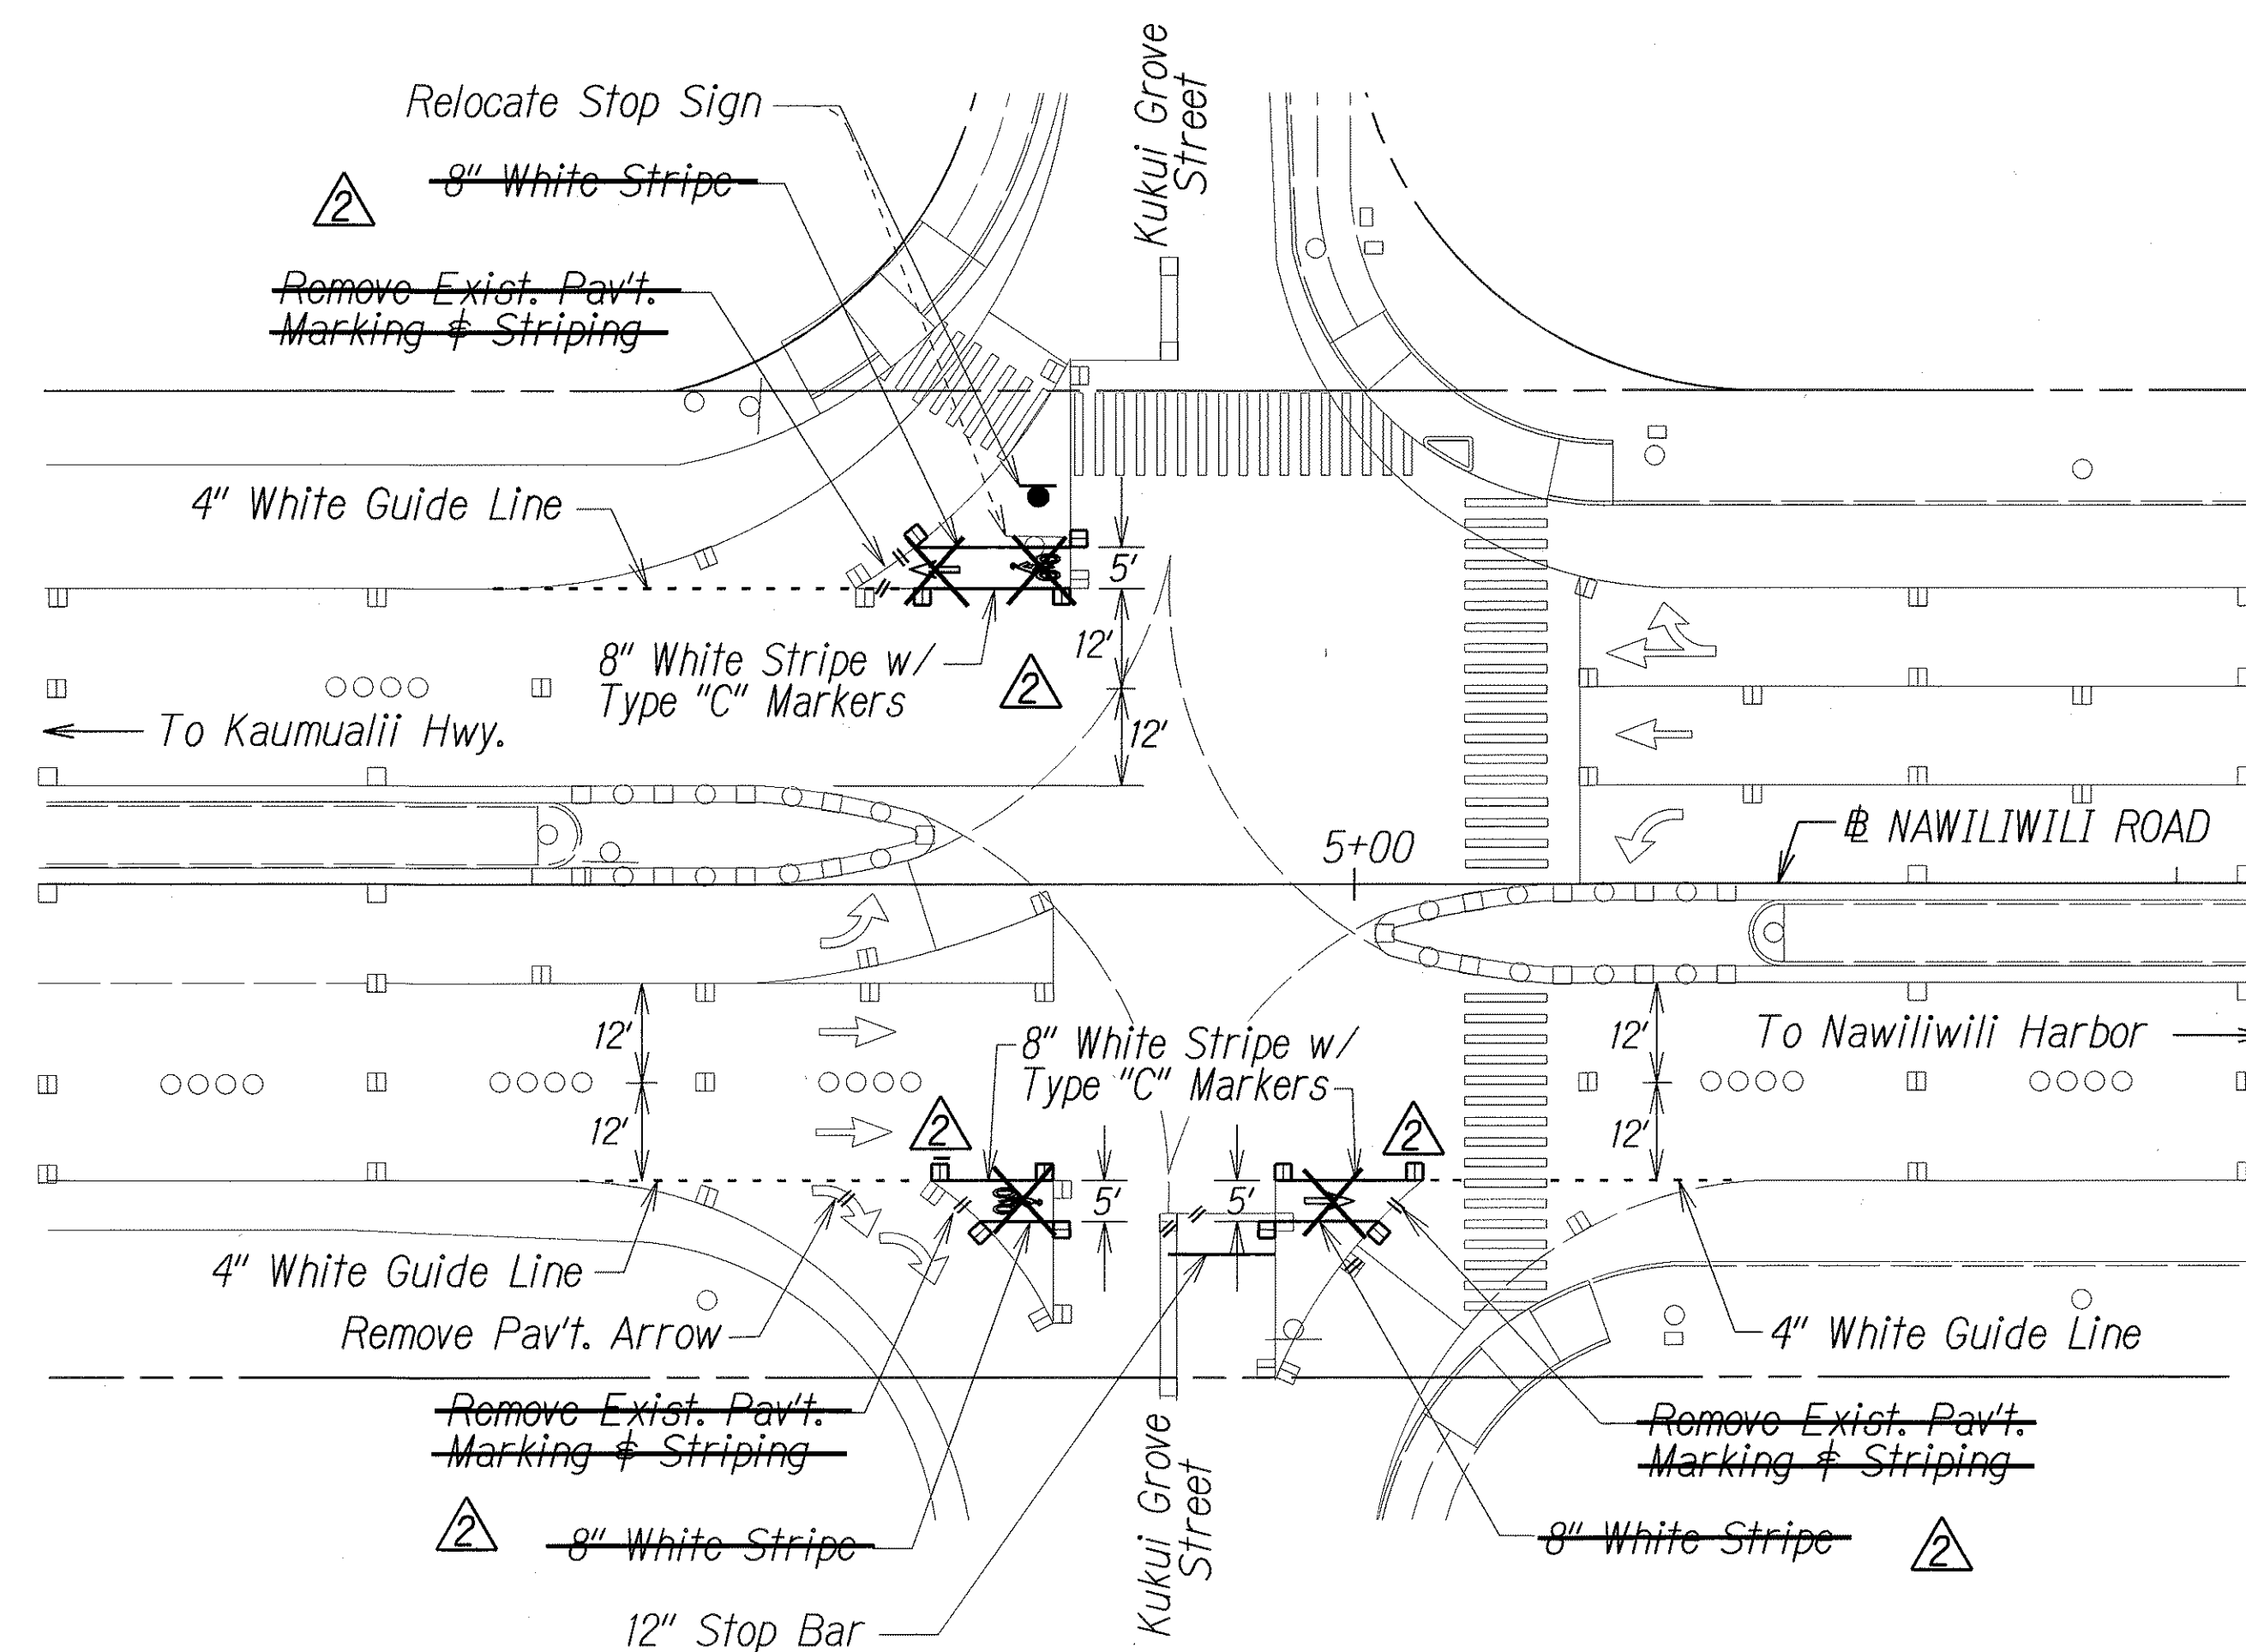


FED. ROAD DIST. NO.	STATE	FED. AID PROJ. NO.	FISCAL YEAR	SHEET NO.	TOTAL SHEETS
HAWAII	HAW.	CMAQ-058-1(4)	2005	C.O. 19	23

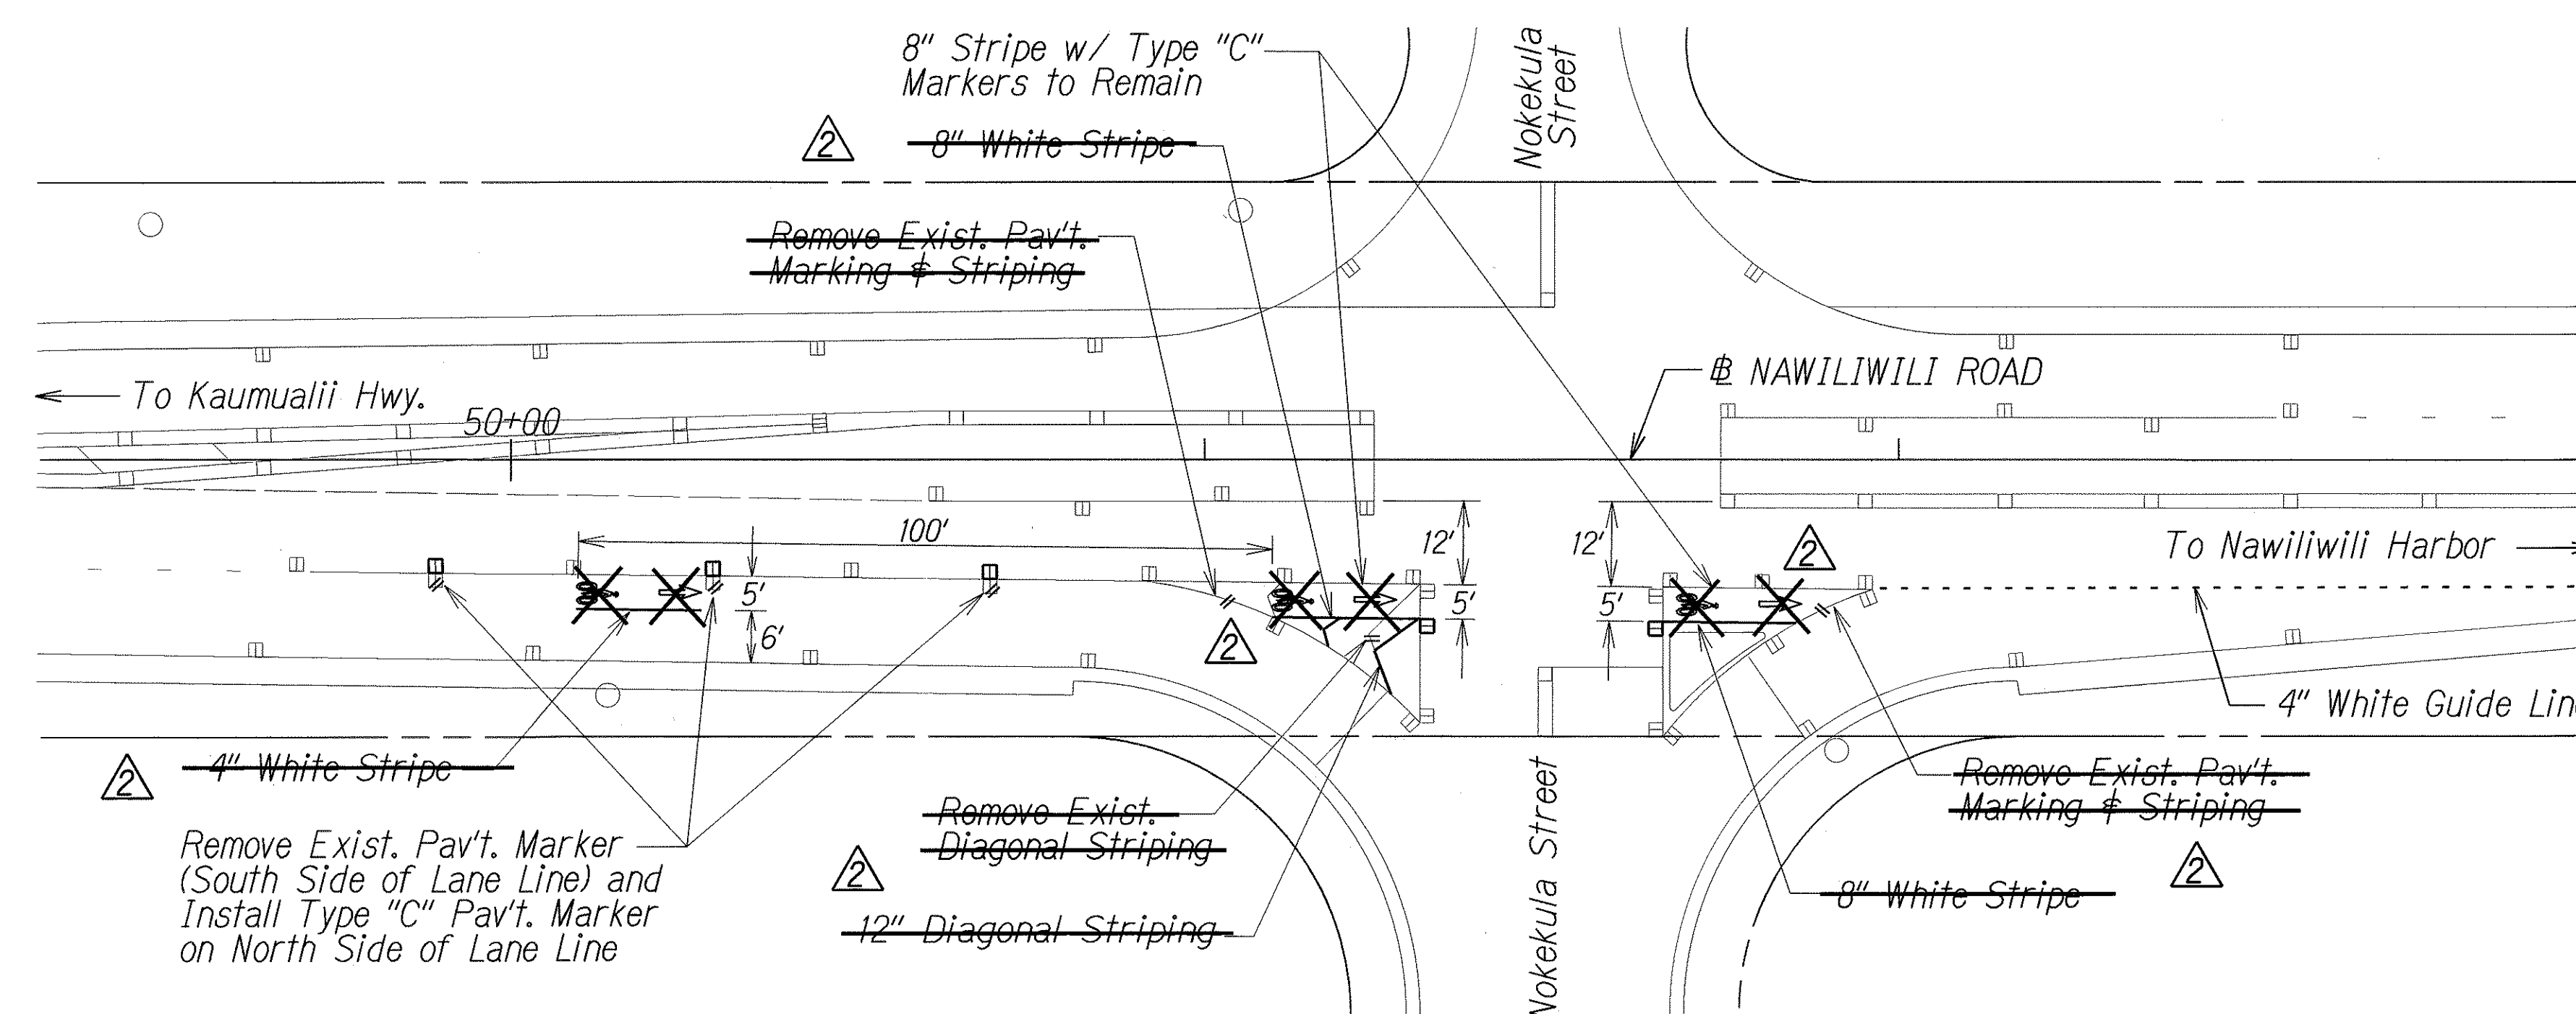

KUKUI GROVE STREET - NAWILIWILI ROAD INTERSECTION

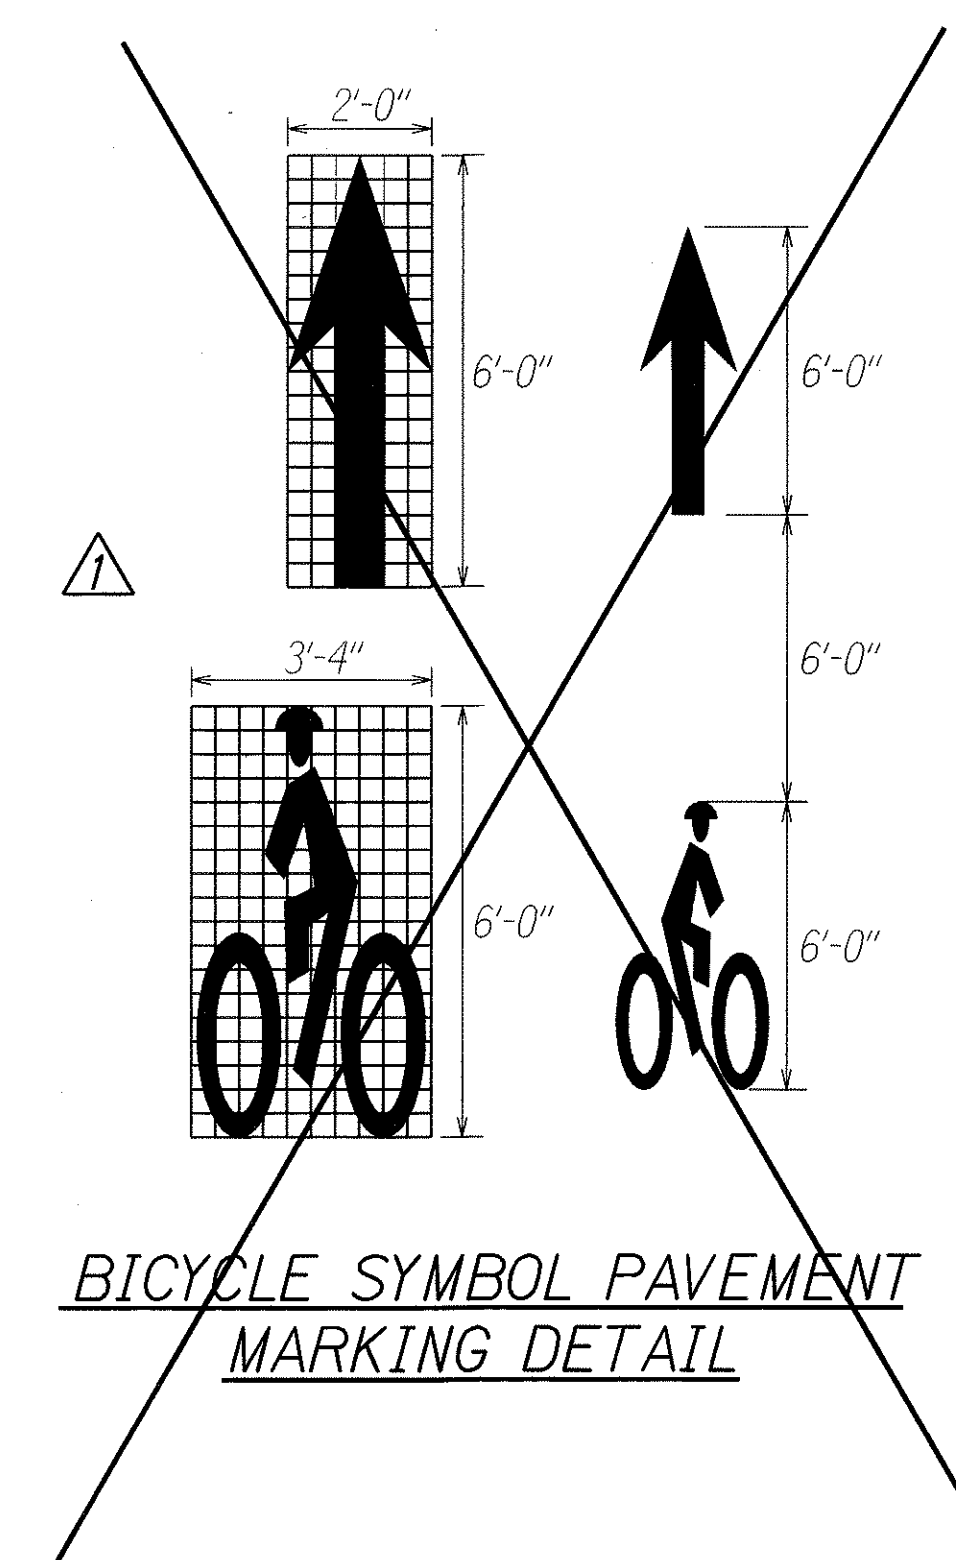

NOKEKULA STREET - NAWILIWILI ROAD INTERSECTION

10/01/07	2	Deleted Pavement Marking & Striping Callout and Pavement Symbols
	1	Deleted Bicycle Symbol Pavement Marking Detail
DATE		REVISION

STATE OF HAWAII
DEPARTMENT OF TRANSPORTATION
HIGHWAYS DIVISION

PAVEMENT MARKING PLAN

NAWILIWILI ROAD BIKEWAY
Kaumualii Highway to Waapa Road
Fed. Aid Project No. CMAQ-058-1(4)


Scale: 1" = 20' Date: April 2005

SHEET No. 1 OF 3 SHEETS


C.O. 19

ORIGINAL PLAN	DATE
SURVEY PLOTTED BY	
DRAWN BY	
DESIGNED BY	
CHECKED BY	
IN CHARGE	

FED. ROAD DIST. NO.	STATE	FED. AID PROJ. NO.	FISCAL YEAR	SHEET NO.	TOTAL SHEETS
HAWAII	HAW.	CMAQ-058-1(4)	2005	C.O. 20	23

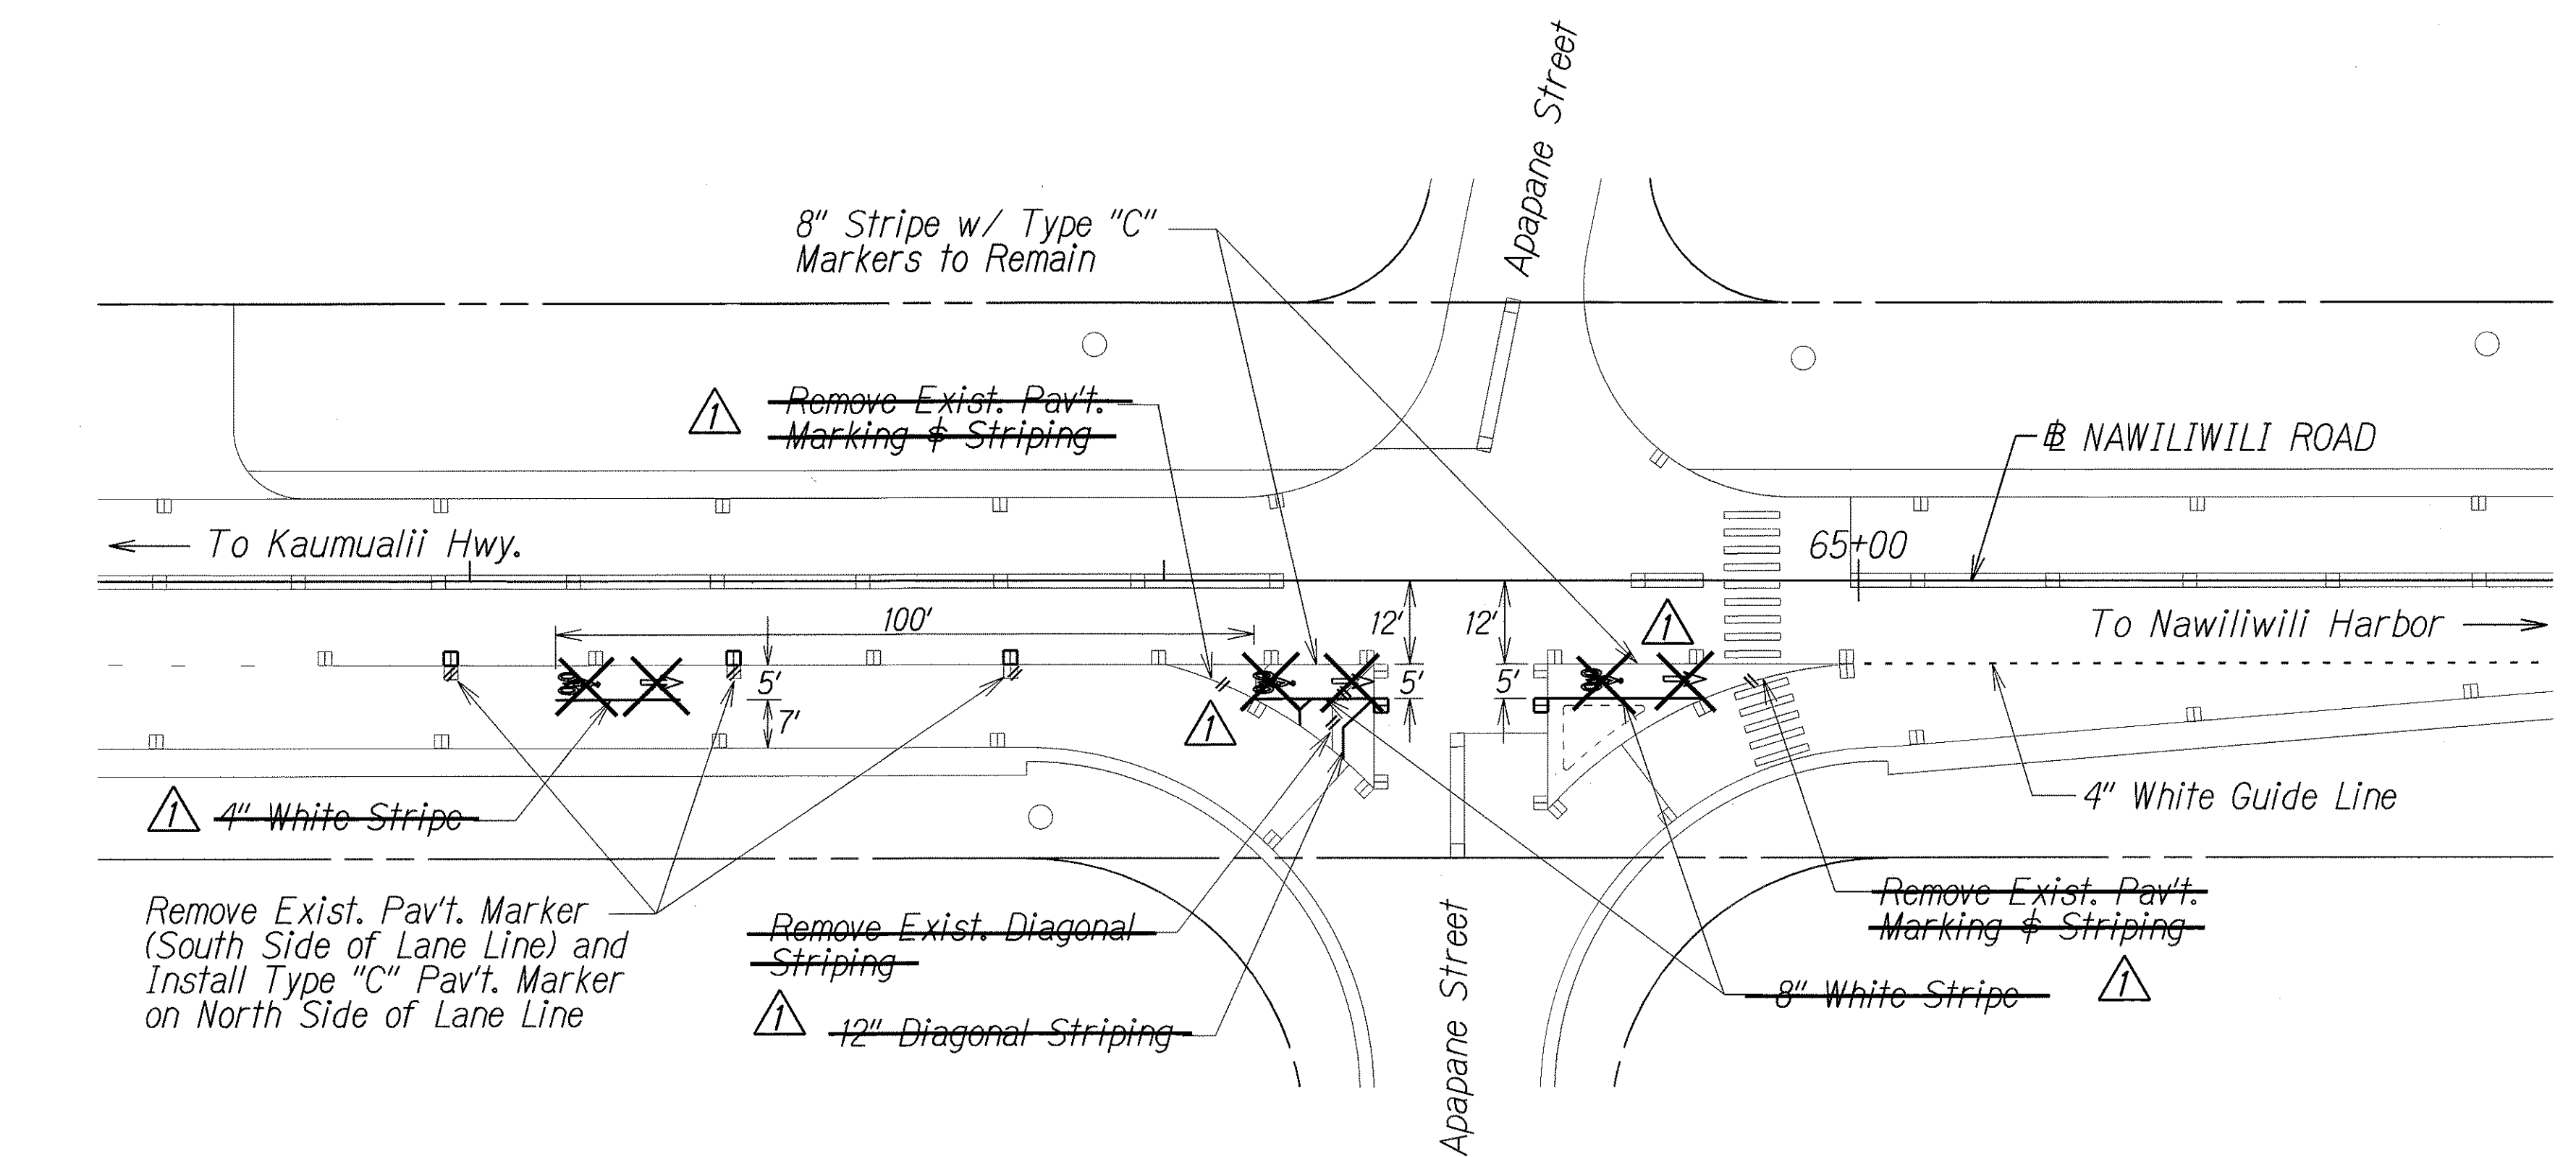

APAPANE STREET - NAWILIWILI ROAD INTERSECTION

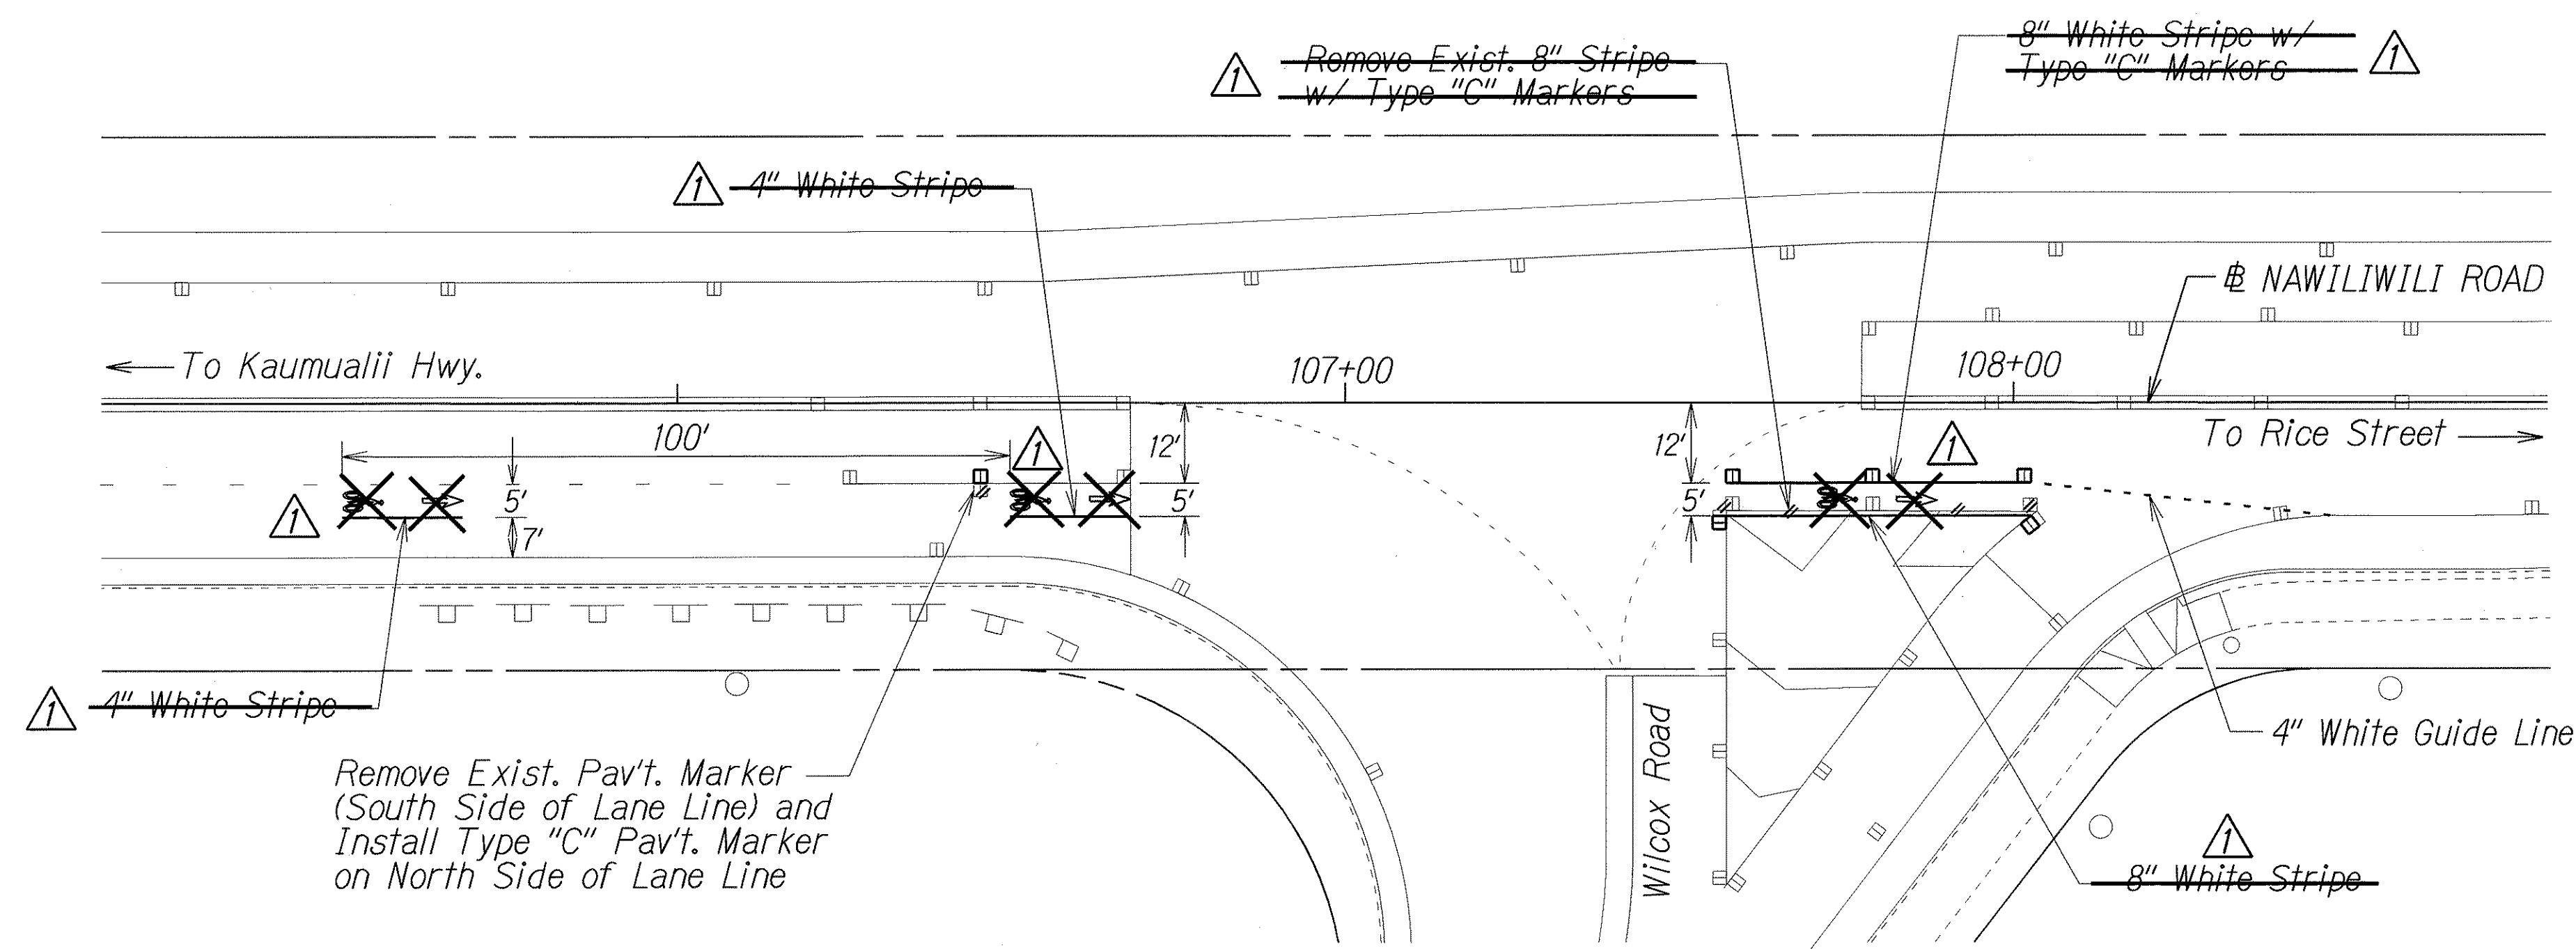


WILCOX ROAD - NAWILIWILI ROAD INTERSECTION

ORIGINAL PLAN	SURVEY PLOTTED BY	DATE
TRACED BY		
NOTED BY		
CHECKED BY		

10/01/07	Deleted Pavement Marking & Striping Callout and Pavement Symbols
DATE	REVISION
STATE OF HAWAII DEPARTMENT OF TRANSPORTATION HIGHWAYS DIVISION	
PAVEMENT MARKING PLAN	
NAWILIWILI ROAD BIKEWAY Kaunualii Highway to Waapa Road Fed. Aid Project No. CMAQ-058-1(4)	
Scale: 1" = 20'	Date: April 2005
SHEET No. 2 OF 3 SHEETS	

FED. ROAD DIST. NO.	STATE	FED. AID PROJ. NO.	FISCAL YEAR	SHEET NO.	TOTAL SHEETS
HAWAII	HAW.	CMAQ-058-1(4)	2005	C.O. 21	23

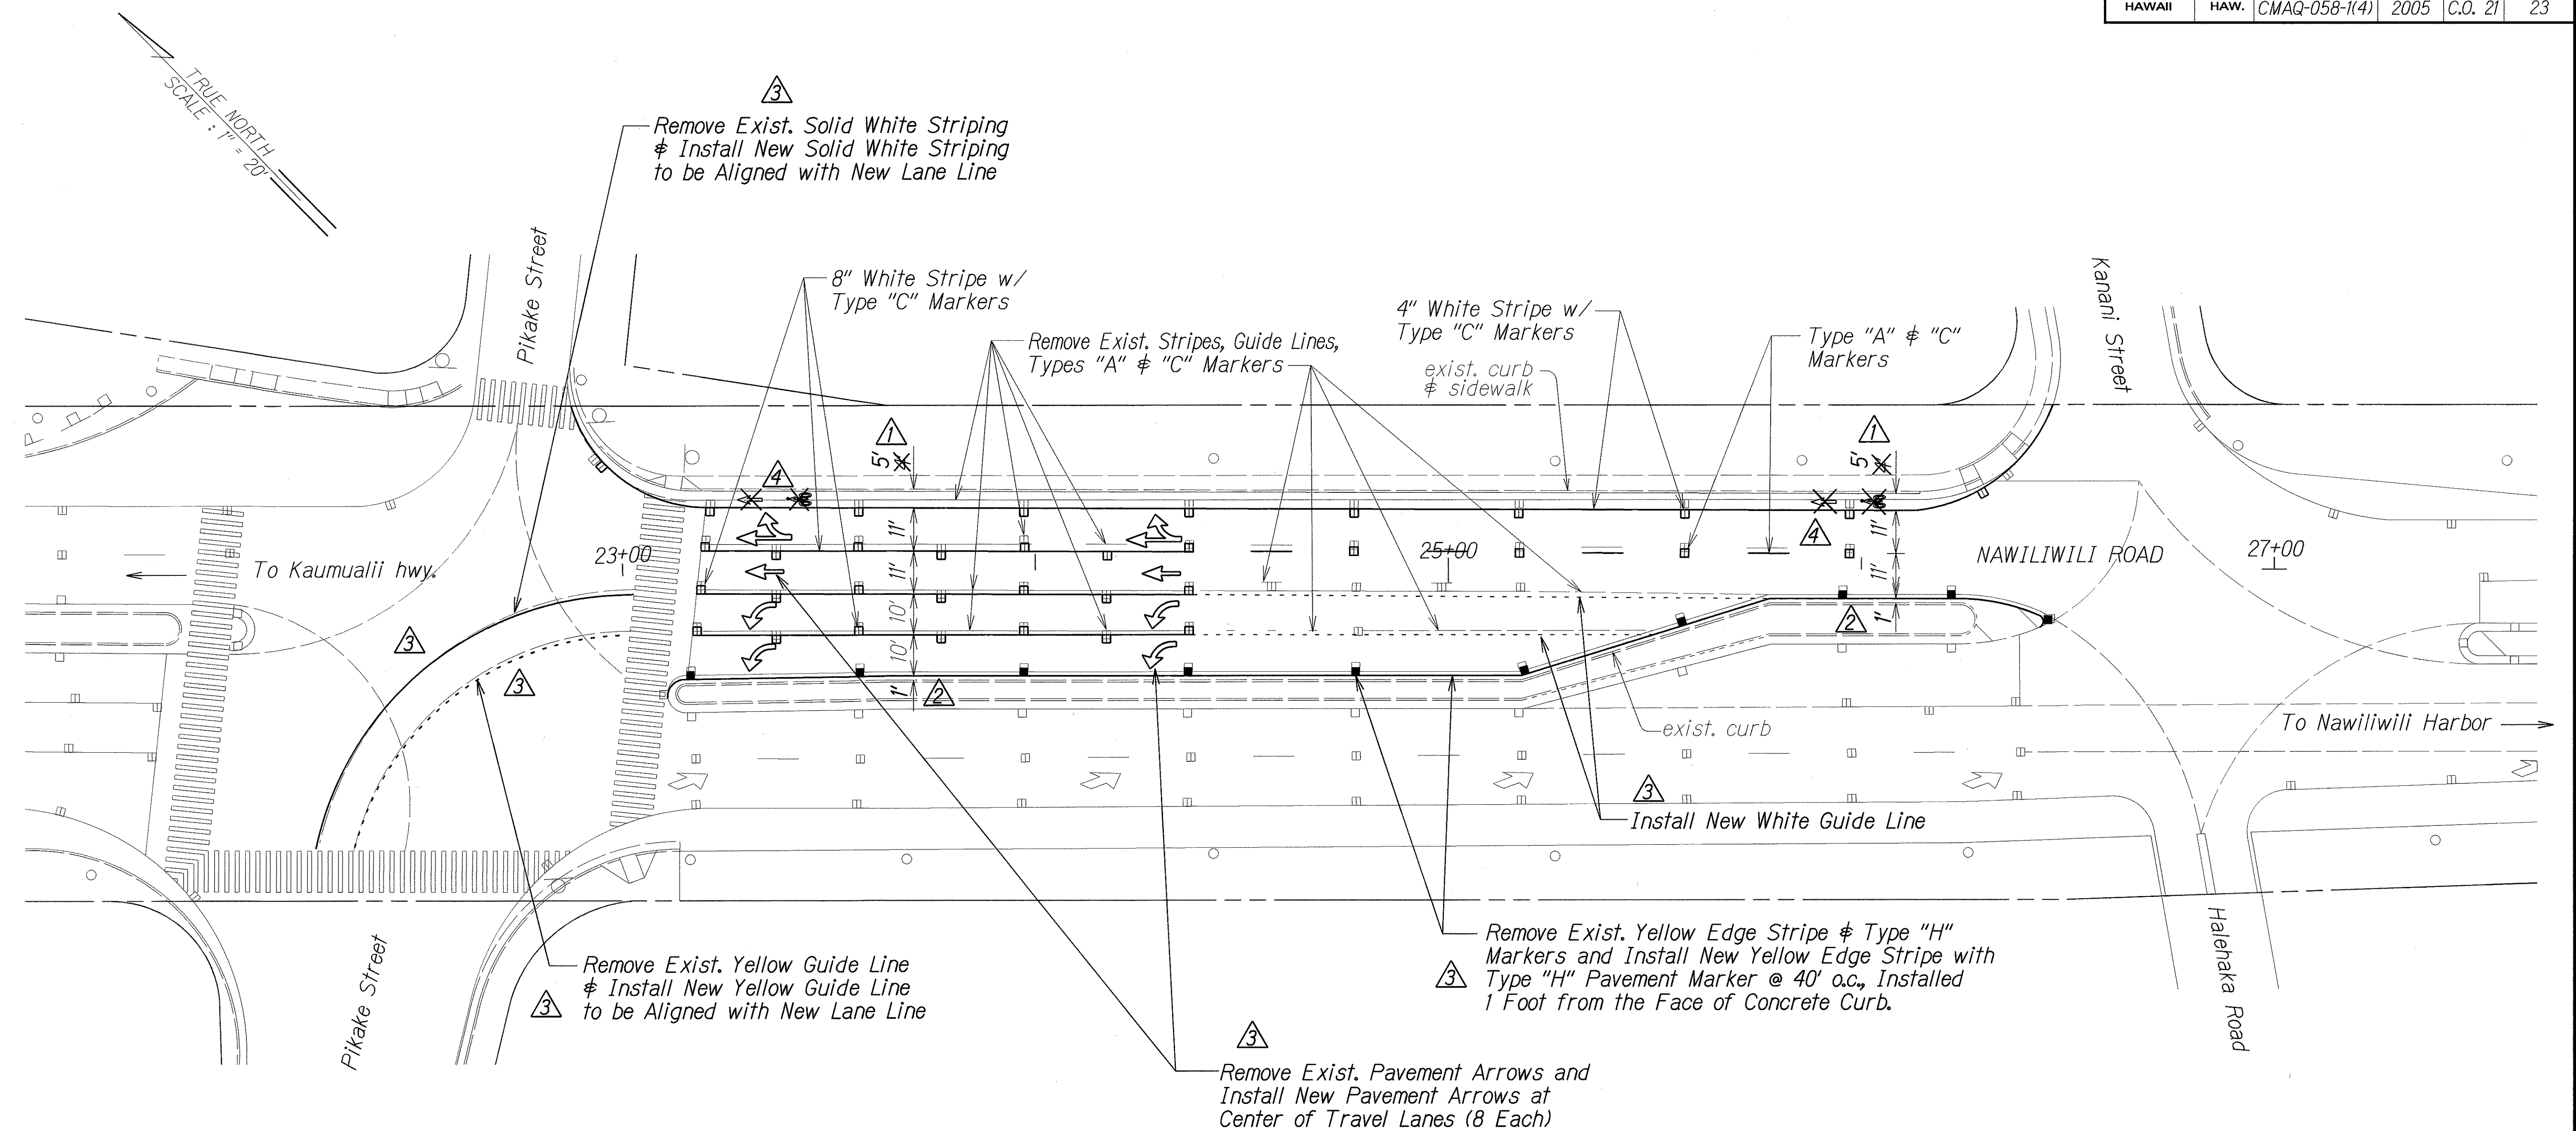

PIKAKE STREET TO KANANI STREET

10/01/07	Deleted Bicycle and Arrow Pavement Symbols
	Added Callout for Removal and Installation of Pavement Markings
	Shown Location of New Yellow Edge Striping & Type "H" Pav't. Marker
	Revised Paved Shoulder Width
DATE	REVISION

STATE OF HAWAII
DEPARTMENT OF TRANSPORTATION
HIGHWAYS DIVISION

PAVEMENT MARKING PLAN

NAWILIWILI ROAD BIKEWAY
Kaumualii Highway to Waapa Road
Fed. Aid Project No. CMAQ-058-1(4)

Scale: 1" = 20' Date: April 2005

SHEET No. 3 OF 3 SHEETS

ORIGINAL PLAN	DATE
SURVEY PLOTTED BY	
DRAWN BY	
DESIGNED BY	
CHECKED BY	
NOTED BY	
DATE	