


FED. ROAD DIST. NO.	STATE	FED. AID PROJ. NO.	FISCAL YEAR	SHEET NO.	TOTAL SHEETS
HAWAII	HAW.	CMAQ-058-1(4)	2005	10	23

BEGIN PROJECT
Fed. Aid Proj. No. CMAQ-058-1(4)
Sta. 0+00.00

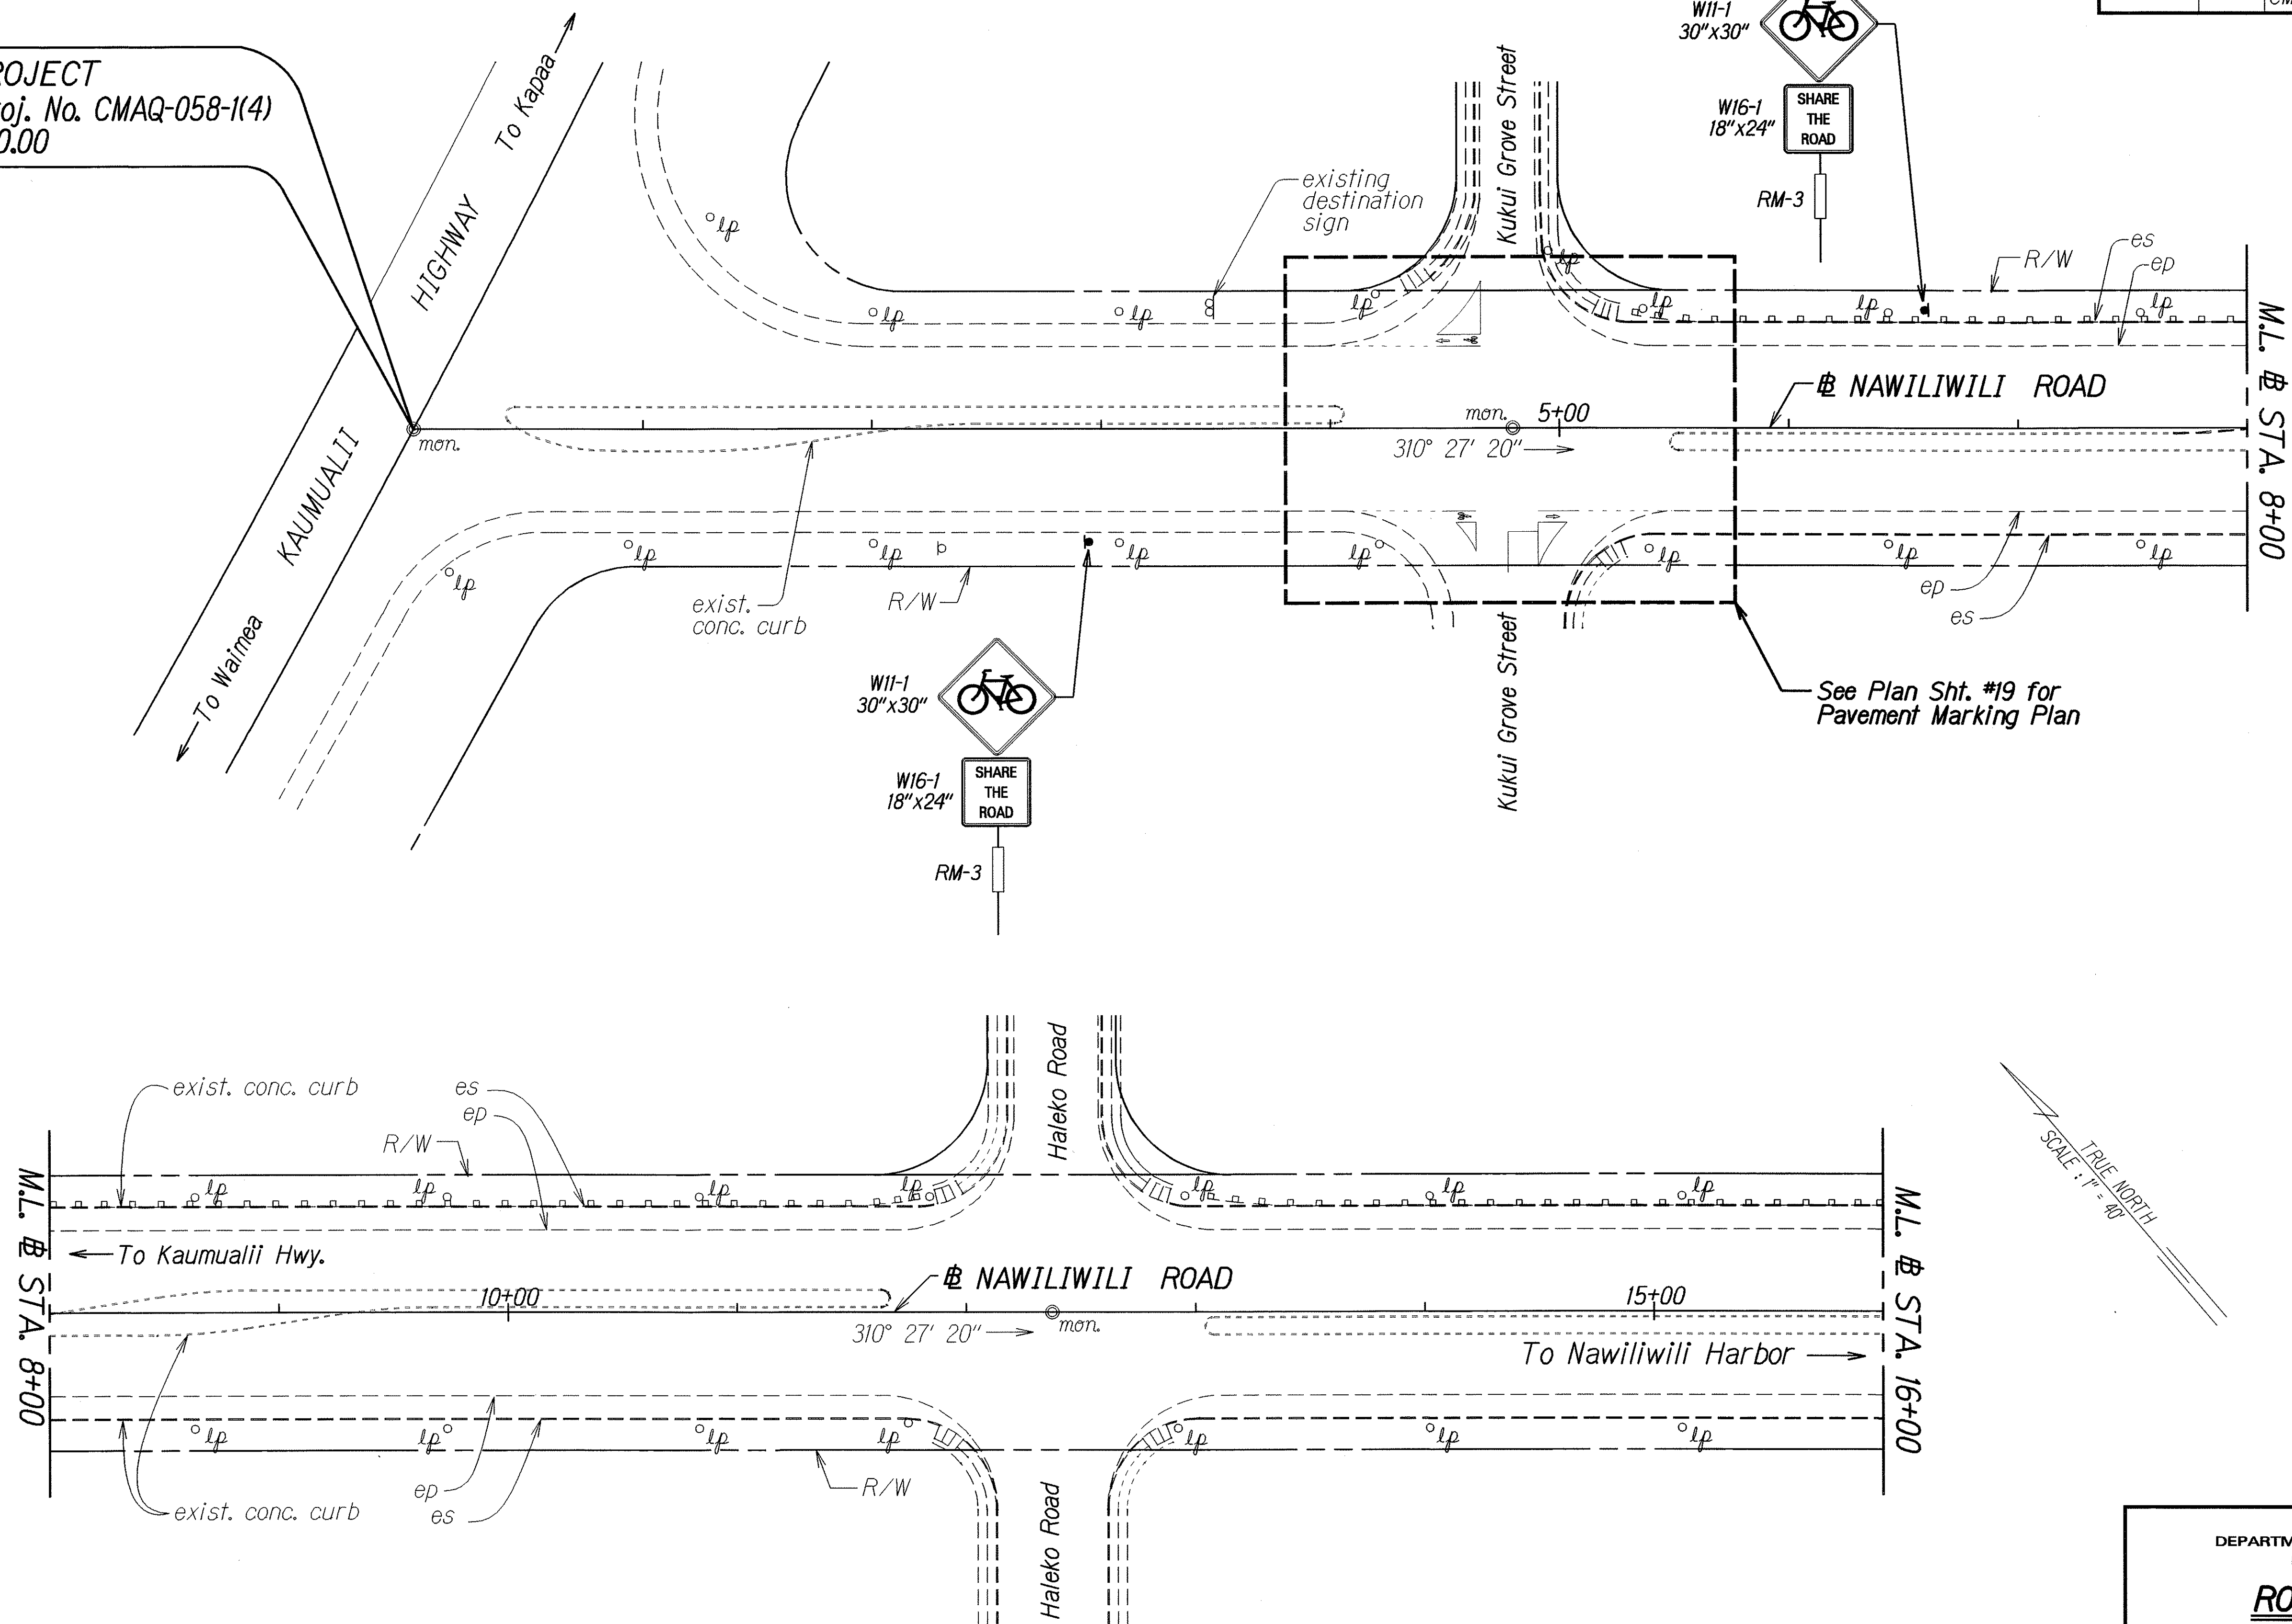

ORIGINAL PLAN	SURVEY PLOTTED BY	DATE
NOTE BOOK	DRAWN BY	4/04
REVISION	TRACED BY	
QUANTITIES BY	CHECKED BY	
CHECKED BY		

STATE OF HAWAII
DEPARTMENT OF TRANSPORTATION
HIGHWAYS DIVISION


ROADWAY PLAN

NAWILIWILI ROAD BIKEWAY
Kaumualii Highway to Waapa Road
Fed. Aid Project No. CMAQ-058-1(4)

Scale: 1" = 40' Date: April 2005

SHEET No. 1 OF 6 SHEETS

FED. ROAD DIST. NO.	STATE	FED. AID PROJ. NO.	FISCAL YEAR	SHEET NO.	TOTAL SHEETS
HAWAII	HAW.	CMAQ-058-1(4)	2005	C.O. 12	23

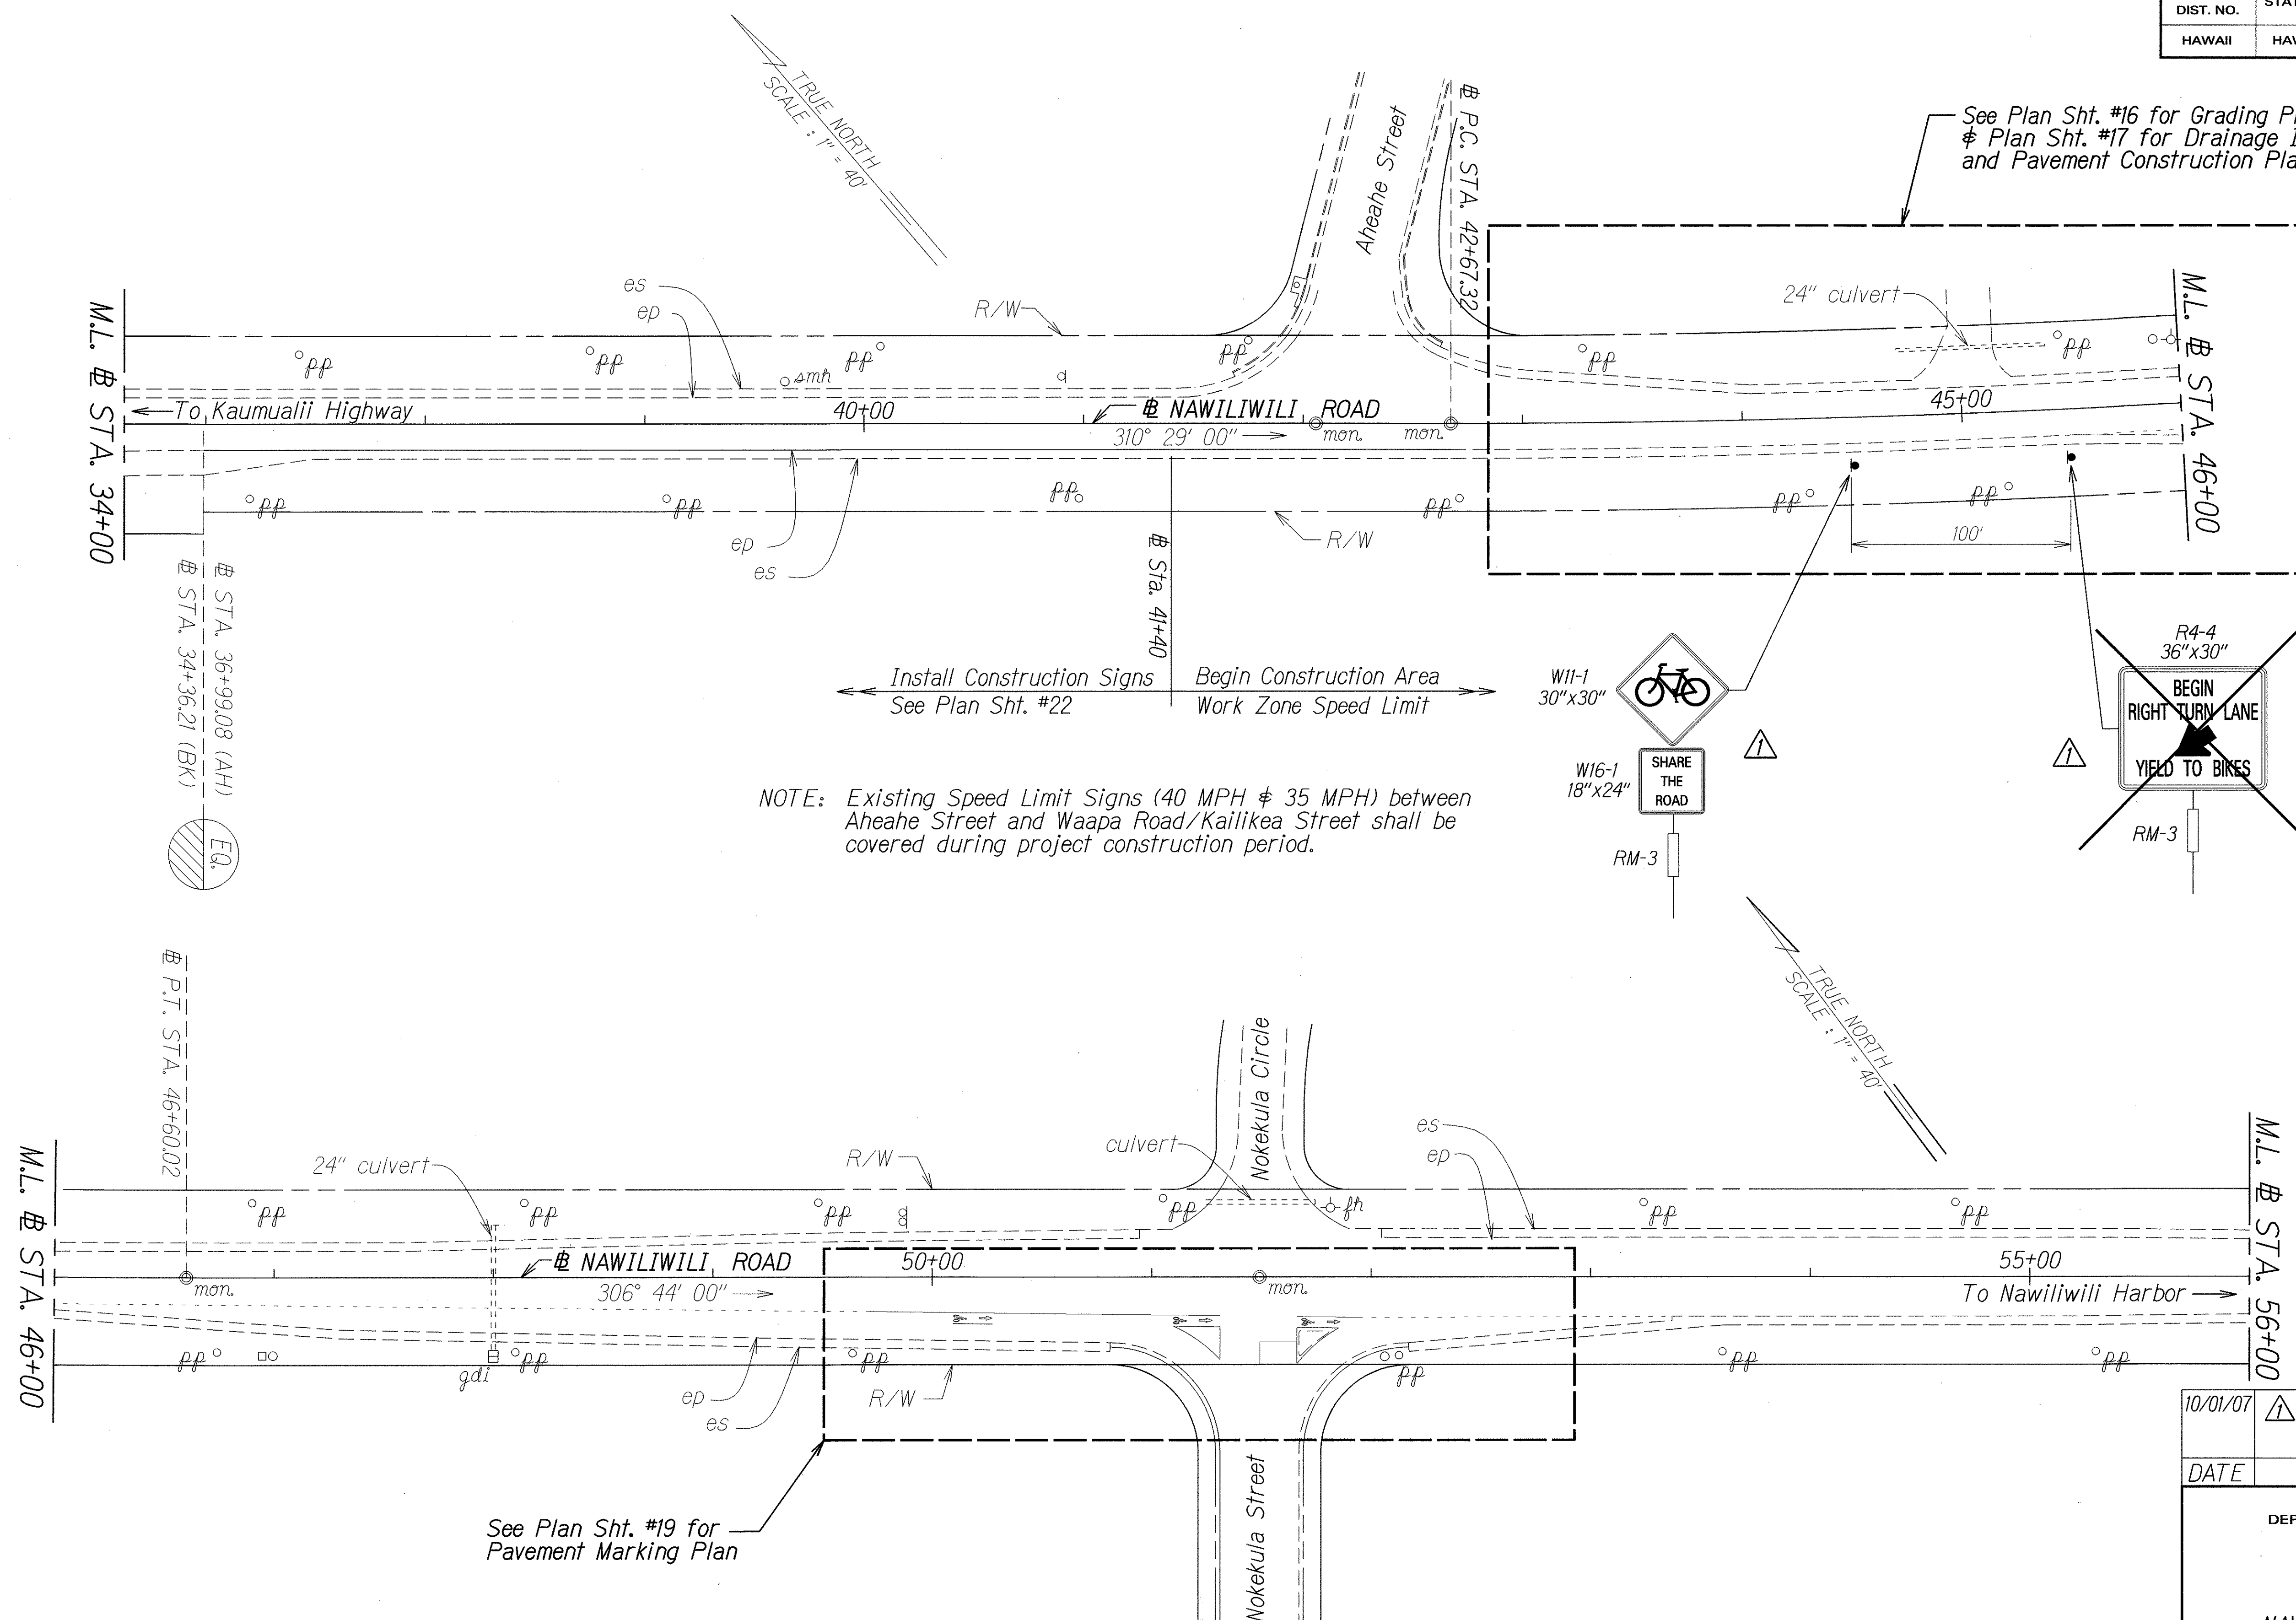


DATE	4/04
DESIGNED BY	
CHECKED BY	
IN CHARGE	
NOTED	
ORIGINAL PLAN	

10/01/07	Deleted R4-4 and Install W11-1 & W16-1 Signs
DATE	REVISION
STATE OF HAWAII DEPARTMENT OF TRANSPORTATION HIGHWAYS DIVISION	
ROADWAY PLAN	
NAWILIWILI ROAD BIKEWAY Kaumualii Highway to Waapa Road Fed. Aid Project No. CMAQ-058-1(4)	
Scale: 1"=40'	Date: April, 2005
SHEET No. 3 OF 6 SHEETS	

C.O. 12

FED. ROAD DIST. NO.	STATE	FED. AID PROJ. NO.	FISCAL YEAR	SHEET NO.	TOTAL SHEETS
HAWAII	HAW.	CMAQ-058-1(4)	2005	C.O. 13	23

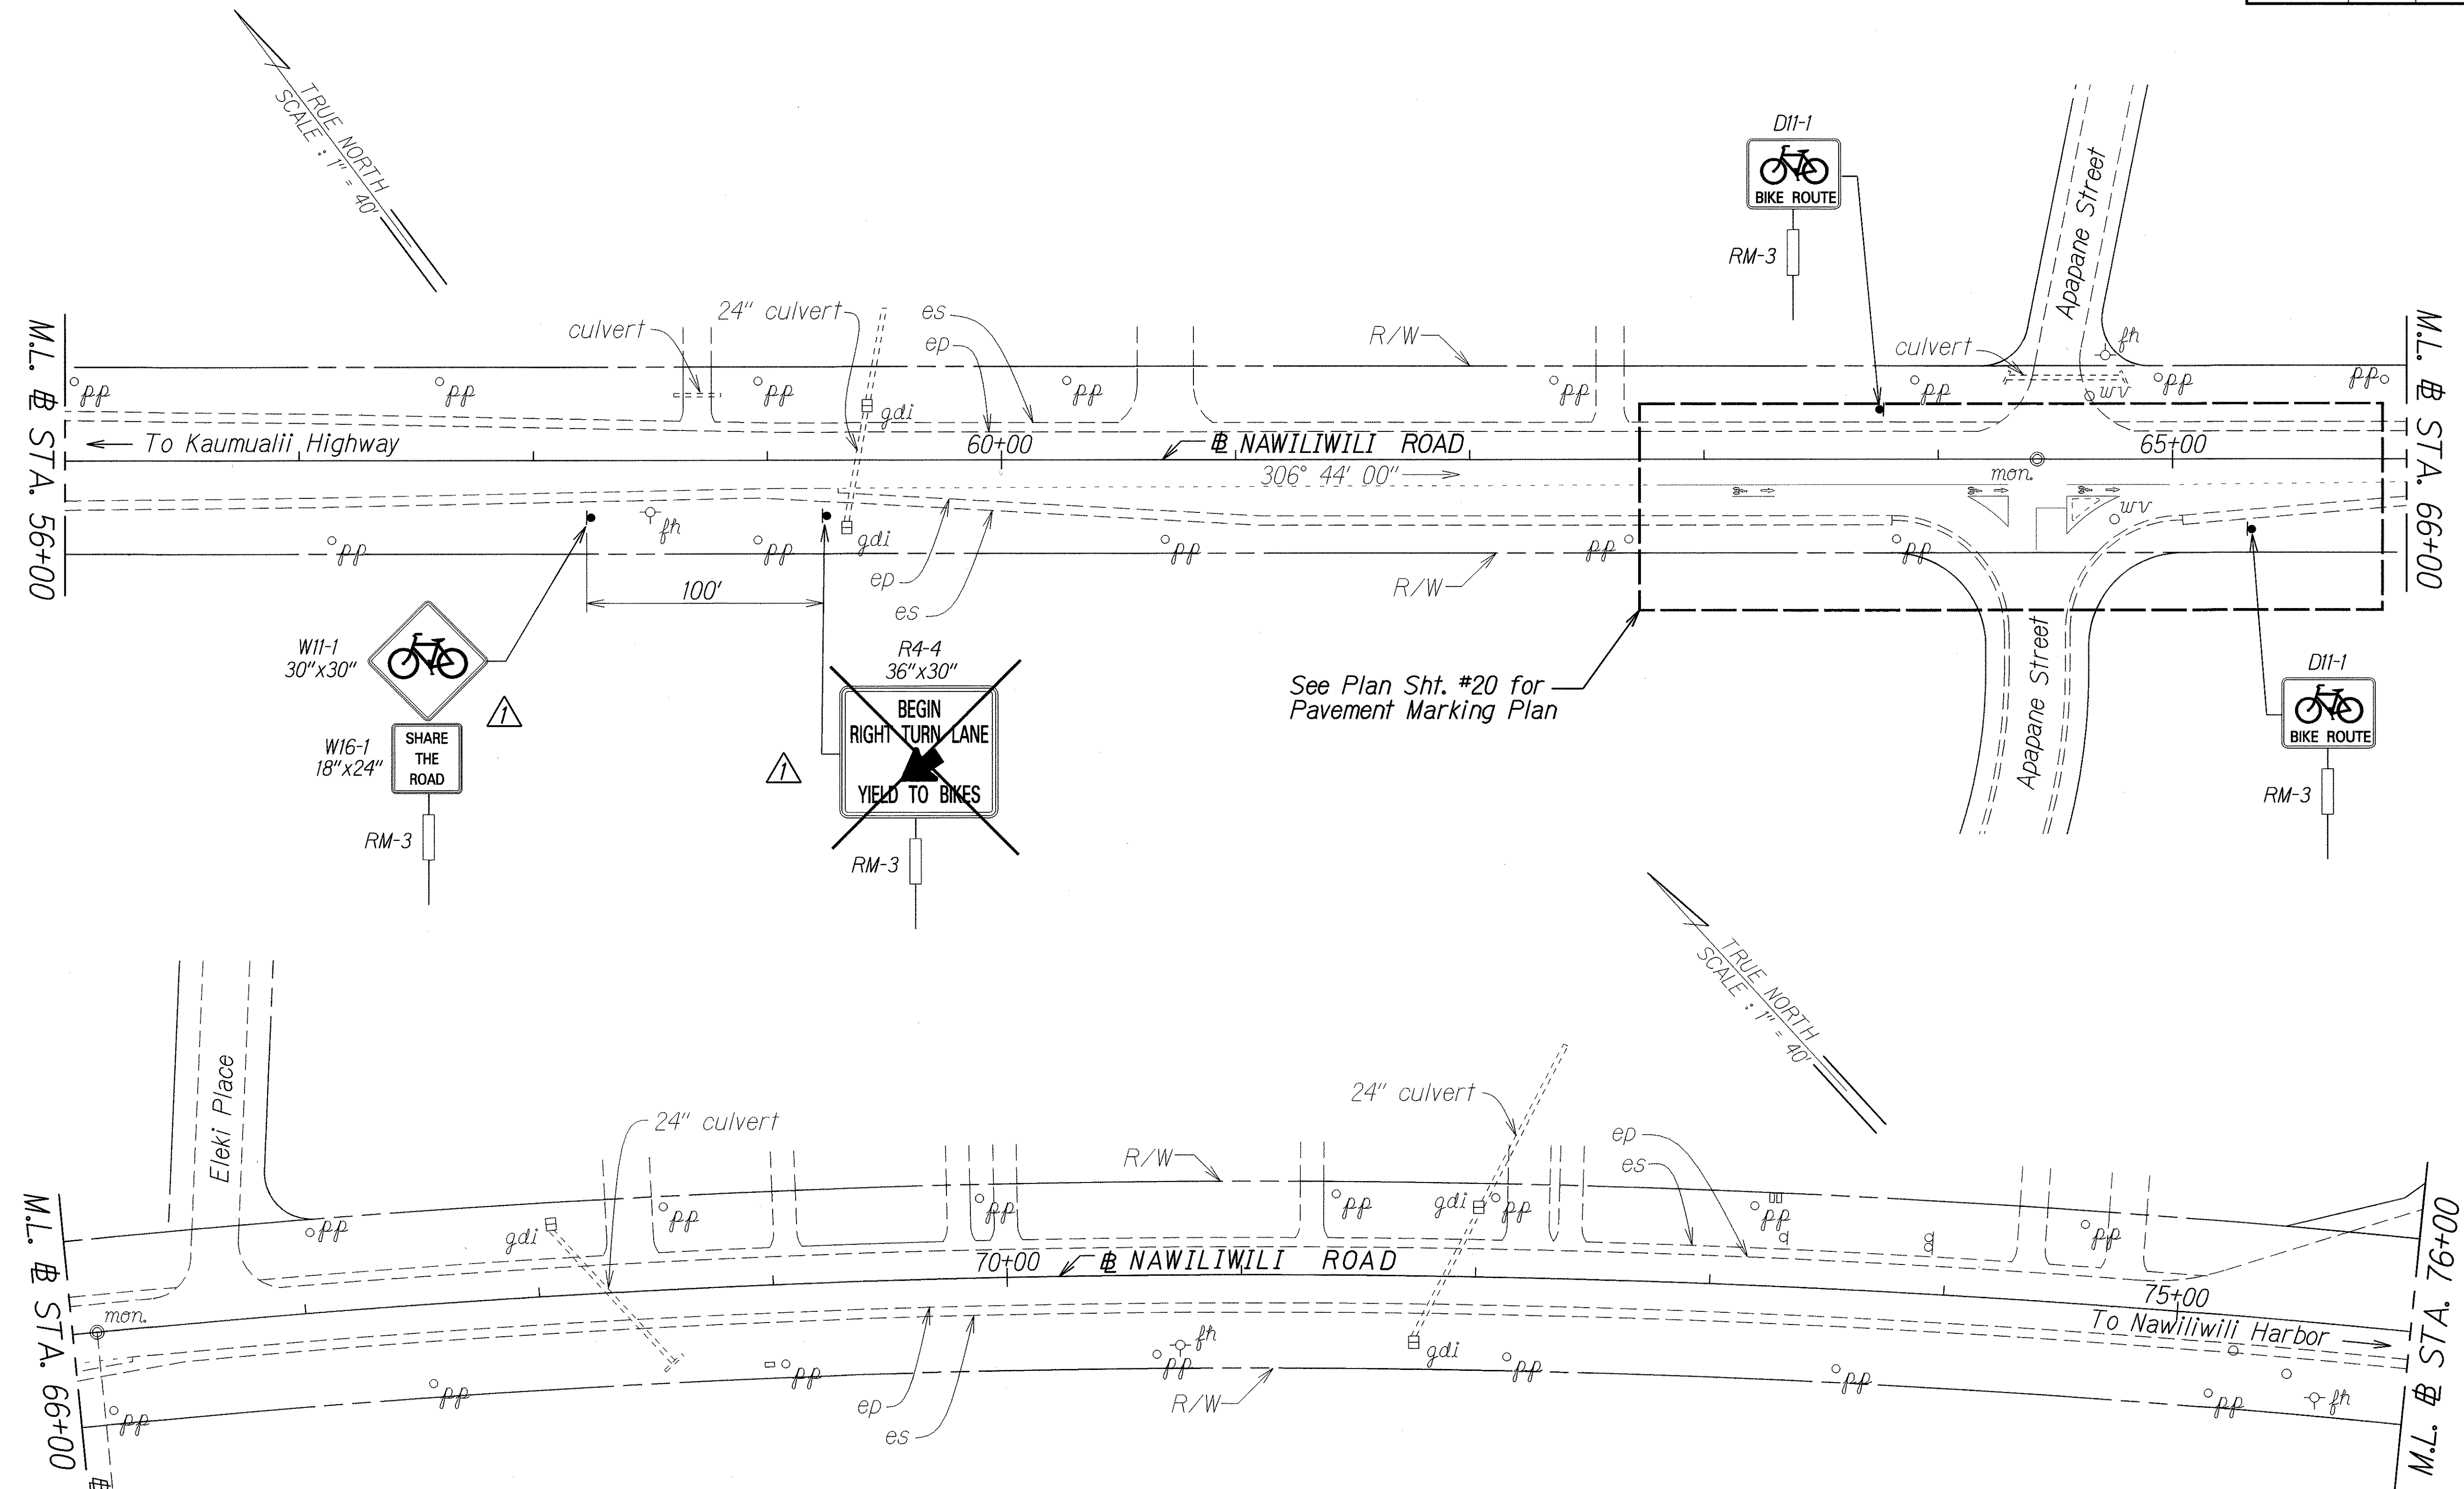

ORIGINAL PLAN	DATE
DRAWN BY	4/04
TRACED BY	
DESIGNED BY	
CHECKED BY	
NOTED BY	
DATE	


10/01/07	Deleted R4-4 and Install W11-1 & W16-1 Signs
DATE	REVISION

STATE OF HAWAII
DEPARTMENT OF TRANSPORTATION
HIGHWAYS DIVISION

ROADWAY PLAN
NAWILIWILI ROAD BIKEWAY
Kaunualii Highway to Waapa Road
Fed. Aid Project No. CMAQ-058-1(4)
Scale: 1"=40'
Date: April 2005

SHEET No. 4 OF 6 SHEETS

FED. ROAD DIST. NO.	STATE	FED. AID PROJ. NO.	FISCAL YEAR	SHEET NO.	TOTAL SHEETS
HAWAII	HAW.	CMAQ-058-1(4)	2005	C.O. 14	23

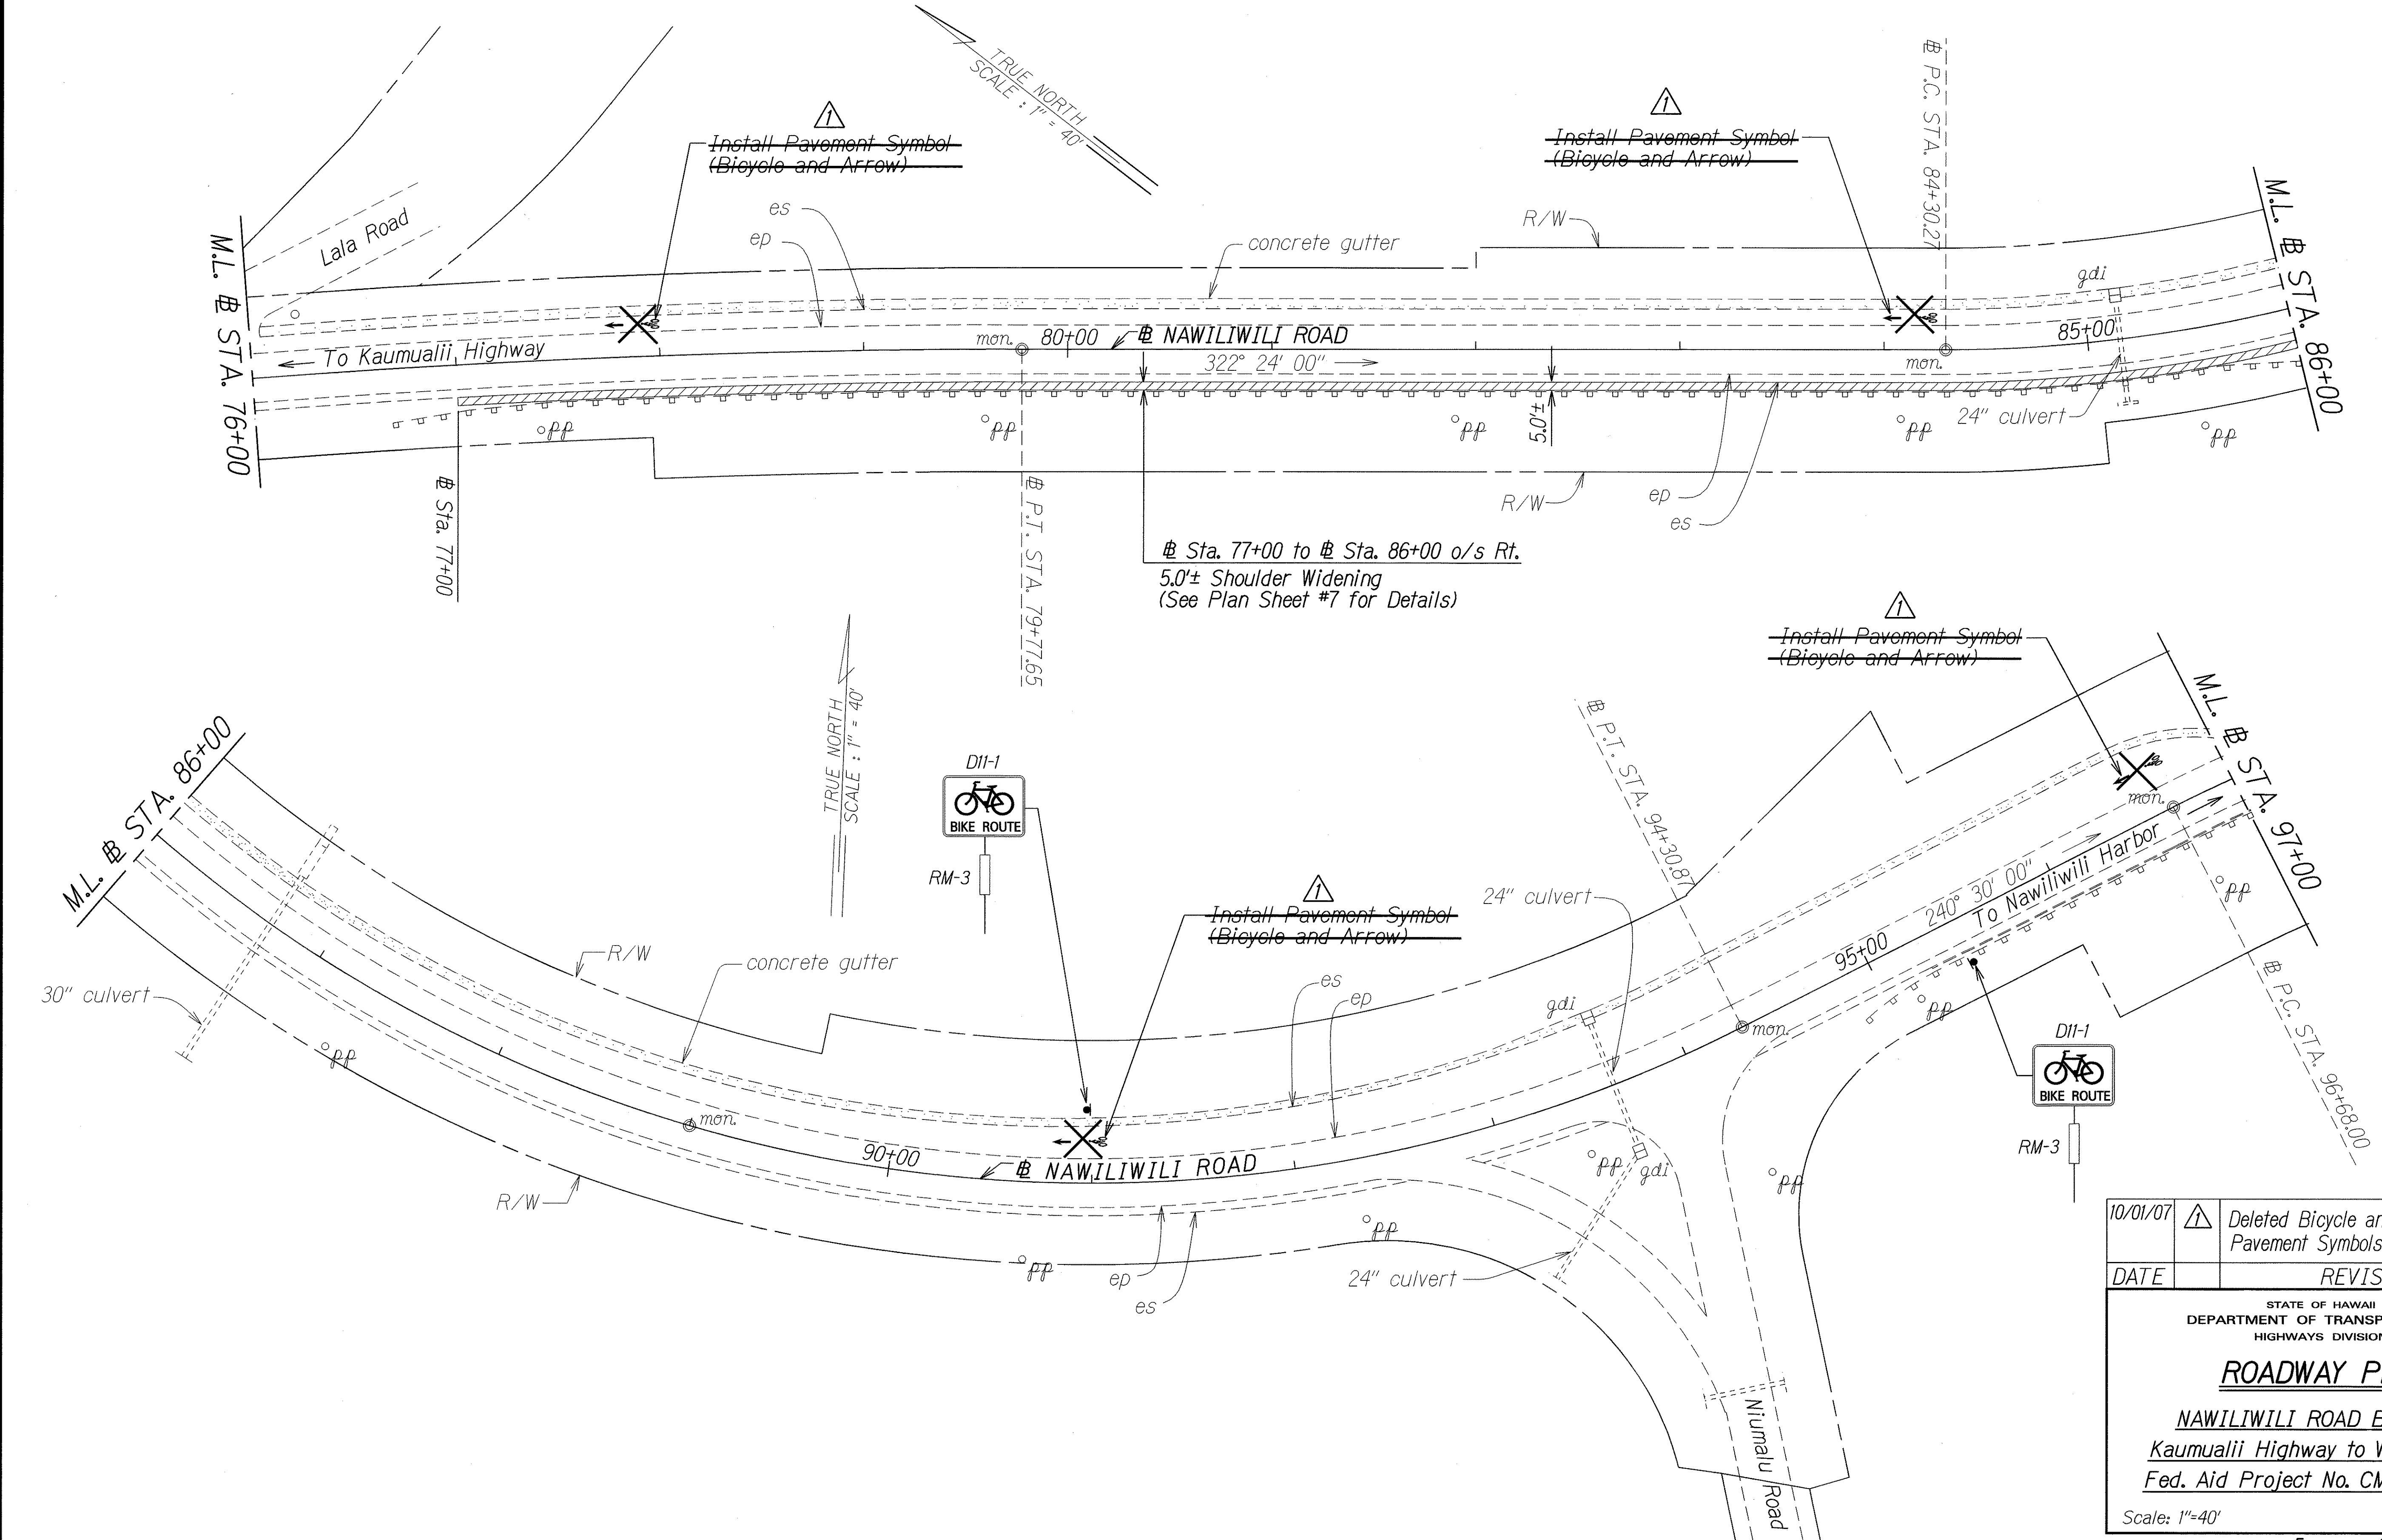

DESIGNED BY	DATE
DRAWN BY	4/04
CHECKED BY	
NOTED BY	
QUANTITIES BY	
REVISIONS	

10/01/07		Deleted Bicycle and Arrow Pavement Symbols
DATE		REVISION
STATE OF HAWAII DEPARTMENT OF TRANSPORTATION HIGHWAYS DIVISION ROADWAY PLAN NAWILIWILI ROAD BIKEWAY Kaunualii Highway to Waapa Road Fed. Aid Project No. CMAQ-058-1(4) Scale: 1"=40' Date: April 2005		
SHEET No. 5 OF 6 SHEETS		

TRUE NORTH
SCALE : 1" = 40'



10/01/07		Deleted R4-4 and Install W11-1 & W16-1 Signs
DATE		REVISION

STATE OF HAWAII
DEPARTMENT OF TRANSPORTATION
HIGHWAYS DIVISION

ROADWAY PLAN

NAWALIWILI ROAD BIKEWAY
Kaunaulii Highway to Waapa Road
Fed. Aid Project No. CMAQ-058-1(4)

Scale: 1"=40' Date: April 2005

SHEET No. 6 OF 6 SHEETS