



PRO. ROAD DIST. No.	STATE	AS BUILT PROJ. No.	FISCAL YEAR	SHEET No.	TOTAL SHEETS
BAWAH	GA	A-580-0000 UNIT 1	1985	12	14

FINAL SURVEY NO.	SURVEYED BY	DATE


ORIGINAL SURVEY NO.	SURVEYED BY	DATE

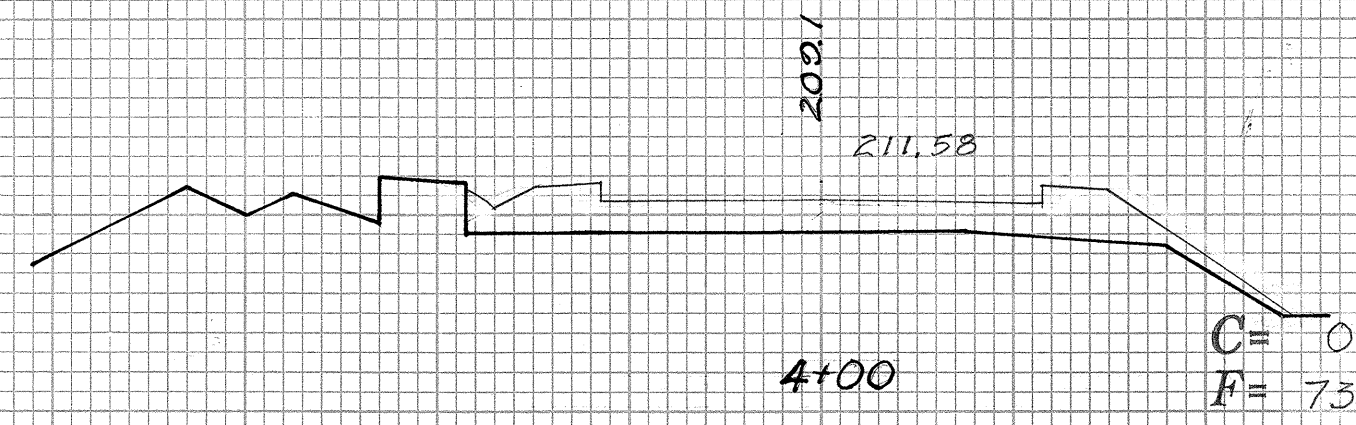


Exc = 43
Emb = 135

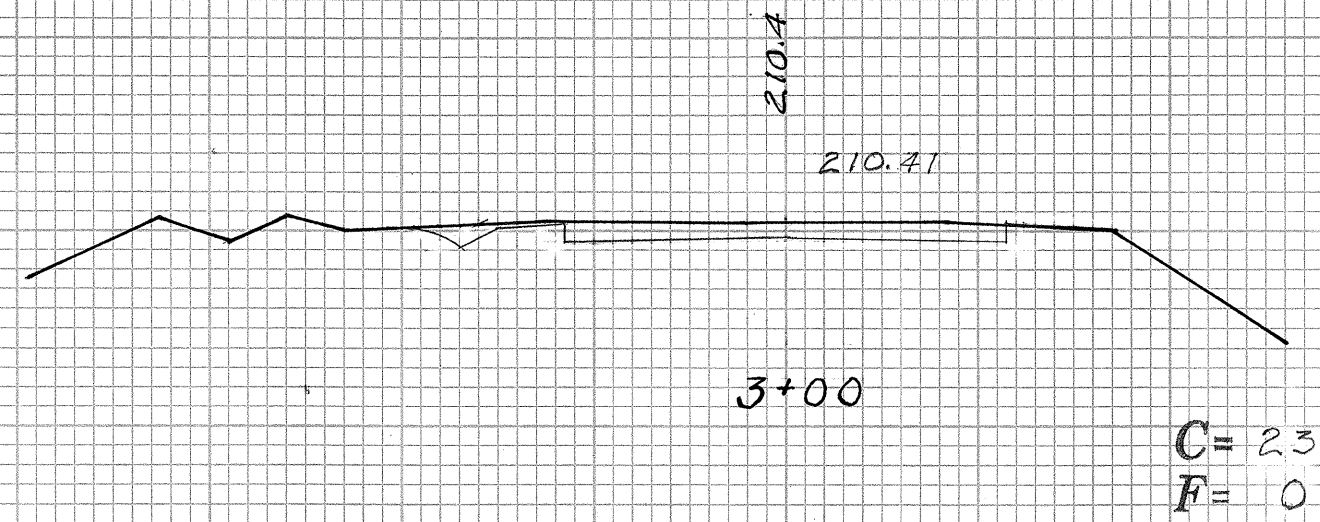



Exc = 213
Emb = 0

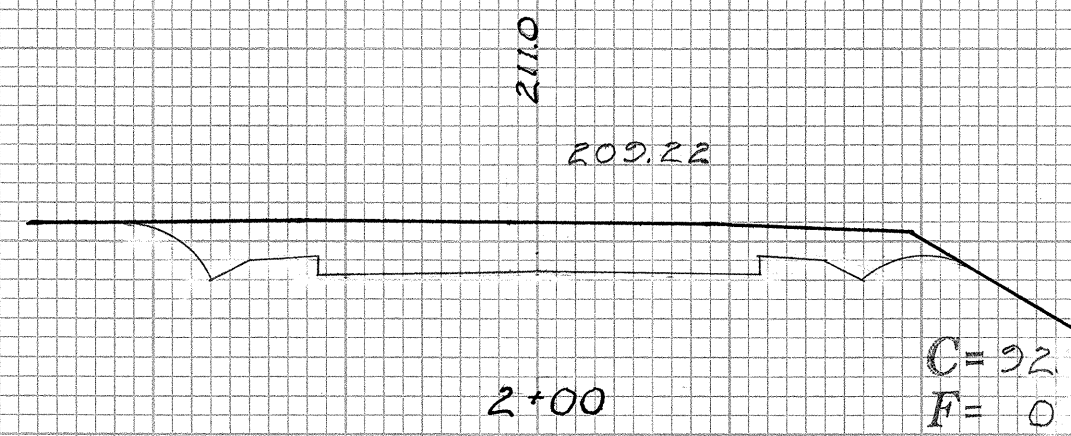


Exc = 176
Emb = 0

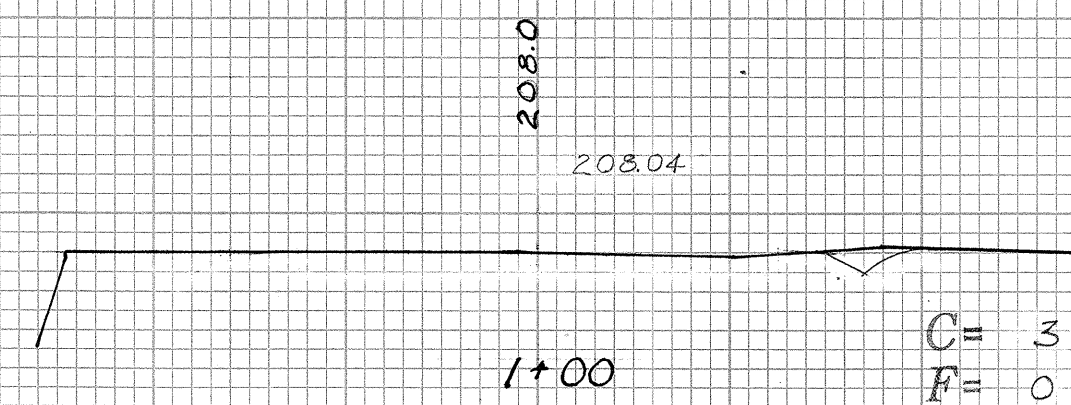


Exc = 0
Emb = 0

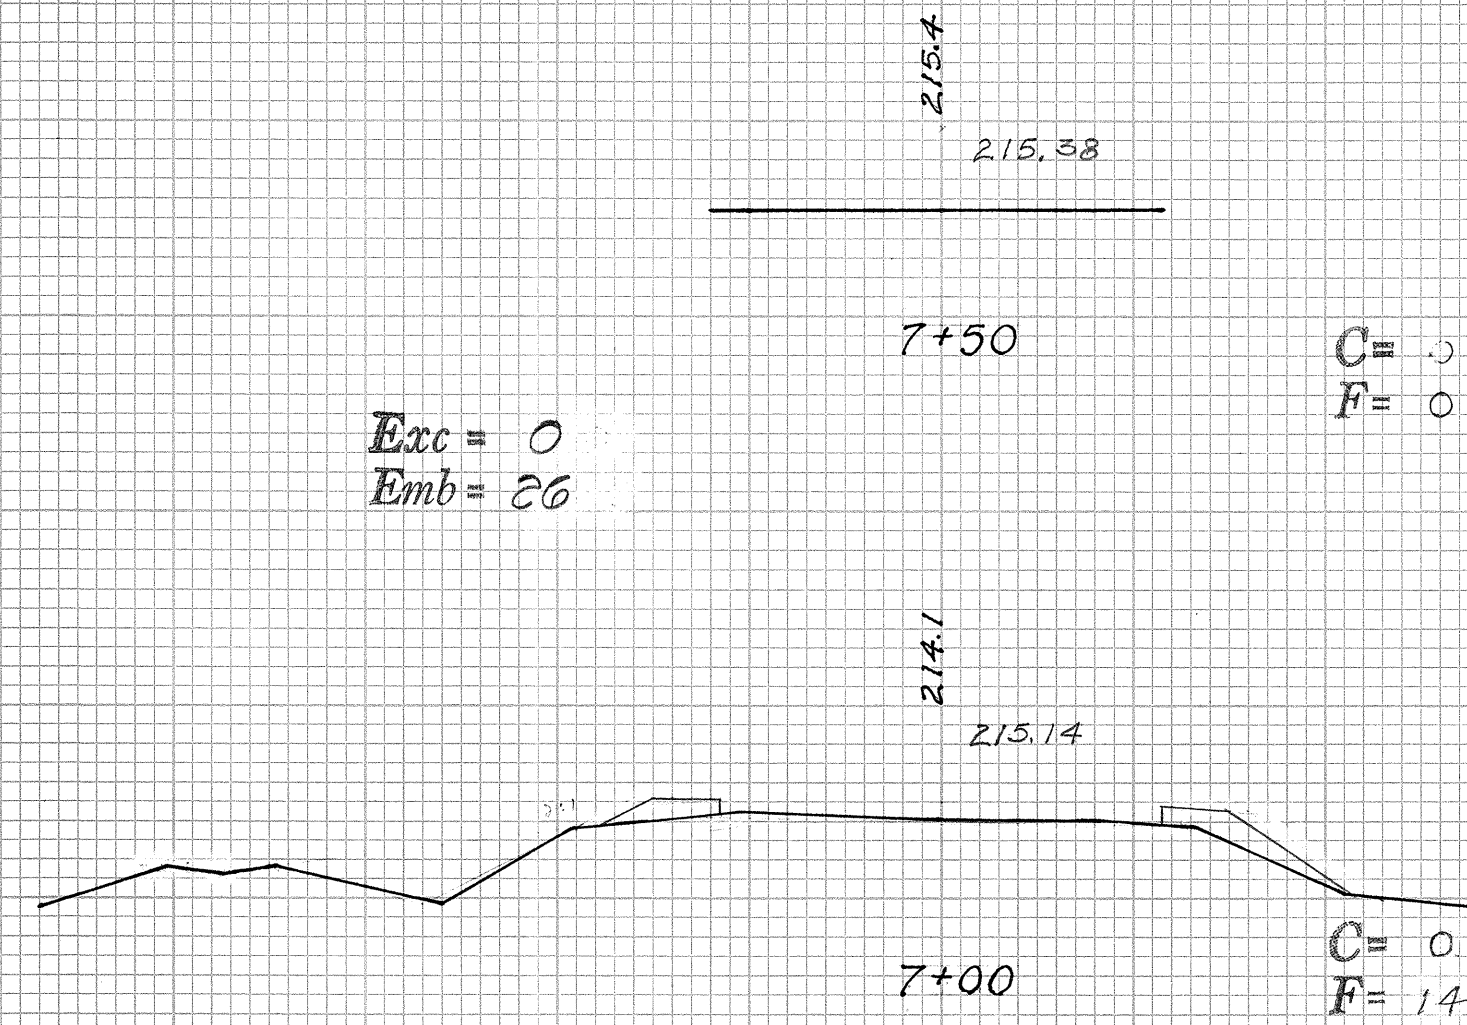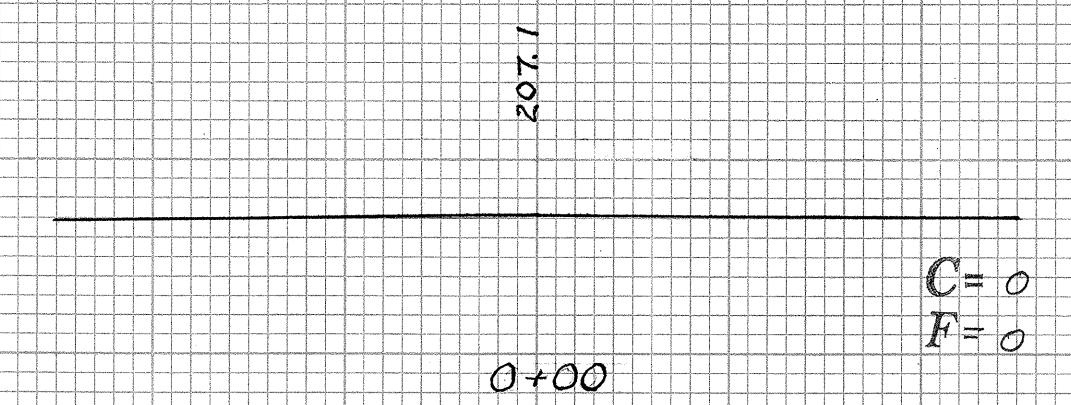


Exc = 0
Emb = 26

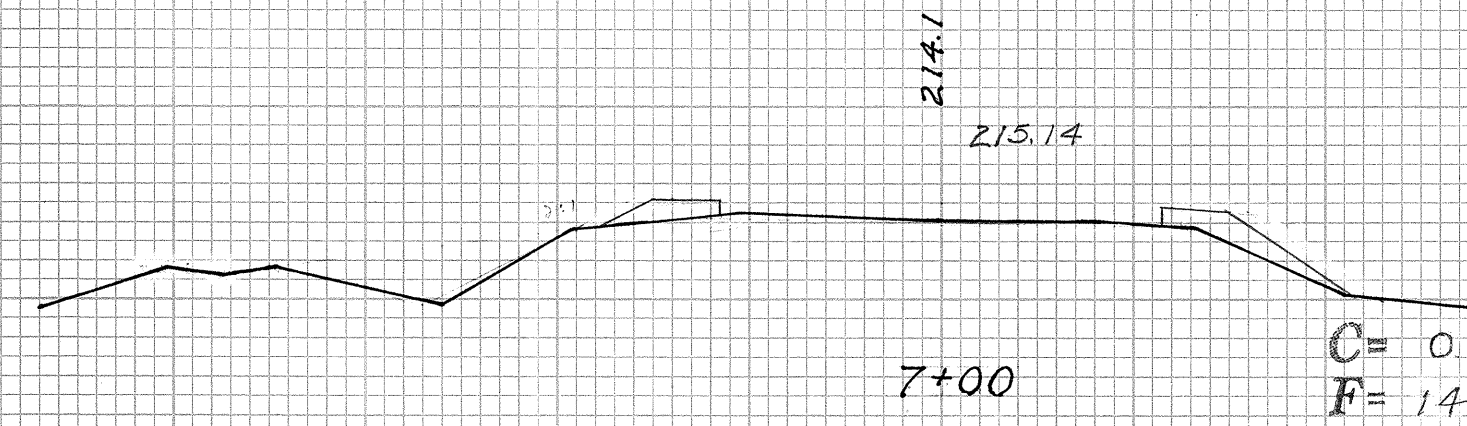









Exc = 0
Emb = 178

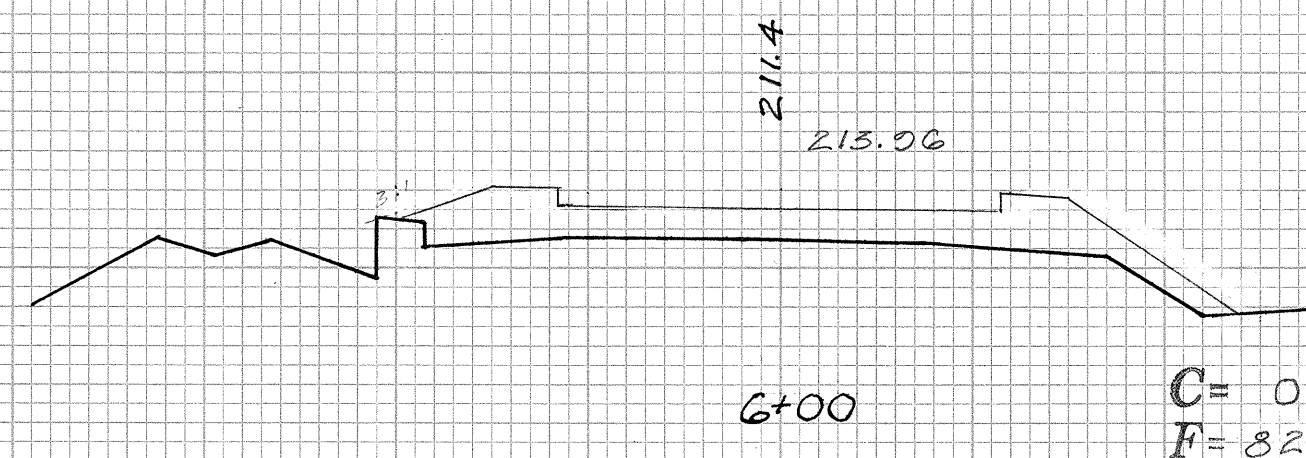

Exc = 0
Emb = 339

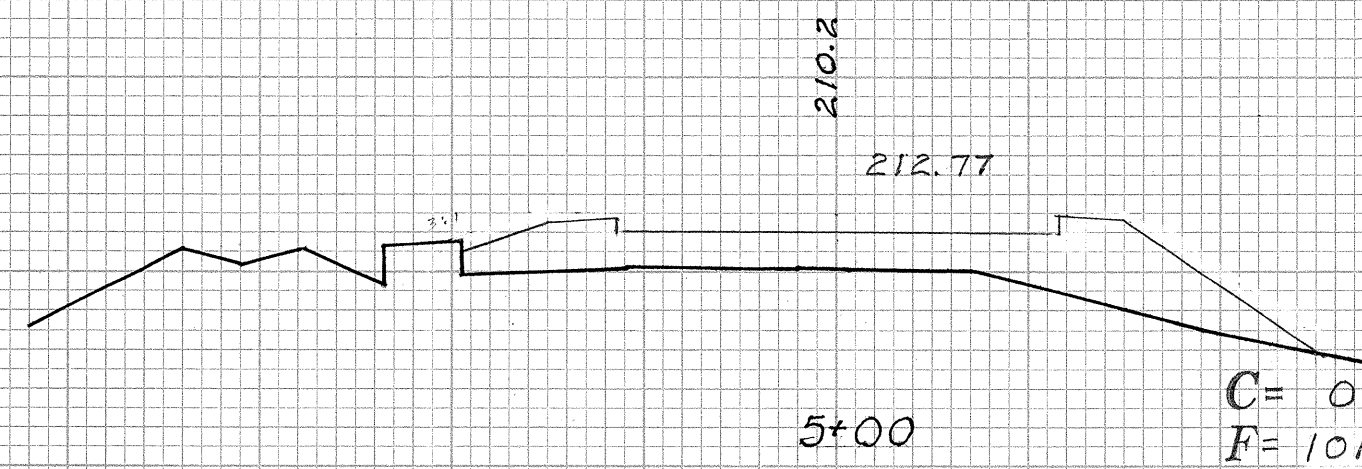

Exc = 0
Emb = 322

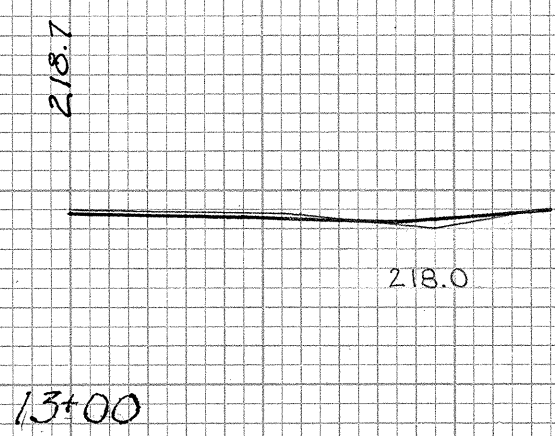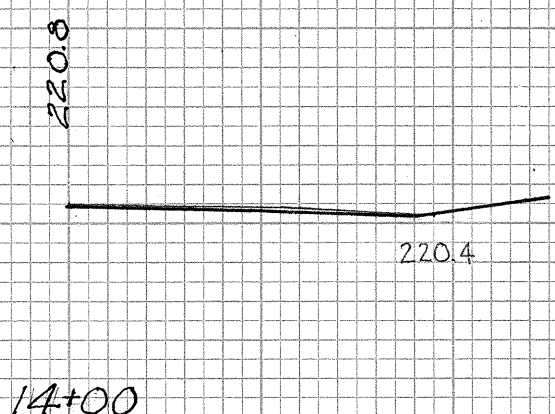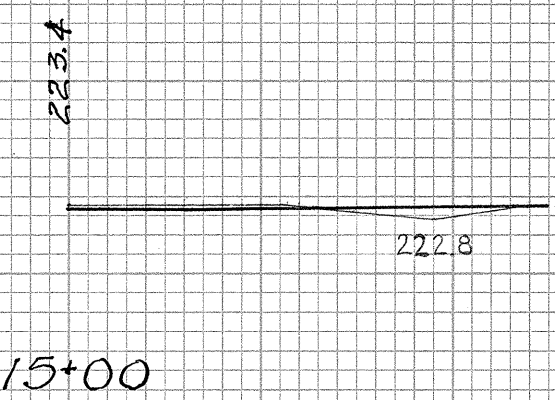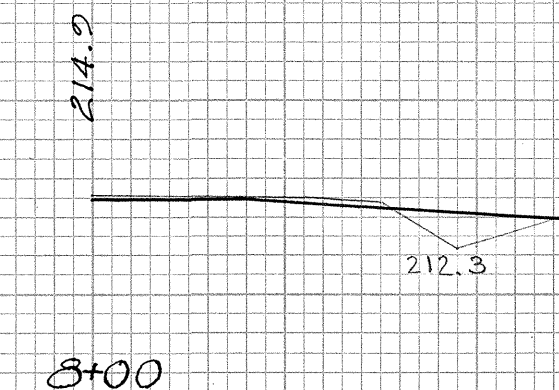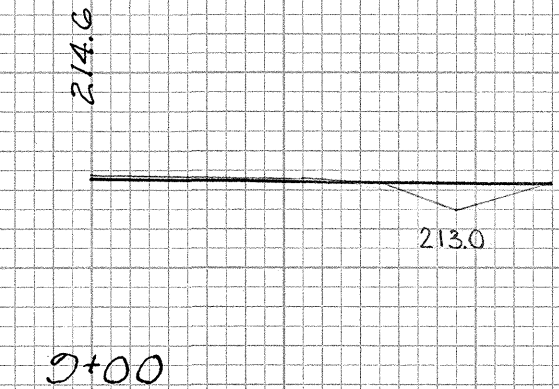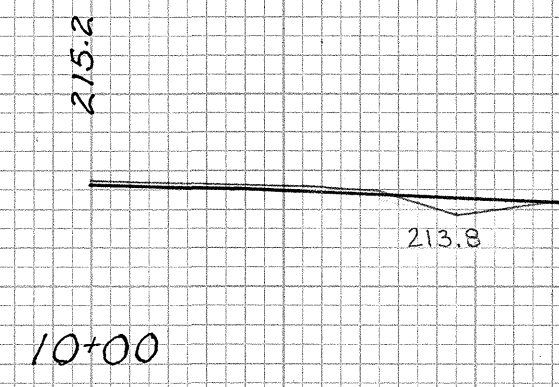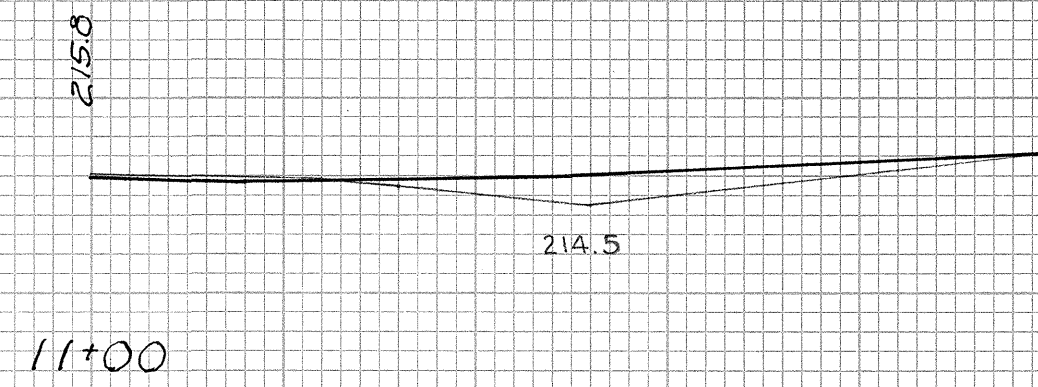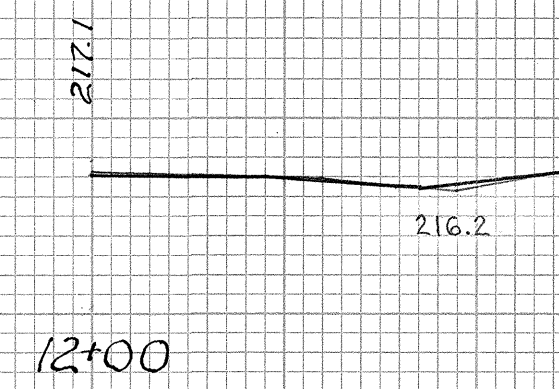


DRAINAGE SWALE
STA 8+00 to STA 15+00 RIGHT SIDE

PRO. ROAD DIST. No.	STATE	PROJ. No.	PICTAL YEAR	SEWER No.	TOTAL SHEETS
HAWAII	HAW.	A-520-01-000 UNIT 1	1965	13	14

FINAL SURVEY	BY	DATE
SURVEYED		
PLOTTED		
NOTE BOOK		
NO.		


ORIGINAL SURVEY	BY	DATE
SURVEYED		
PLOTTED		
NOTE BOOK		
NO.		

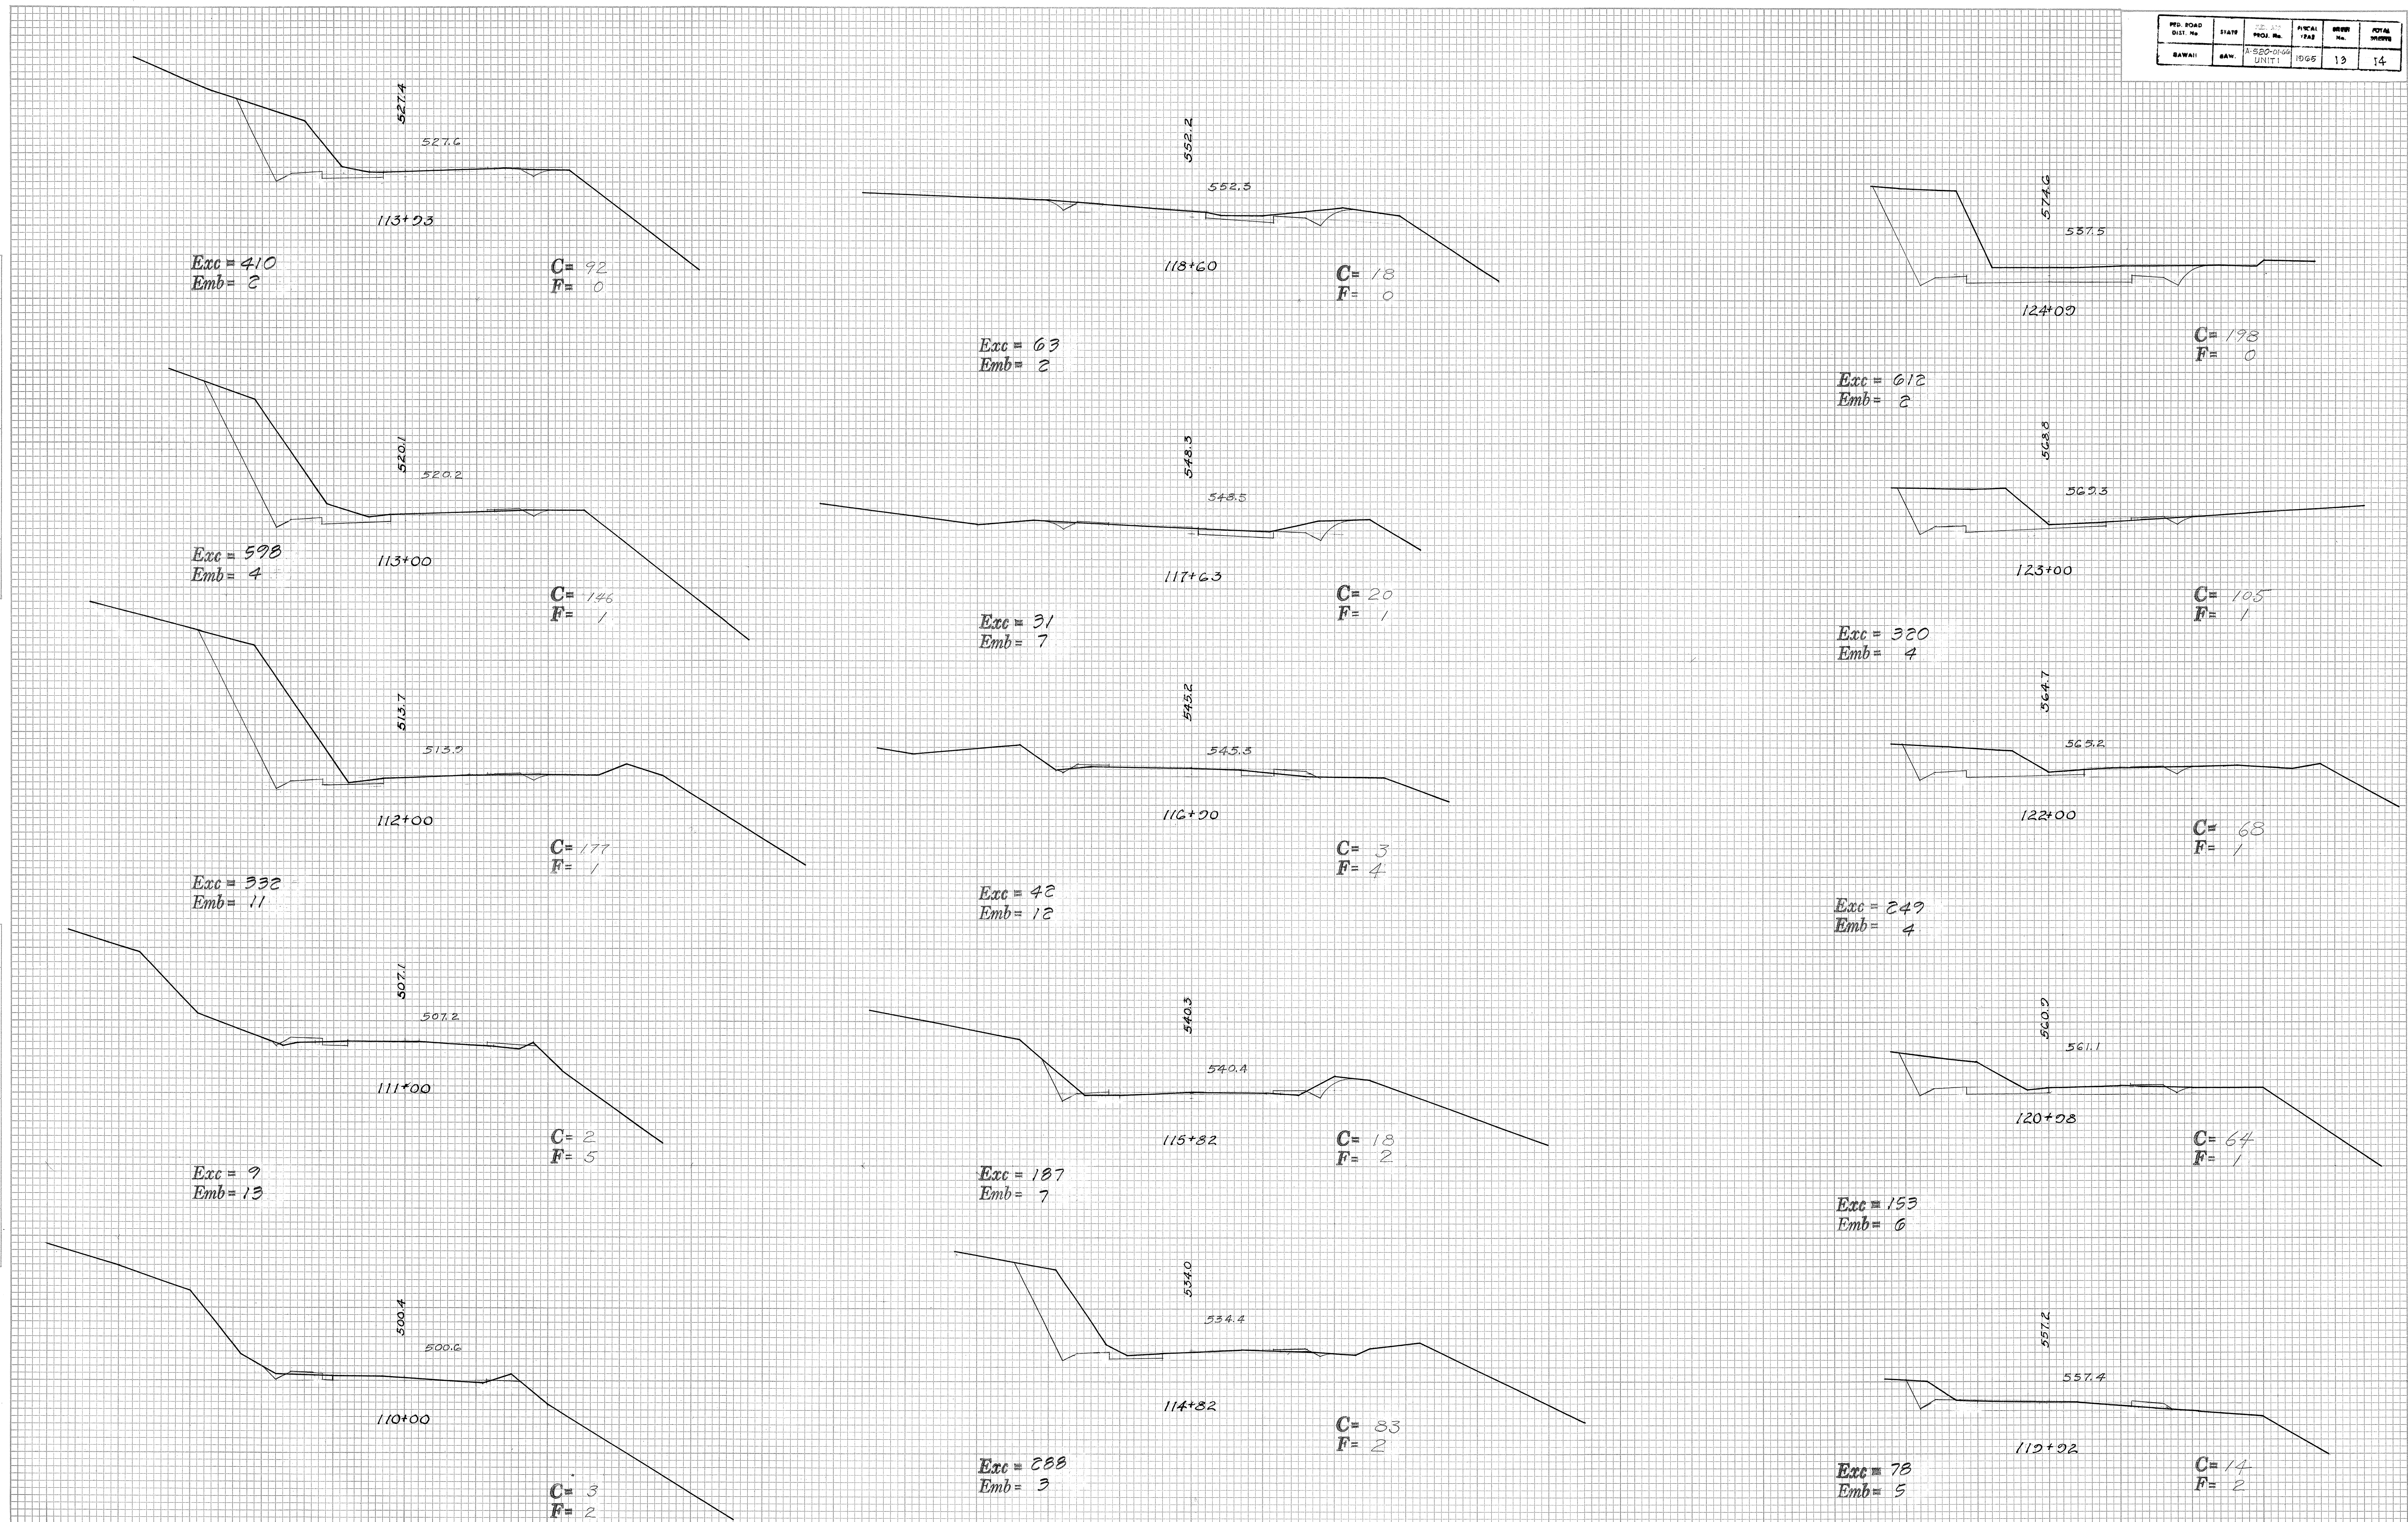

FED. ROAD DIST. NO.	STATE	PROJECT NO.	FISCAL YEAR	SHEET NO.	TOTAL SHEETS
KAWAII		1520-004	1965	14	14


FINAL SURVEY NO.	BY	DATE

ORIGINAL SURVEY NO.	BY	DATE

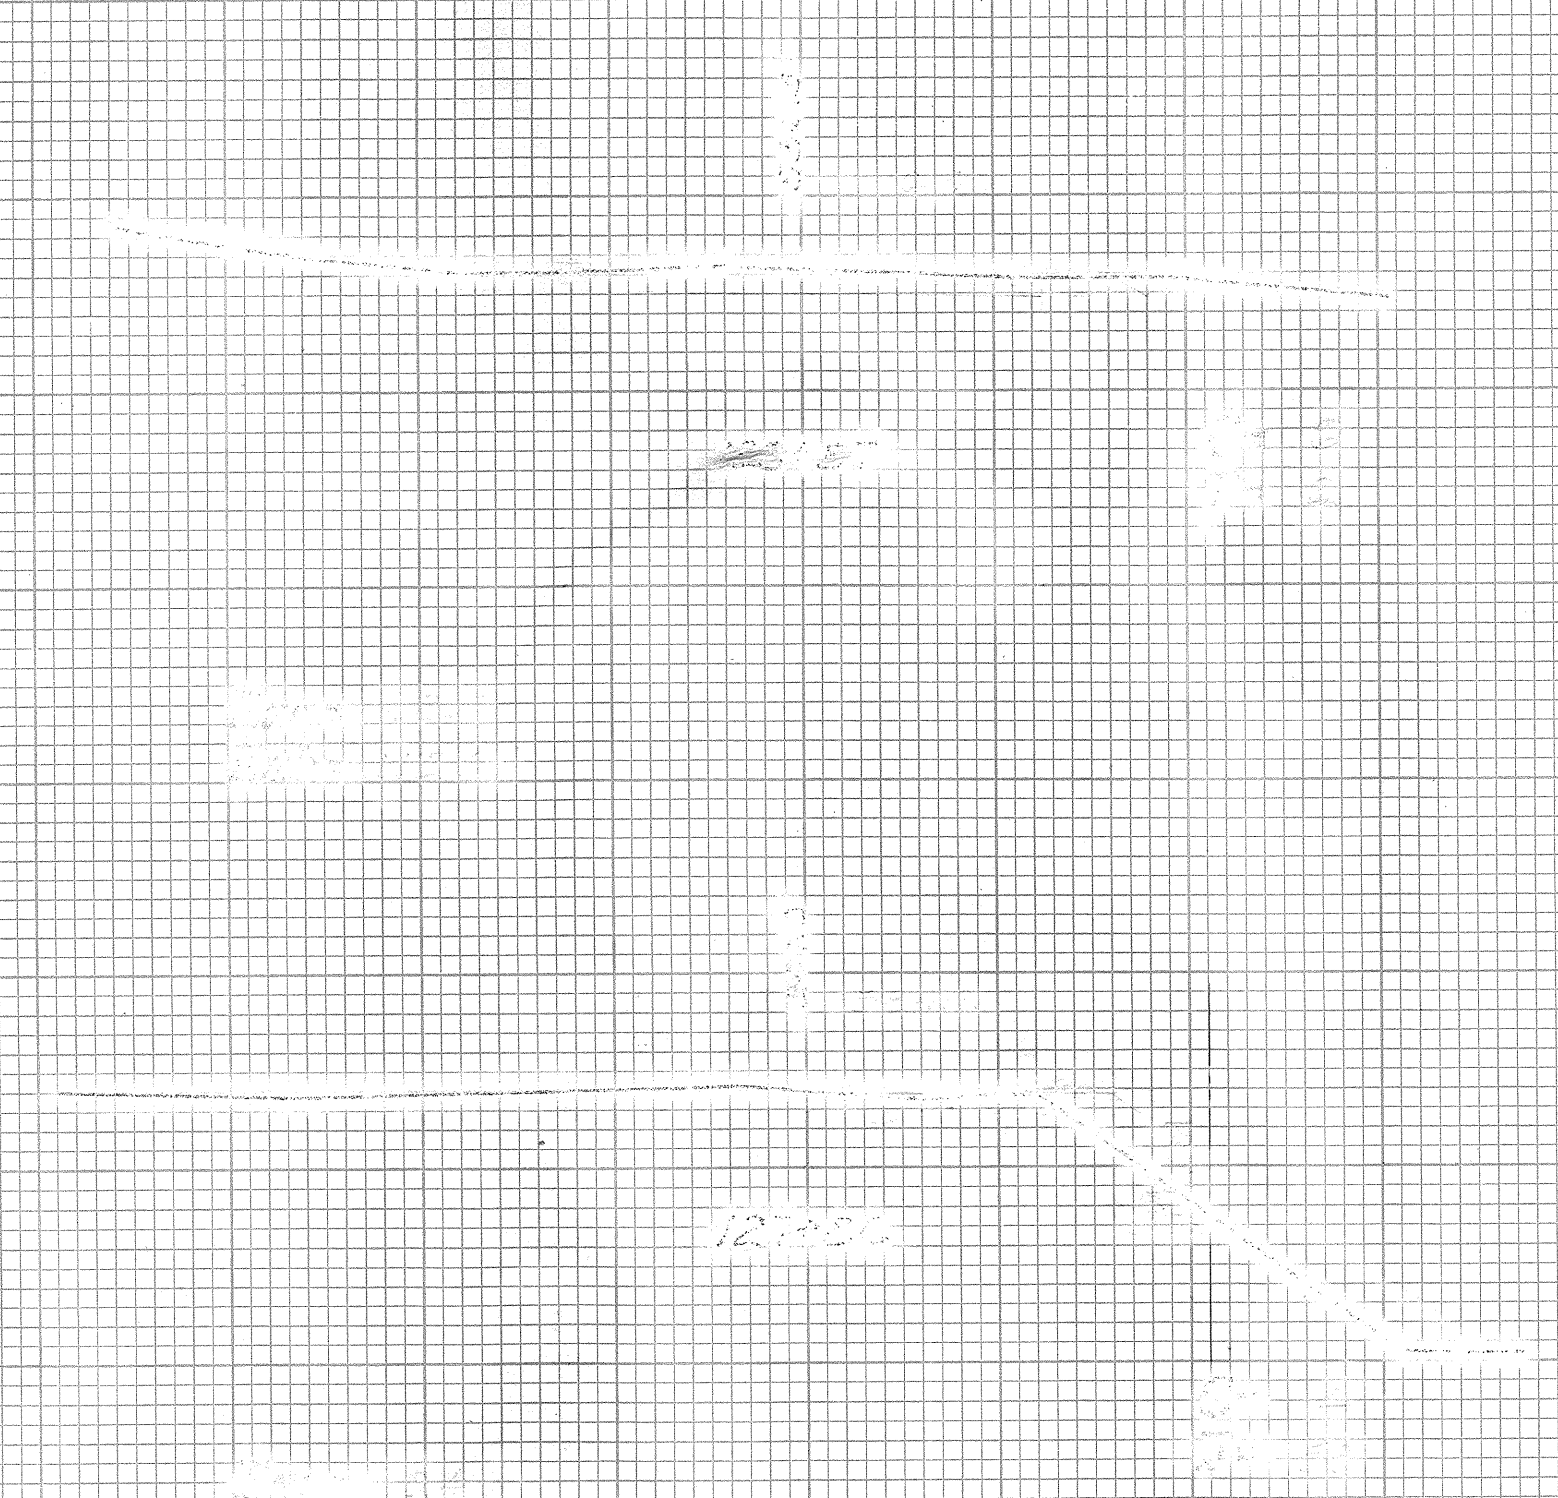

Exc = 18
Emb = 41

C = 1
F = 19

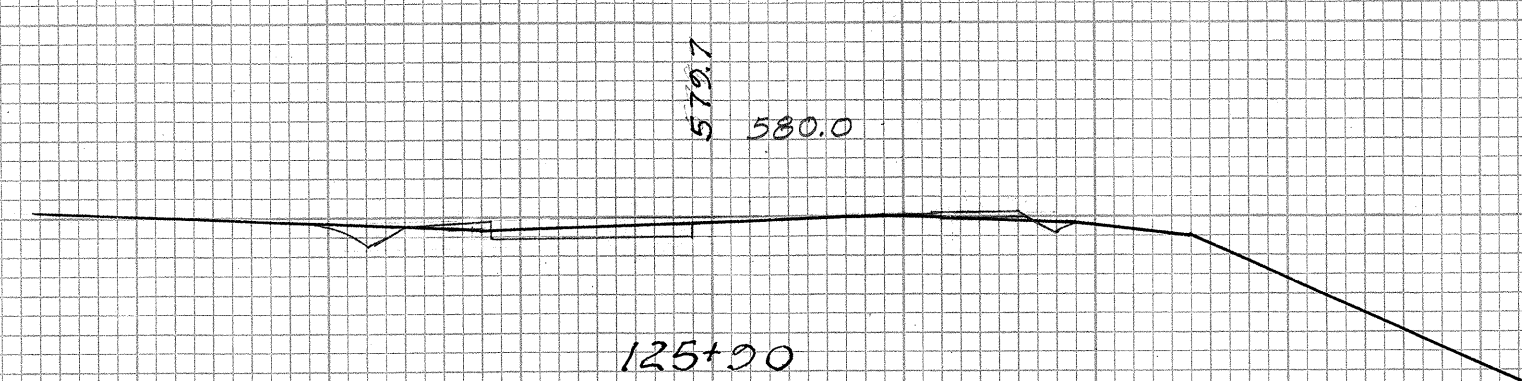

Exc = 298
Emb = 2

C = 8
F = 1



Exc = 642
Emb = 0

C = 175
F = 0