

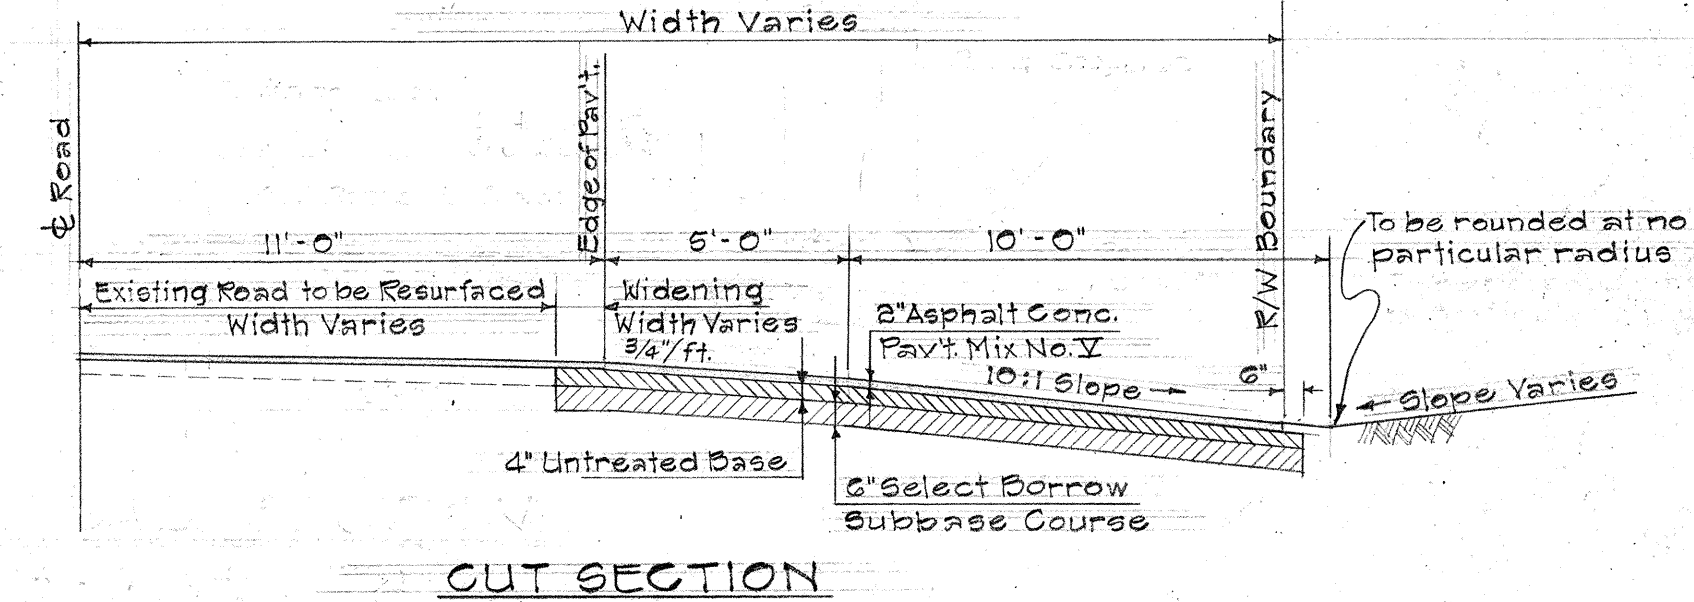
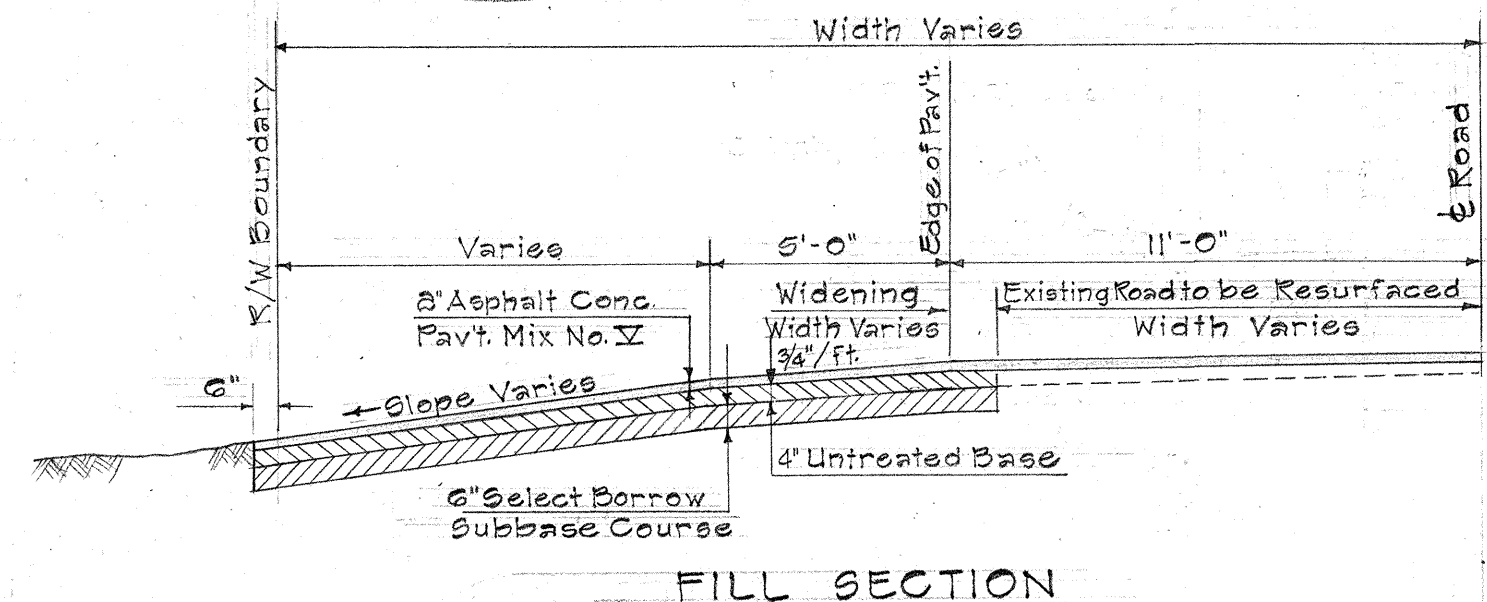
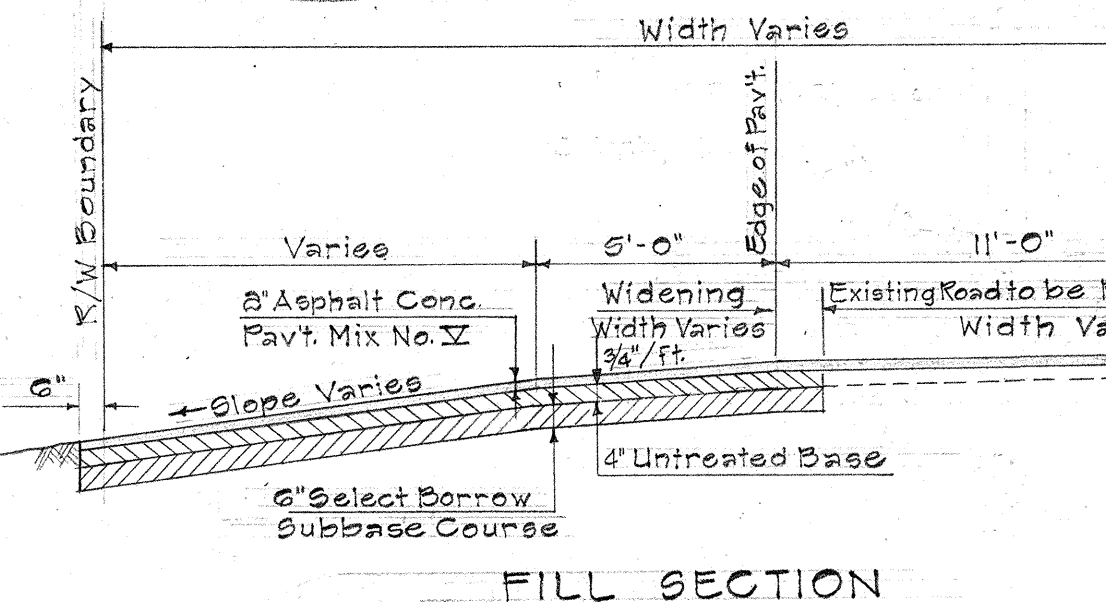
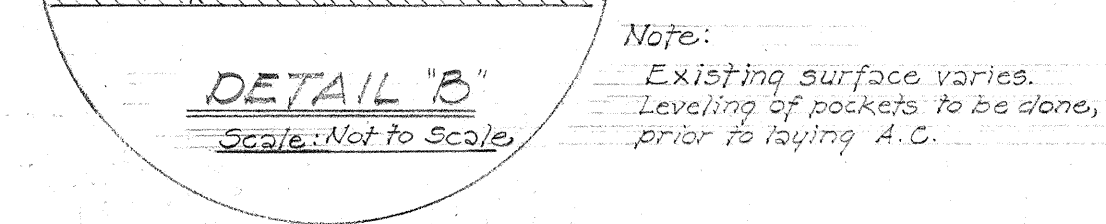
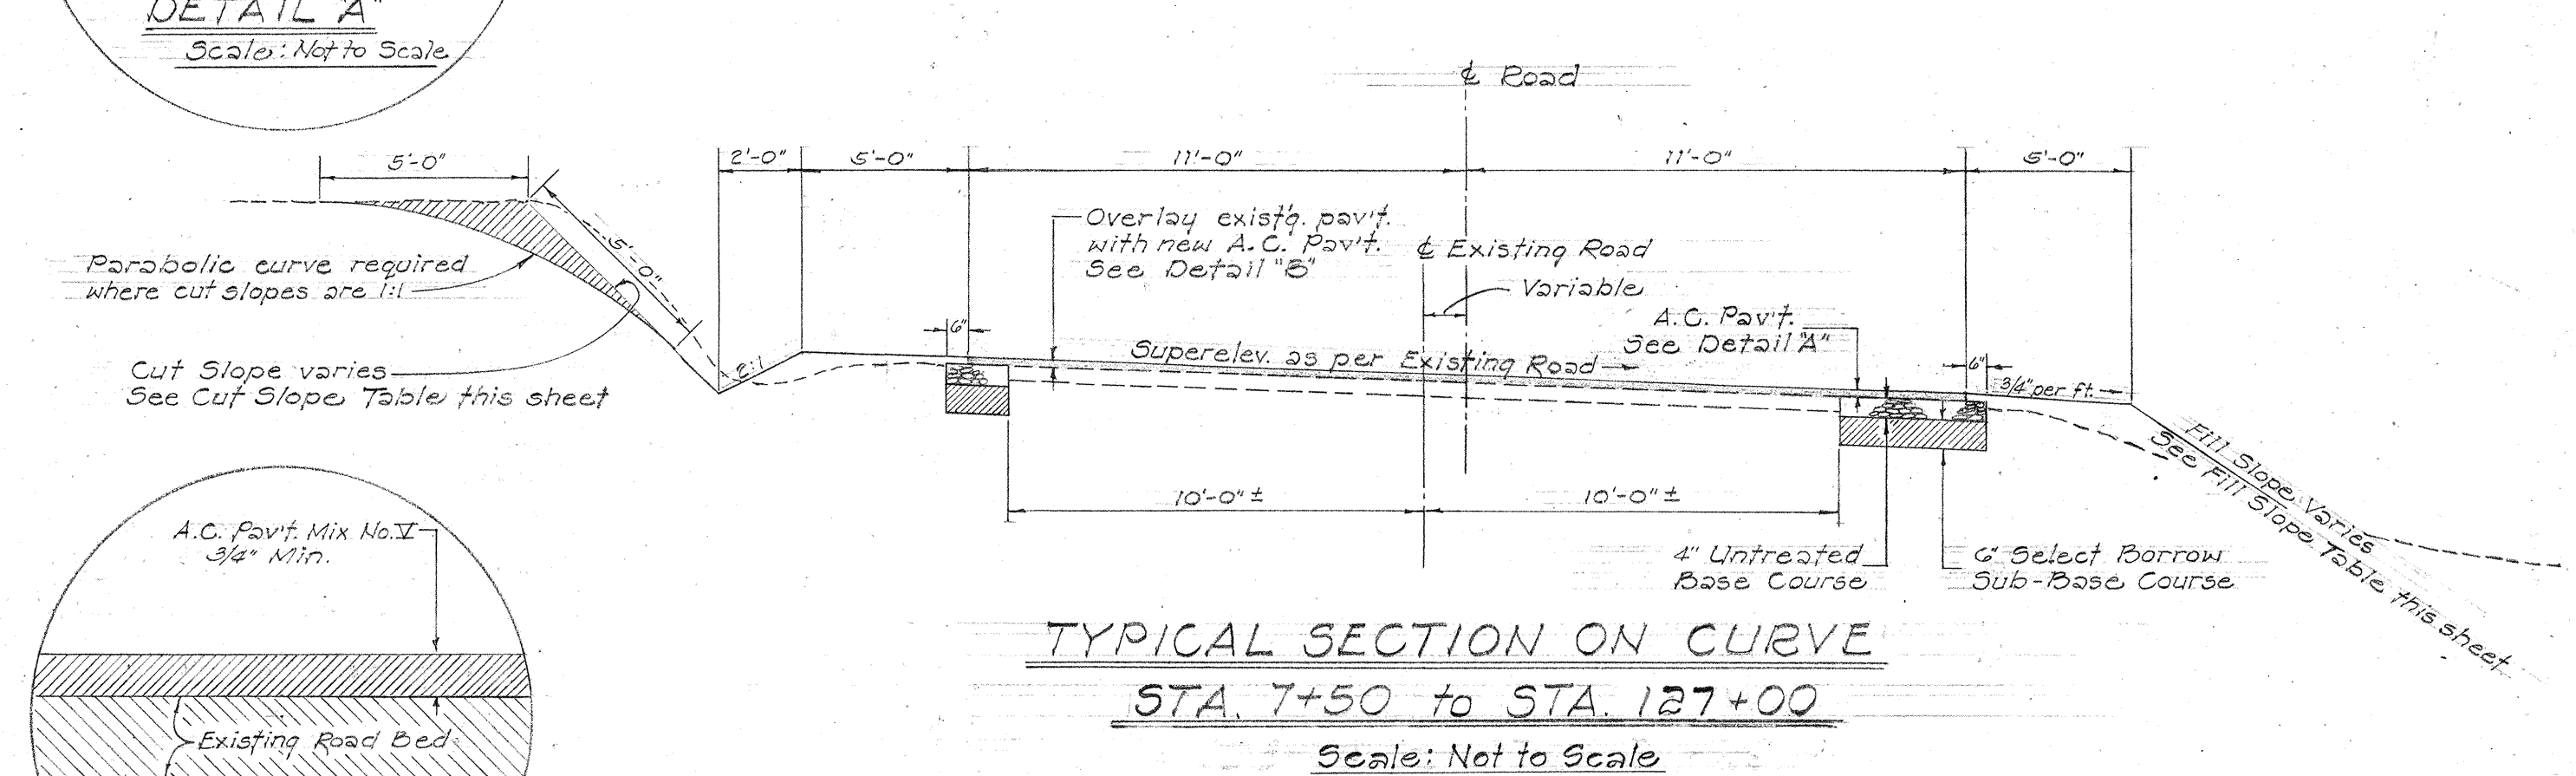
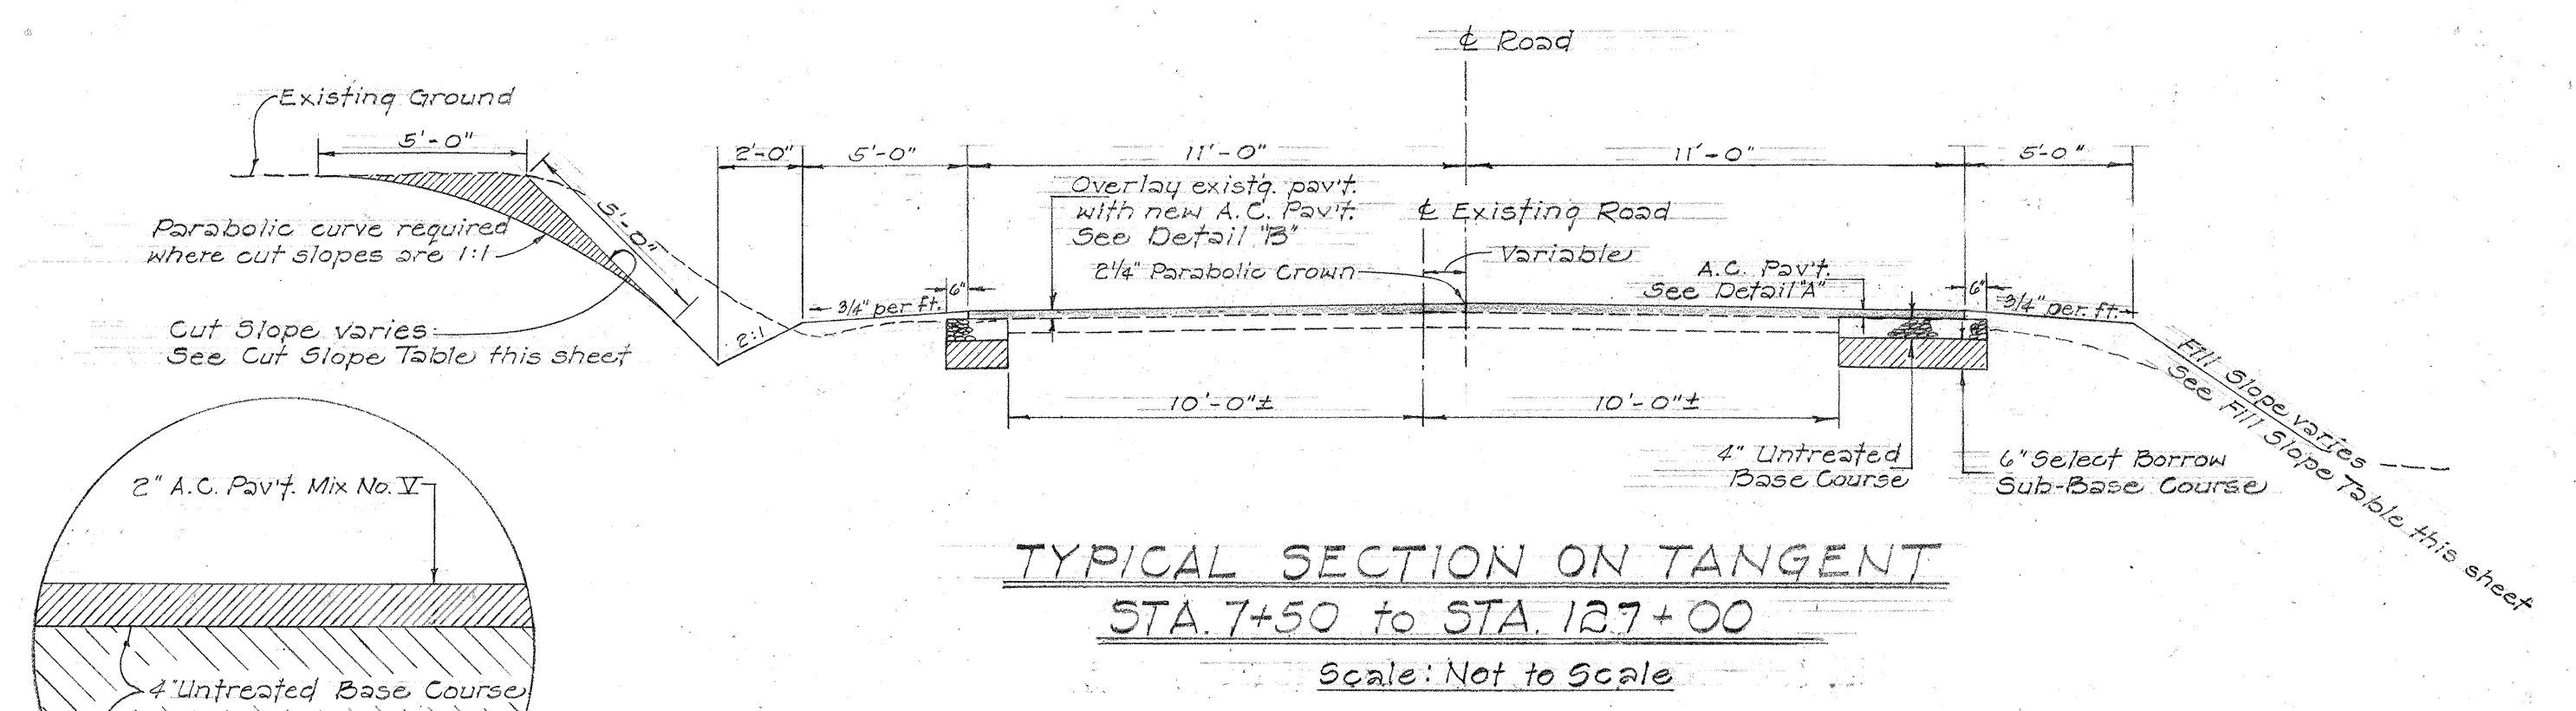
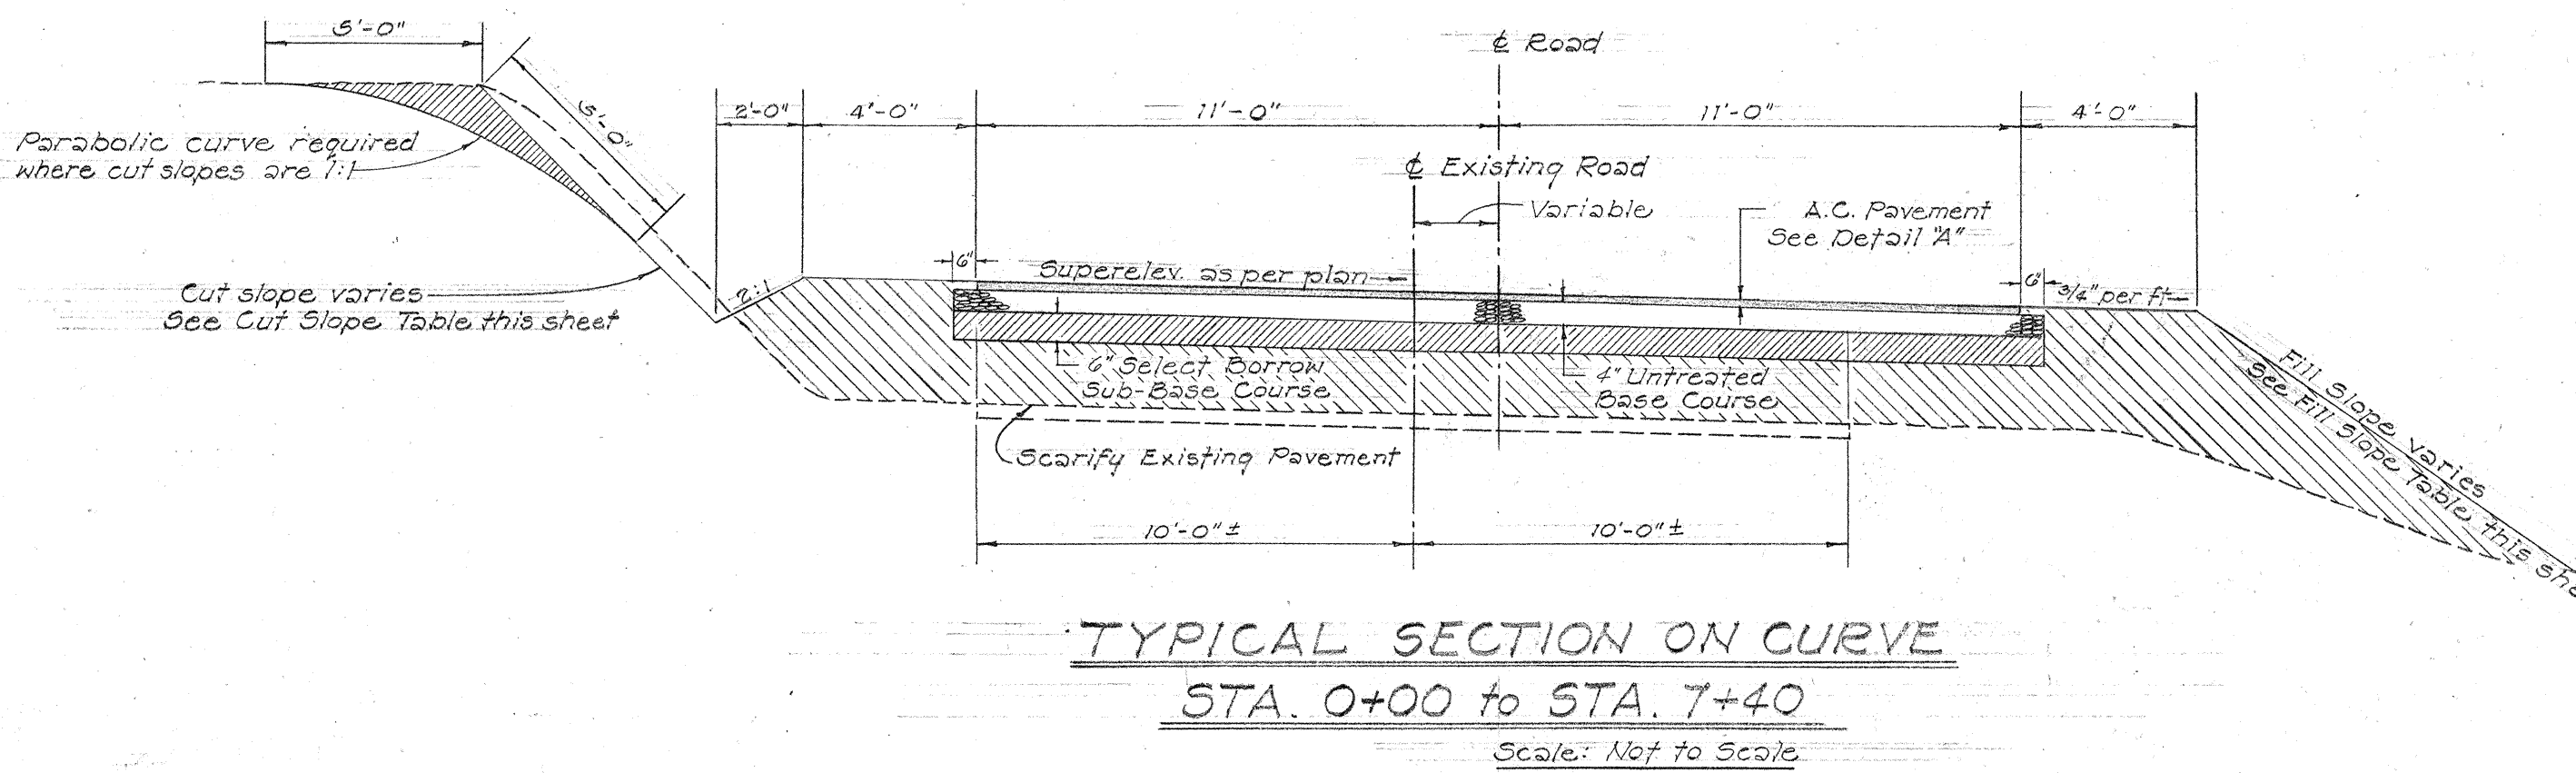
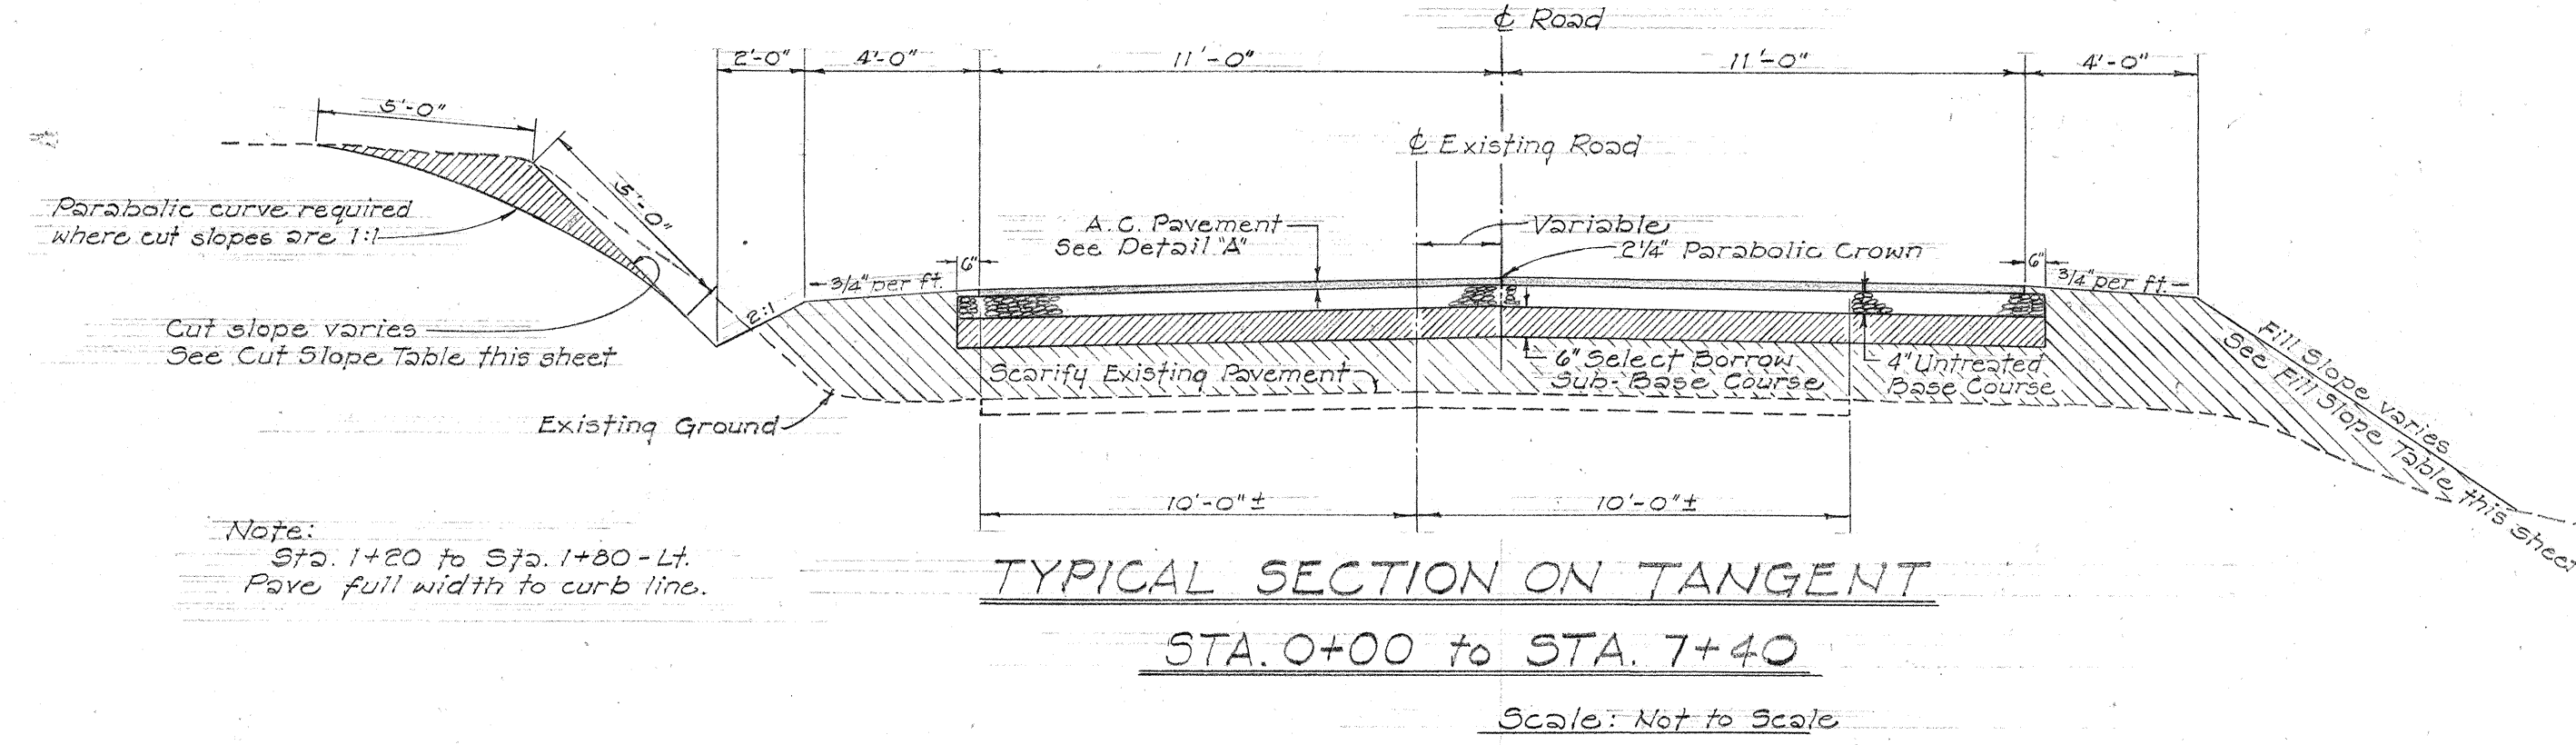


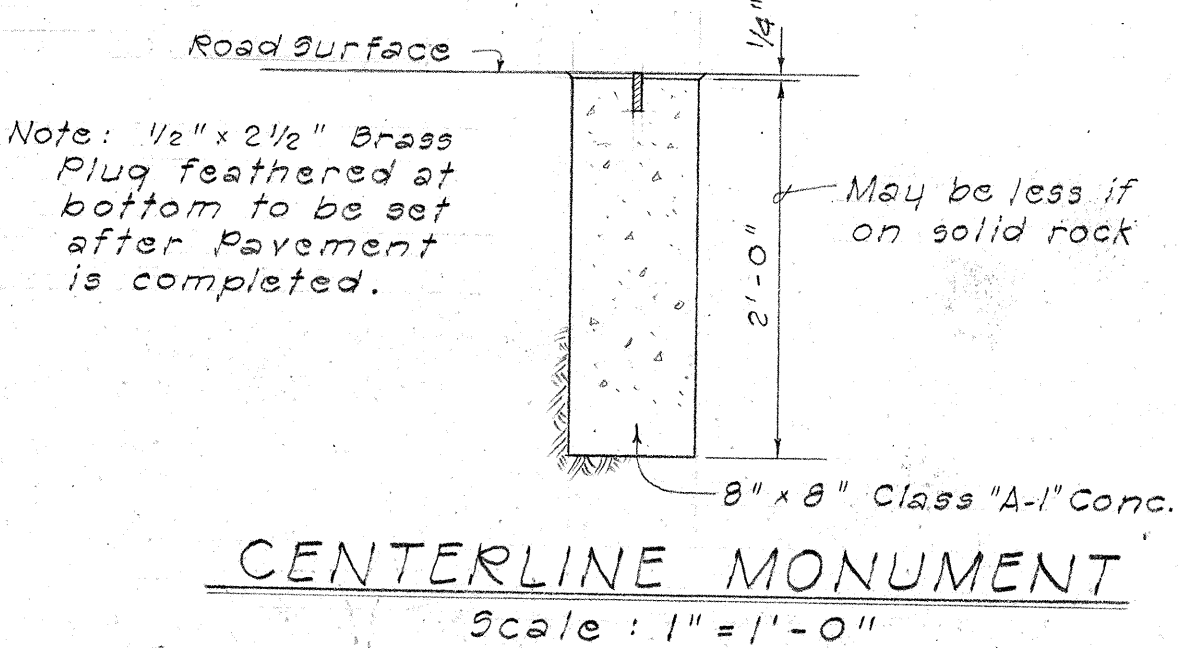

DETAIL OF SIDE ROAD APPROACHES
Scale: 1/4" = 1'-0"

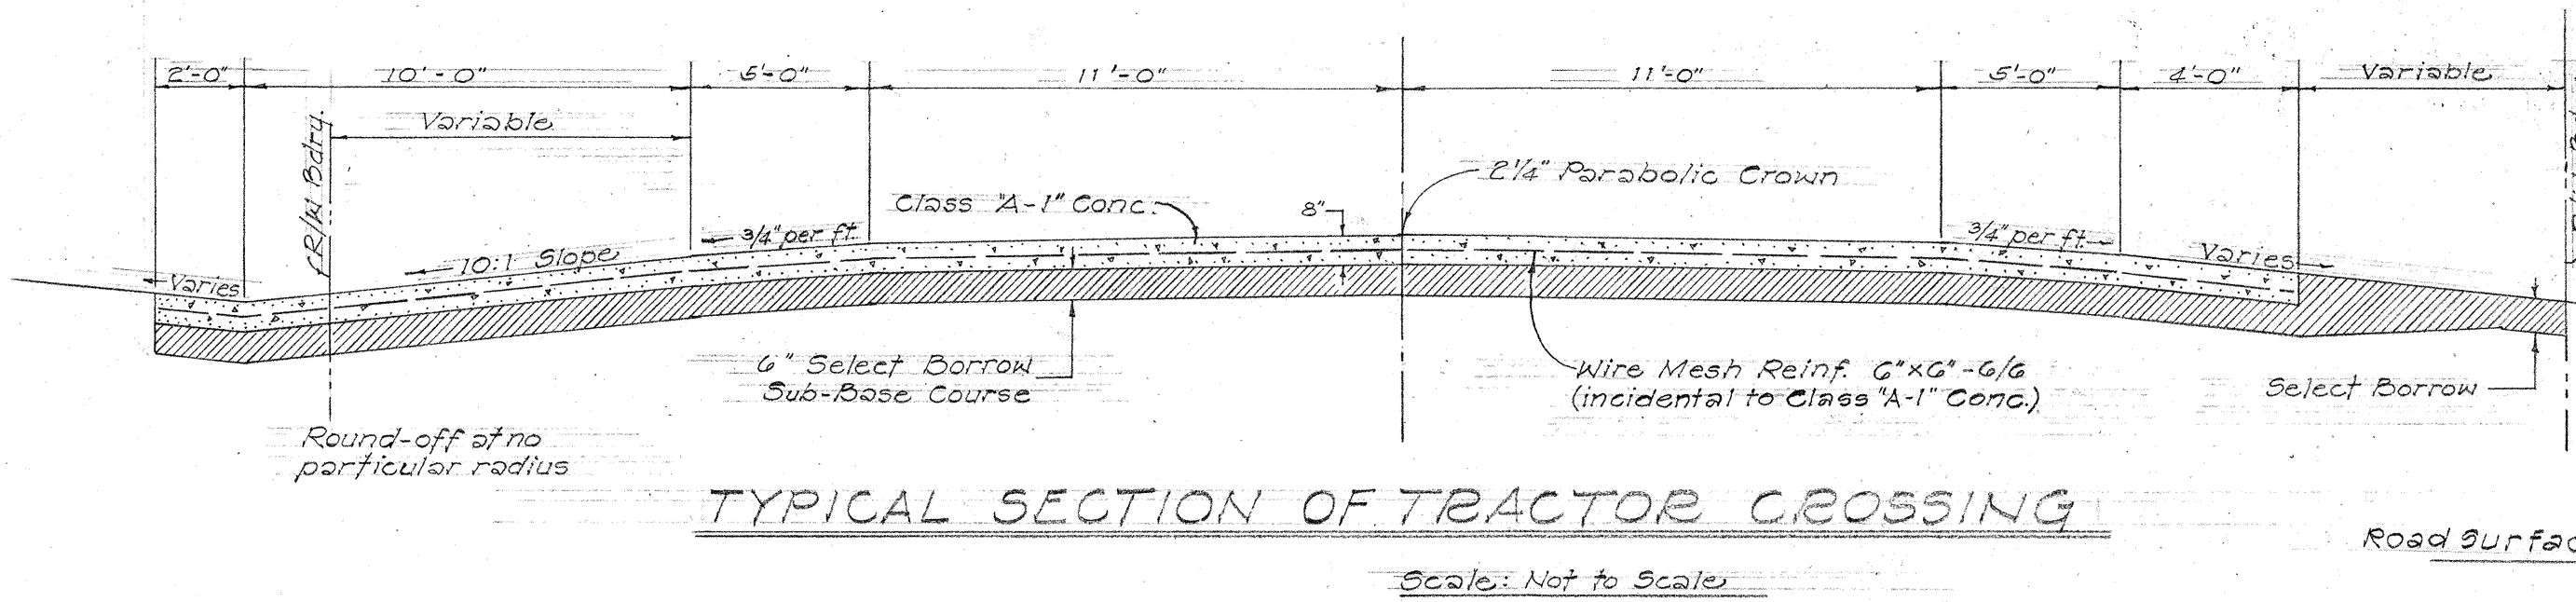

Cut Slope Table	
Station	Cut Slope
Sta. 0+00 to Sta. 13+00	1:1
Sta. 14+00 to Sta. 20+00	1/2:1
Sta. 21+00 to Sta. 25+00	1:1
Sta. 26+00 to Sta. 35+00	1/2:1
Sta. 36+00 to Sta. 62+00	1:1
Sta. 63+00 to Sta. 127+00	1/2:1

Fill Slope Table	
Height of Fill	Slope
0'-4"	4:1
4'-6"	3:1
6'-10"	2:1
10' & over	1 1/2:1