




NOTE:
1/2" x 2 1/2" Brass Plug feathered at bottom to be set after pavement is completed.

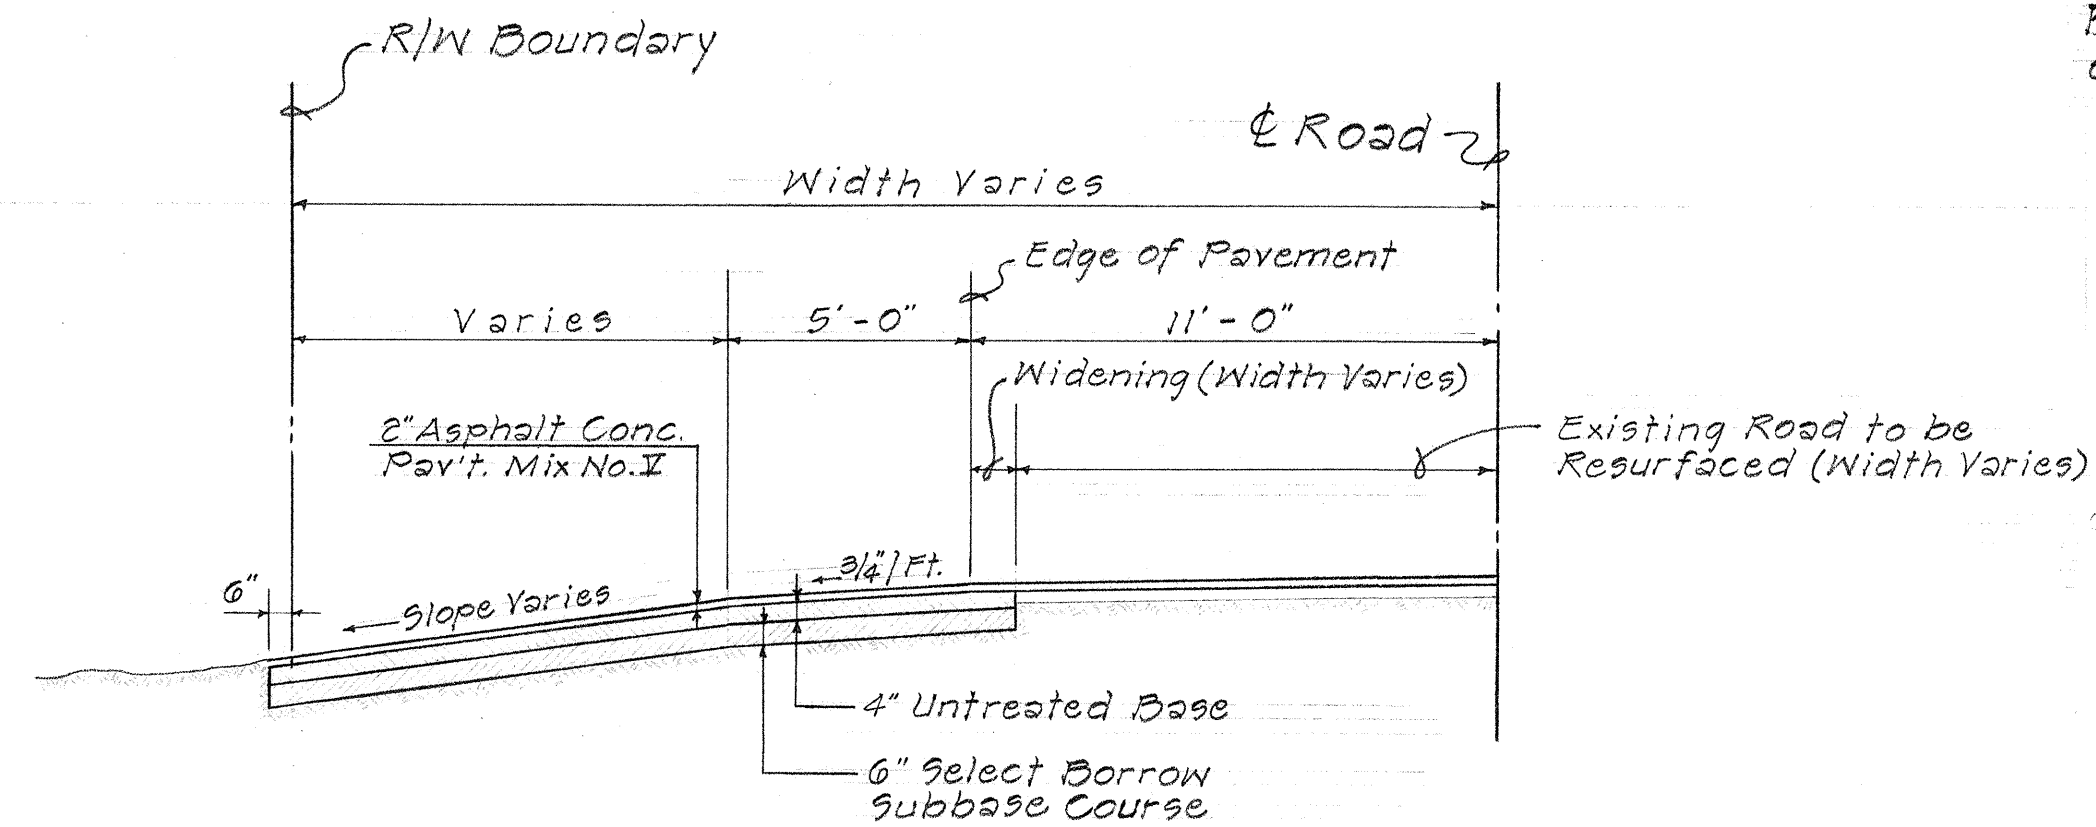


FILL SECTION

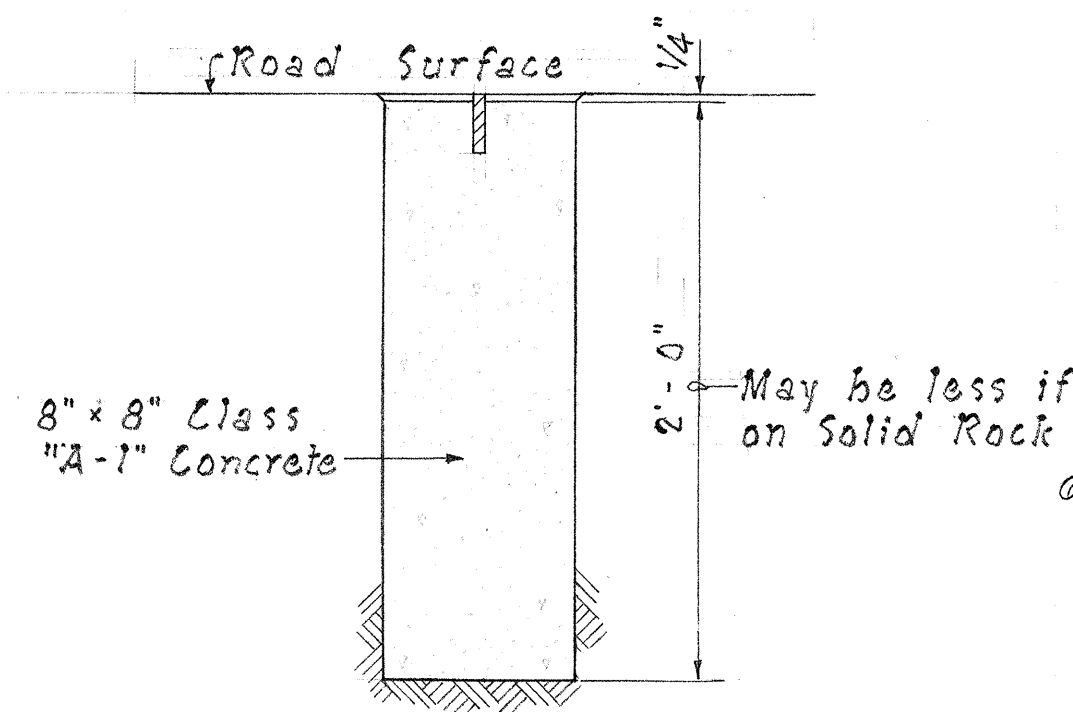

CENTERLINE MONUMENT
Scale: 1 1/2" = 1'-0"

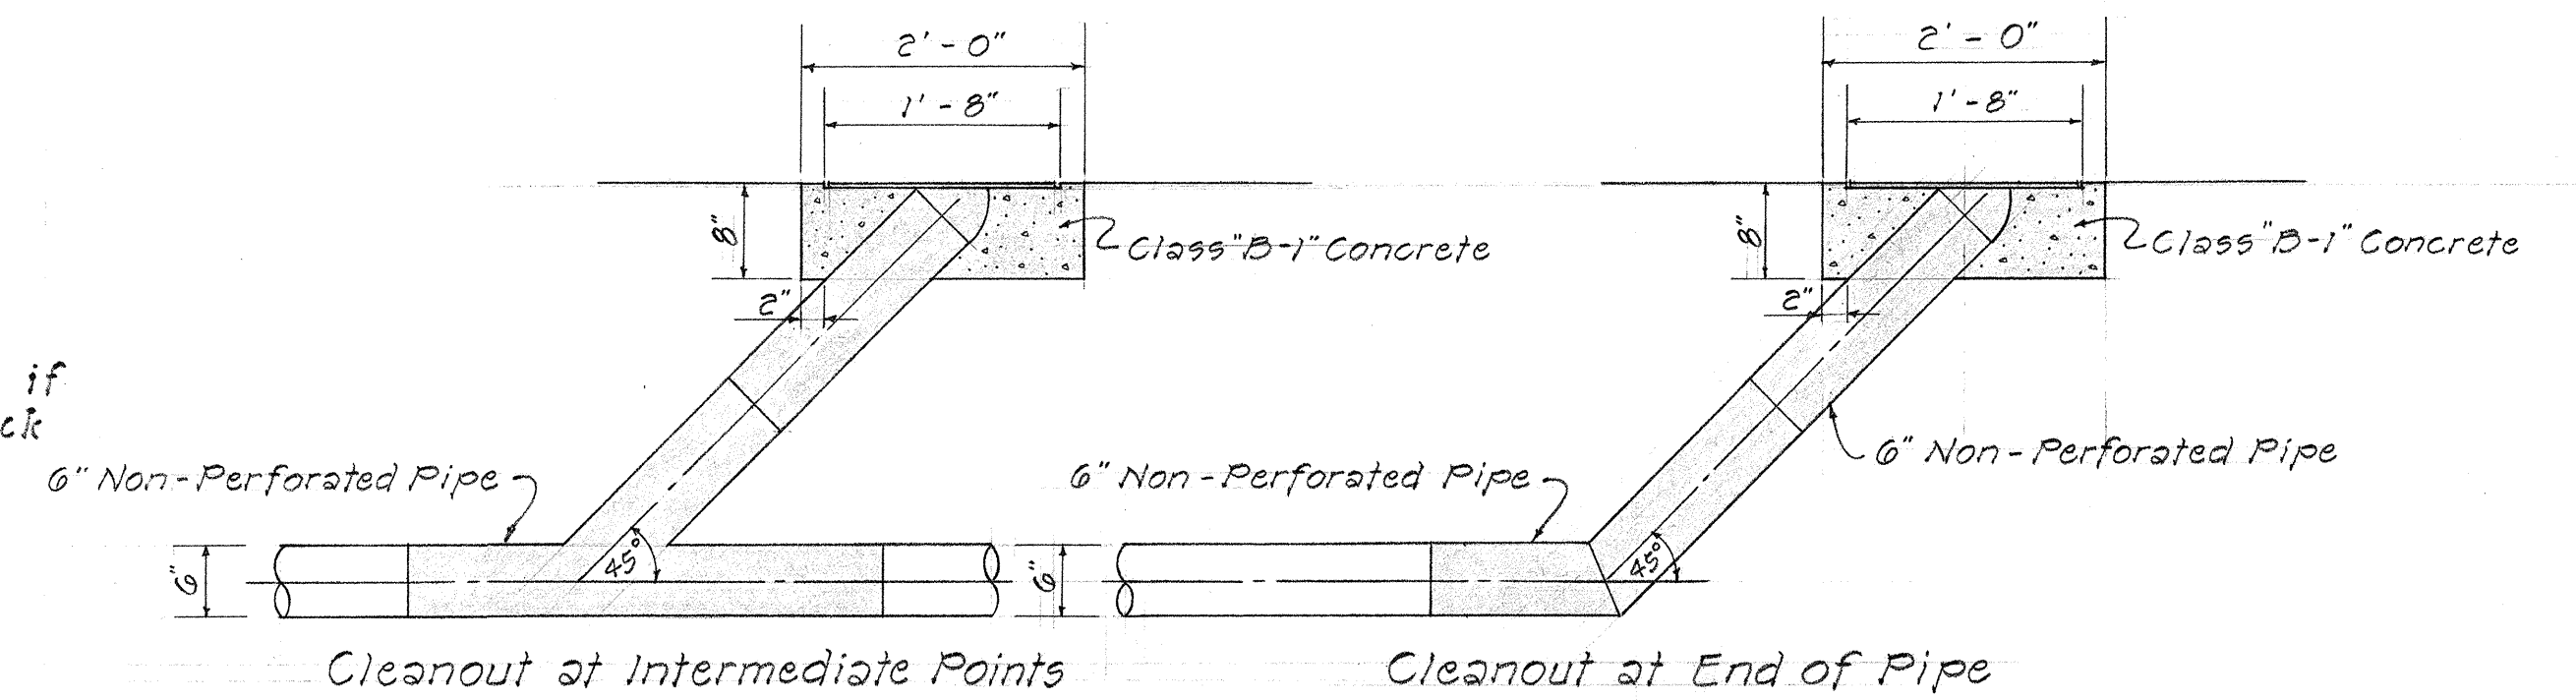


ELEVATIONS

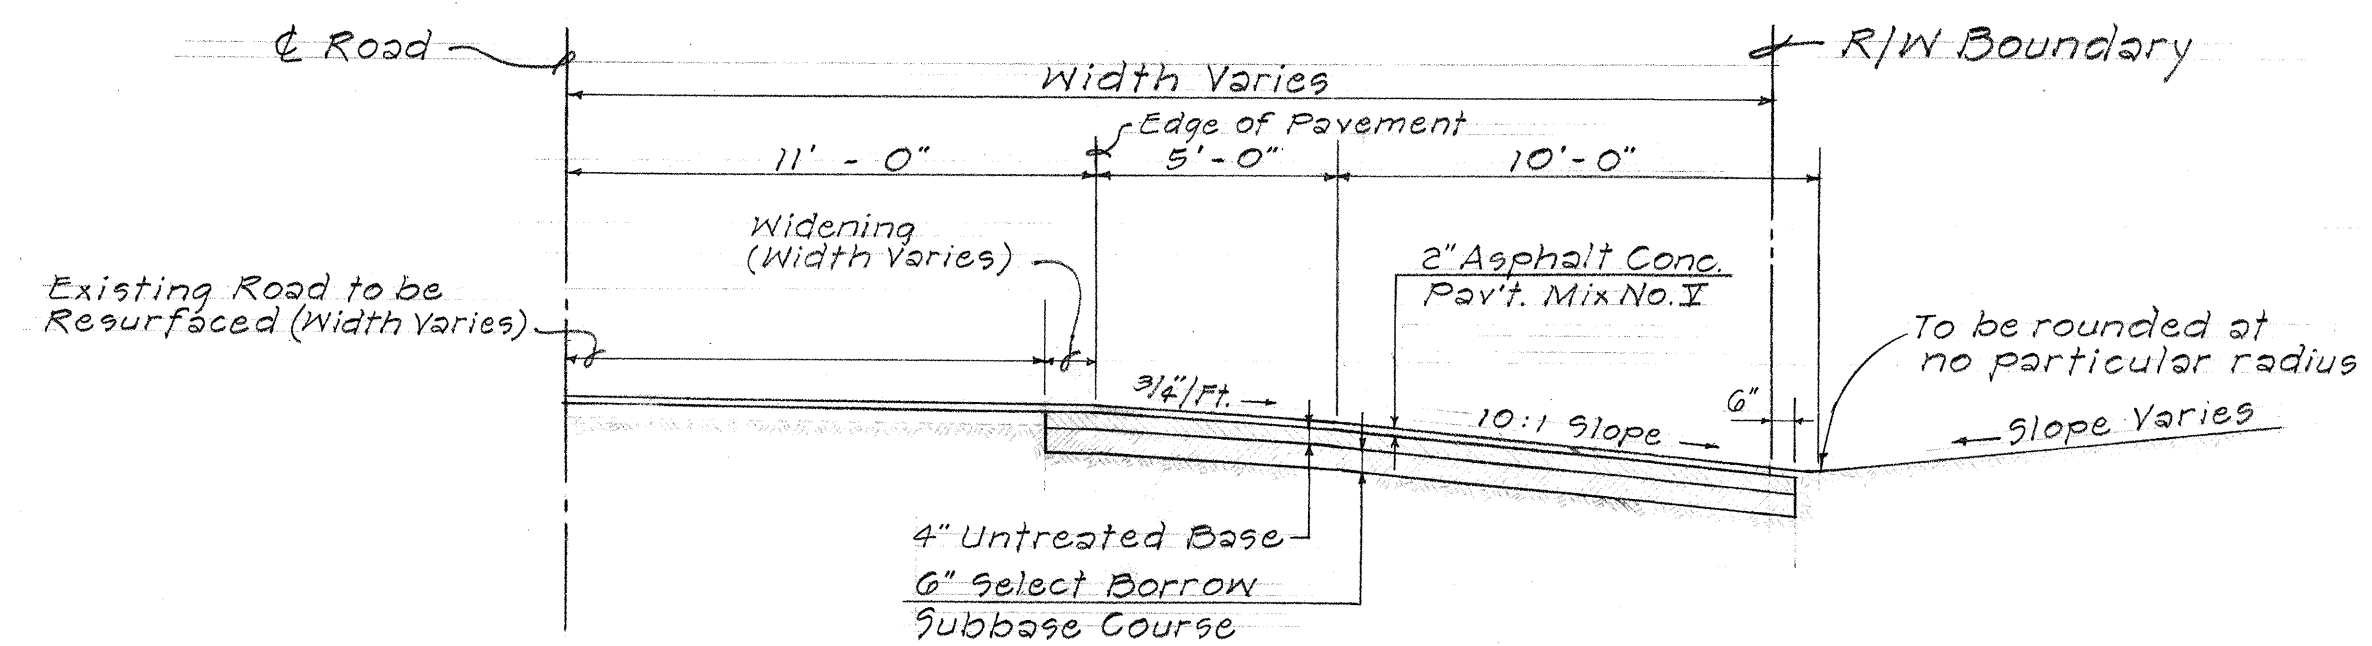

CUT SECTION

NOTES:



1. Steel Plates shall be thoroughly cleaned and painted with one coat of high grade asphaltum.
2. Shaded area denotes limit of payment for cleanouts.

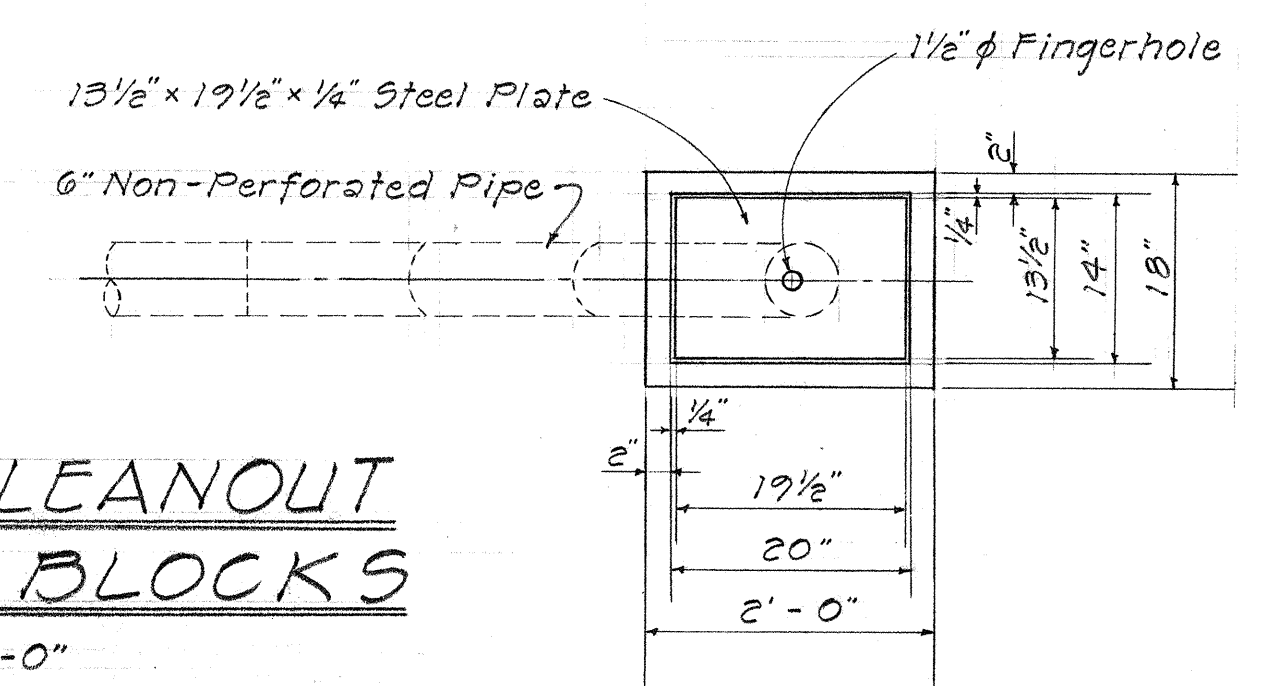


DETAIL OF CLEANOUT AND CONCRETE BLOCKS
Scale: 3/4" = 1'-0"

PLAN

DETAIL OF SIDE ROAD APPROACHES
Scale: 1/4" = 1'-0"

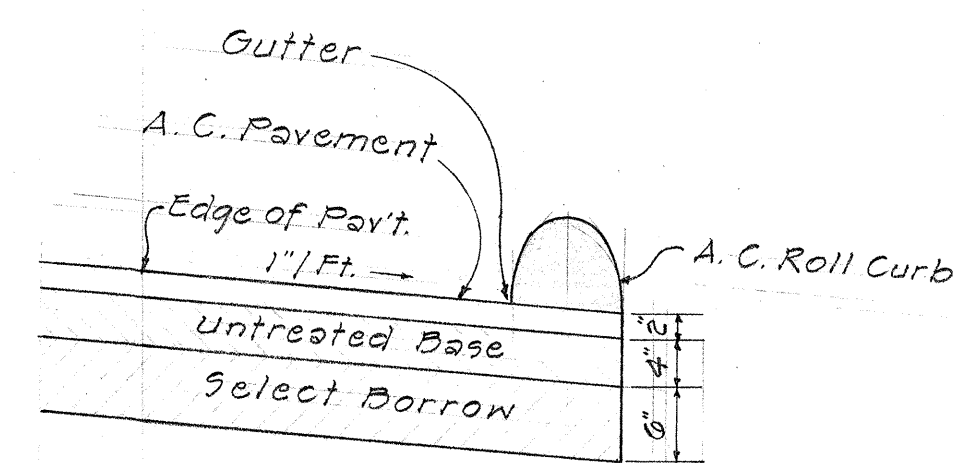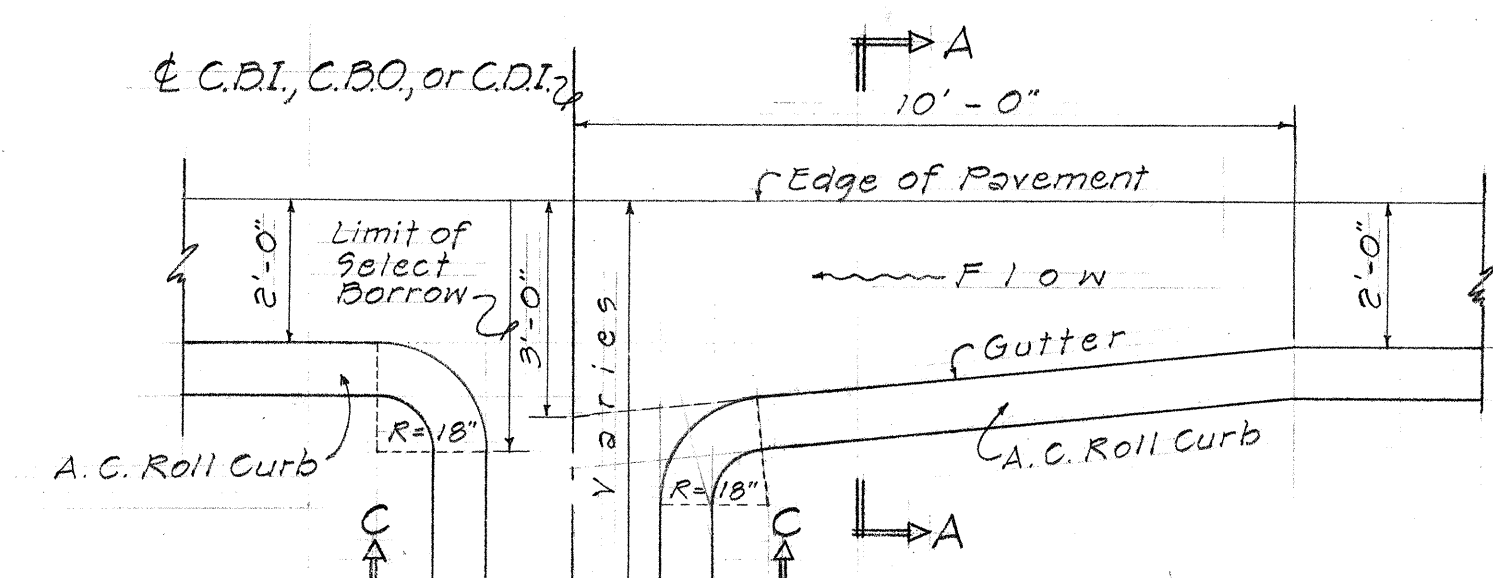


SECTION "A-A"
Scale: 3/4" = 1'-0"

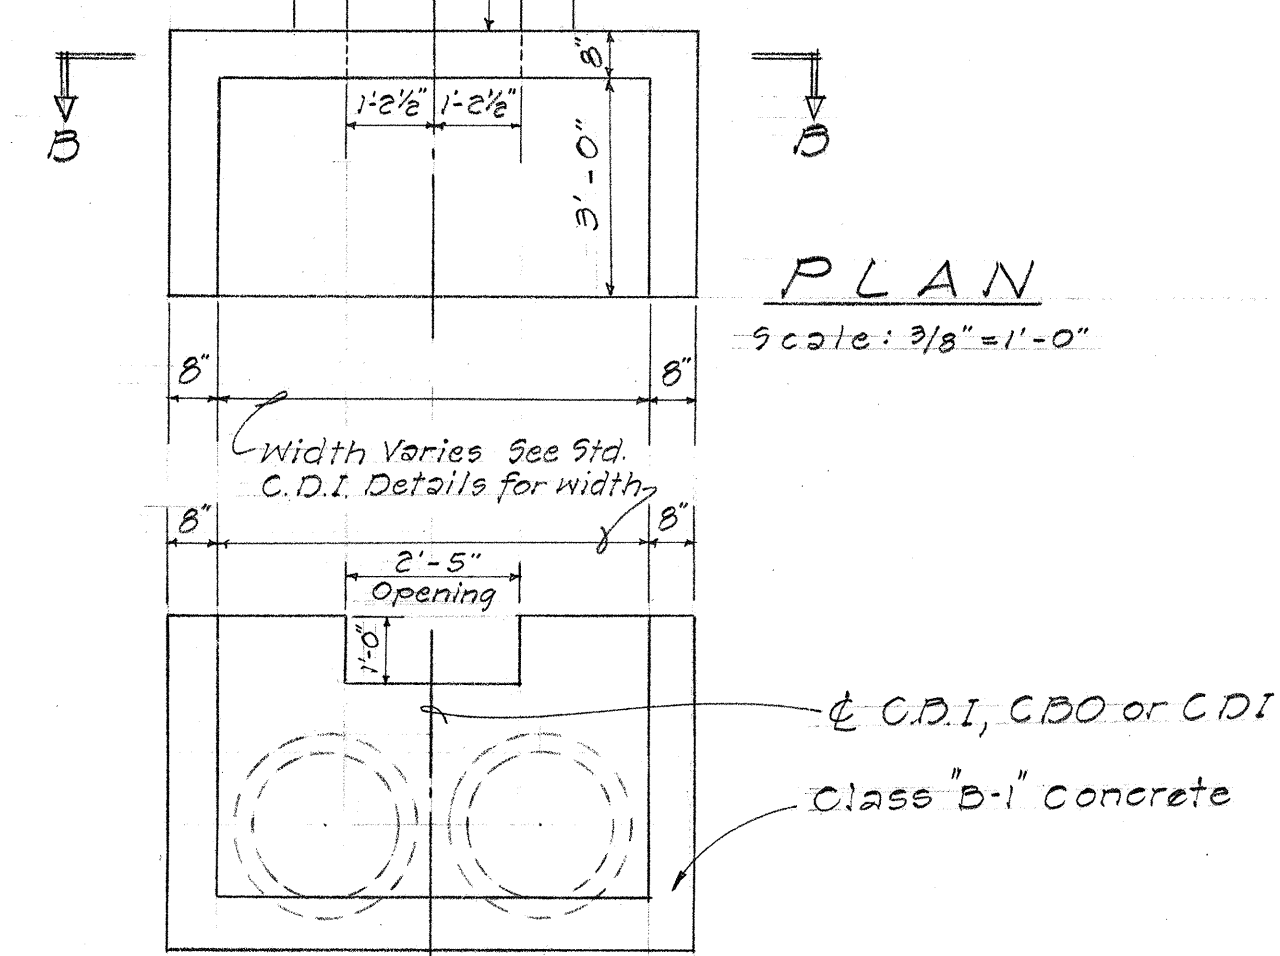

PLAN
Scale: 3/8" = 1'-0"


SECTION "B-B"
Scale: 3/8" = 1'-0"

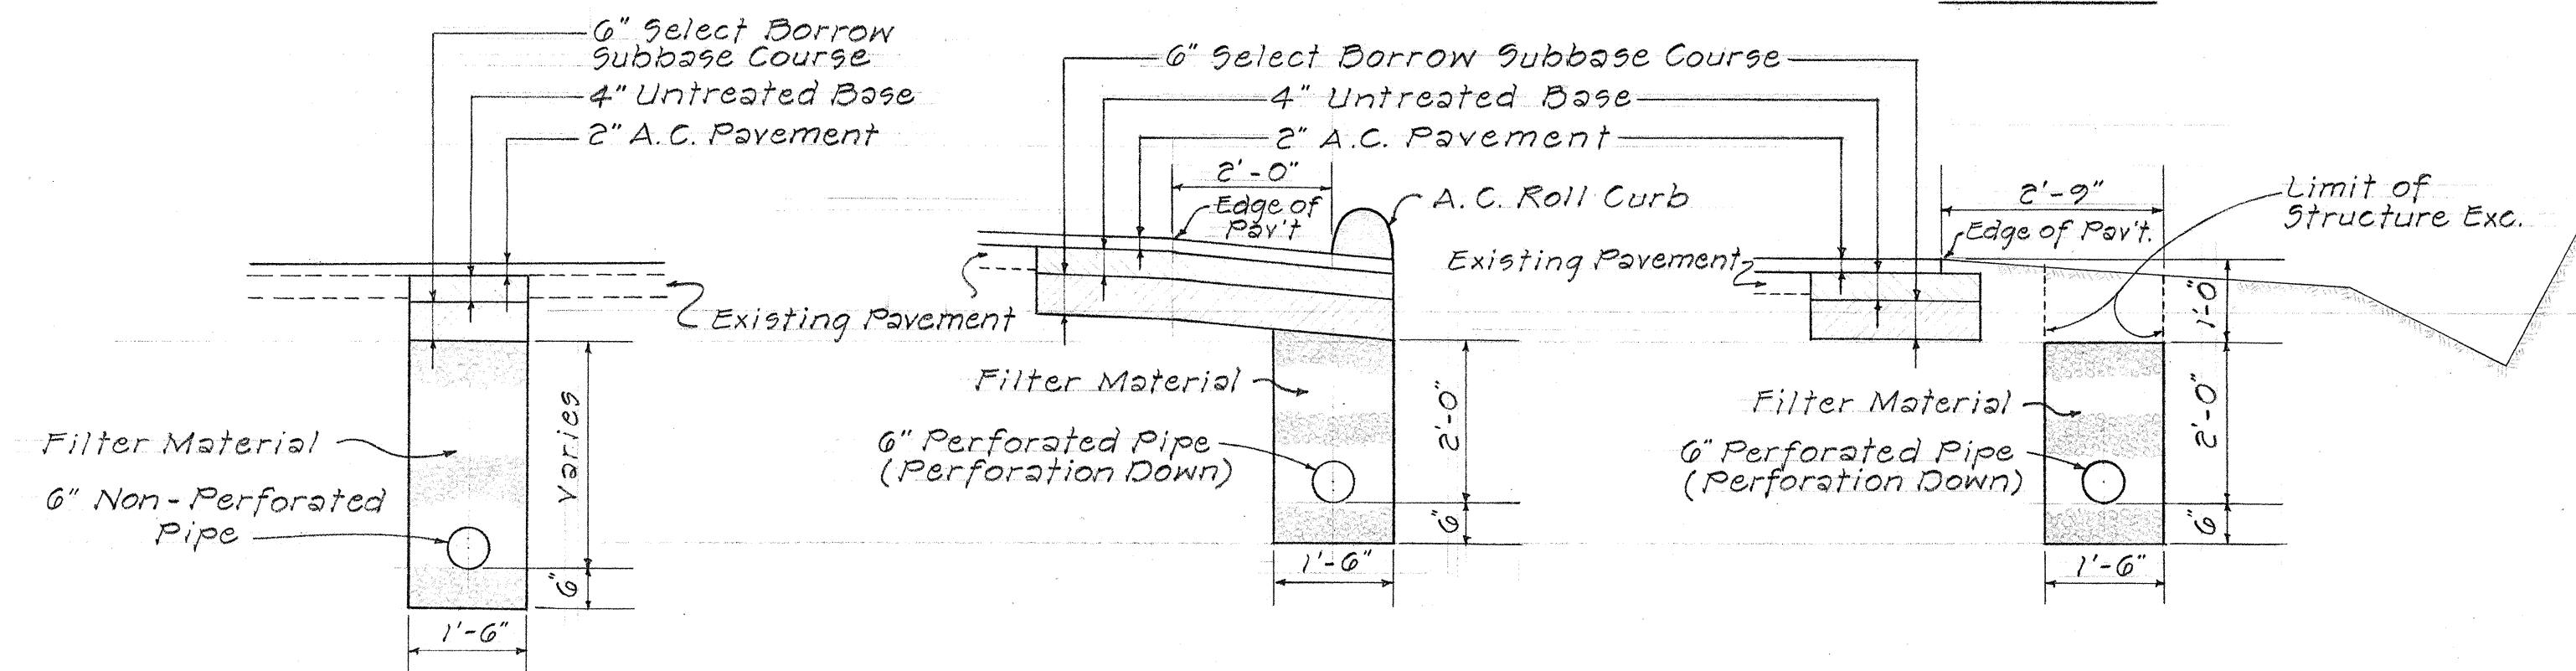

TRANSVERSE UNDERDRAIN DETAIL
Scale: 1/2" = 1'-0"

LONGITUDINAL UNDERDRAIN DETAIL
STA. 138+00 TO STA. 165+00 RT. AND LT.
Scale: 1/2" = 1'-0"

LONGITUDINAL UNDERDRAIN DETAIL
STA. 131+00 TO STA. 138+00 RT. AND LT.
STA. 165+00 TO STA. 169+00 RT. AND LT.
Scale: 1/2" = 1'-0"

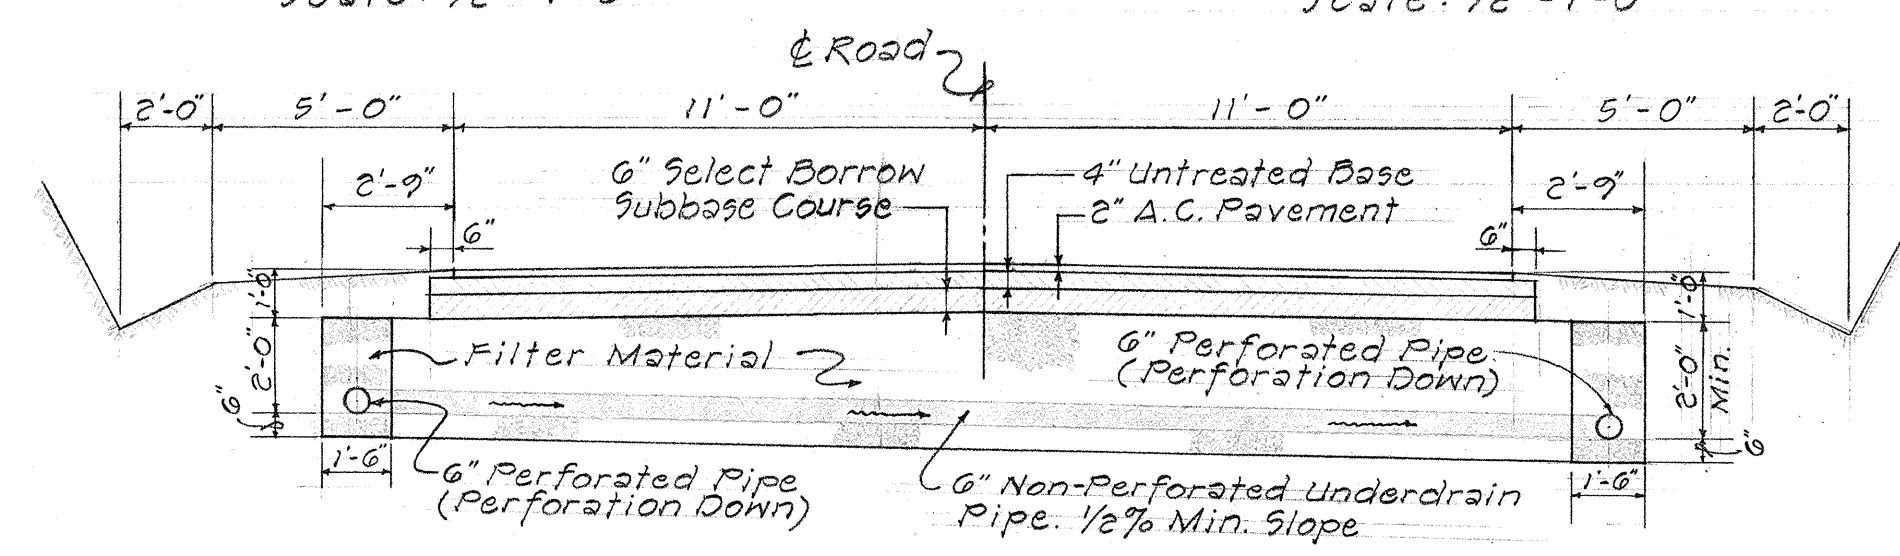

TYPICAL SECTION FOR TRANSVERSE UNDERDRAIN
STA. 132+00 AND STA. 168+00
Scale: 1/4" = 1'-0"

UNDERDRAIN DETAILS

DETAIL OF C.B.I. AND C.B.O. AND TYPICAL GUTTER TREATMENT
STA. 138+00 TO STA. 165+00

STATE OF HAWAII
DEPARTMENT OF TRANSPORTATION
HIGHWAYS DIVISION

MISCELLANEOUS DETAILS
MALUHIA ROAD
PROJECT NO. A 520-01-66 UNIT 3
KOLOA, KAUAI

Scale: As Shown
March, 1966
SHEET No. 1 OF 1 SHEETS

DATE	
SURVEY PLOTTED BY	
DRAWN BY	
DESIGNED BY	
NOTED BY	
CHECKED BY	
ORIGINAL PLAN	
NOTE BOOK	
No.	