

INDEX TO DRAWINGS	
SHEET NO.	DESCRIPTION
1	TITLE SHEET
2	TYPICAL SECTIONS
3	MISCELLANEOUS DETAILS
4-5	PLAN AND PROFILE
6	CONNECTION AT KAUMUALII HIGHWAY
7-12	STANDARD DETAILS

STATE OF HAWAII

DEPARTMENT OF TRANSPORTATION

HIGHWAYS DIVISION

"AS BUILT" PLANS FOR

MALUHIA ROAD

(WIDENING AND RESURFACING)

PROJECT NO. A 520-01-66


UNIT 3

DISTRICT OF KOLOA

ISLAND OF KAUAI

CONVENTIONAL	SIGNS
Baseline	75
Boundary Line	
Fences (Named)	
Existing Roadway	
Pipe Culvert	
Box Culvert	
Telephone Line & Pole	T o T
Electric Line & Pole	E o E
Water Main	W- W-

PLAN PROFILE	SCALES	
	HOR.	1 INCH = 100 FT.
	VER.	1 INCH = 10 FT.

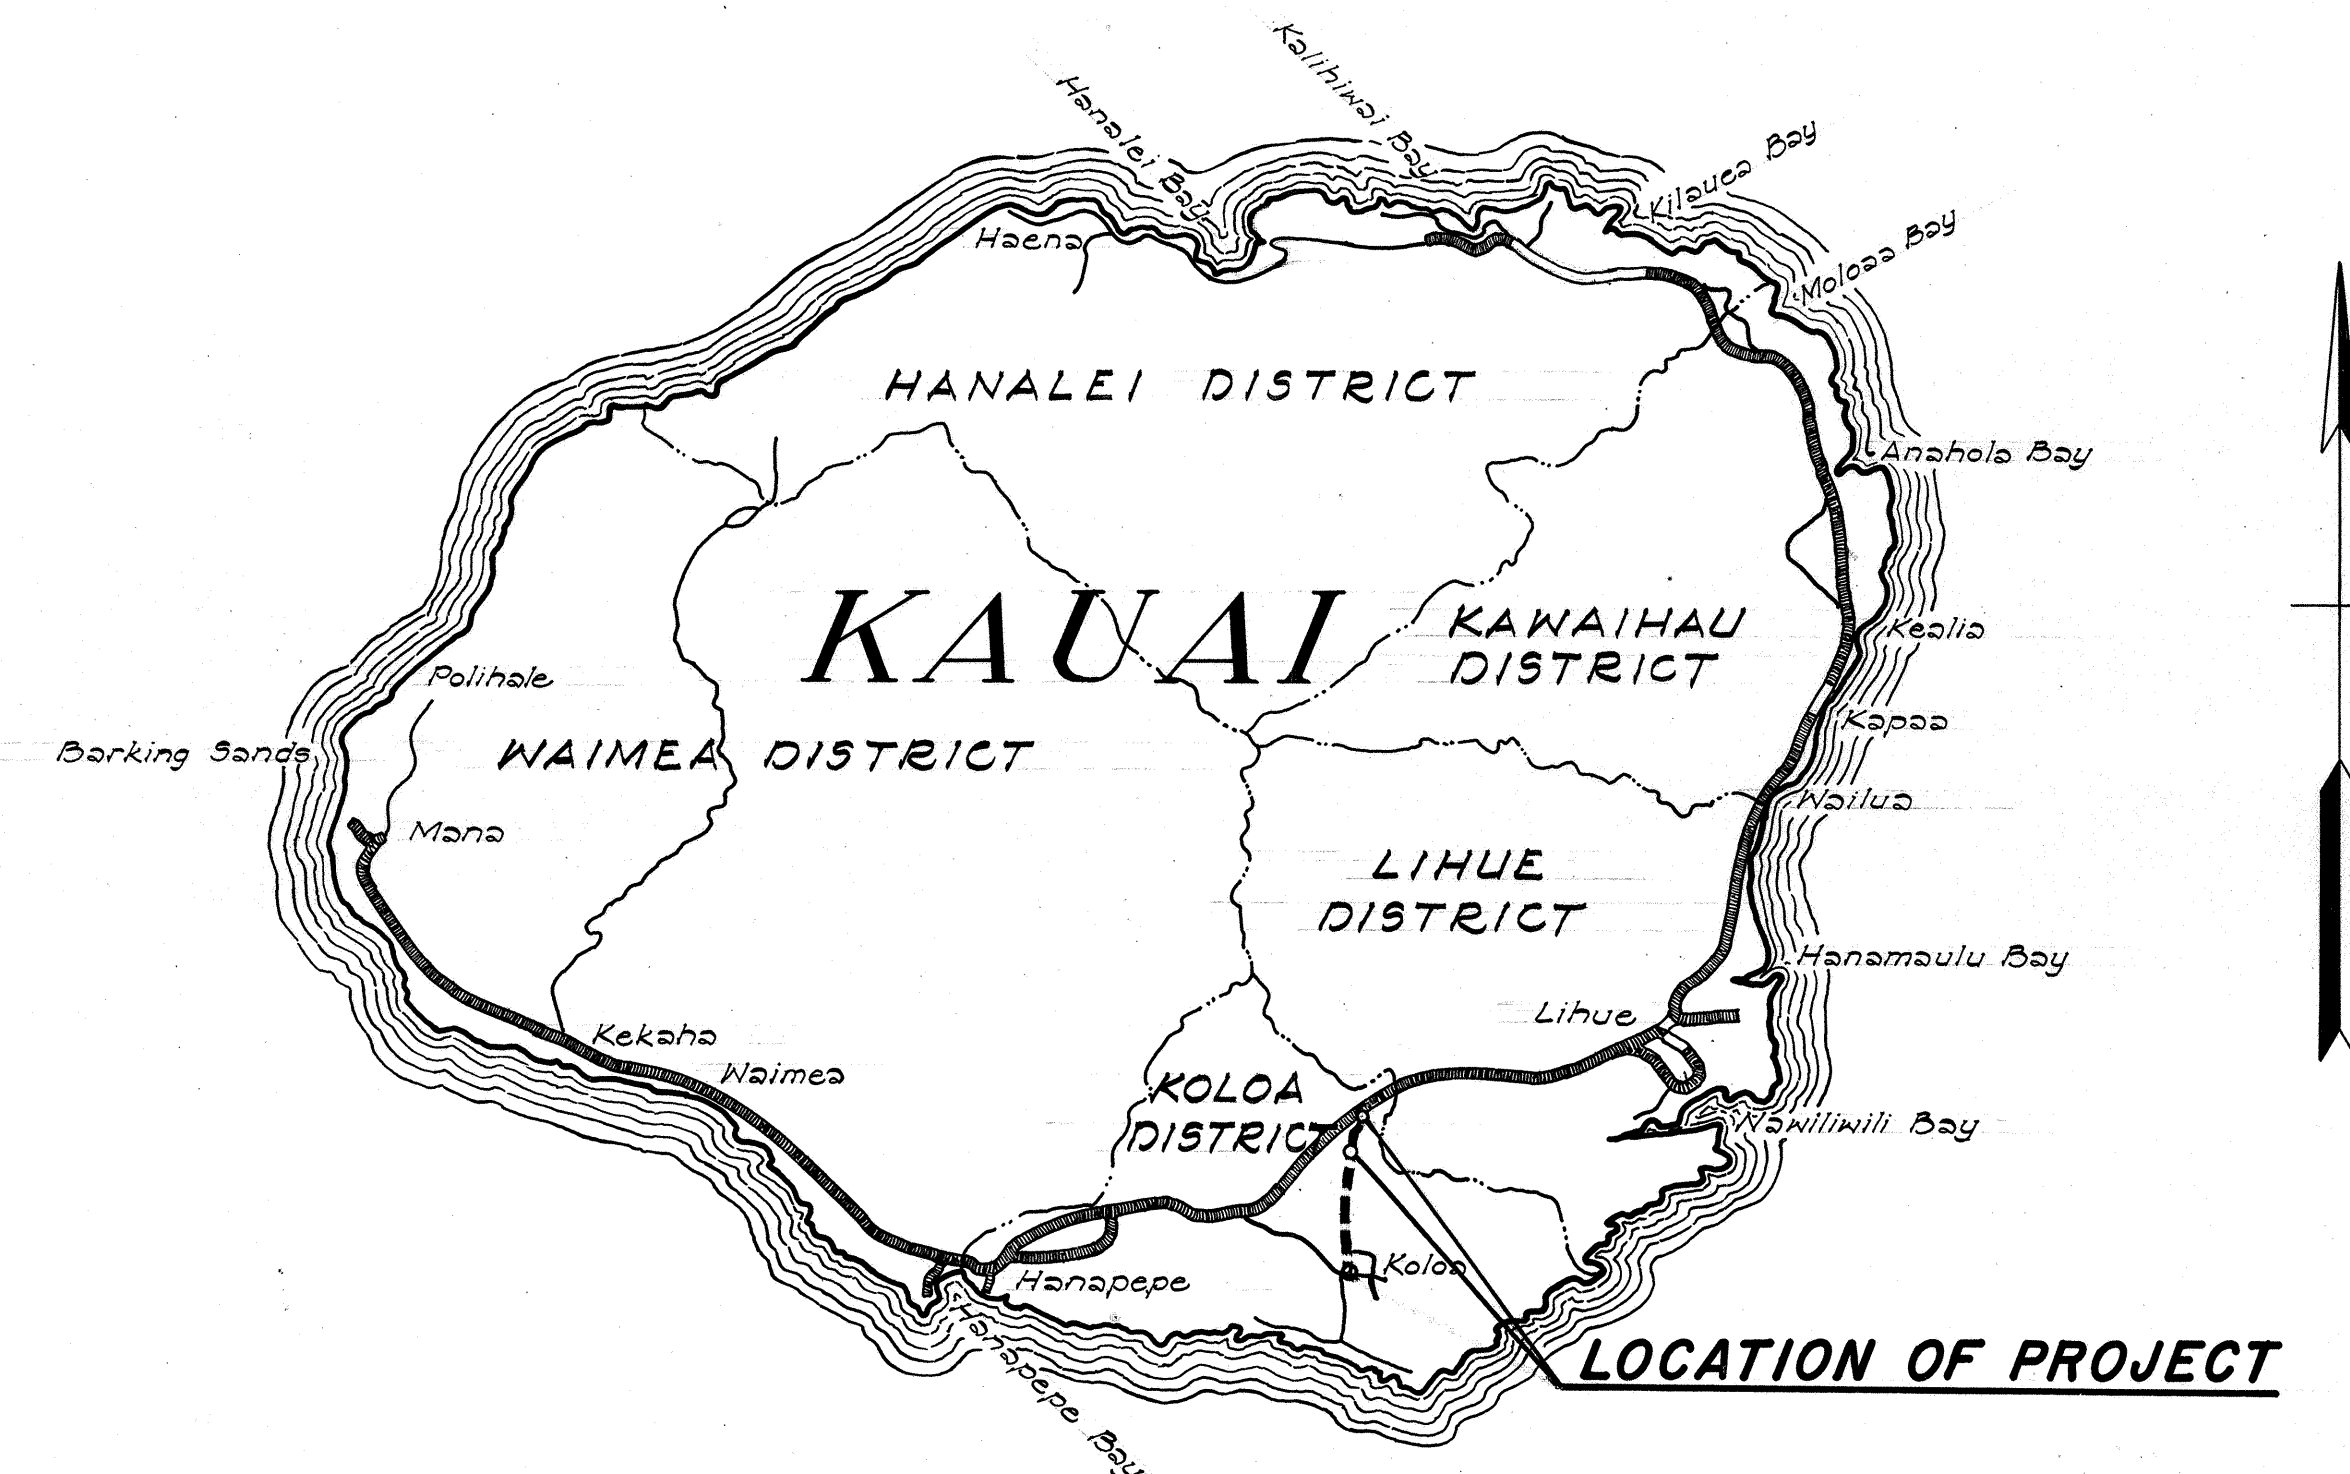

FEDERAL AID PROJECTS PREVIOUSLY CONSTRUCTED OR UNDER CONSTRUCTION

NOTE:
ALL CHANGES MADE DURING CONSTRUCTION HAVE BEEN NOTED IN RED ON THESE TRACINGS AND CHECKED BY:

Heide Yamaguchi

PROJECT ENGINEER


June 6, 1967

DATE

GROSS LENGTH OF PROJECT.....0.866 Mi.

BRIDGE (EXCEPTION).....0.008 Mi.

NET LENGTH OF PROJECT.....0.858 Mi.

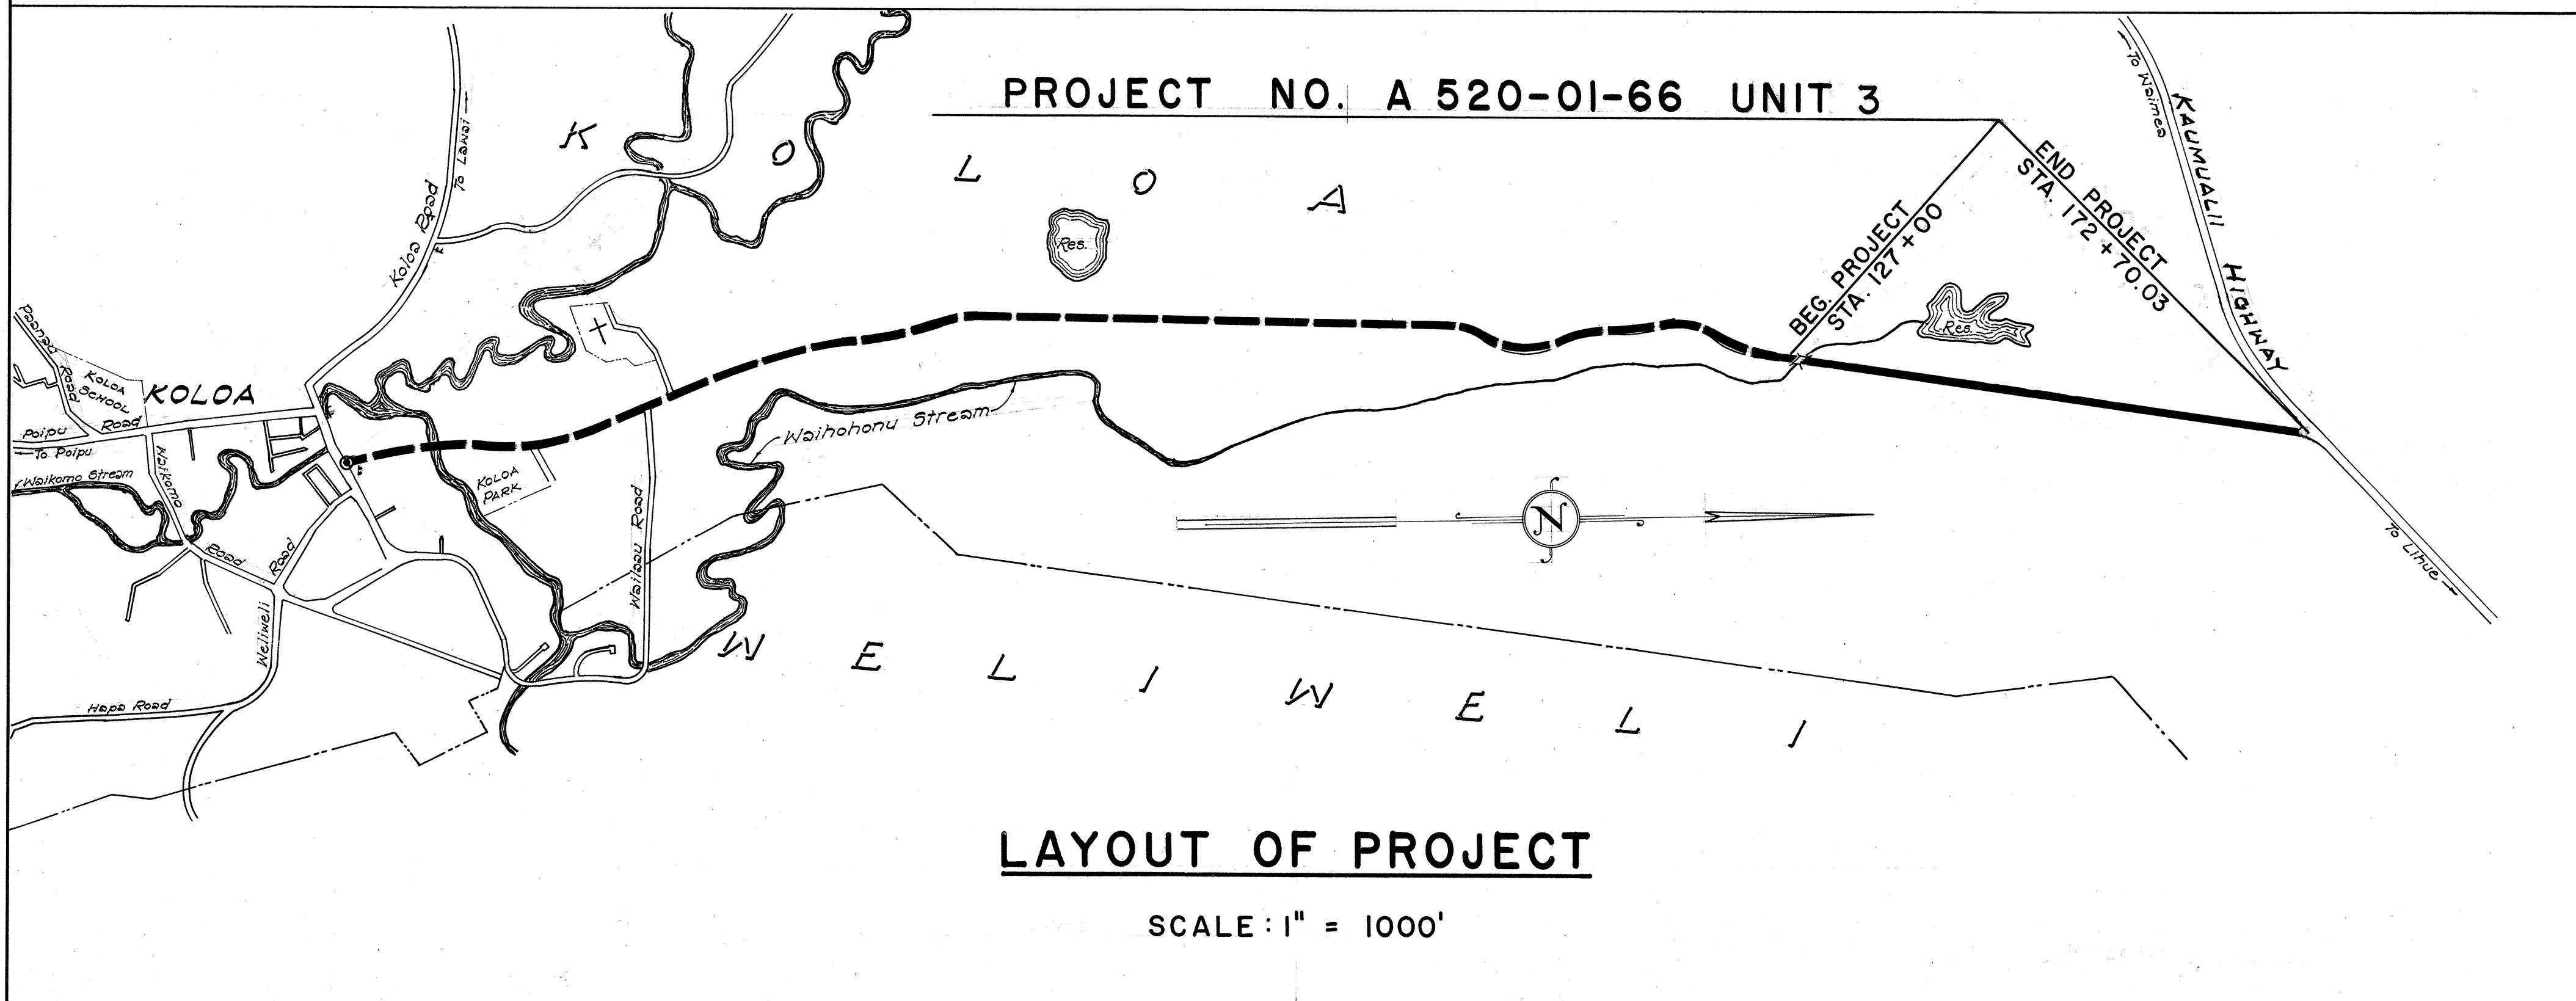

APPROVED: DATE 5/17/66

John B. K.

FOR DIRECTOR OF TRANSPORTATION

Designed by: A. Marutani May 1966

Checked by: F. Okimoto May 1966