



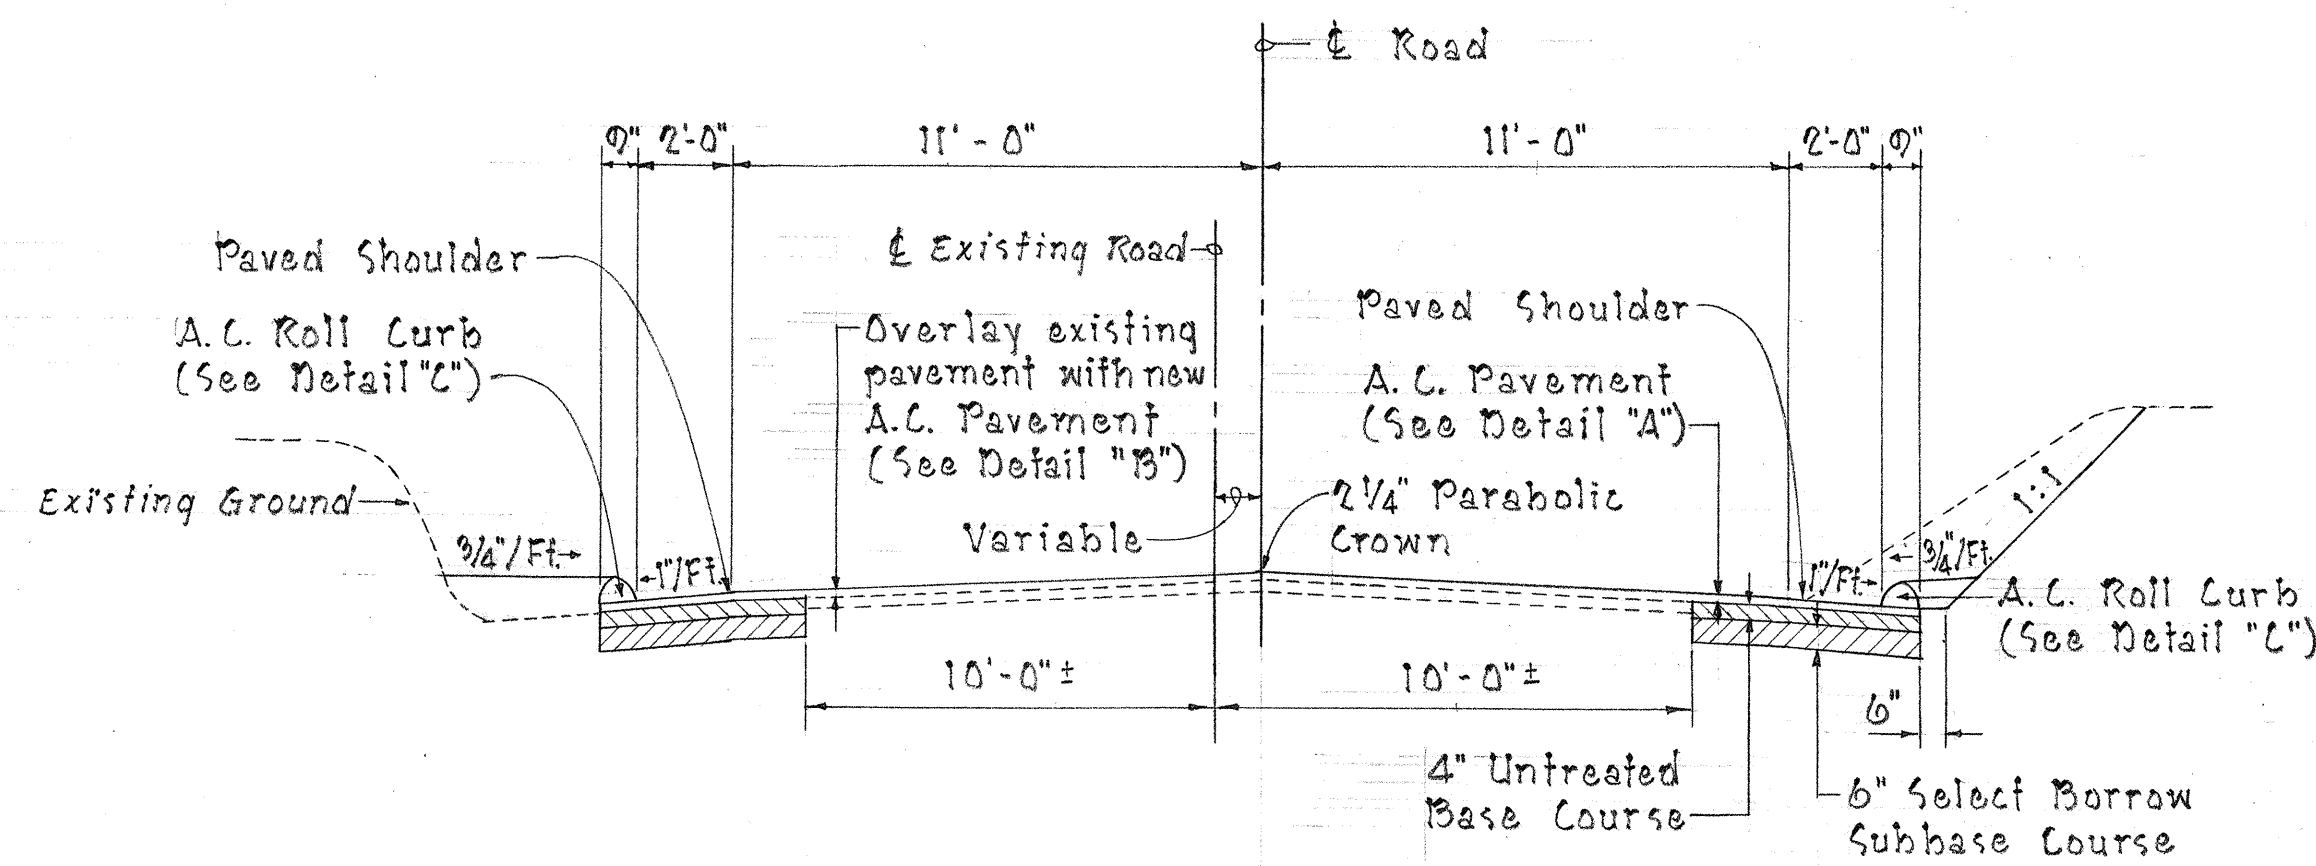


TYPICAL SECTION

STA. 138 + 00 TO STA. 165 + 00
Scale: 1/4" = 1'-0"

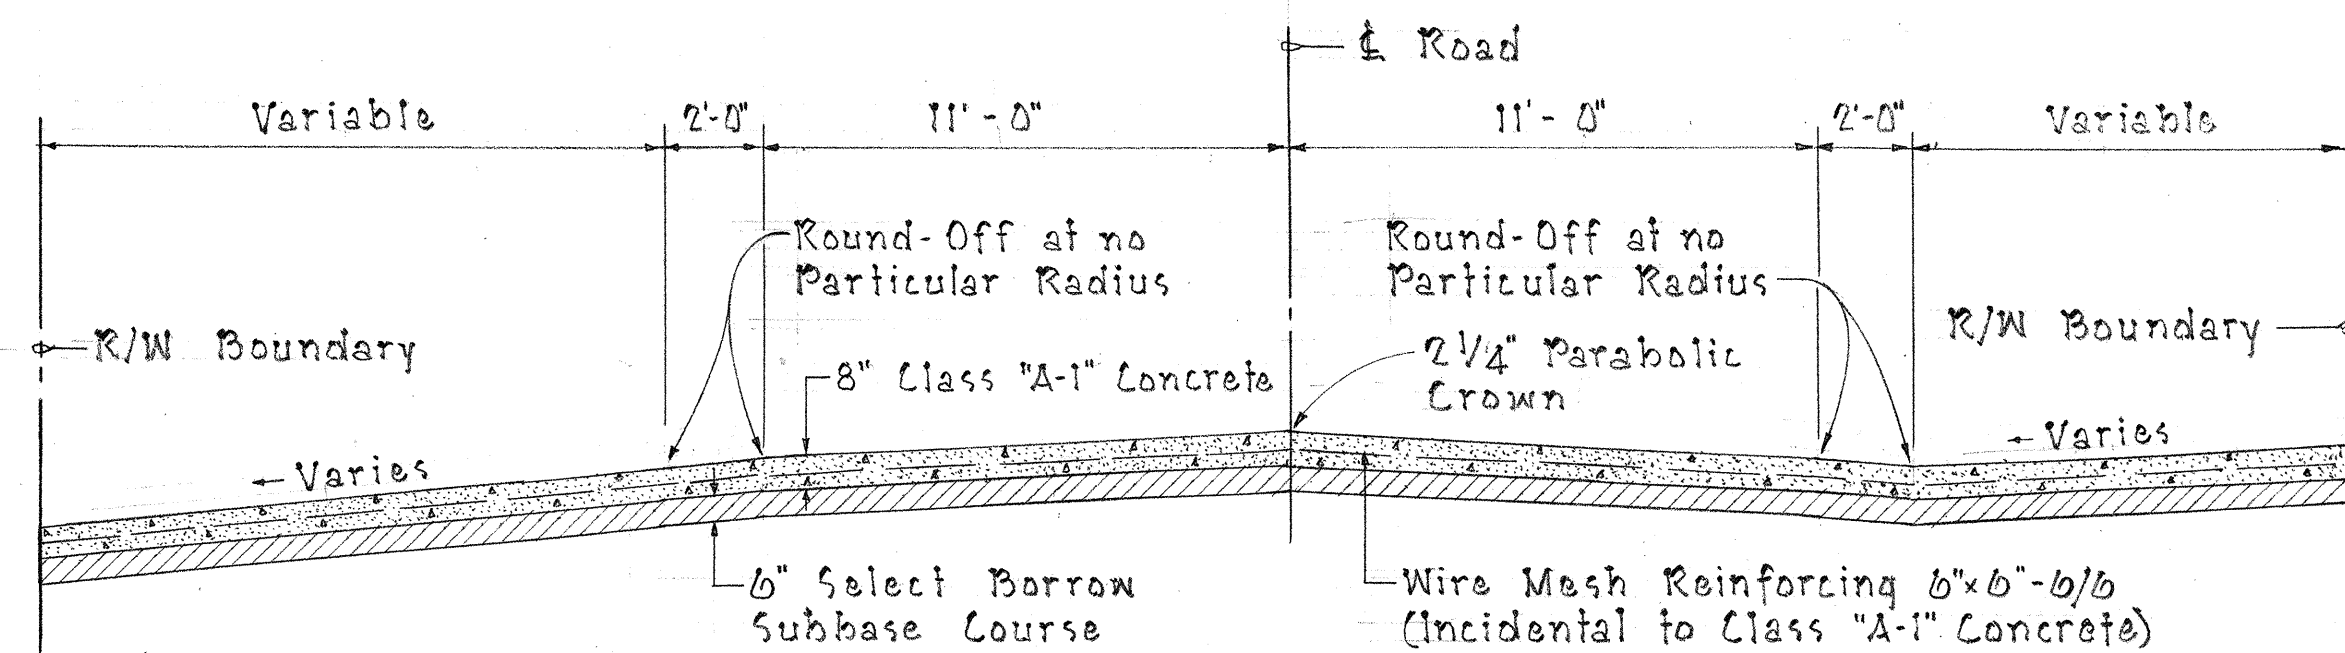


DETAIL OF TRACTOR CROSSING

STA. 165 + 40
Scale: 1/4" = 1'-0"

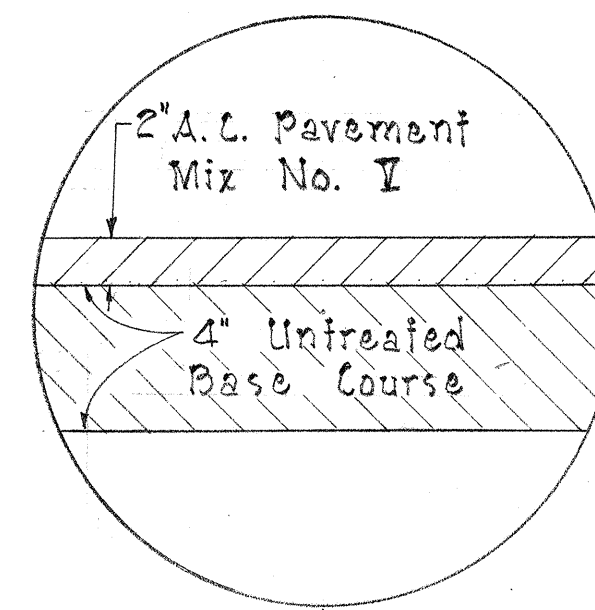


DETAIL "A"

Scale: Not to Scale

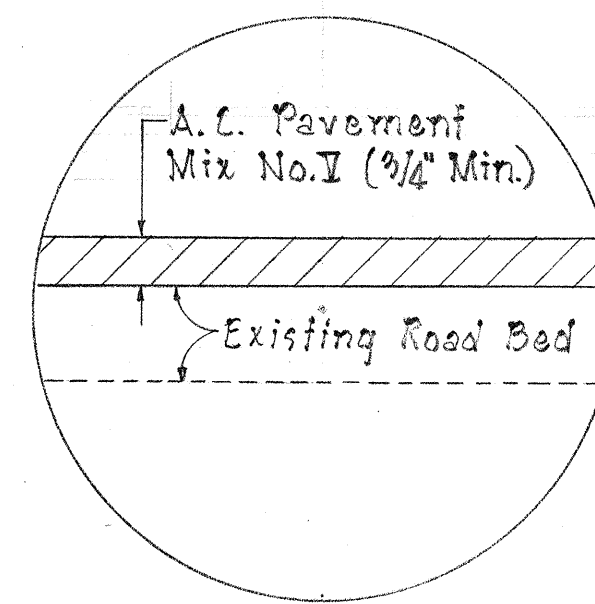


DETAIL "B"

Scale: Not to Scale

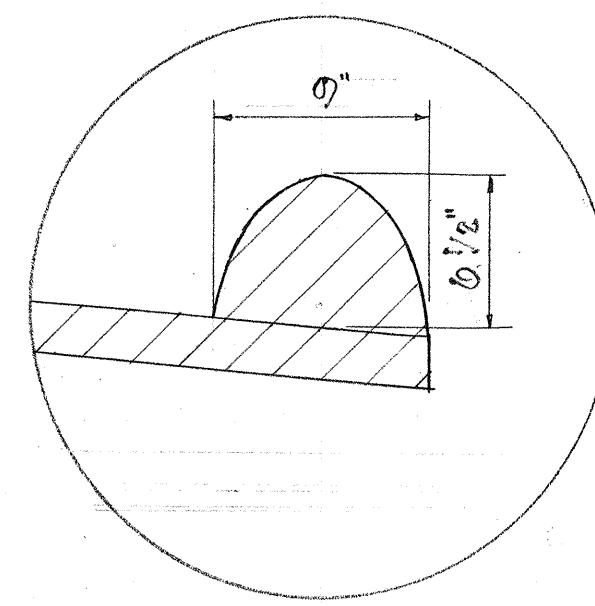

DETAIL "C"


Scale: 1 1/2" = 1'-0"

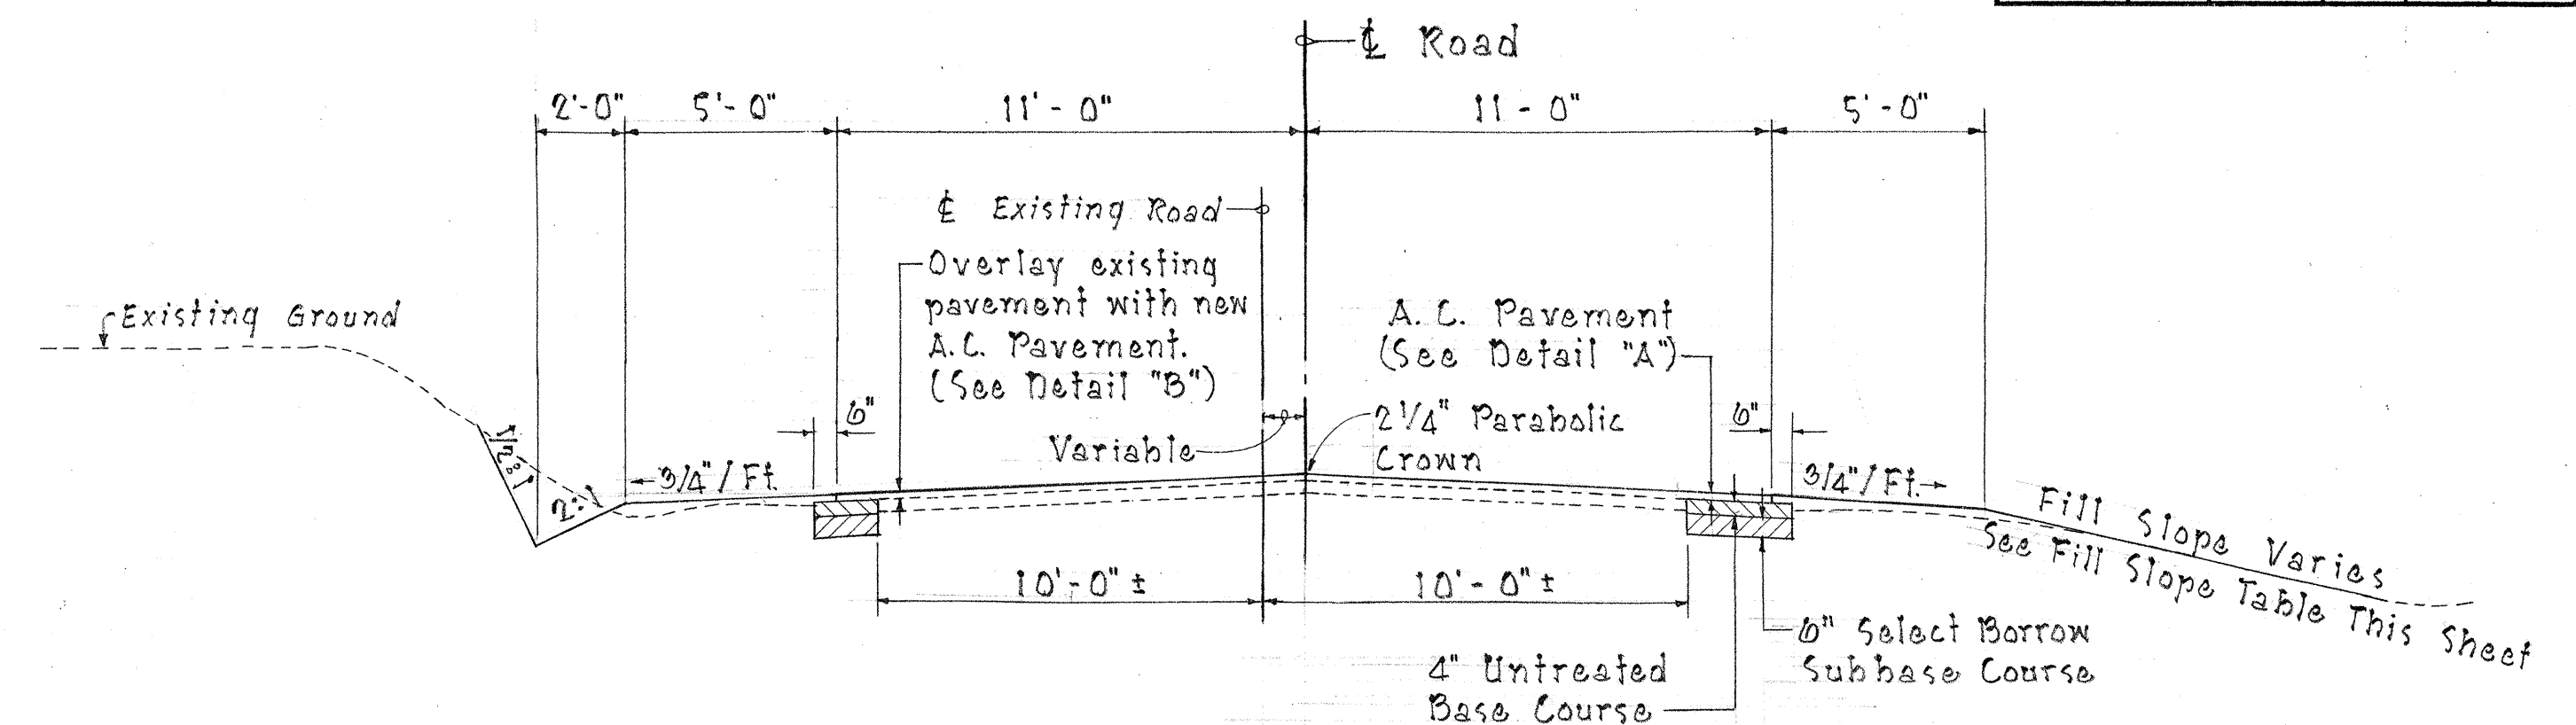

TYPICAL SECTION ON TANGENT

STA. 127 + 00 TO STA. 138 + 00
STA. 165 + 00 TO STA. 172 + 70.03
Scale: 1/4" = 1'-0"

NOTE
Existing surface varies.
Leveling of pockets to be done
prior to laying surface course.

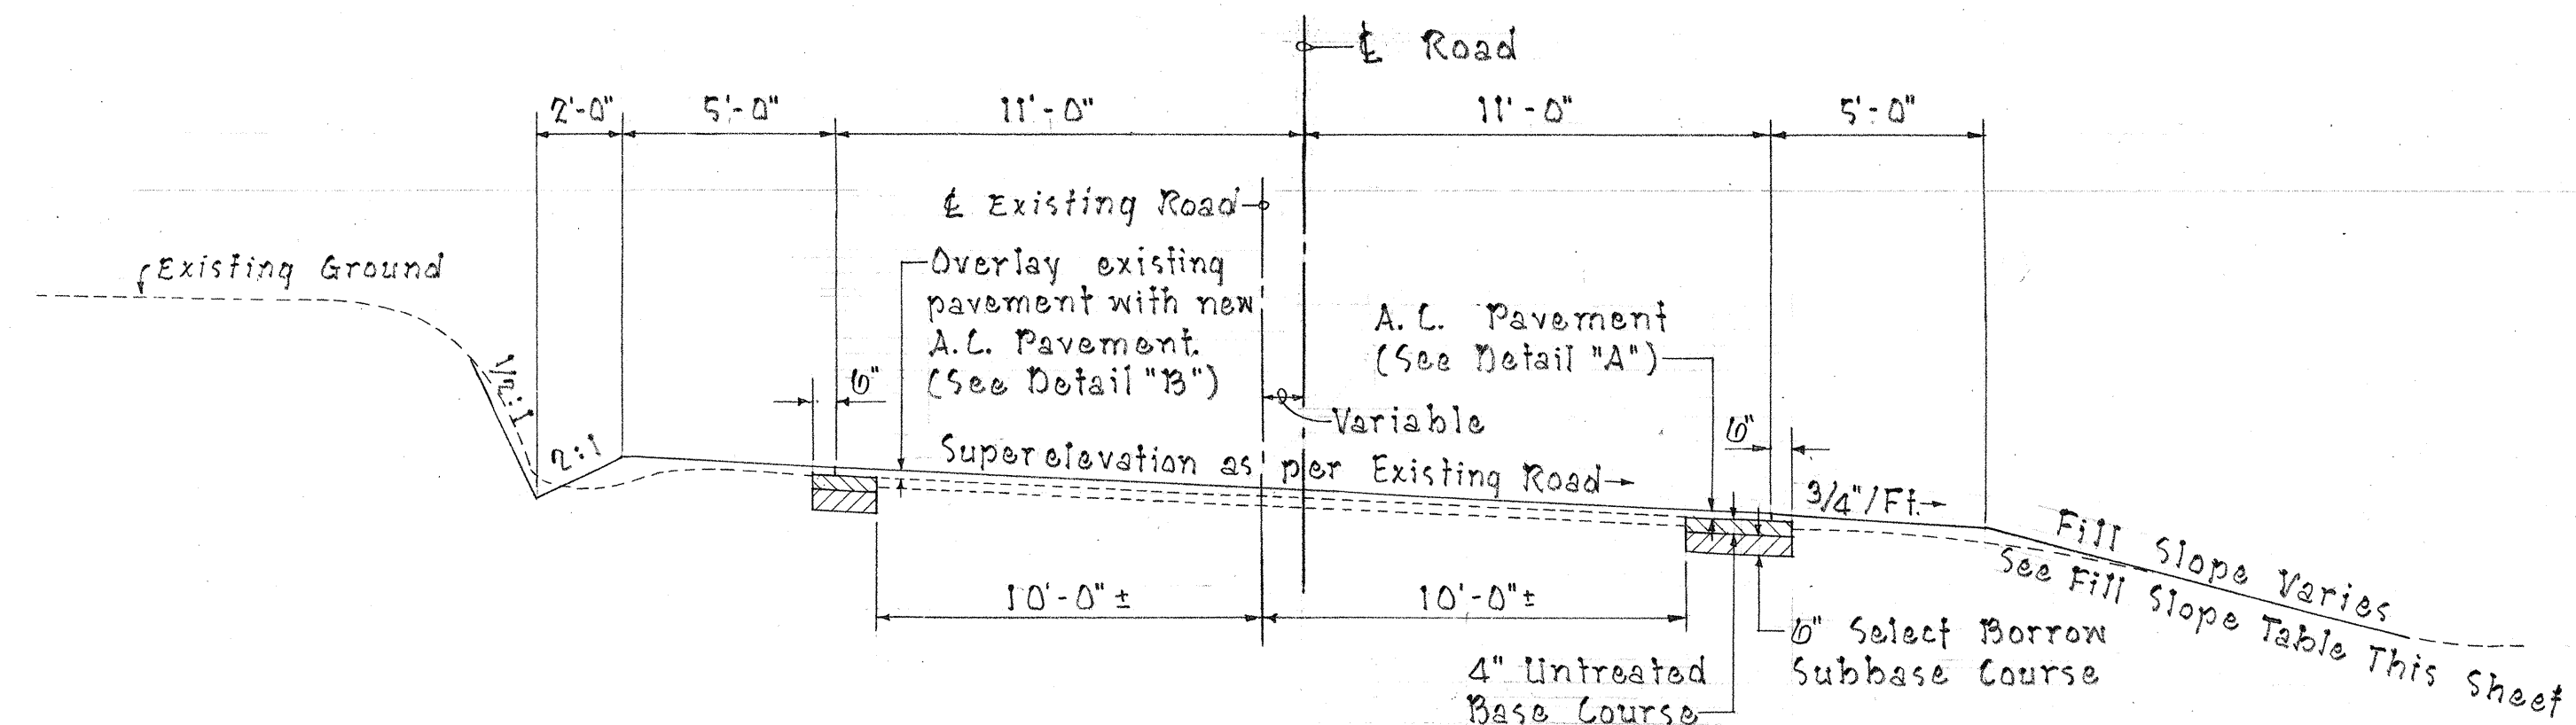

TYPICAL SECTION ON CURVE

STA. 127 + 00 TO STA. 138 + 00
STA. 165 + 00 TO STA. 172 + 70.03
Scale: 1/4" = 1'-0"

HEIGHT OF FILL	SLOPE
0' - 4'	4 : 1
4' - 6'	3 : 1
6' - 10'	2 : 1
10' and over	1 1/2 : 1

STATE OF HAWAII
DEPARTMENT OF TRANSPORTATION
HIGHWAYS DIVISION

TYPICAL SECTIONS

MALUHIA ROAD
PROJ. NO. A520-01-66 UNIT 3
KOLOA, KAUAI

Scale: As Shown Date: May 3, 1966

SHEET No. 1 OF 1 SHEETS

ORIGINAL PLAN	DATE
SURVEY PLOTTED BY	
DRAWN BY	
DESIGNED BY	
NOTED BY	
CHECKED BY	