


DIST. NO.	STATE	PROJ. NO.	FISCAL YEAR	SHEET NO.	TOTAL SHEETS
HAWAII	HAW.	G-3325-01-G3	1963	13	23

ESTIMATED QUANTITIES

Reservoir Exc. = 204 Cy. + 77cy. from Rdwy. Area
Reservoir Emb. = 725 cy.

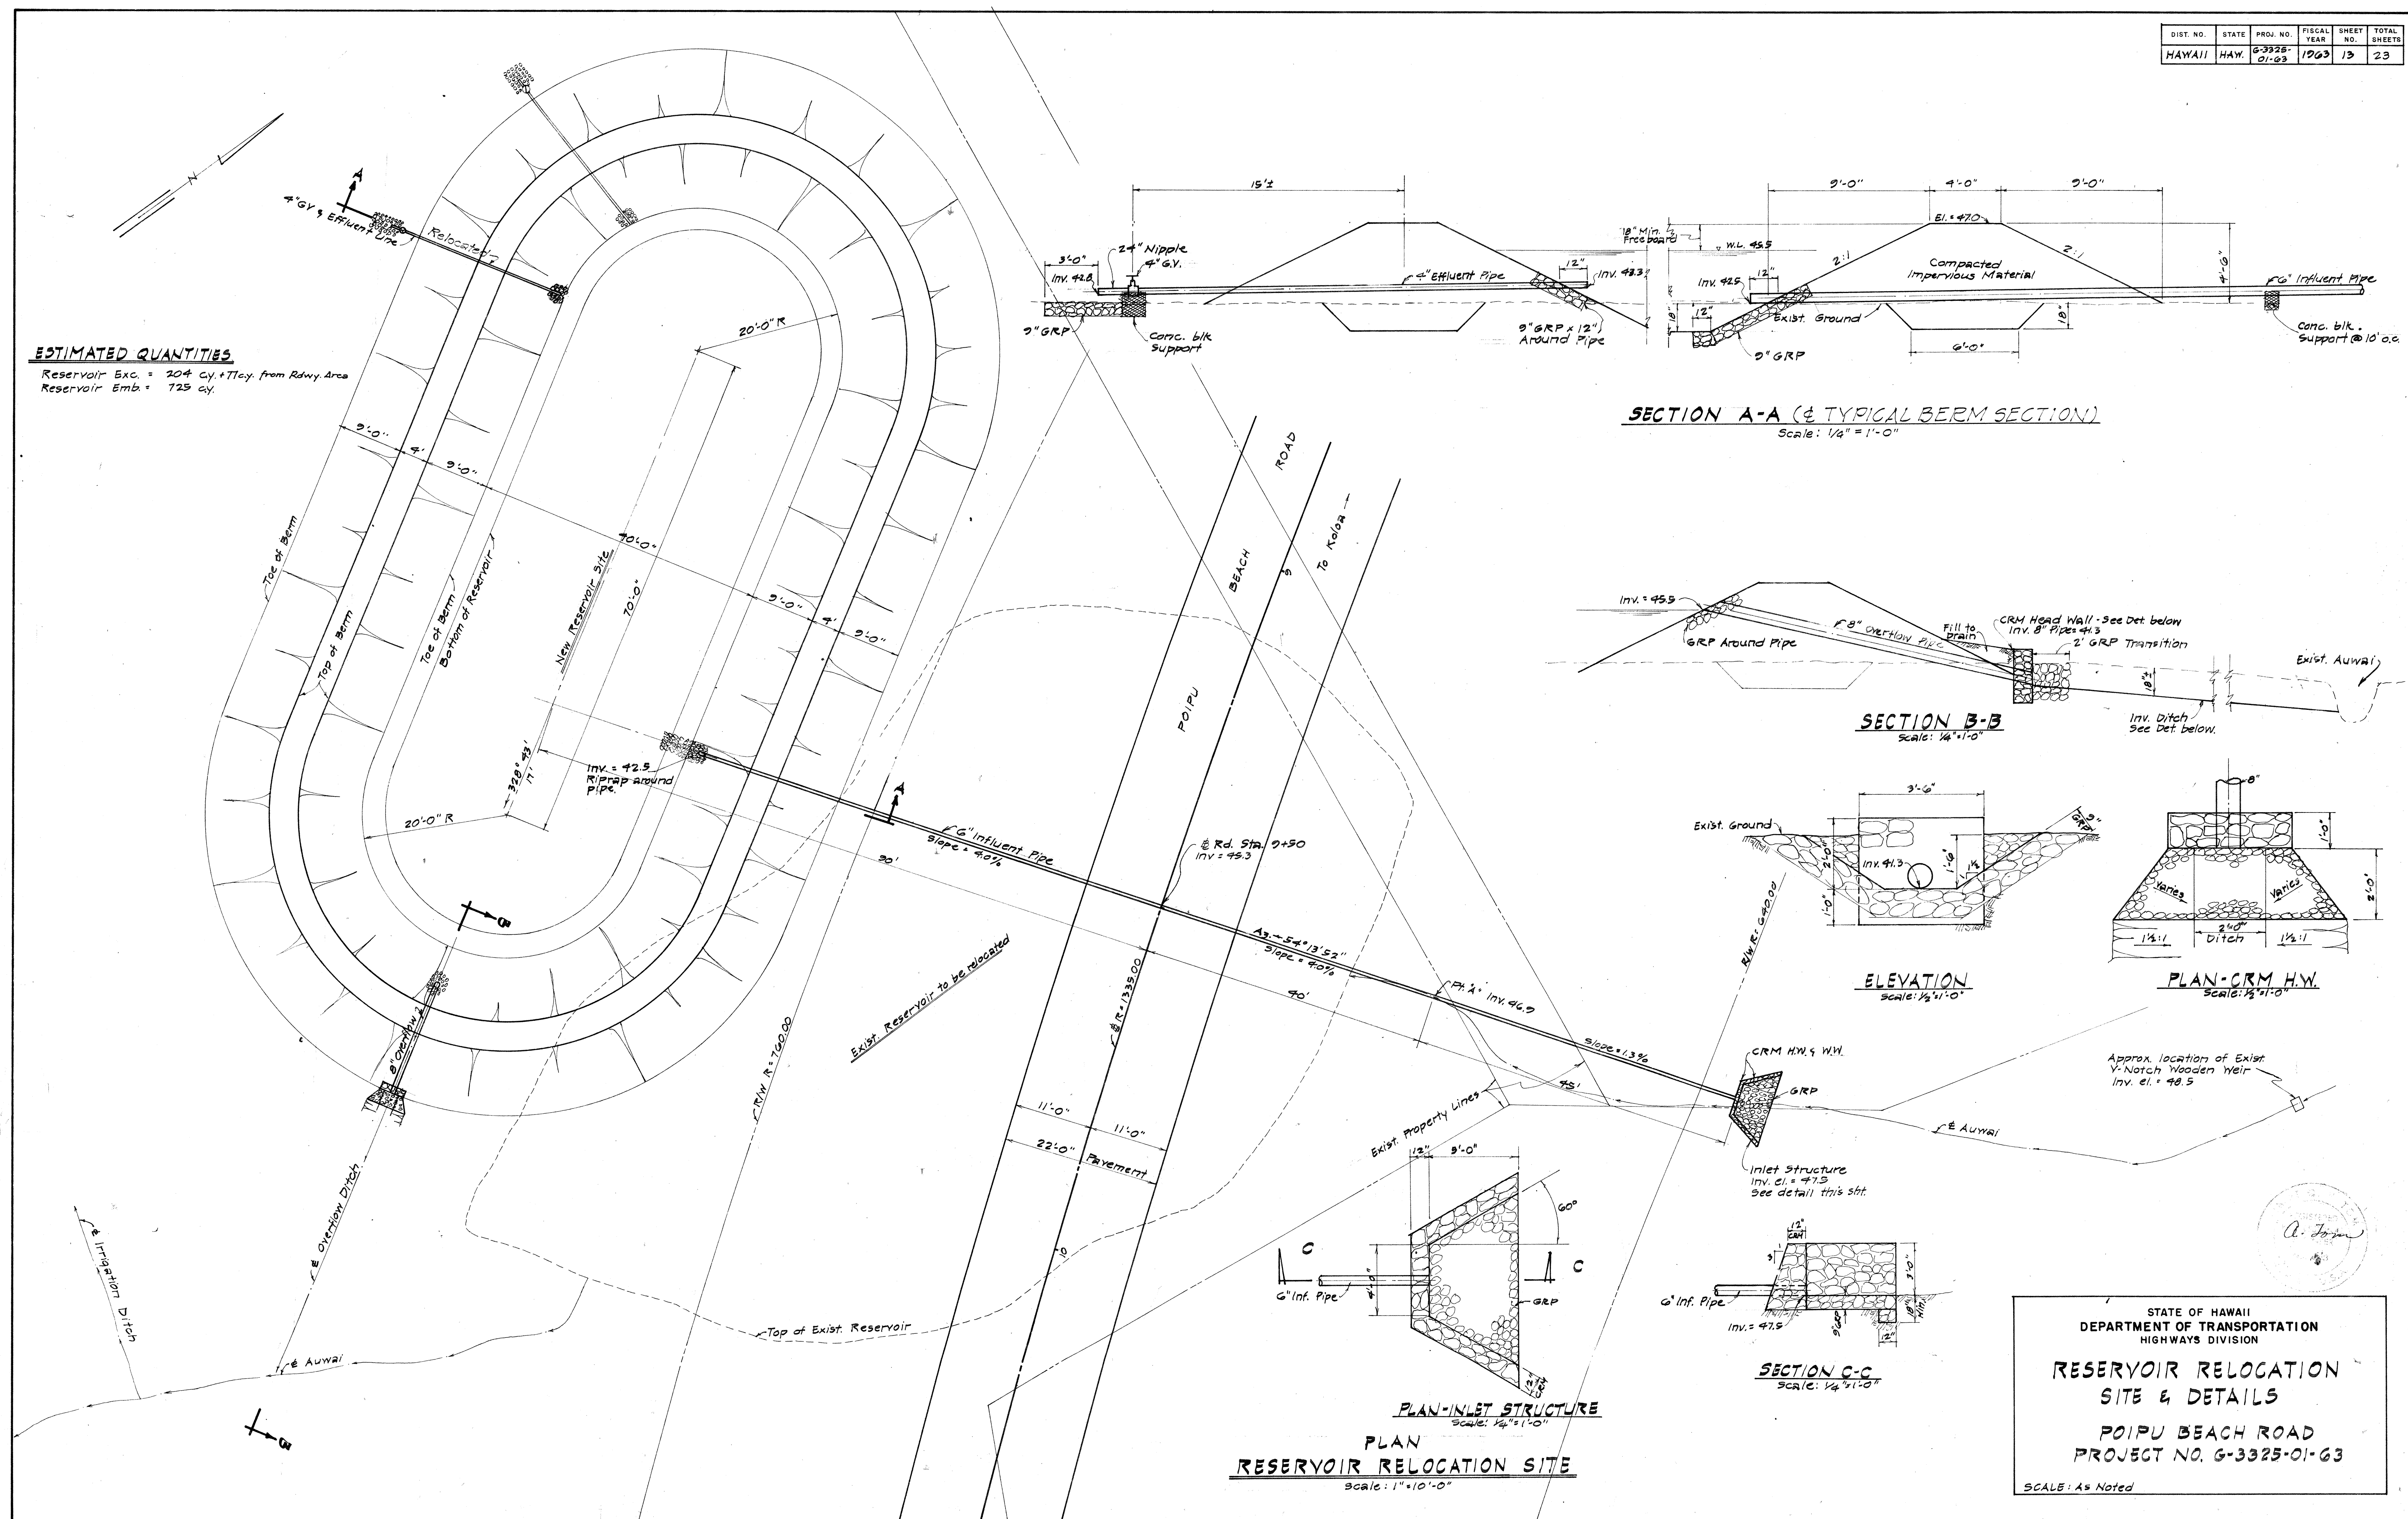

STATE OF HAWAII
DEPARTMENT OF TRANSPORTATION
HIGHWAYS DIVISION

**RESERVOIR RELOCATION
SITE & DETAILS**

POIPU BEACH ROAD
PROJECT NO. G-3325-01-G3

SCALE: As Noted