

INDEX TO DRAWINGS	
SHEET NO.	DESCRIPTION
1	TITLE SHEET
2	TYPICAL ROAD SECTIONS & MISCELL. DET.
3	BORING LOCATIONS & LOGS
4-9	PLAN & PROFILE SHEETS
10	INTERSECTION DETAILS
11	CORRUGATED METAL MULTI-PLATE ARCH CULVERT
12	CORRUGATED METAL PIPE CULVERT DETAILS
13	RESERVOIR RELOCATION SITE & DETAILS
14	FIRE HYDRANT DETAILS
15	METAL GUARDRAIL, ROAD DELINEATOR & A. C. TRAFFIC ROLL DETAILS
16-17	REGULATORY SIGNS (STD. HWY. SHT.)
18	WARNING SIGNS (STD. HWY. SHT.)
19-23	CROSS SECTIONS

STATE OF HAWAII

DEPARTMENT OF TRANSPORTATION

HIGHWAYS DIVISION

"AS BUILT"

PLANS OF



POIPU BEACH ROAD

PROJECT NO. G-3325-01-63

DISTRICT OF KOLOA

ISLAND OF KAUAI

SCALES	
PLAN	1" = 50 FT.
PROFILE	HOR. 1" = 50 FT.
	VERT. 1" = 10 FT.
CROSS SECTION	HOR. 1" = 10 FT.
	VERT. 1" = 10 FT.

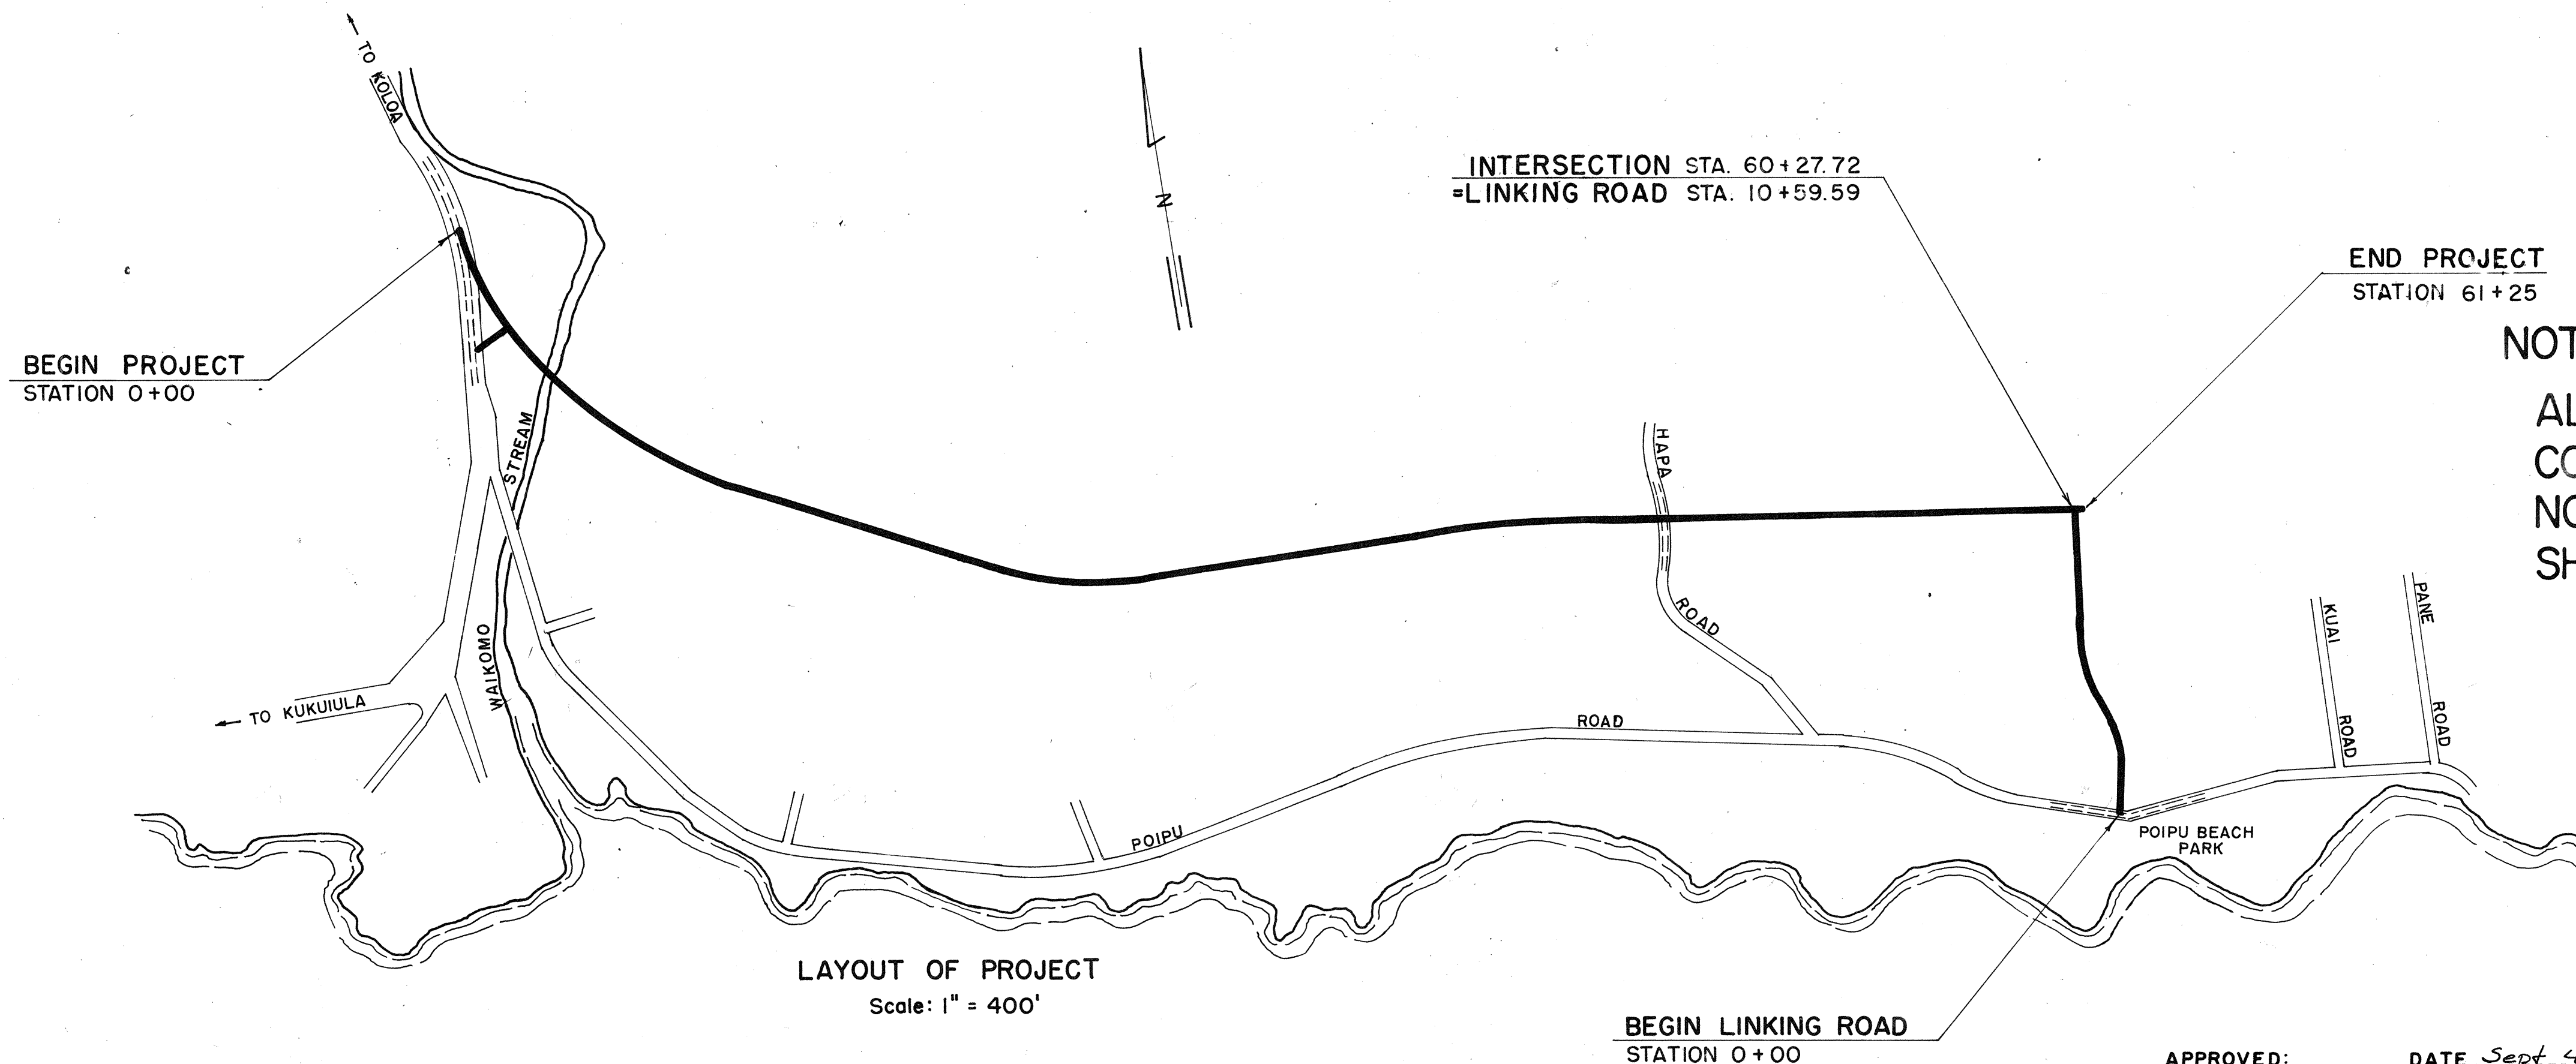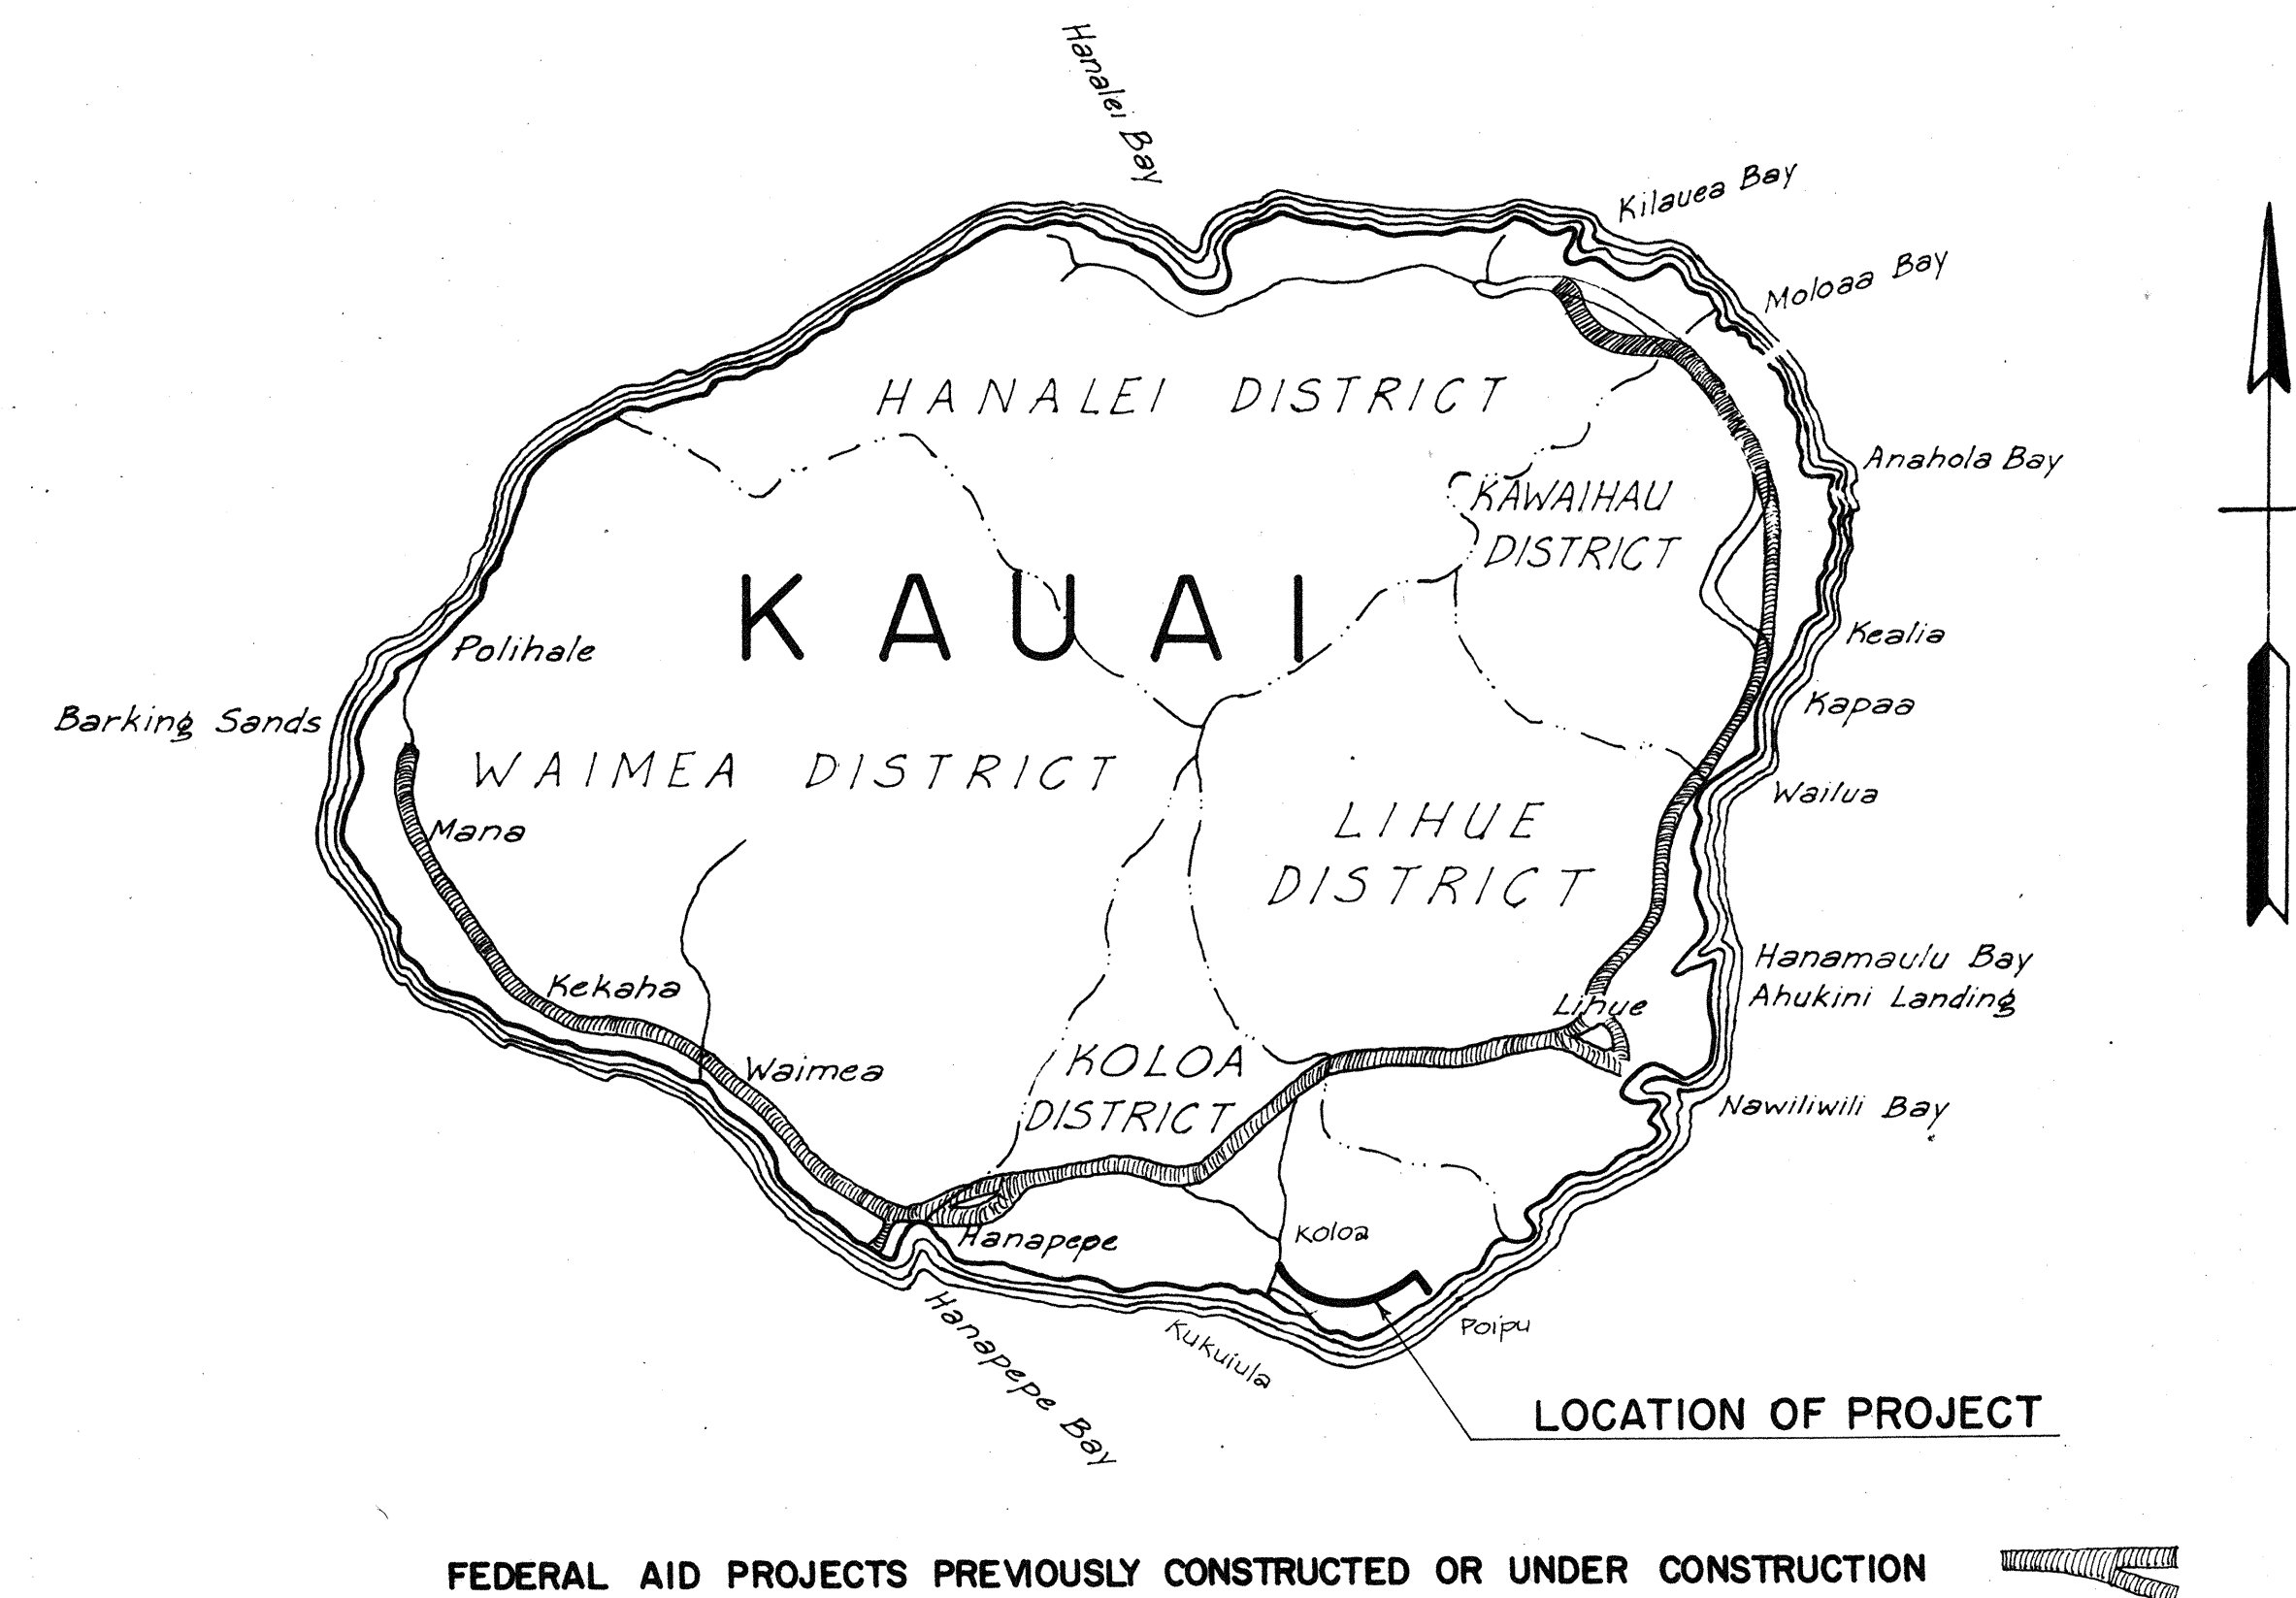

DESIGN CLASSIFICATION	
A. D. T. (1962)	= 500
A. D. T. (1982)	= 1700
D. H. V.	= 10%
D.	= 60/40
T.	= 2%
V.	= 50 MPH
30 MPH FOR LINKING RD	

LAYOUT OF PROJECT	
Scale: 1" = 400'	
Length of Main Highway	= 1.160 Miles
Length of Linking Road	= 0.201 Miles
Total Length	= 1.361 Miles

NOTE:
ALL CHANGES MADE DURING CONSTRUCTION HAVE BEEN NOTED IN RED ON THESE SHEETS AND CHECKED BY.

Robert A. Mui
PROJECT ENGINEER

10 Nov 67
DATE
Plans Prepared By:
SUNN, LOW, TOM & HARA, INC.
CONSULTING ENGINEERS

APPROVED: *Luis Waterson*
DIRECTOR, DEPARTMENT OF TRANSPORTATION

A. Q. J. Jann
OFFICER

6/17/63
DATE

G 3325 01 63.1