

PLAN
DATE: 10/1/59
BY: [illegible]
CHECKED: [illegible]
APPROVED: [illegible]

Revision: Grade & Line Change 7/19/59

PROFILE
DATE: 10/1/59
BY: [illegible]
CHECKED: [illegible]
APPROVED: [illegible]

F.A. MARKER
F.A. 3
5A.

B.M. El. 221.61
+ on conc. post of
baseball backstop.


LIST OF COMMON ABBREVIATIONS

C.R.M. Cement Rubble Masonry
D.R.M. Dry Rubble Masonry
Circ. Conc. Culv't. Circular Concrete Culvert which is either
(a) Cast-in-place Circular Concrete Culvert, or
(b) Concrete Pipe Culvert.
Box Culv't. Various Reinf. Concrete box culverts as detailed.
Std. Reinf. Conc. Pipe Standard Reinforced Concrete Pipe
C.D.I. Concrete Drop Intake
C.H.W. Concrete Headwall


EQUATION
Minus 2.29

True North
Scale 1"=100'

FED. ROAD DIST. NO.	STATE	FED. AID PROJ. NO.	FISCAL YEAR	SHEET NO.	TOTAL SHEETS
HAWAII	HAW	223-54(1)	1959	3A	25

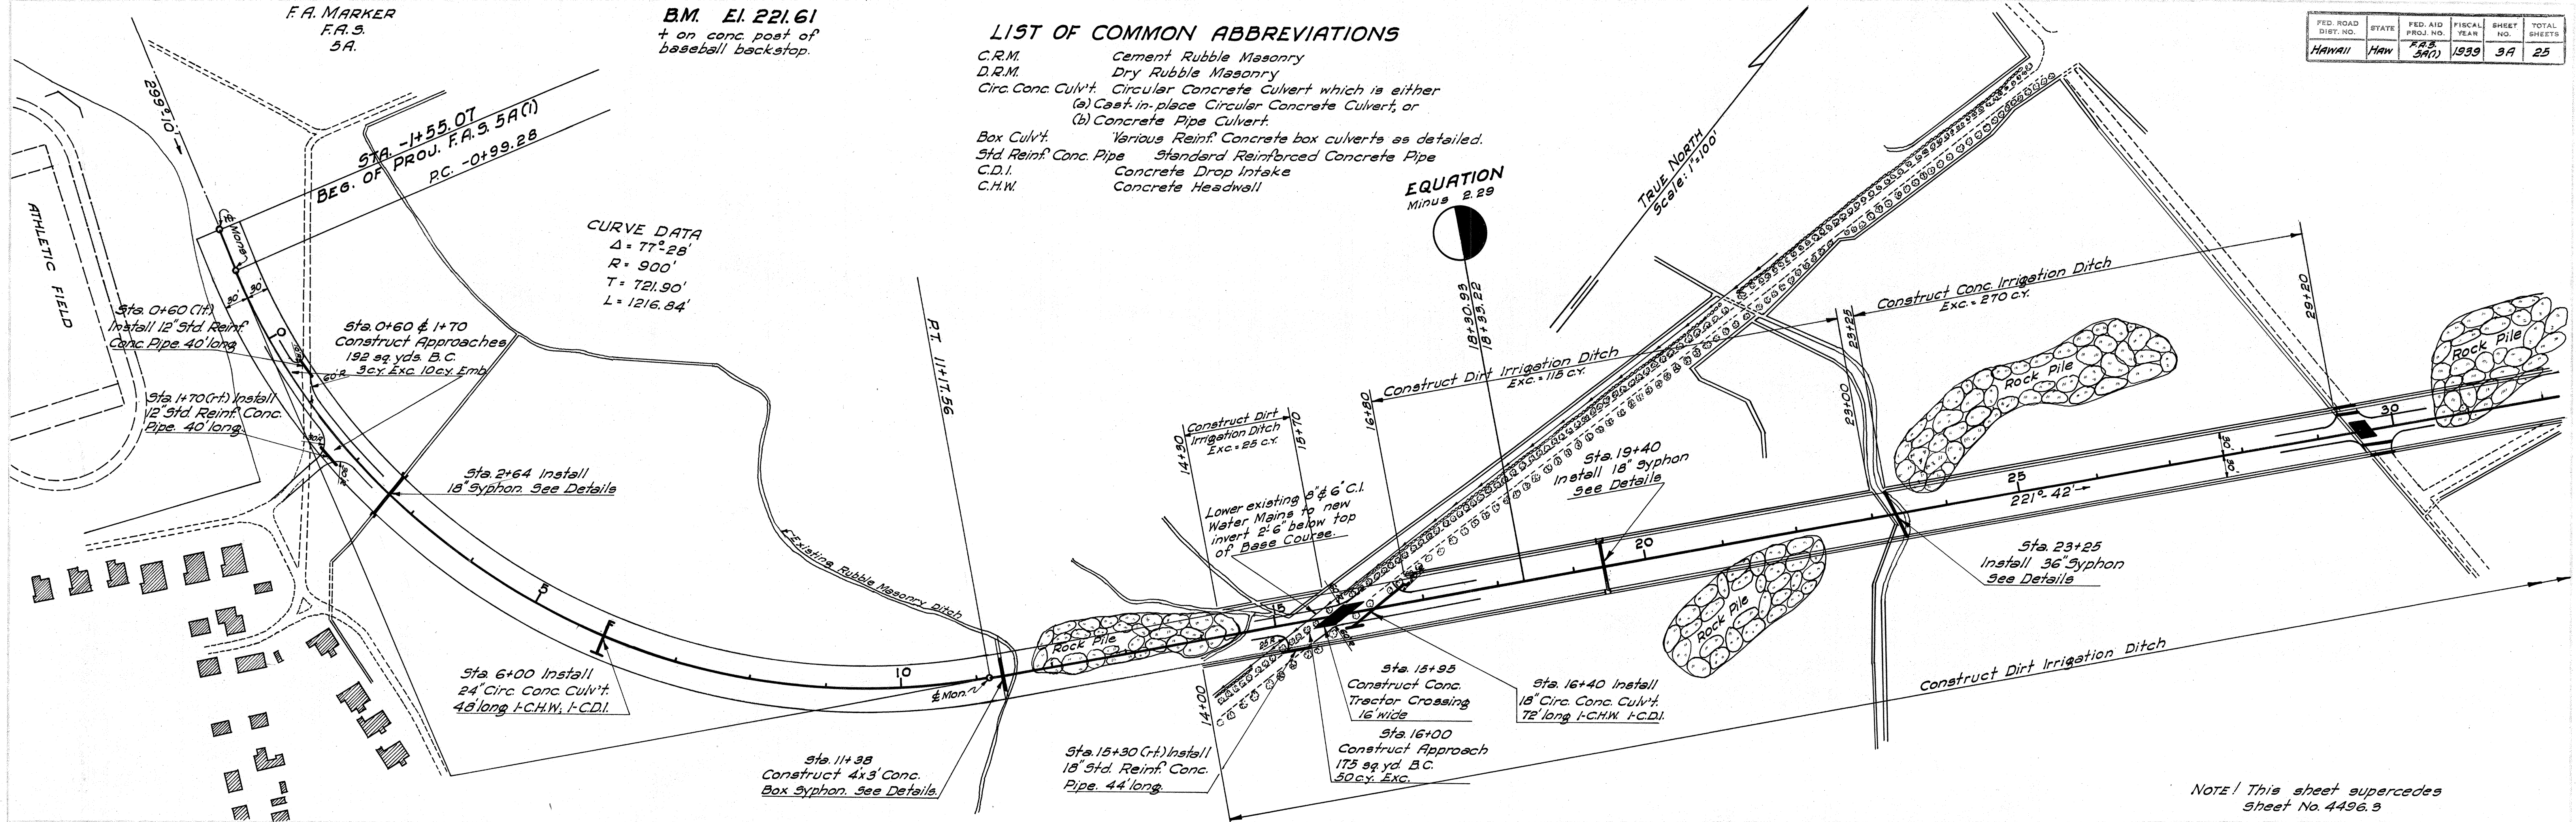

NOTE: This sheet supercedes sheet No. 4496.3

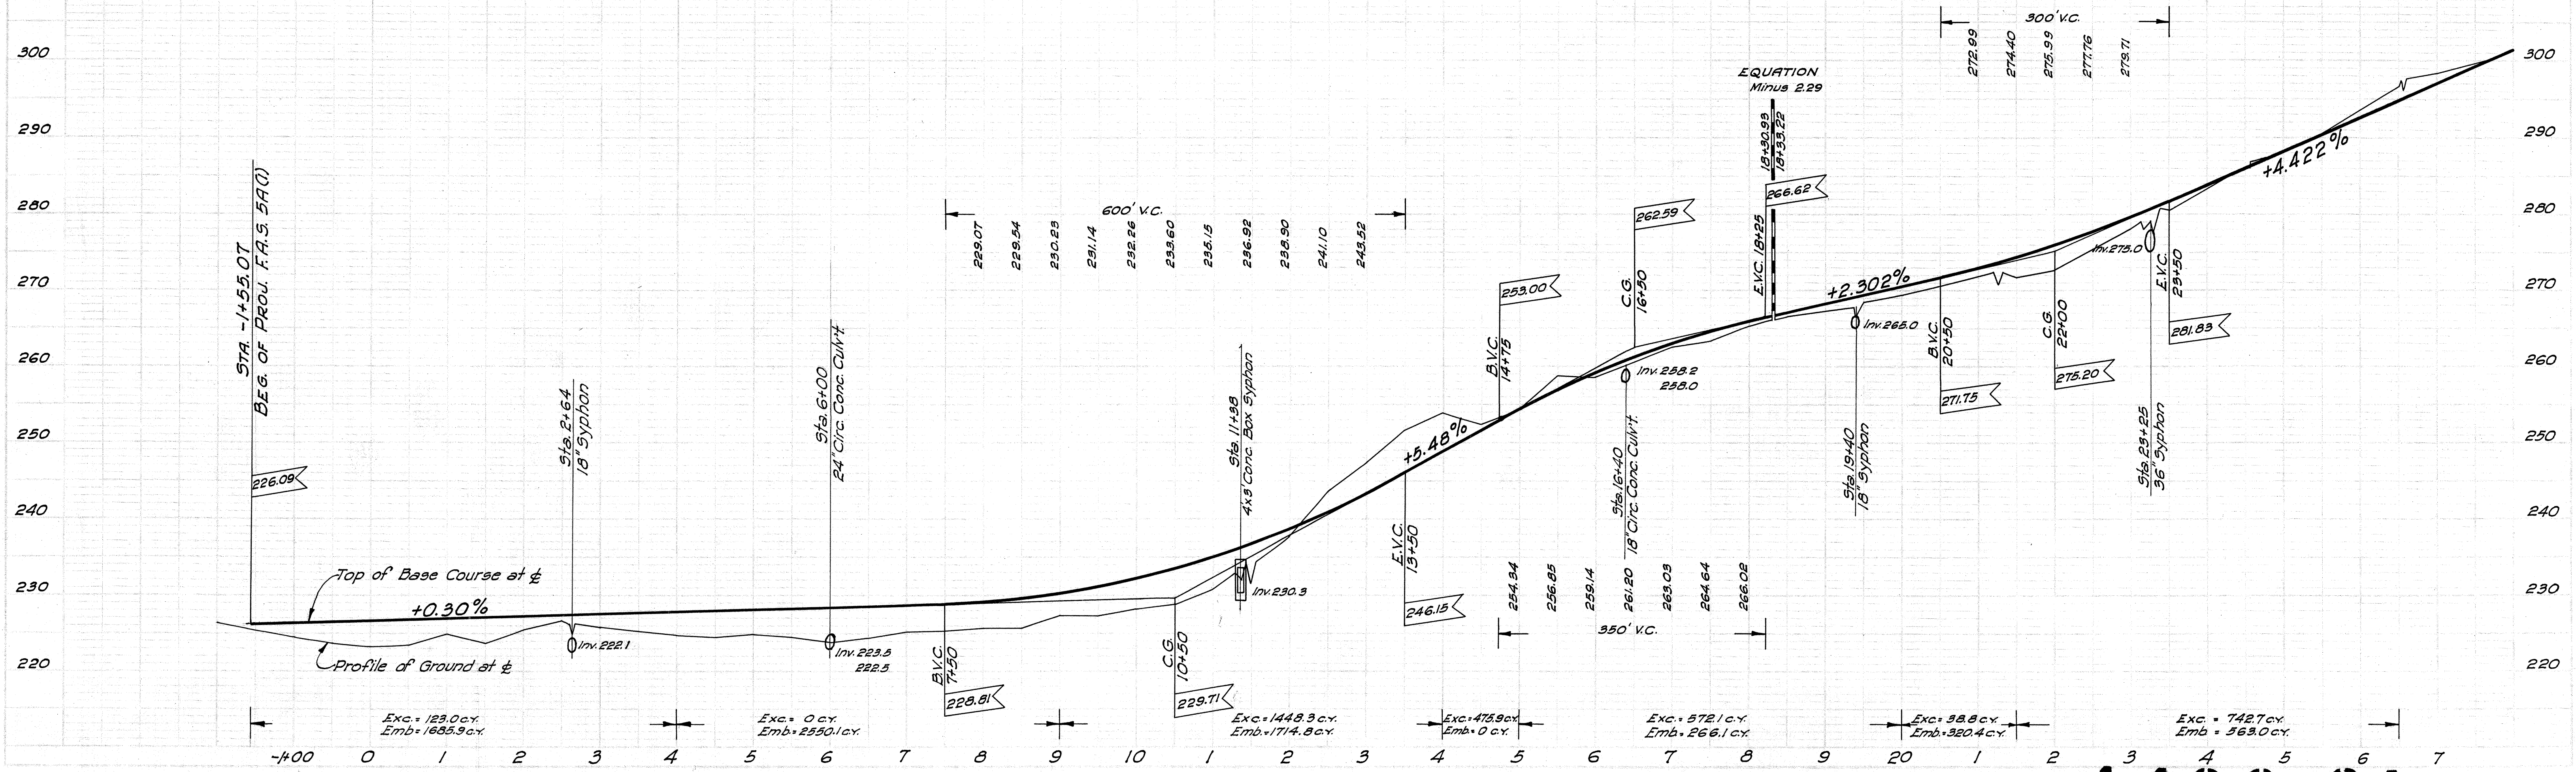



4496.3A

BDN-4



PLAN
DATE
BY
CHECKED
NOTED
APPROVED

Revised Dec. 5, 1939.
Curve at beginning of project
changed.

PROFILE
DATE
BY
CHECKED
NOTED
APPROVED

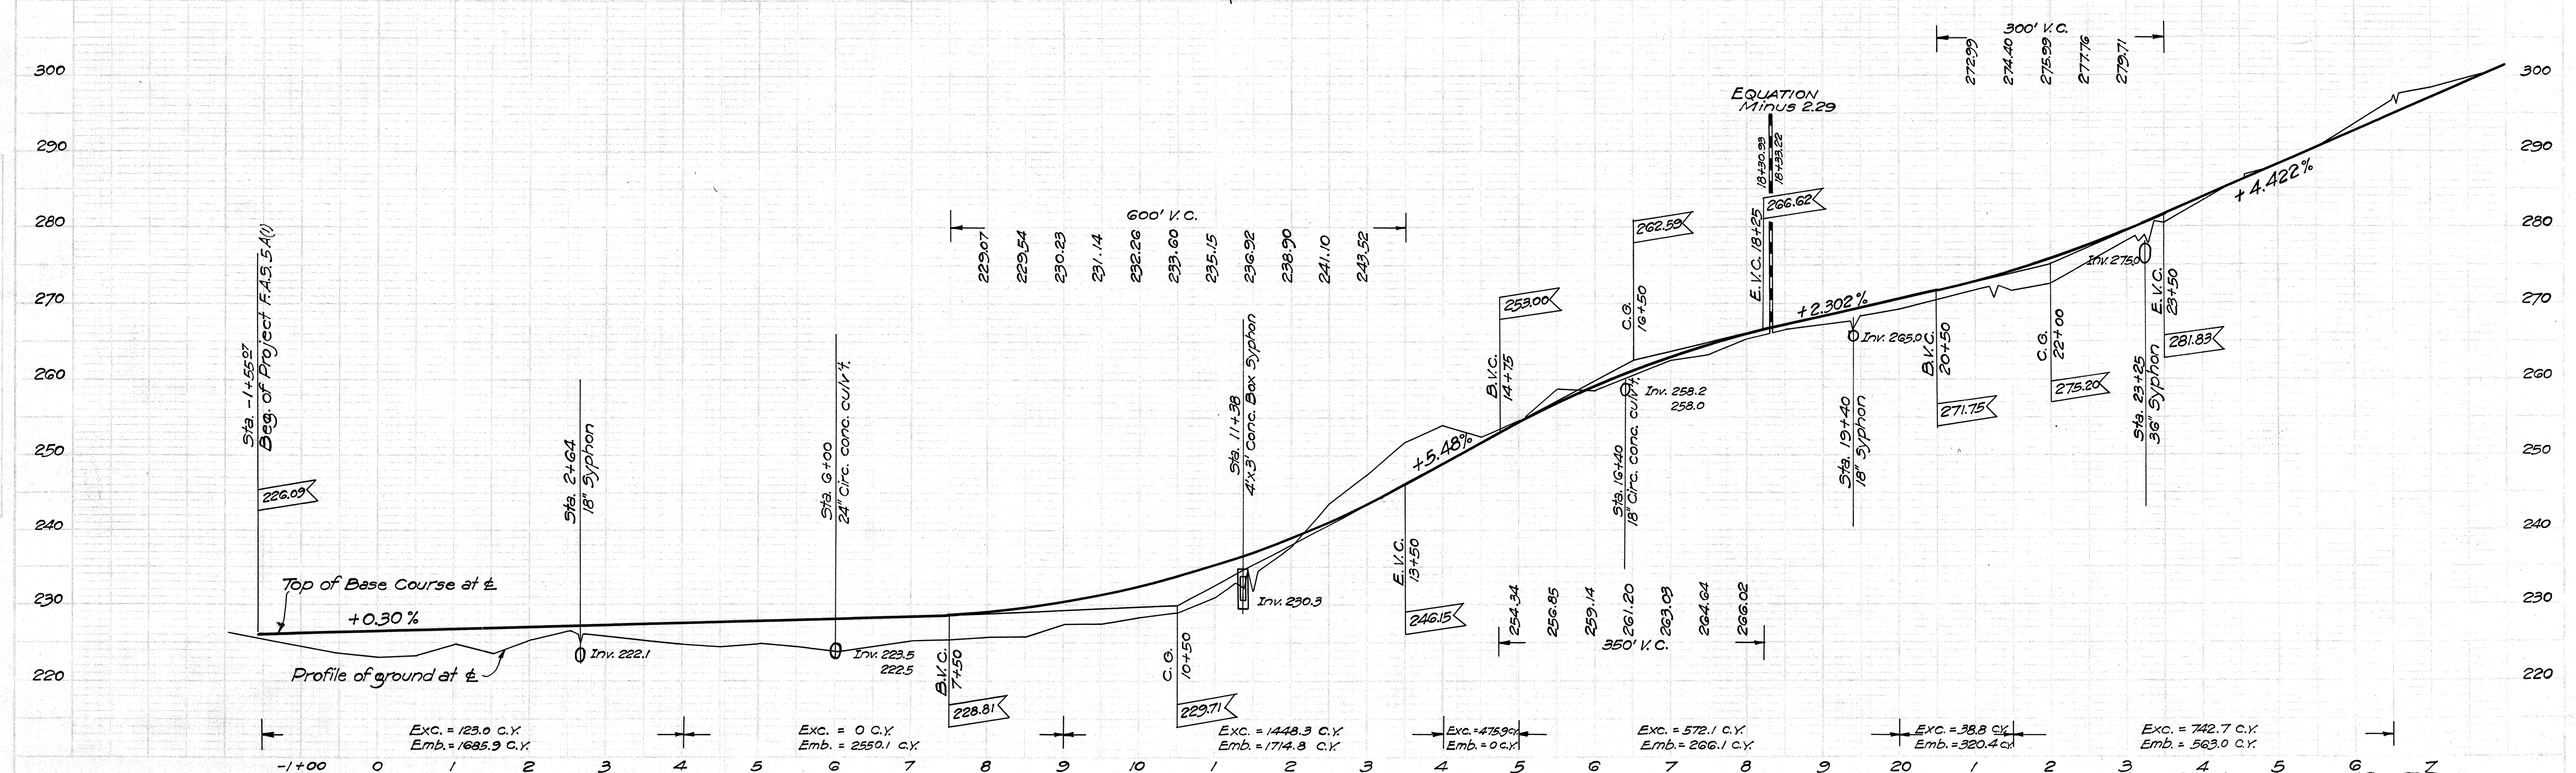
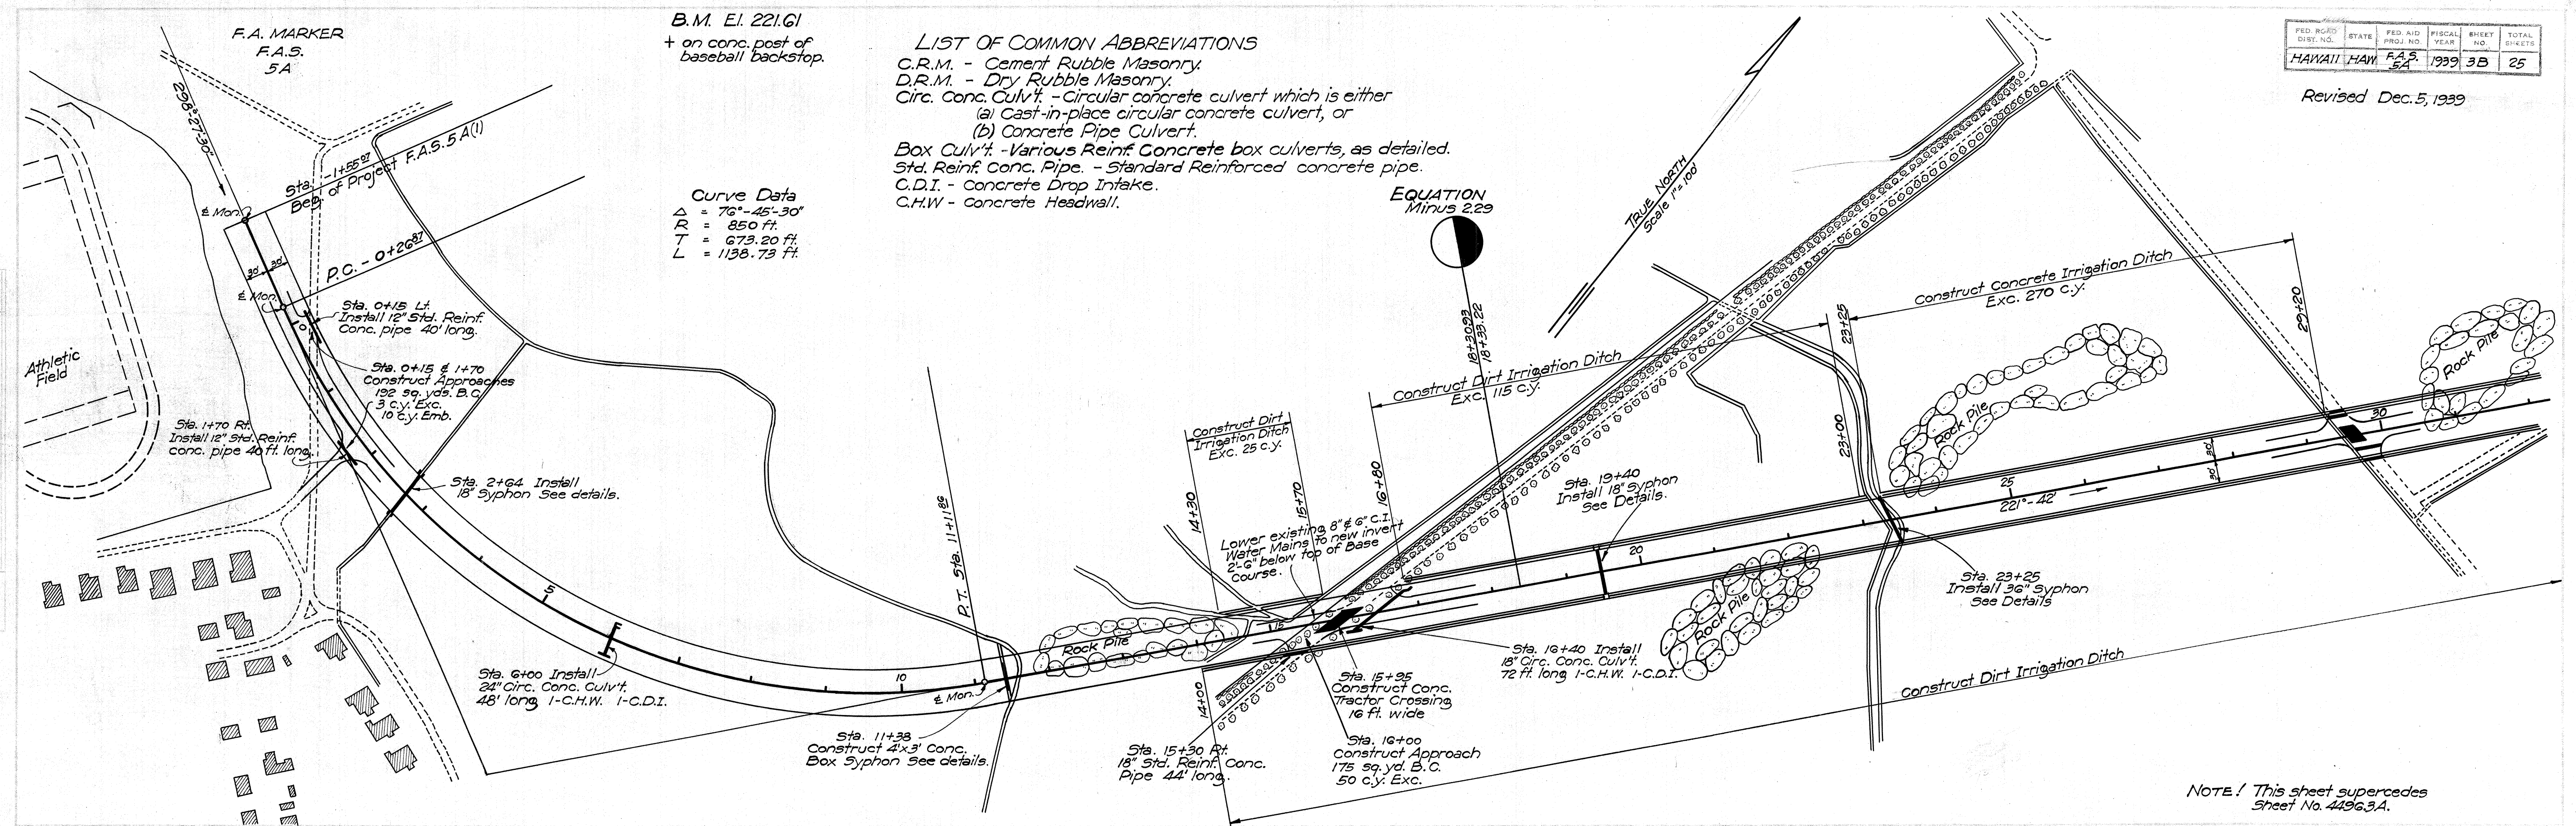


FED. ROAD DIST. NO.	STATE	FED. AID PROJ. NO.	FISCAL YEAR	SHEET NO.	TOTAL SHEETS
HAWAII	HAW	FA95A(1)	1959	4	25

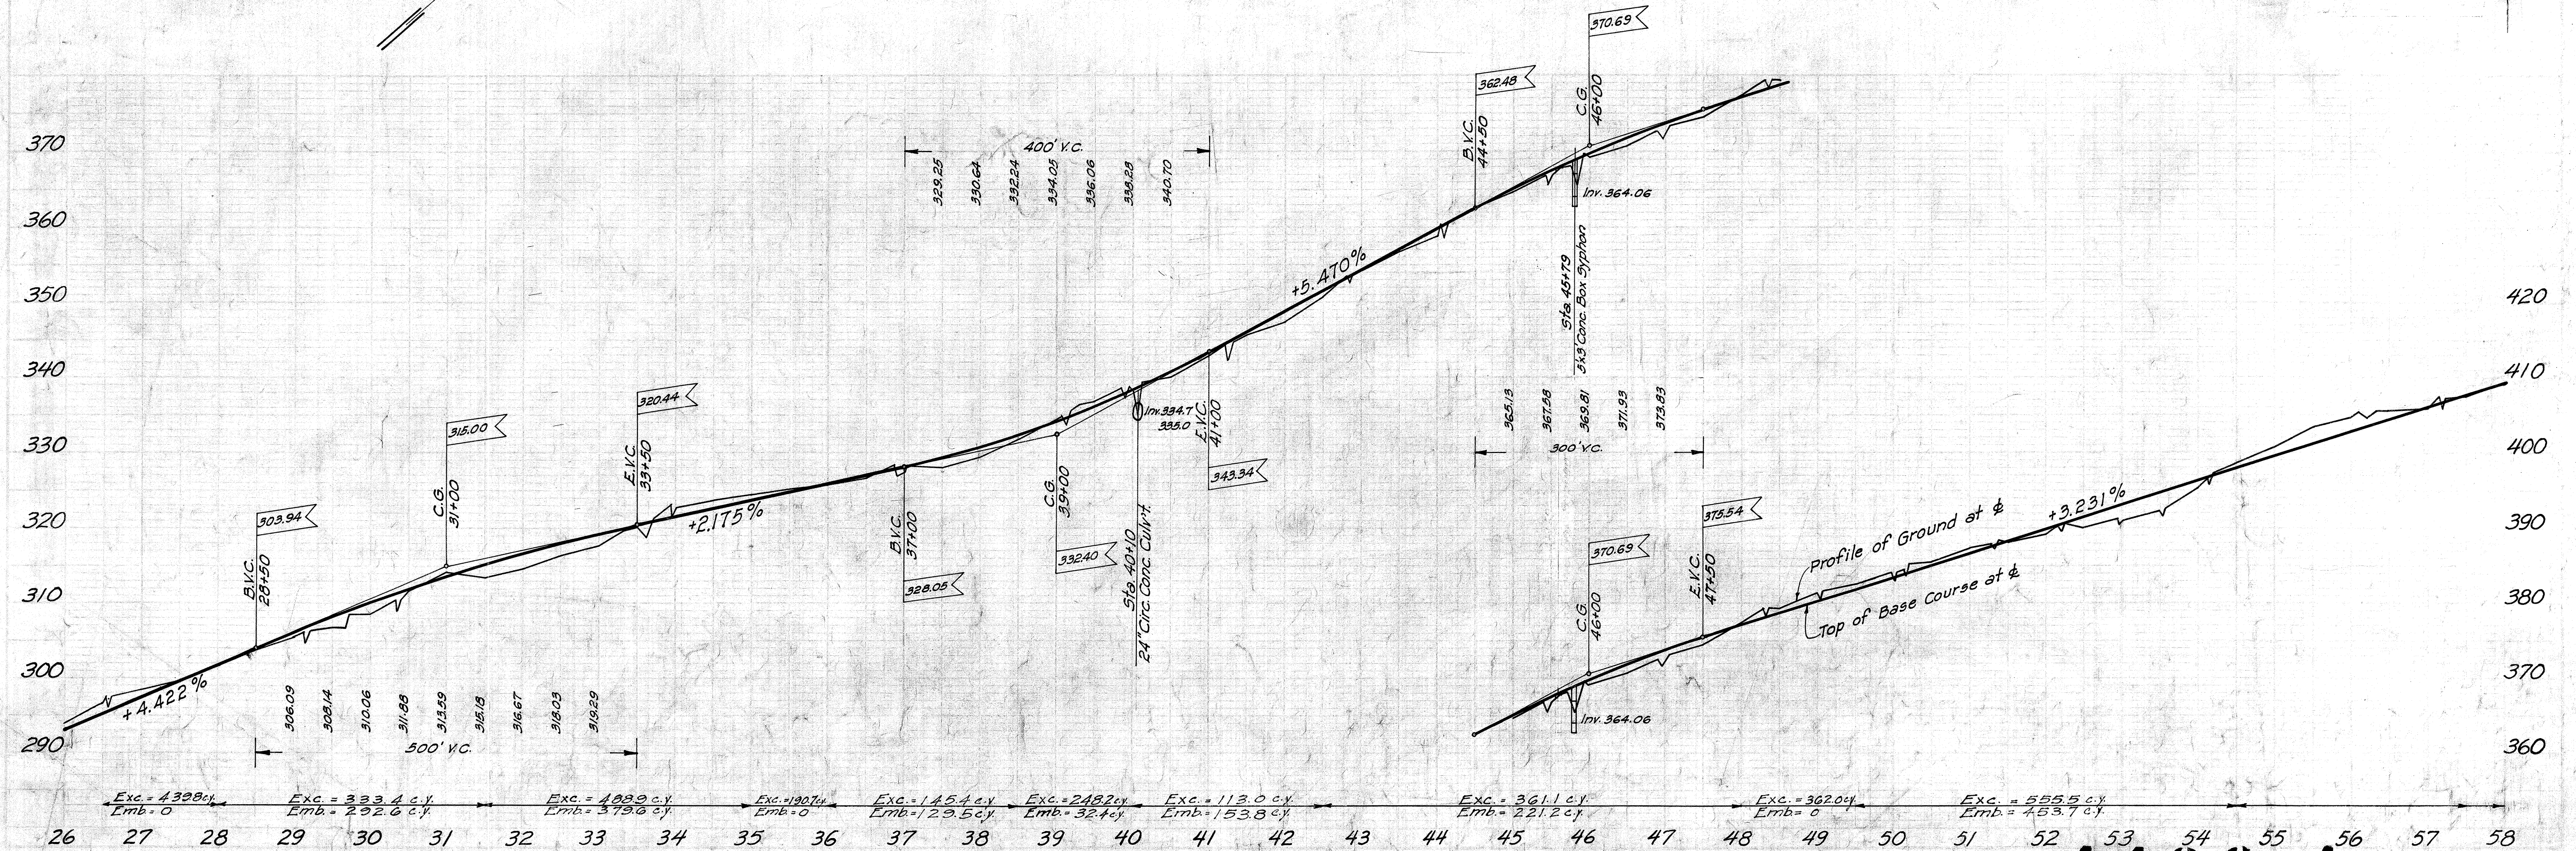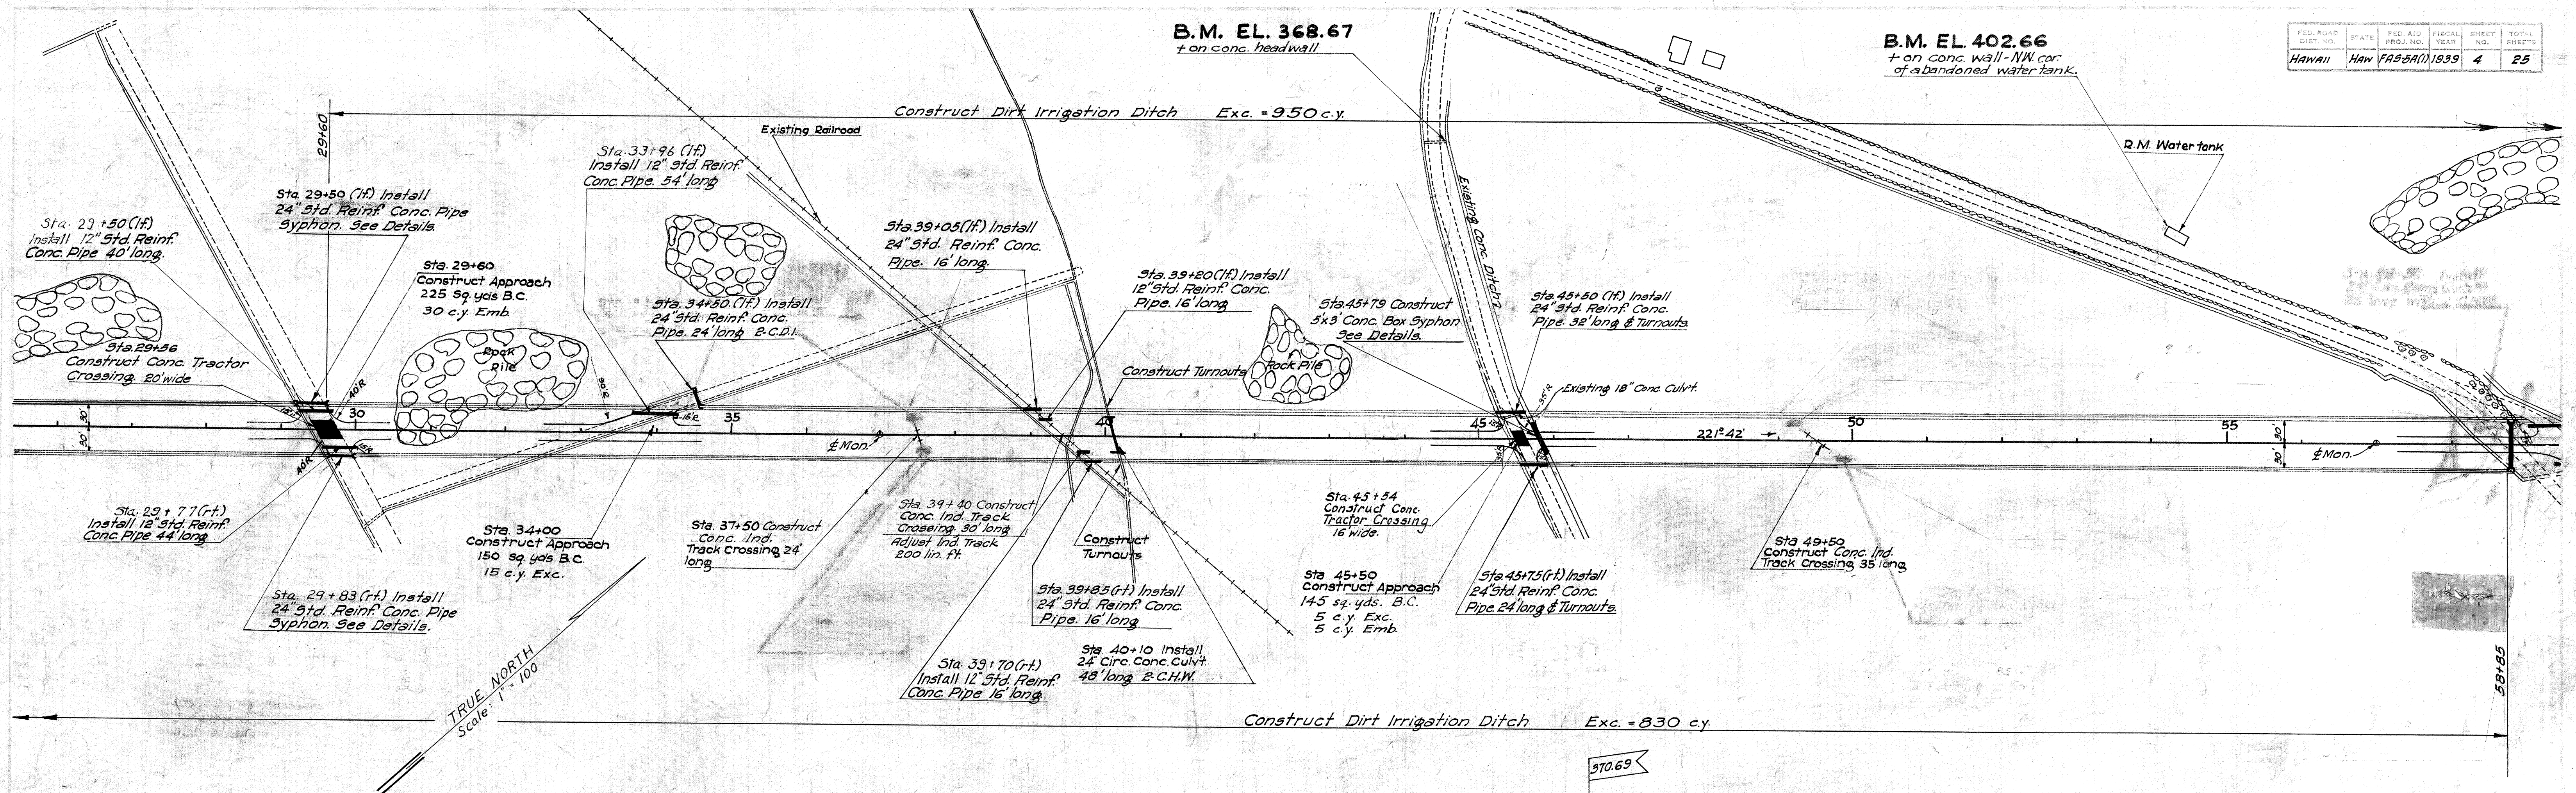



4496.4

FED. ROAD DIST. NO.	STATE	PROJECT NO.	FISCAL YEAR	SHEET NO.	TOTAL SHEETS
HAWAII	HAW	FA-56A(1)	1939	5	25

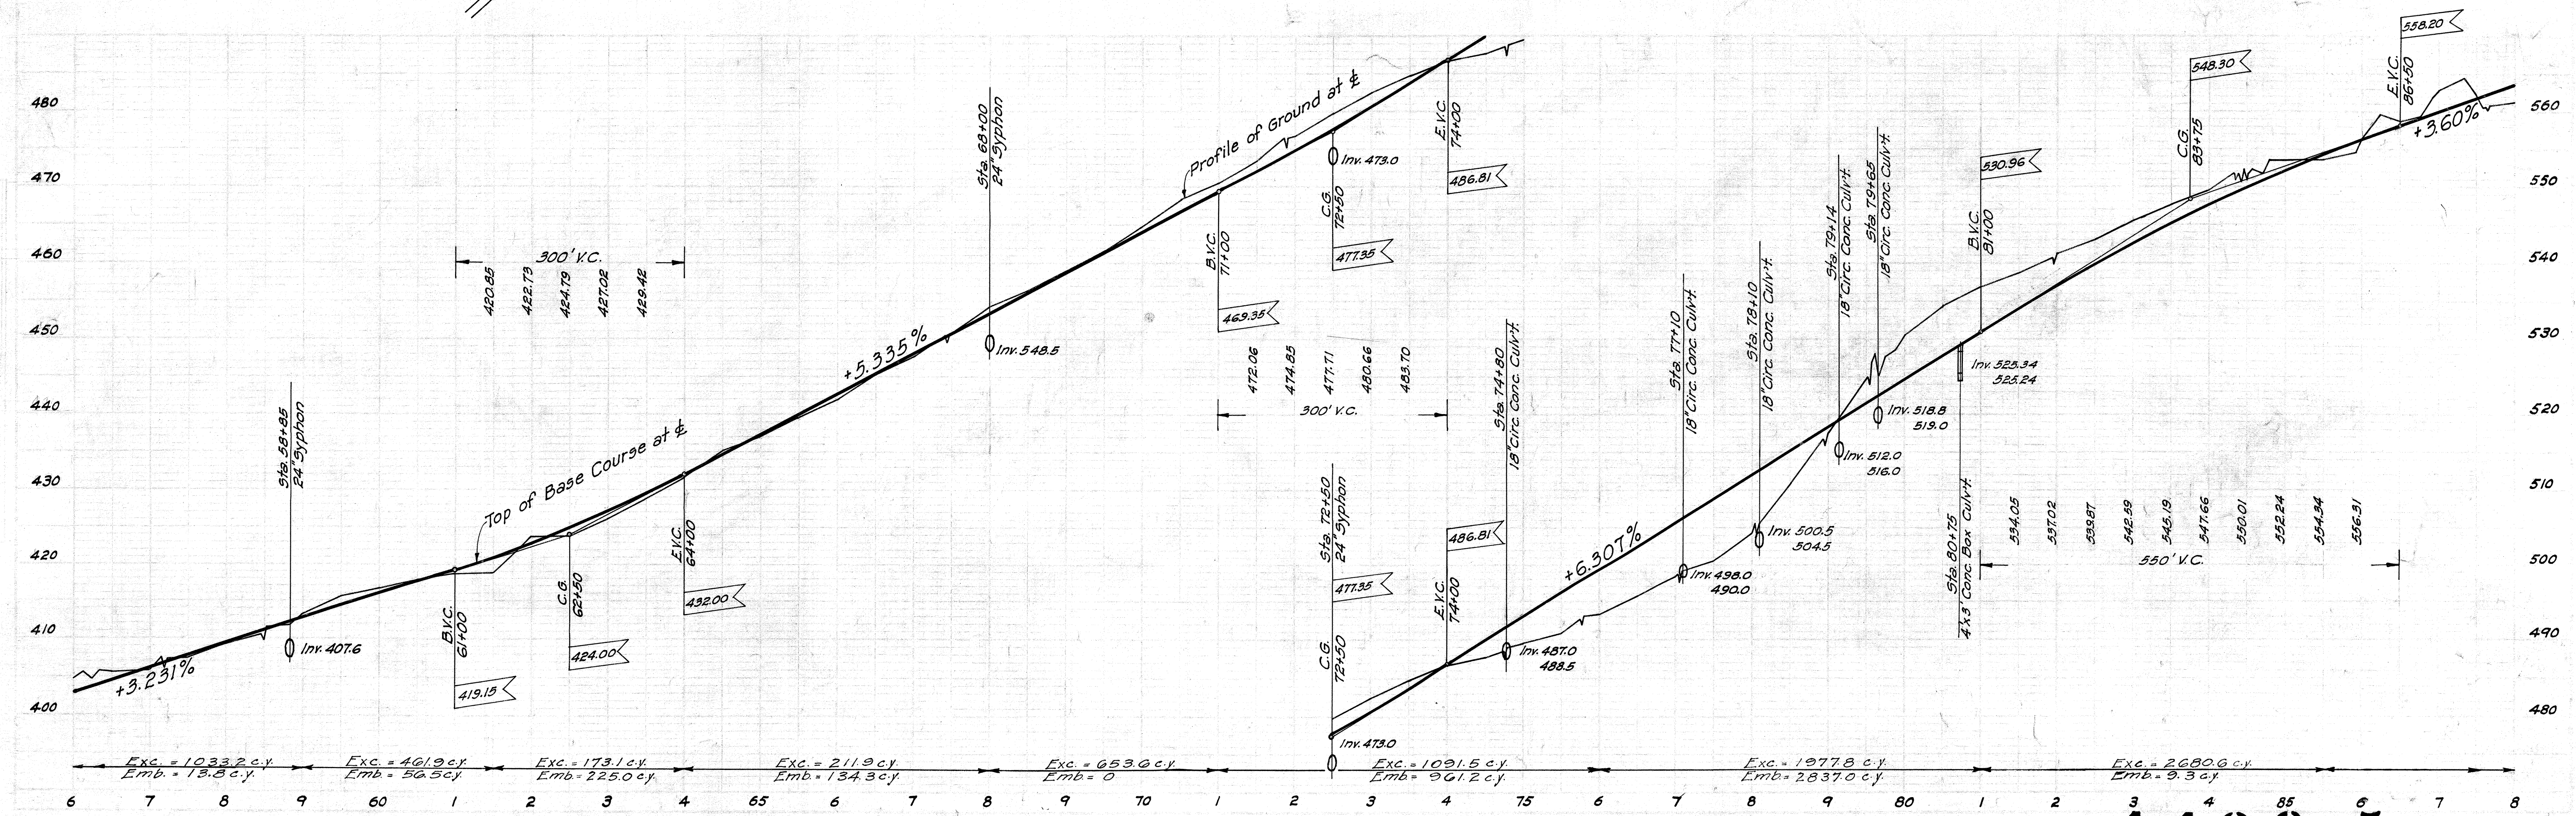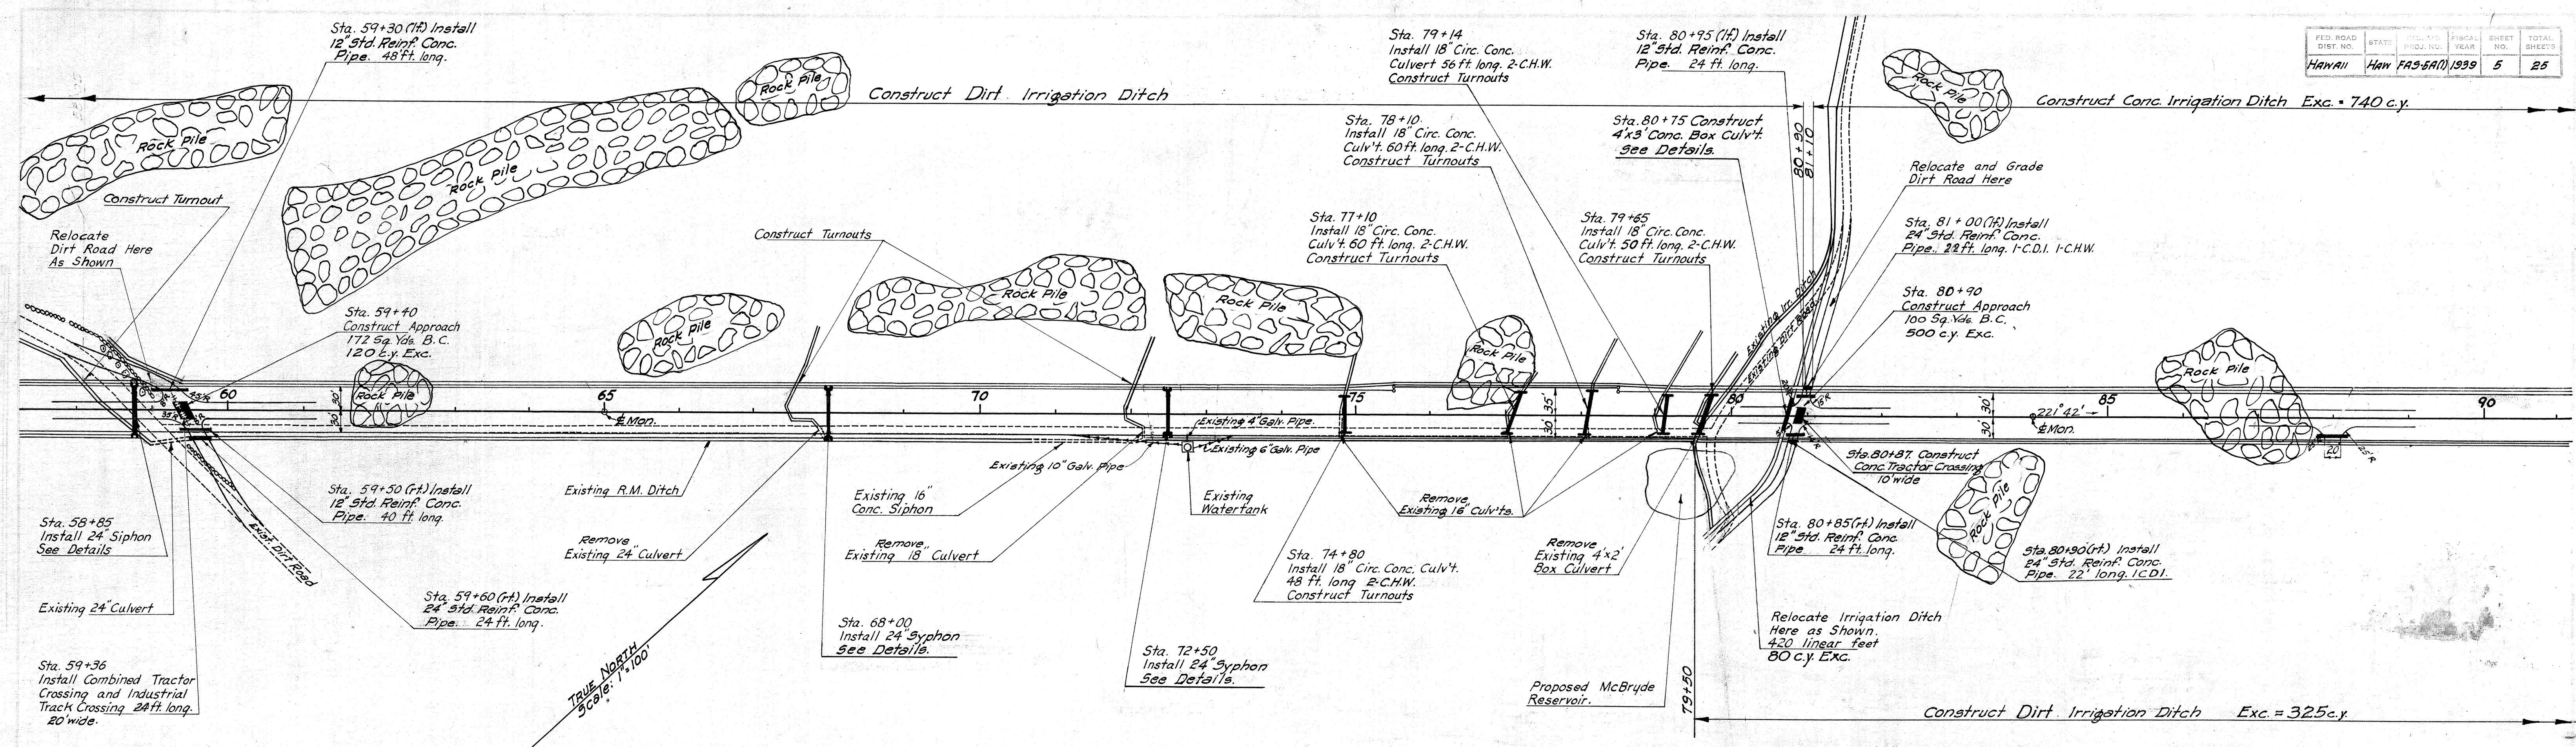

4496.5

FED. ROAD DIST. NO.	STATE	FED. AID PROJ. NO.	FISCAL YEAR	SHEET NO.	TOTAL SHEETS
HAWAII	HAW.	FA-5A(1)	1939	7	25

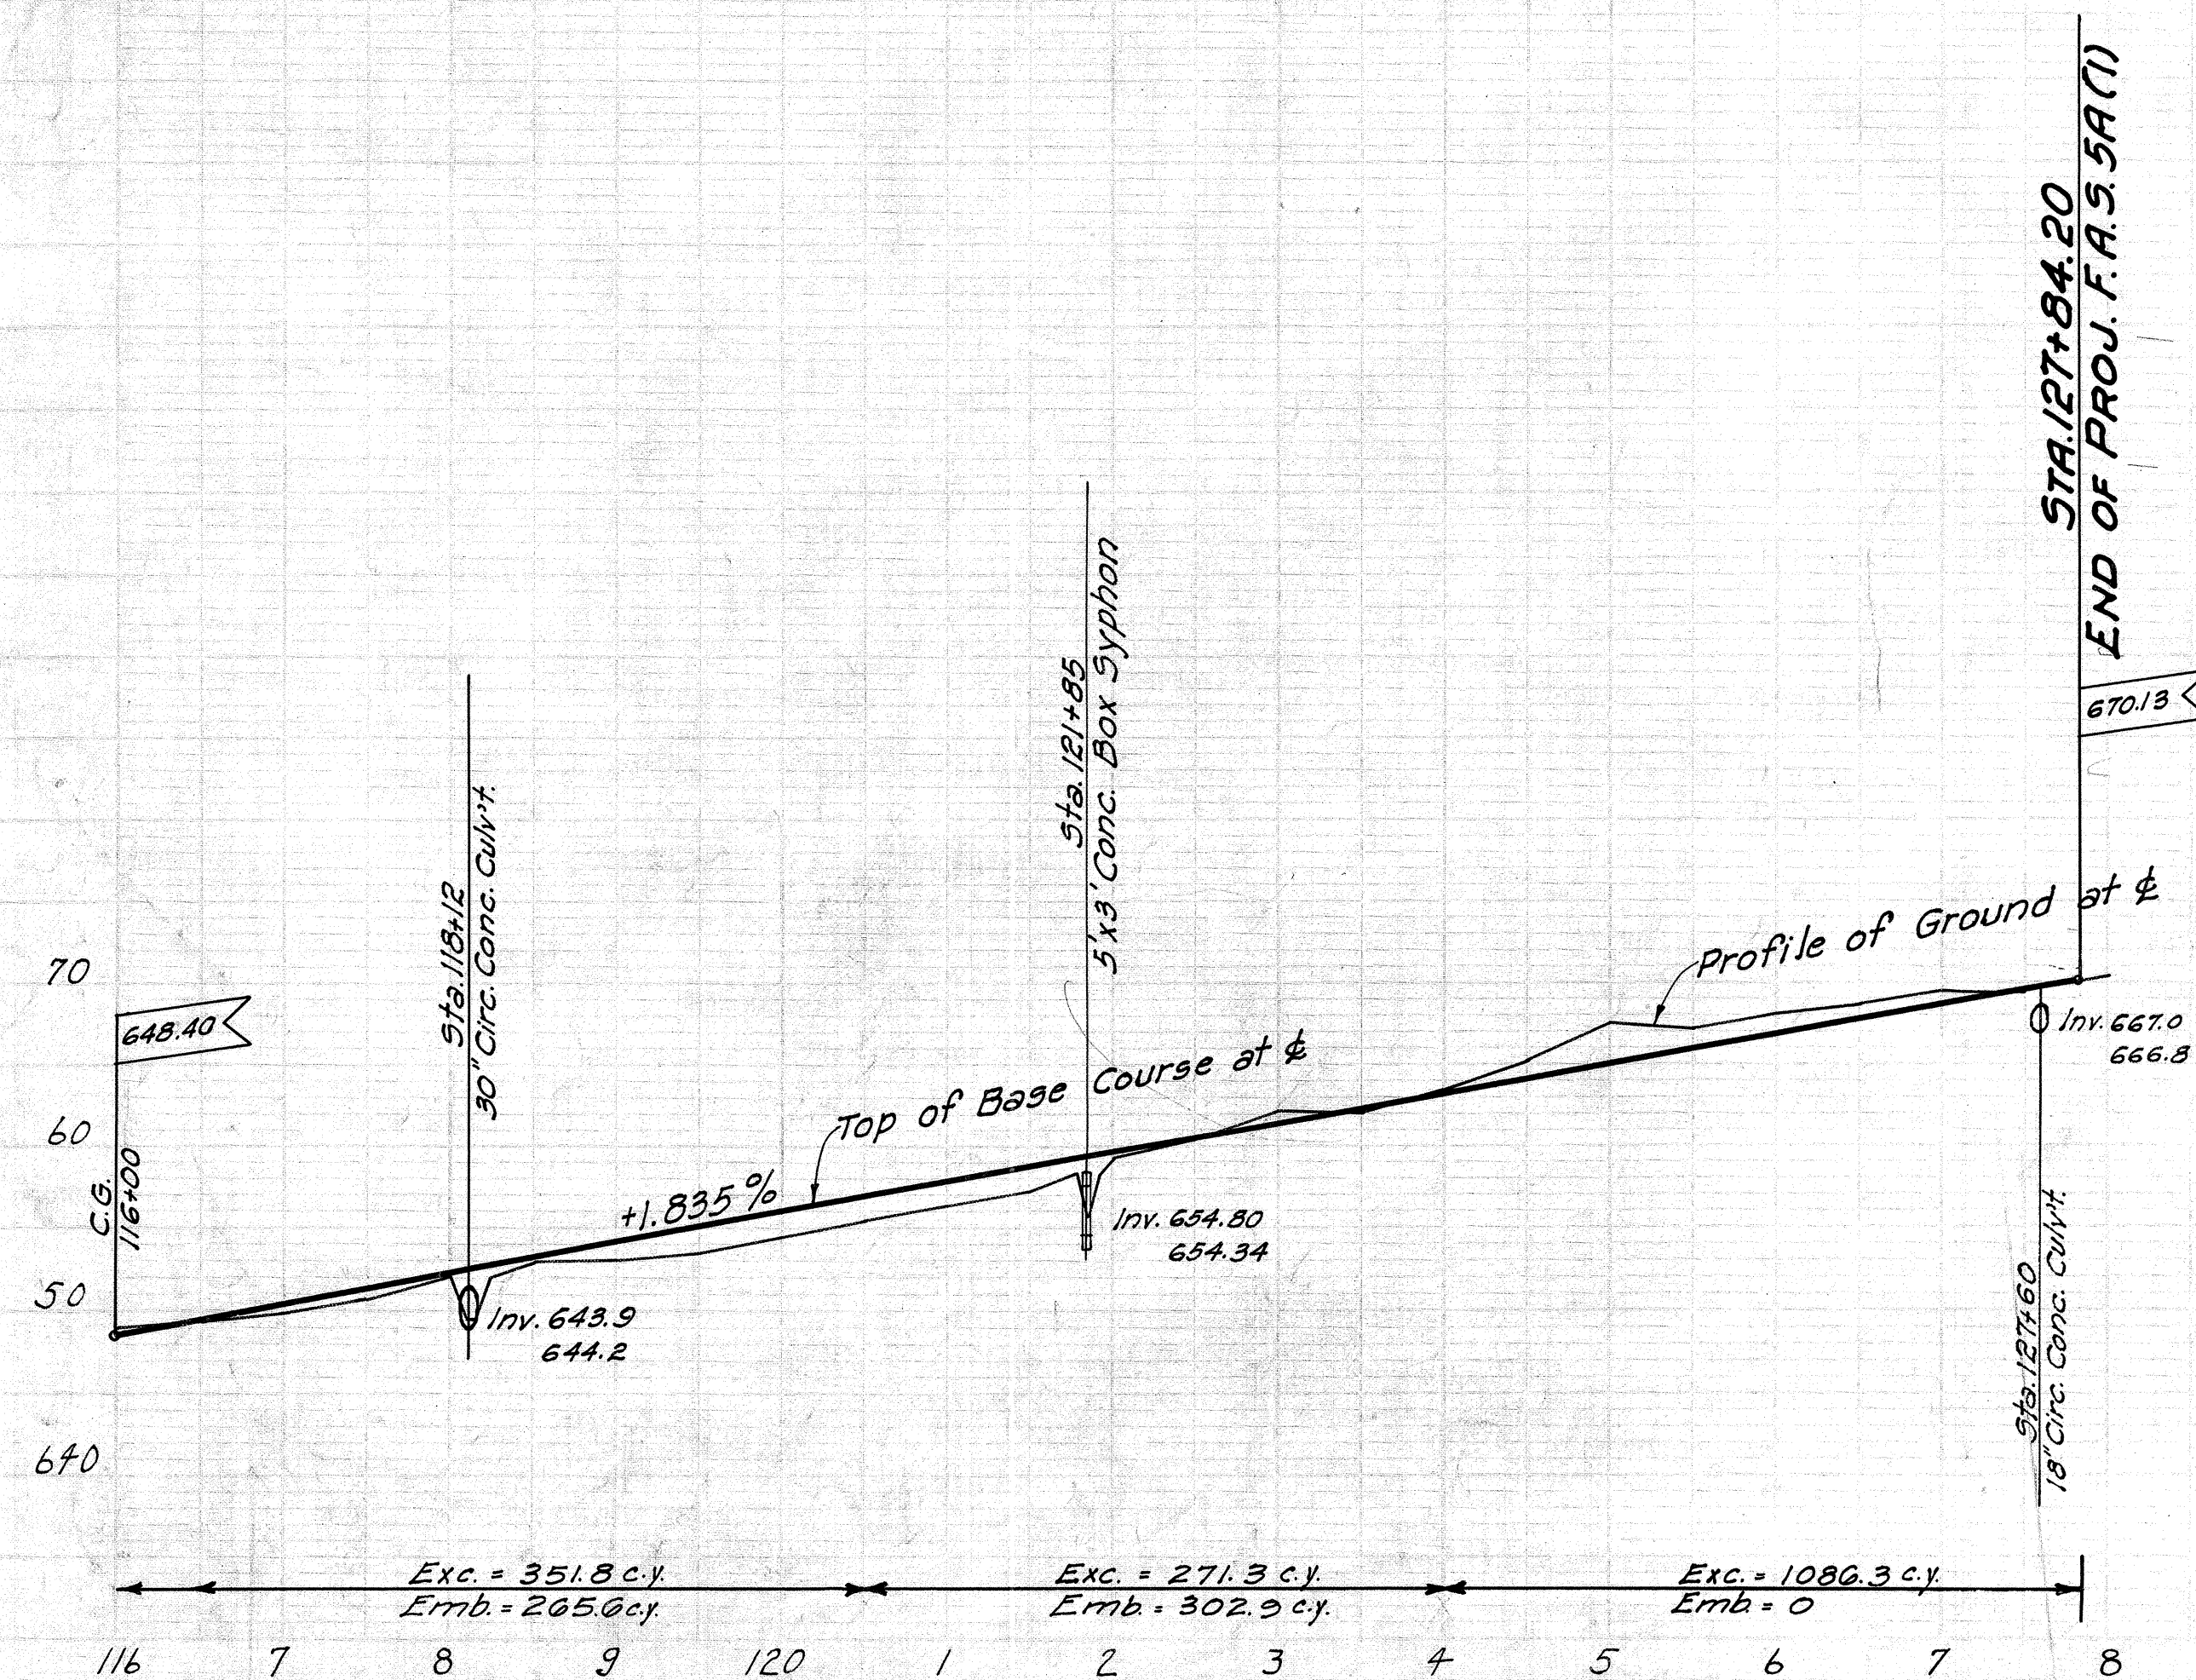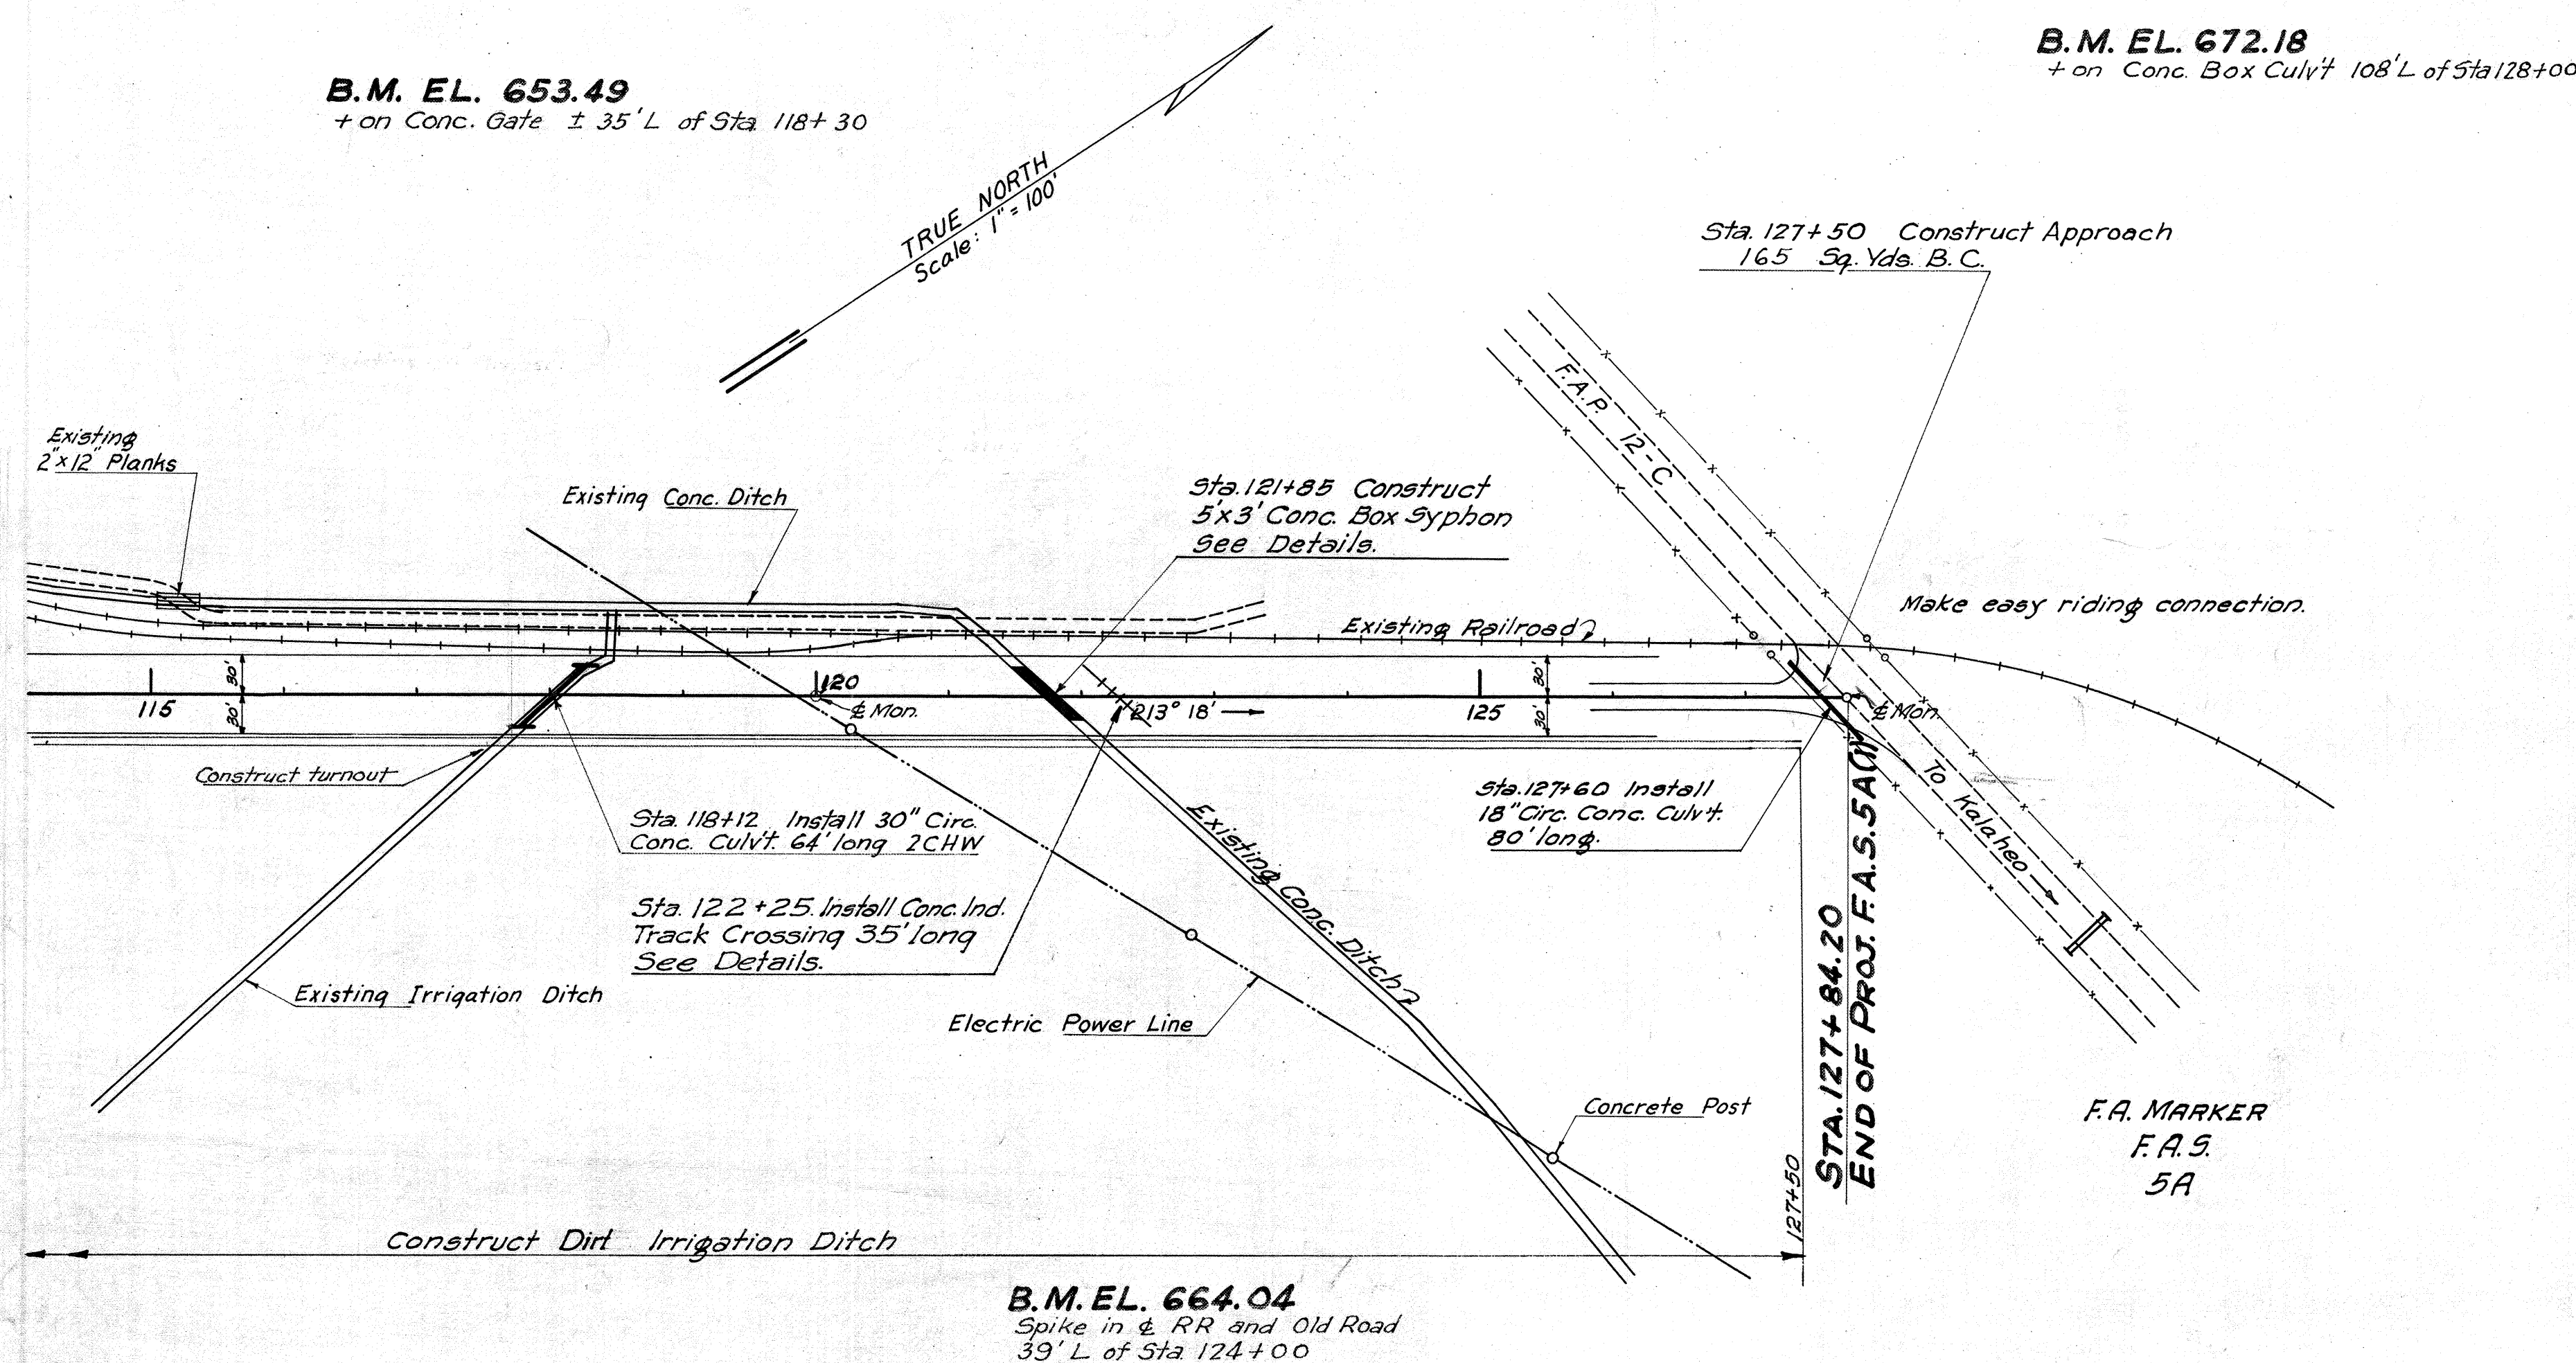

4496.7