



NOTE:
Azimuths referred to "Pohakea Δ"
meridian to conform to FAS SB survey.

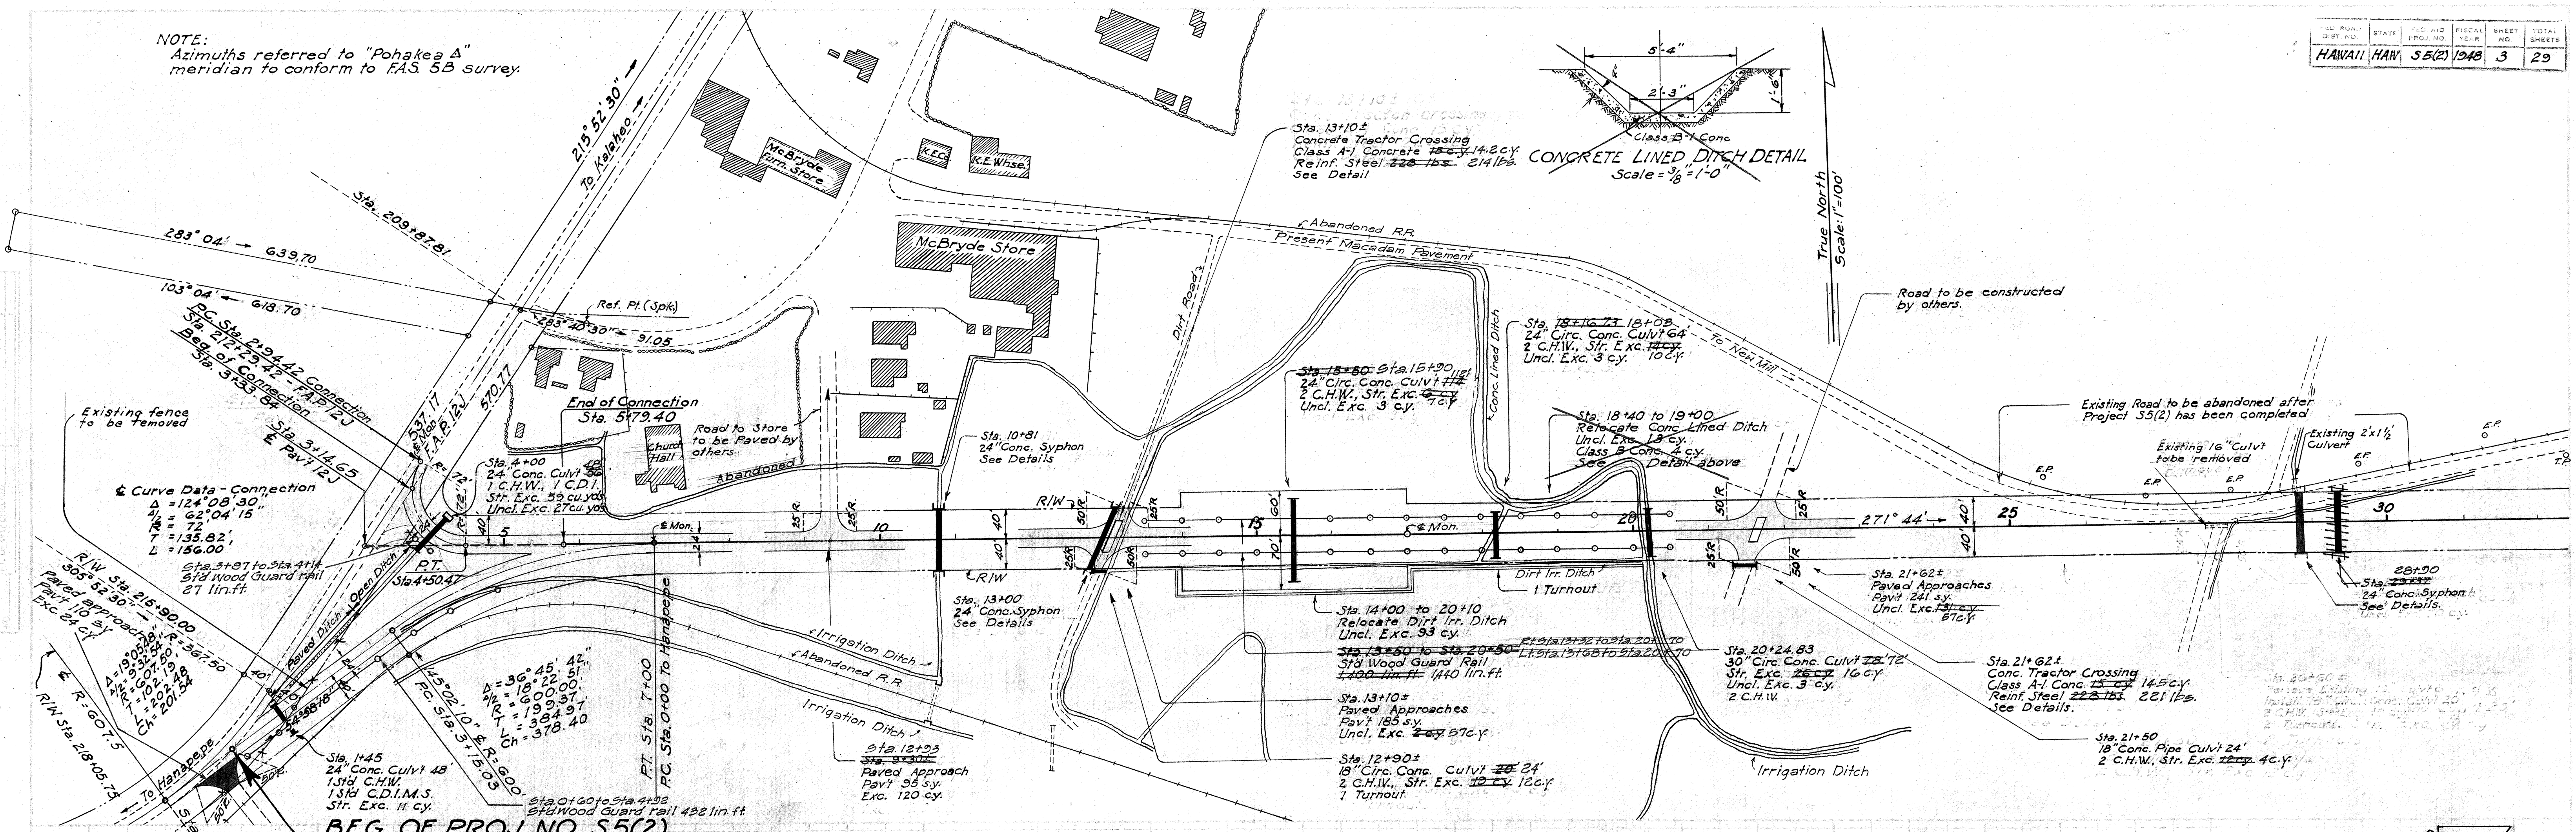

CONCRETE LINED DITCH DETAIL
Scale = 3/8" = 1'-0"



BEG. OF PROJ. NO. 55(2)
STA 0+55.15

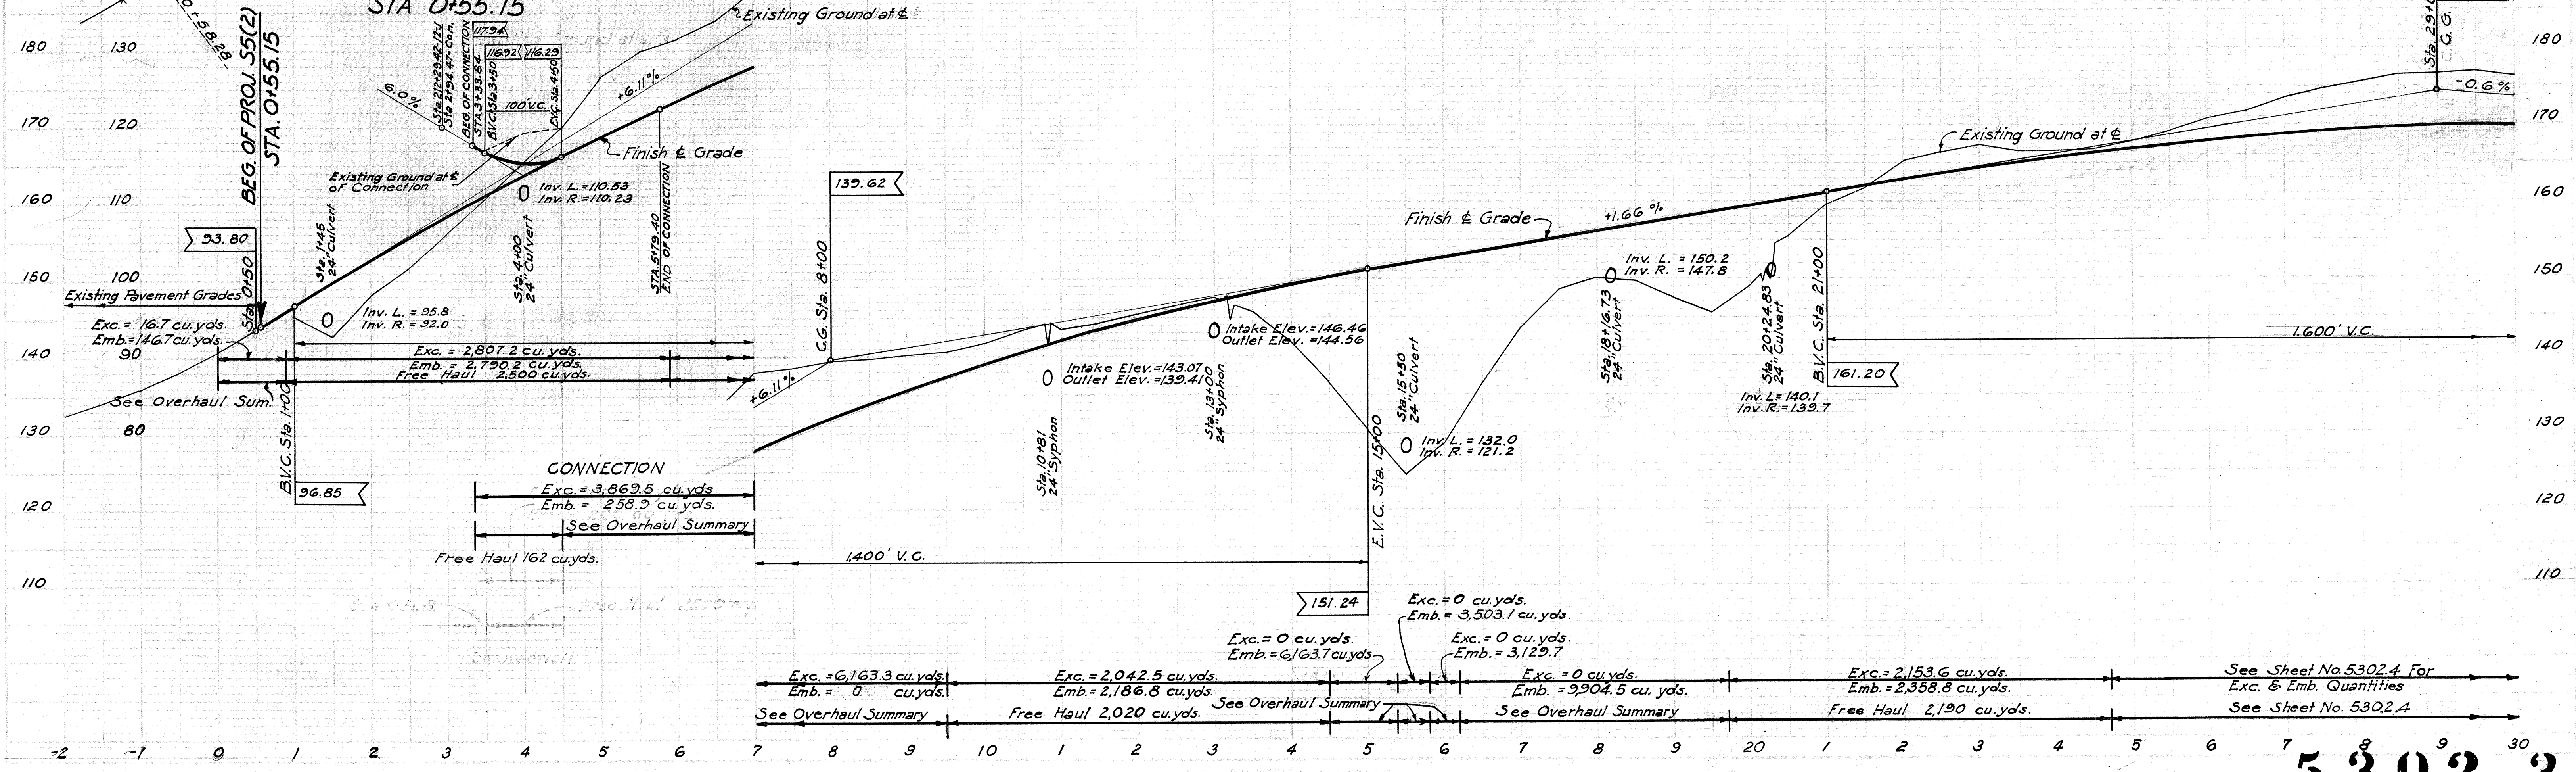



5302.3

Nov. 1, 1948

FED. ROAD DIST. NO.	STATE	FED. AID PROJ. NO.	FISCAL YEAR	SHEET NO.	TOTAL SHEETS
HAWAII	HAW.	55(2)	1948	4	23

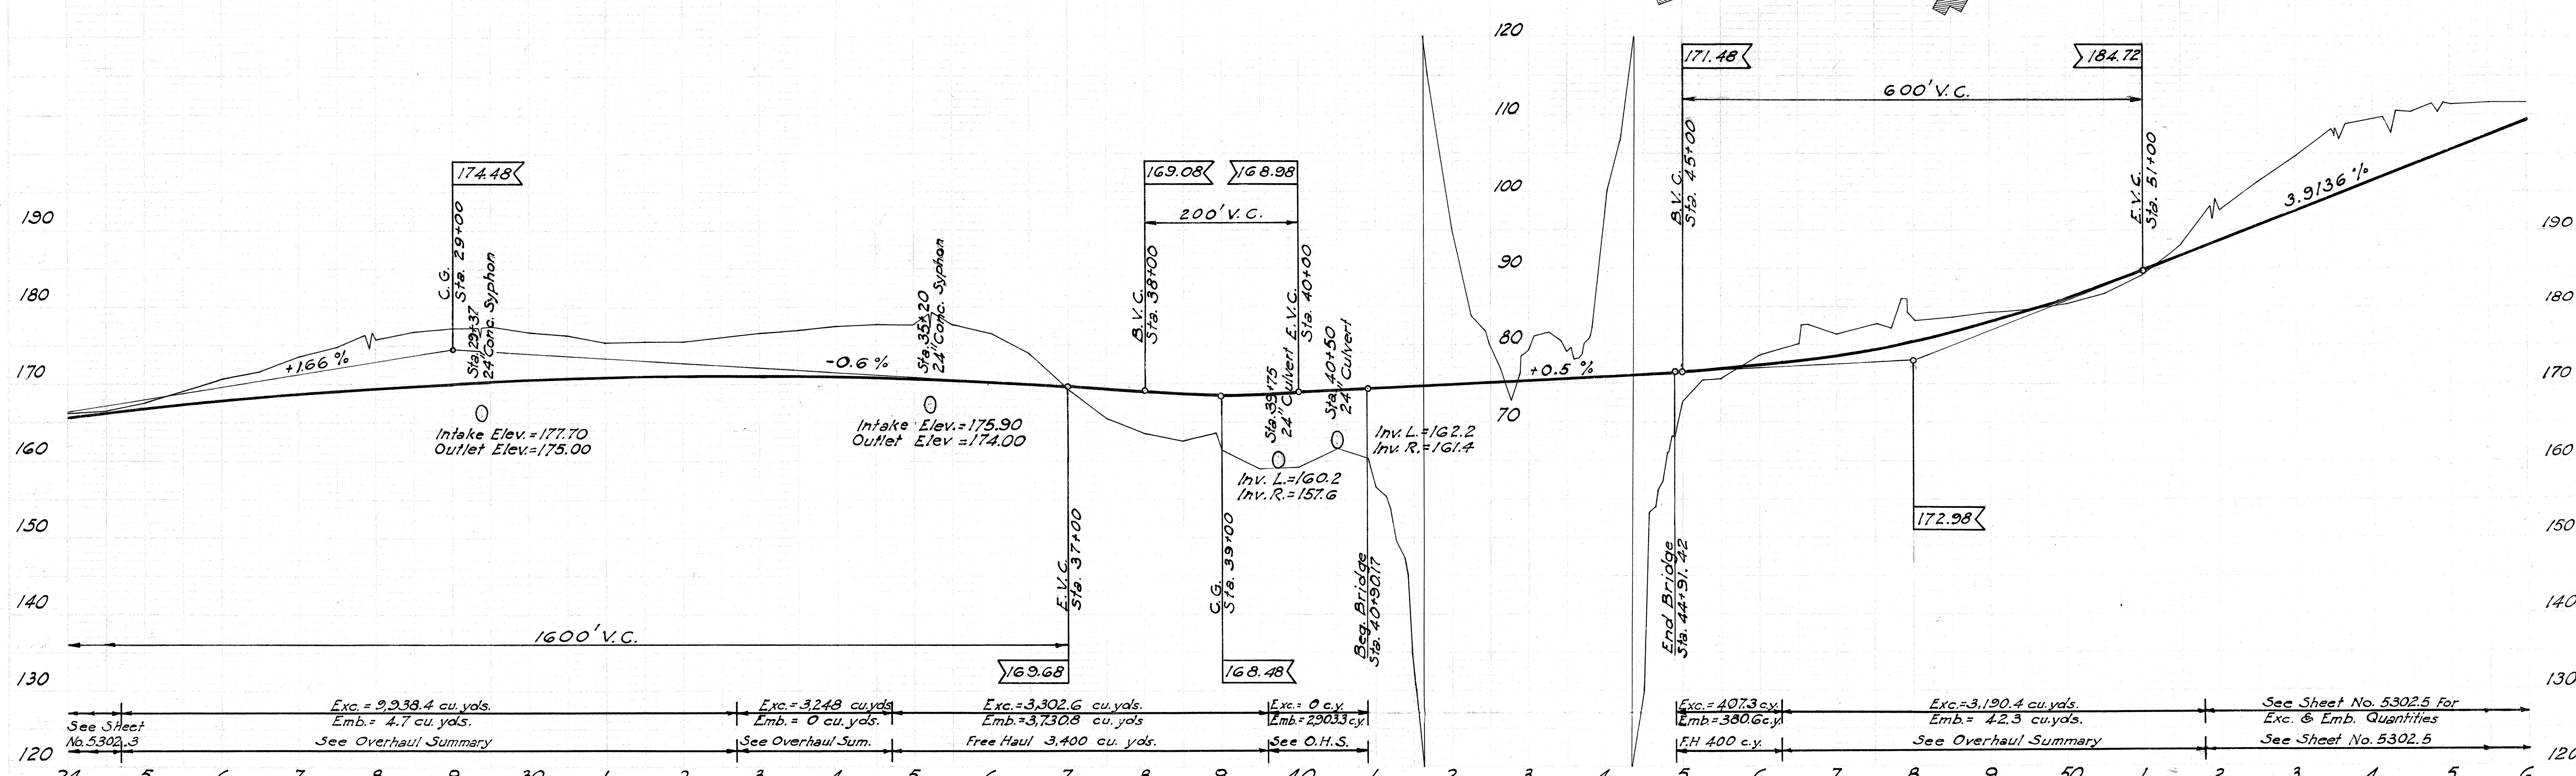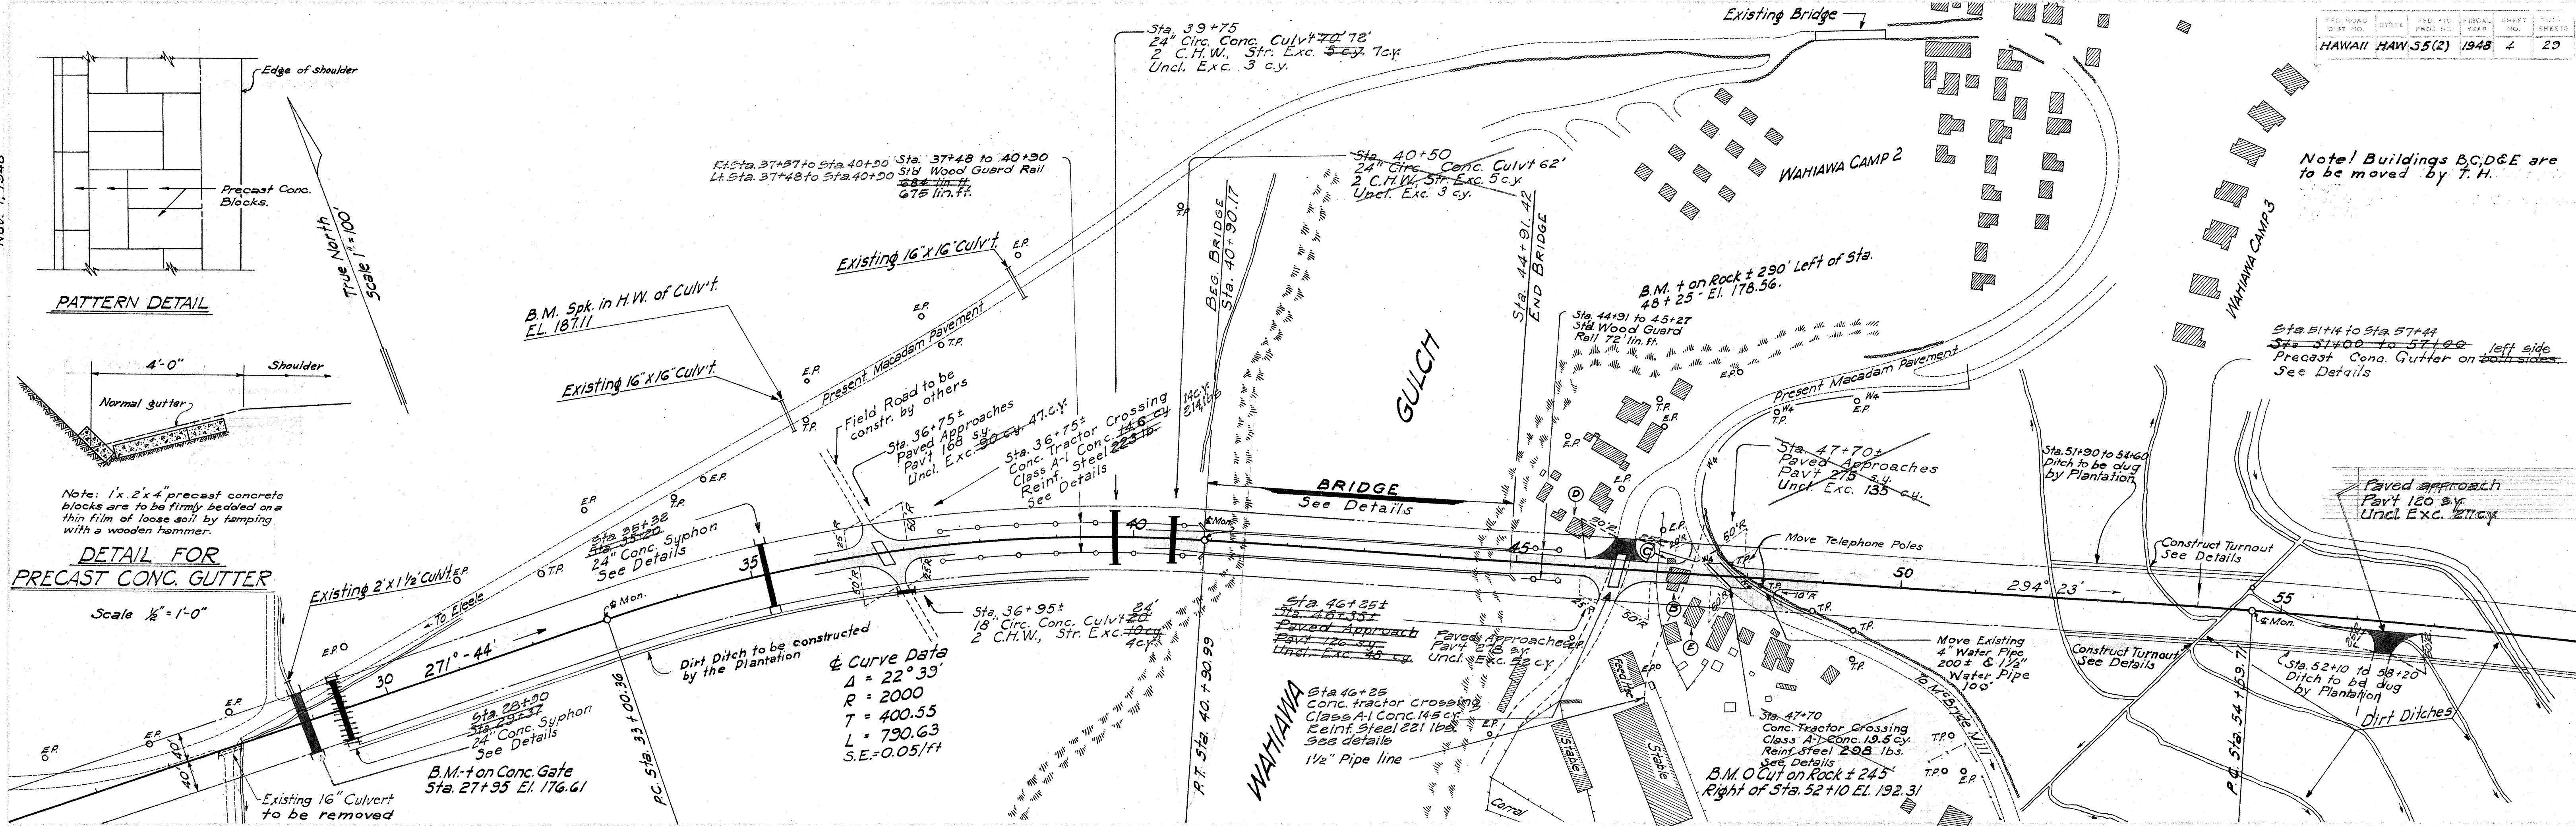

5302.4

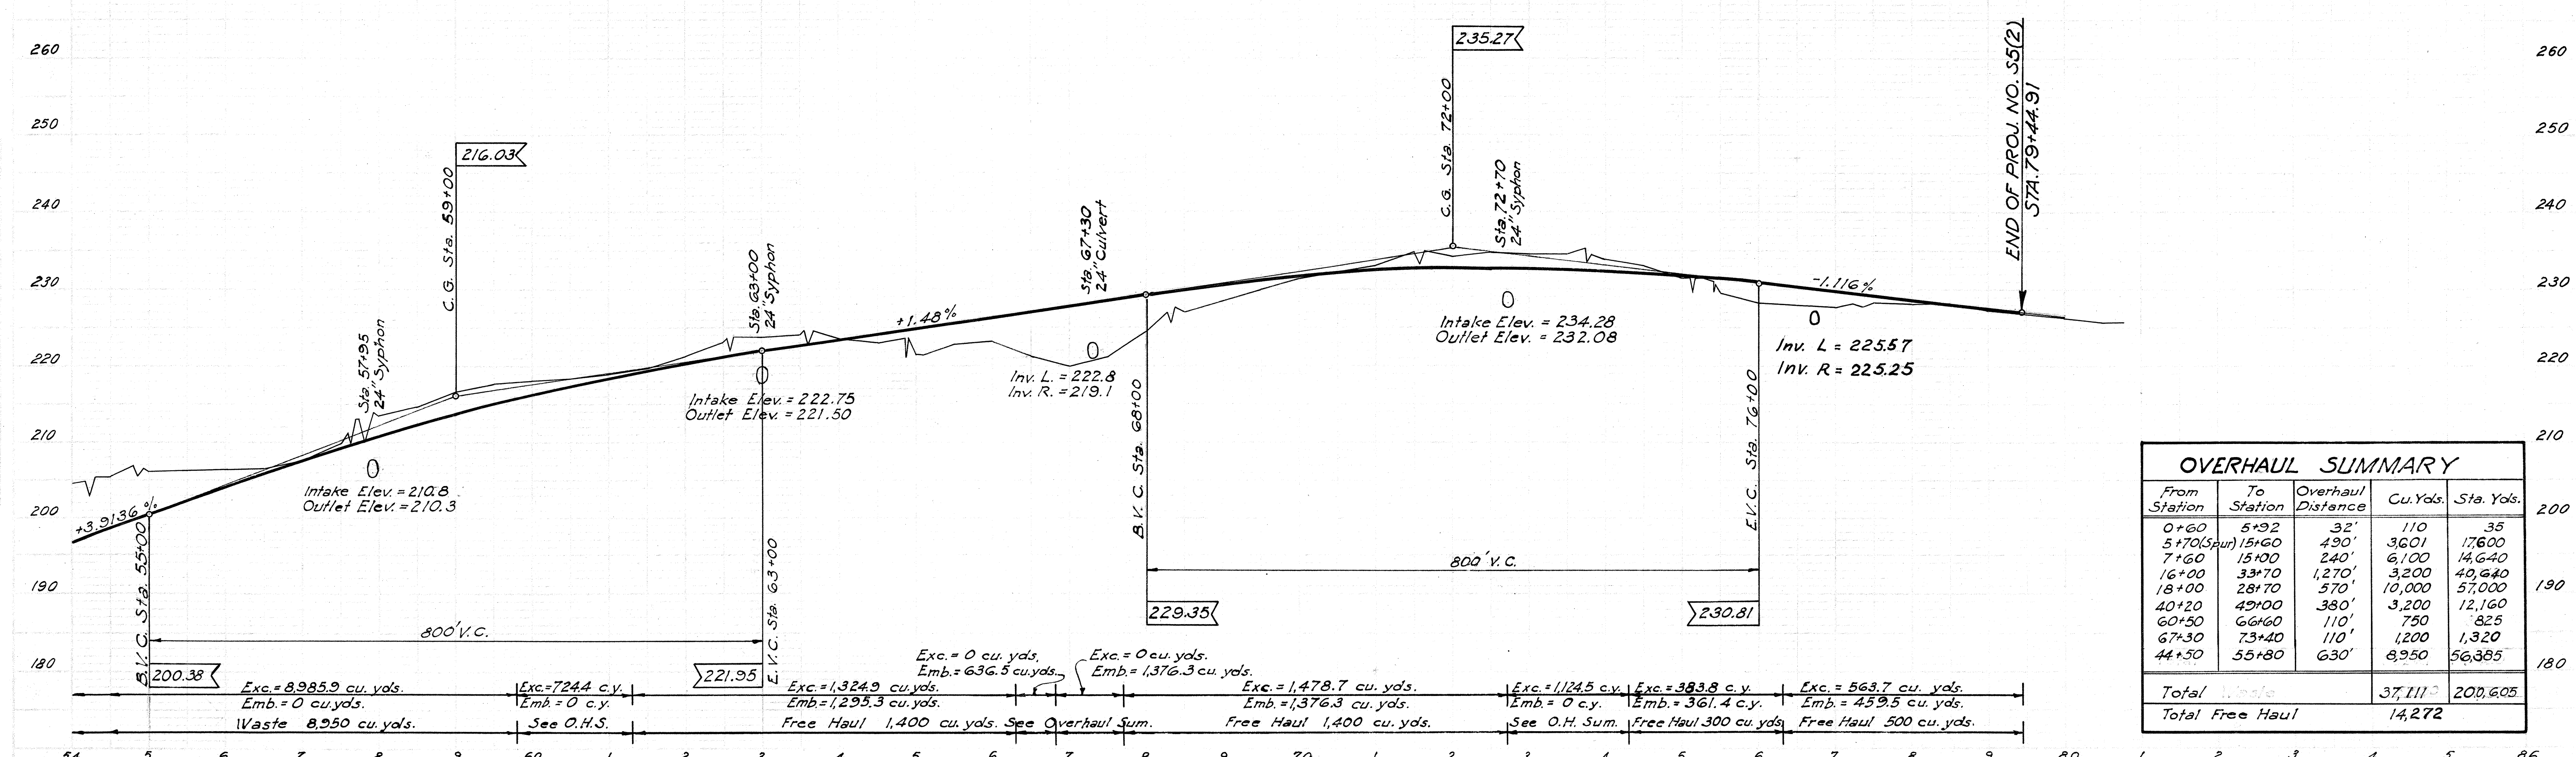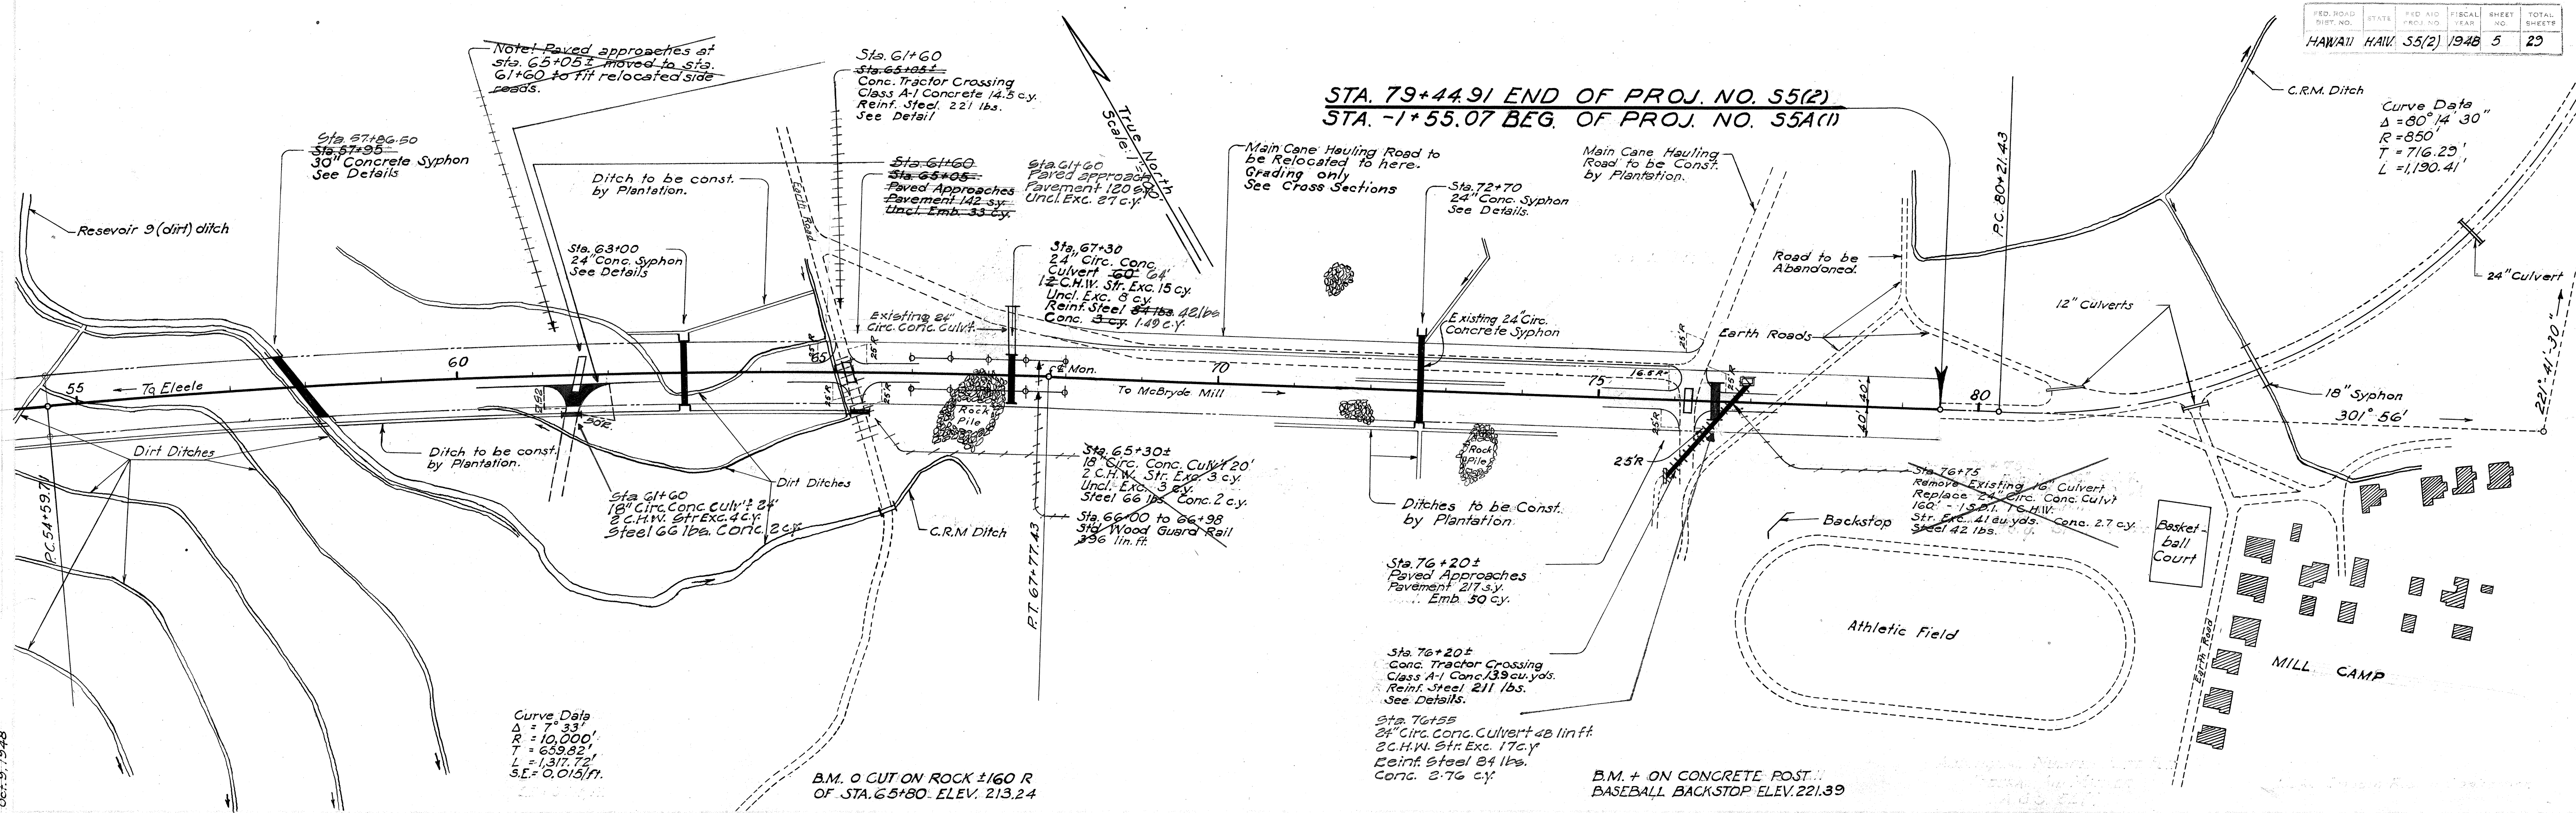

OVERHAUL SUMMARY					
From Station	To Station	Overhaul Distance	Cu. Yds.	Sta. Yds.	
0+60	5+92	32'	110	35	
5+70(Spur)	15+60	490'	3,601	17,600	
7+60	15+00	240'	6,100	14,640	
16+00	33+70	1,270'	3,200	40,640	
18+00	28+70	570'	10,000	57,000	
40+20	49+00	380'	3,200	12,160	
60+50	66+60	110'	750	825	
67+30	73+40	110'	1,200	1,320	
44+50	55+80	630'	8,950	56,385	
Total			37,111	200,605	
Total Free Haul			14,272		