

INDEX TO DRAWINGS	
SHEET NO.	DESCRIPTION
1	TITLE SHEET
2	TYPICAL SECTION & GENERAL NOTES
3 - 5	PLANS
6 - 7	MISCELLANEOUS DETAILS

11-72
Date

548-7537
Phone-Loc

D. Beaver
PS&E By

Kauai District
Designed By

ORIGINAL	DATE
PLAN	DESIGNED BY
NOTE BOOK	DRAWN BY
NO.	QUANTITIES CHECKED BY
	CHECKED BY

STATE OF HAWAII

DEPARTMENT OF TRANSPORTATION

HIGHWAYS DIVISION

PLANS FOR



HALEWILI ROAD RESURFACING, KAUAI

PROJ. NO. 540A-01-72

DISTRICT OF KOLOA

ISLAND OF KAUAI

DIST. NO.	STATE	PROJ. NO.	FISCAL YEAR	SHEET NO.	TOTAL SHEETS
HAWAII	HAW.	540A-01-72	1972	1	7

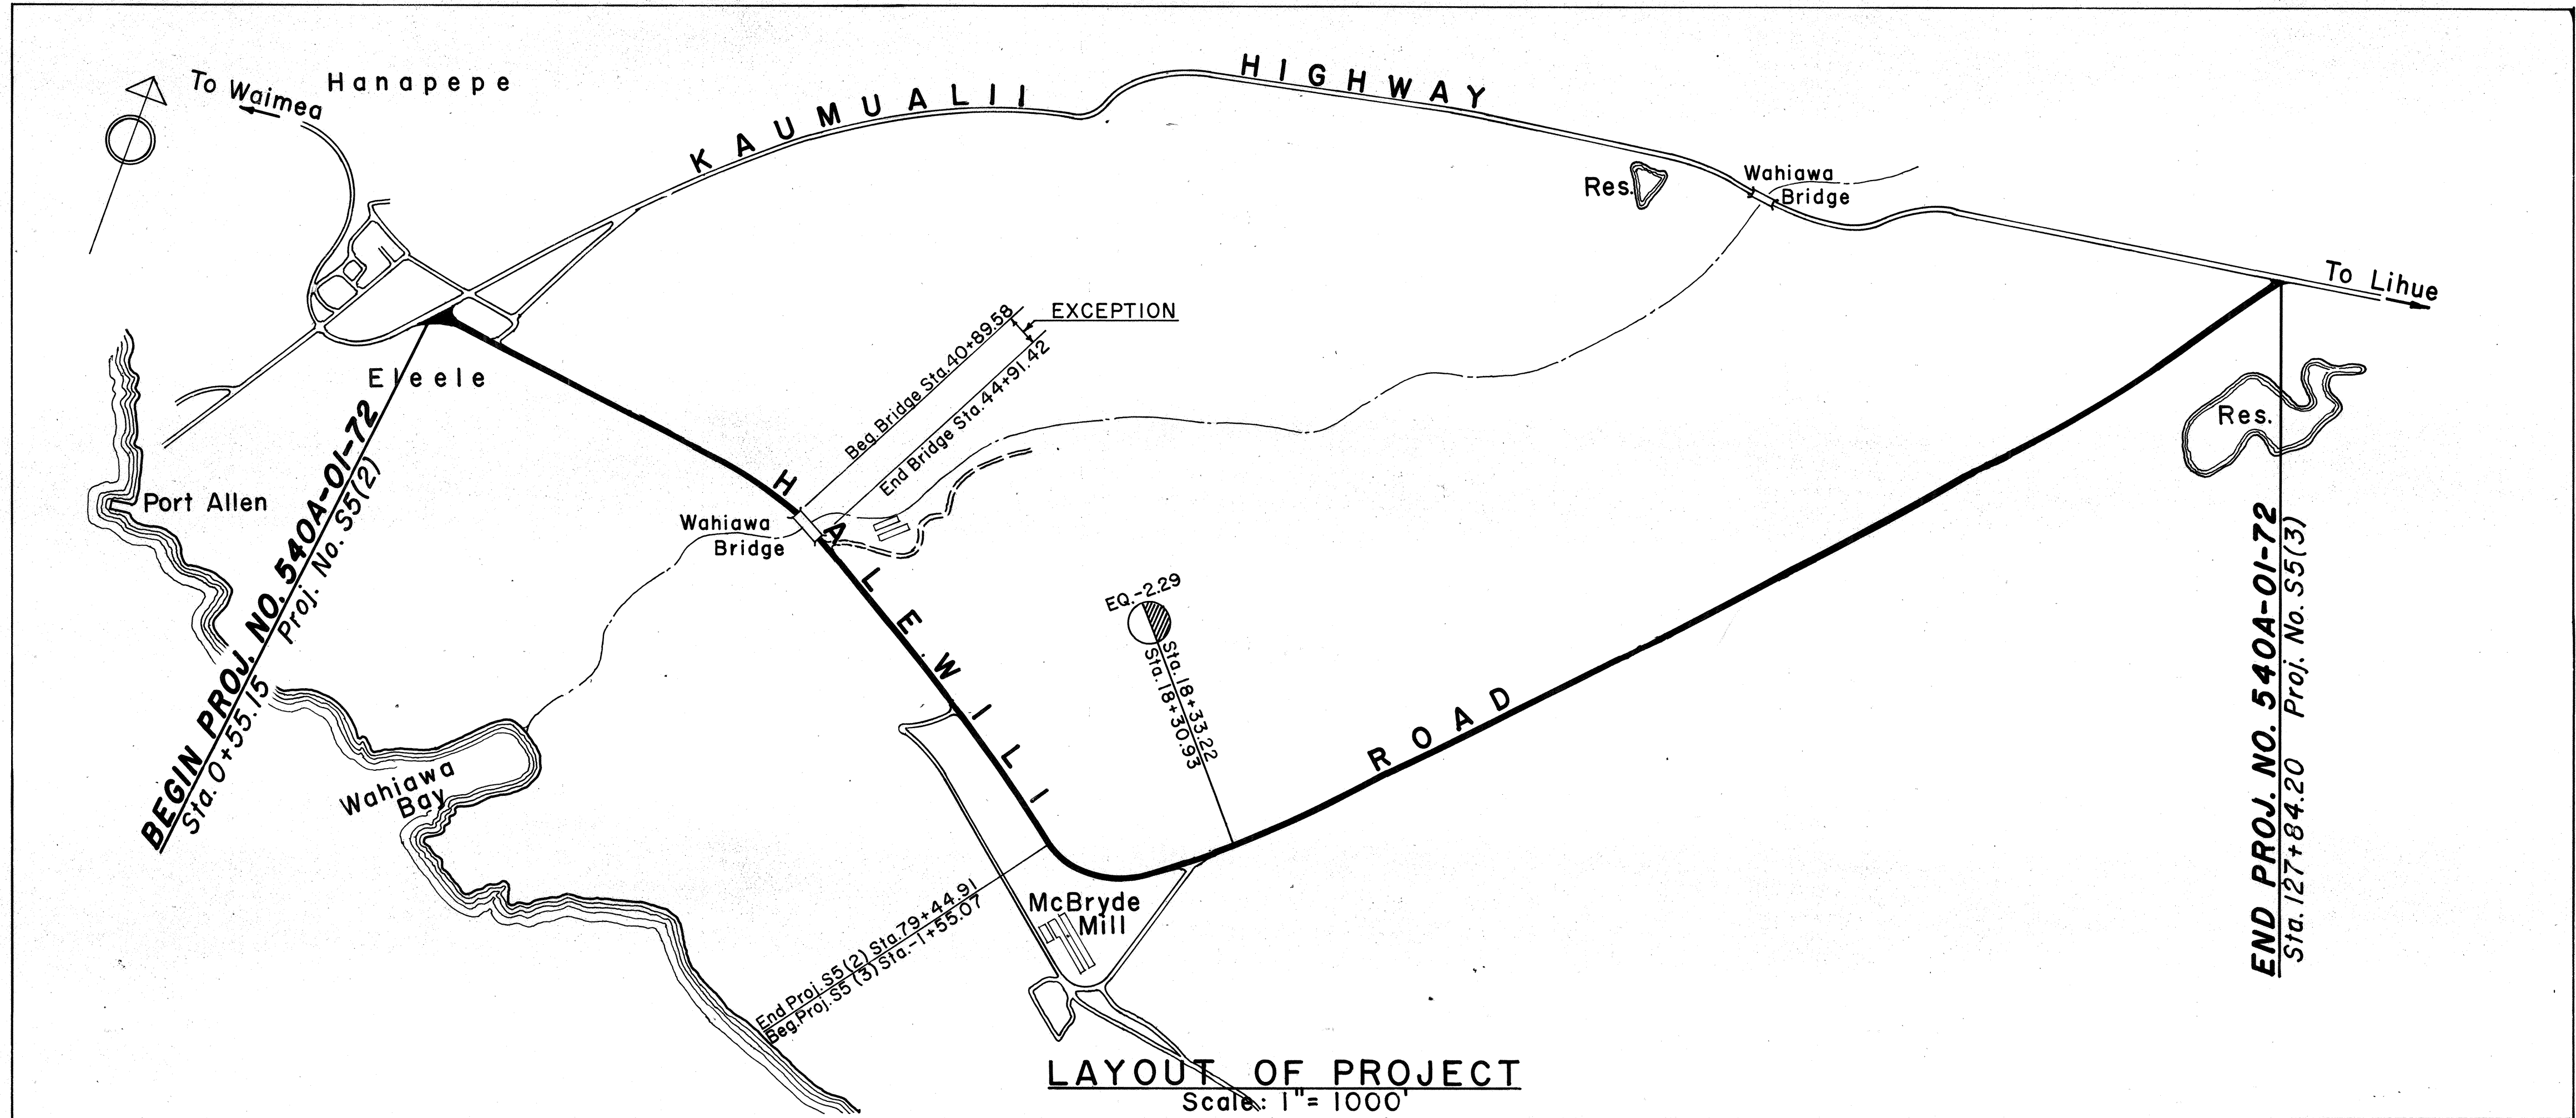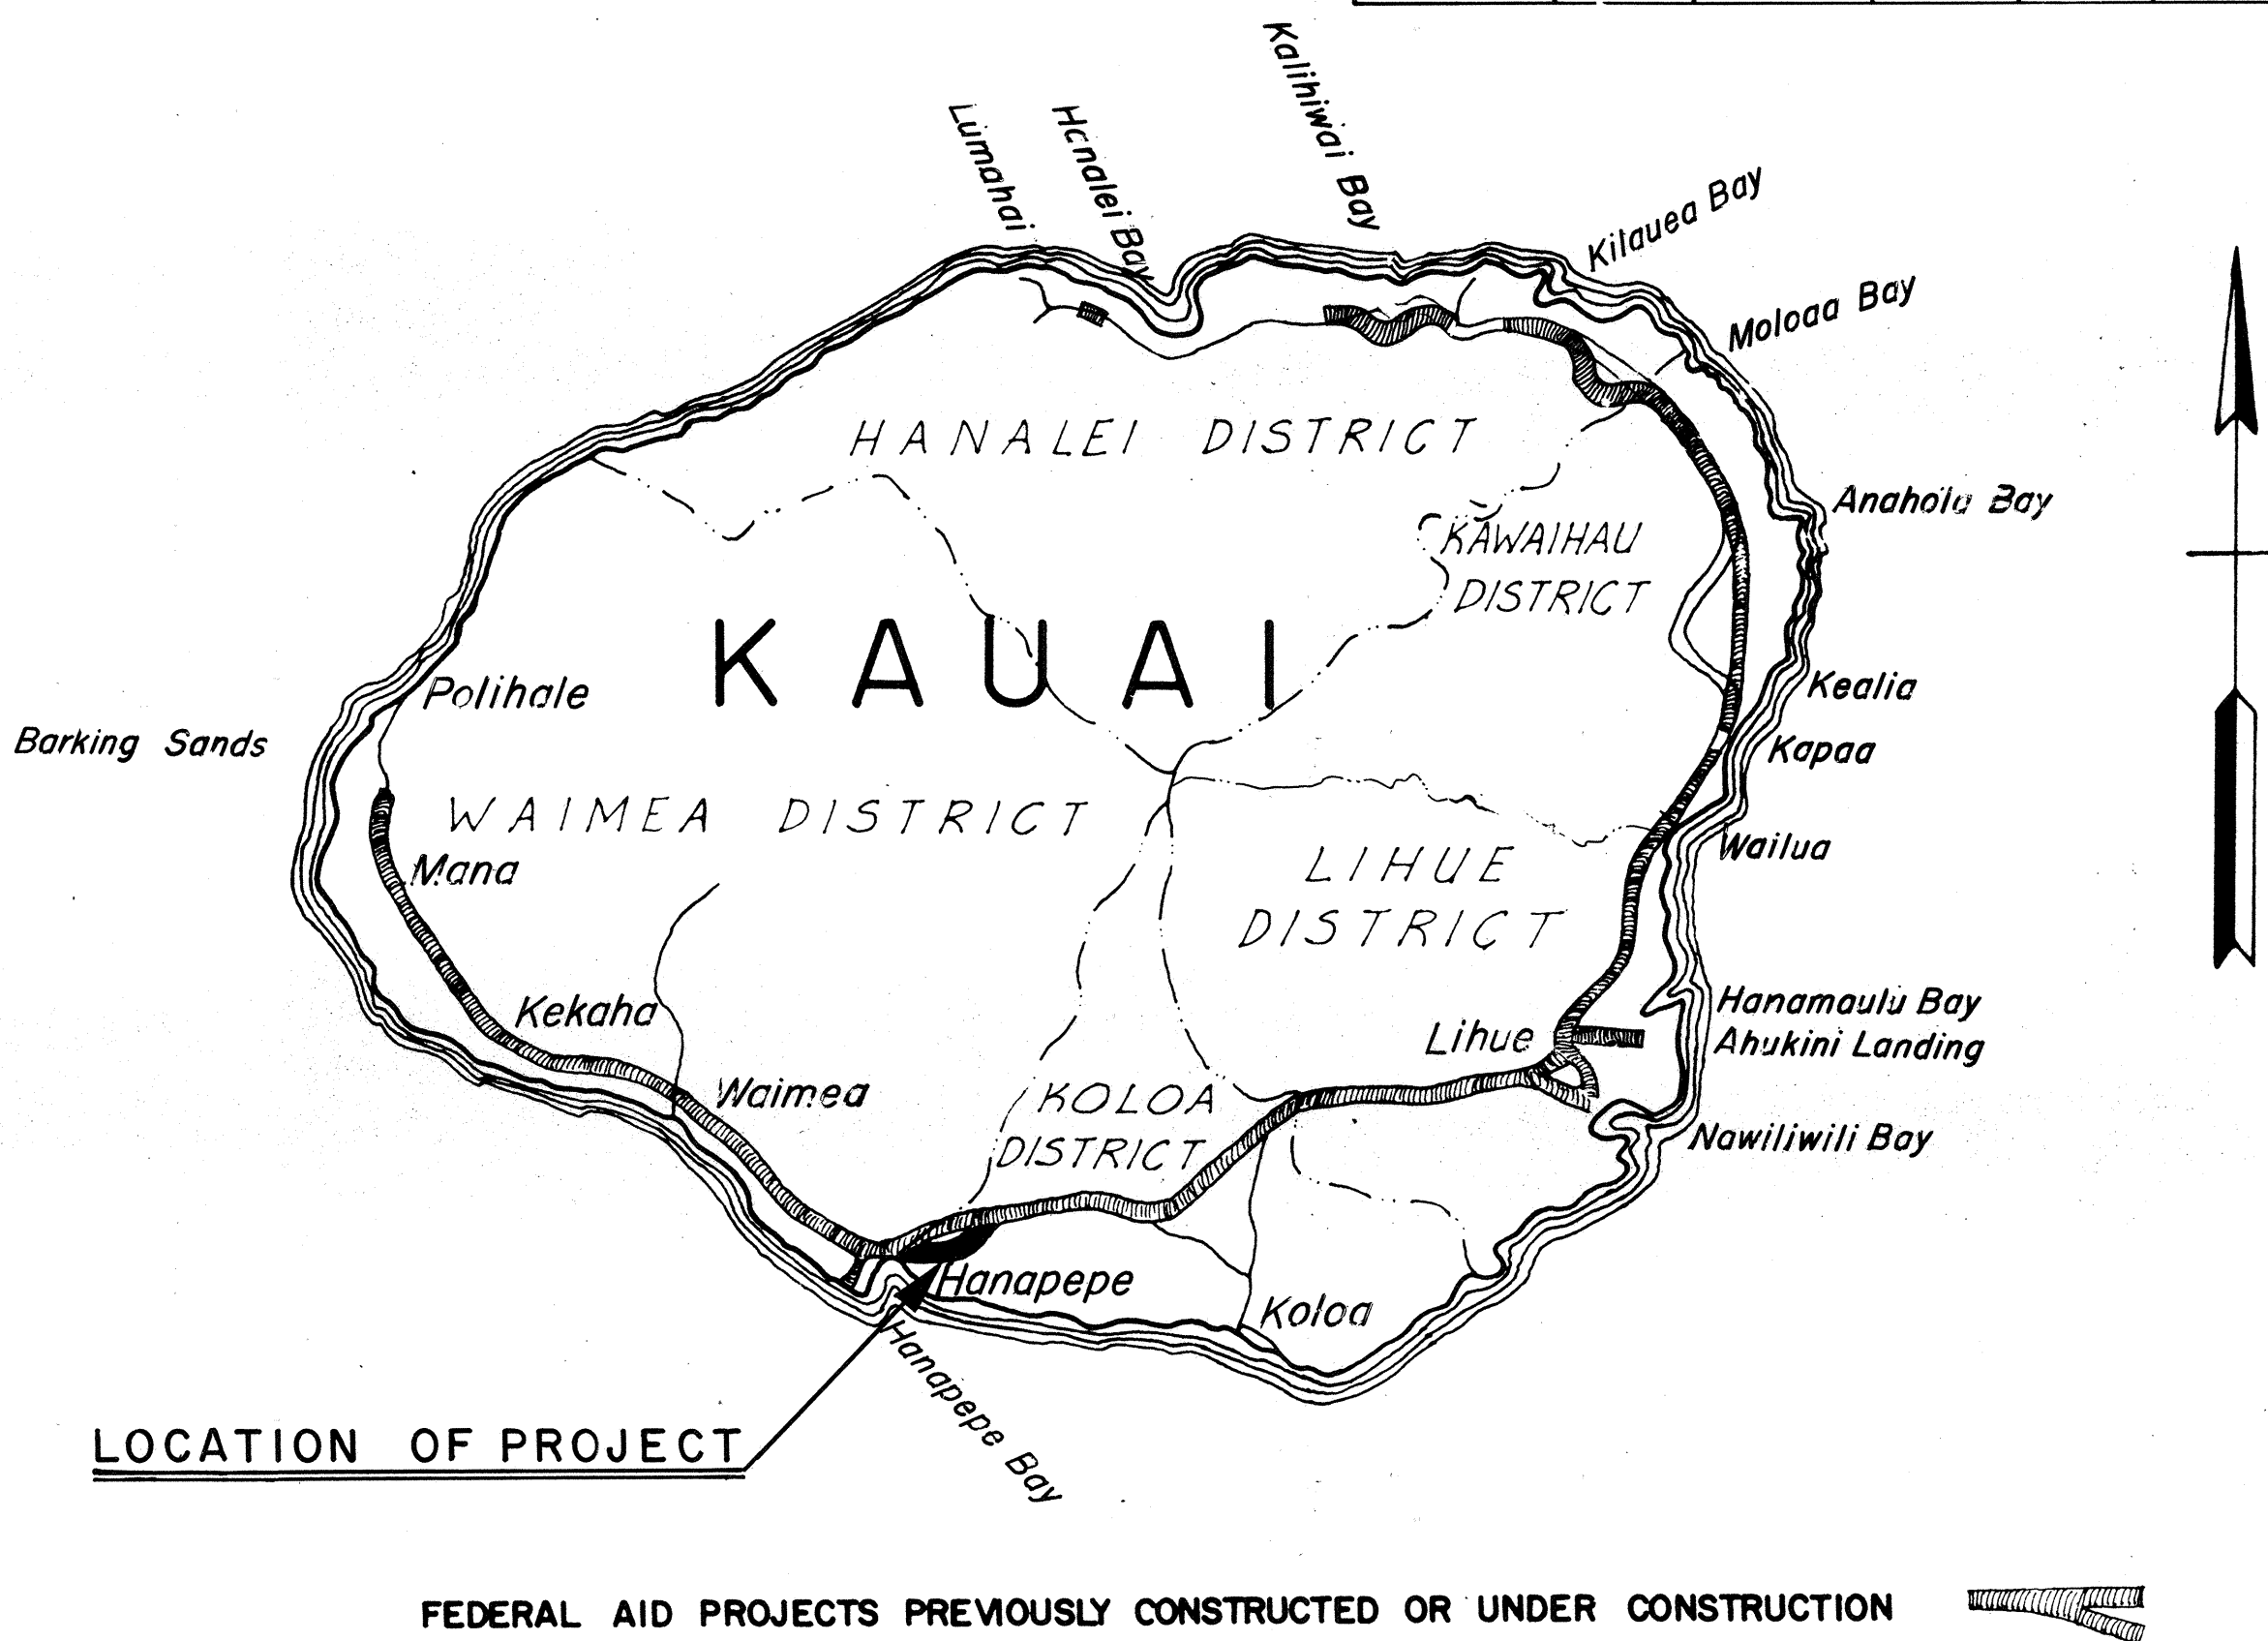

DEPARTMENT OF TRANSPORTATION

STATE OF HAWAII

APPROVED:

Murray Lee

11/12/71

FOR DIR. OF TRANSPORTATION

DATE