
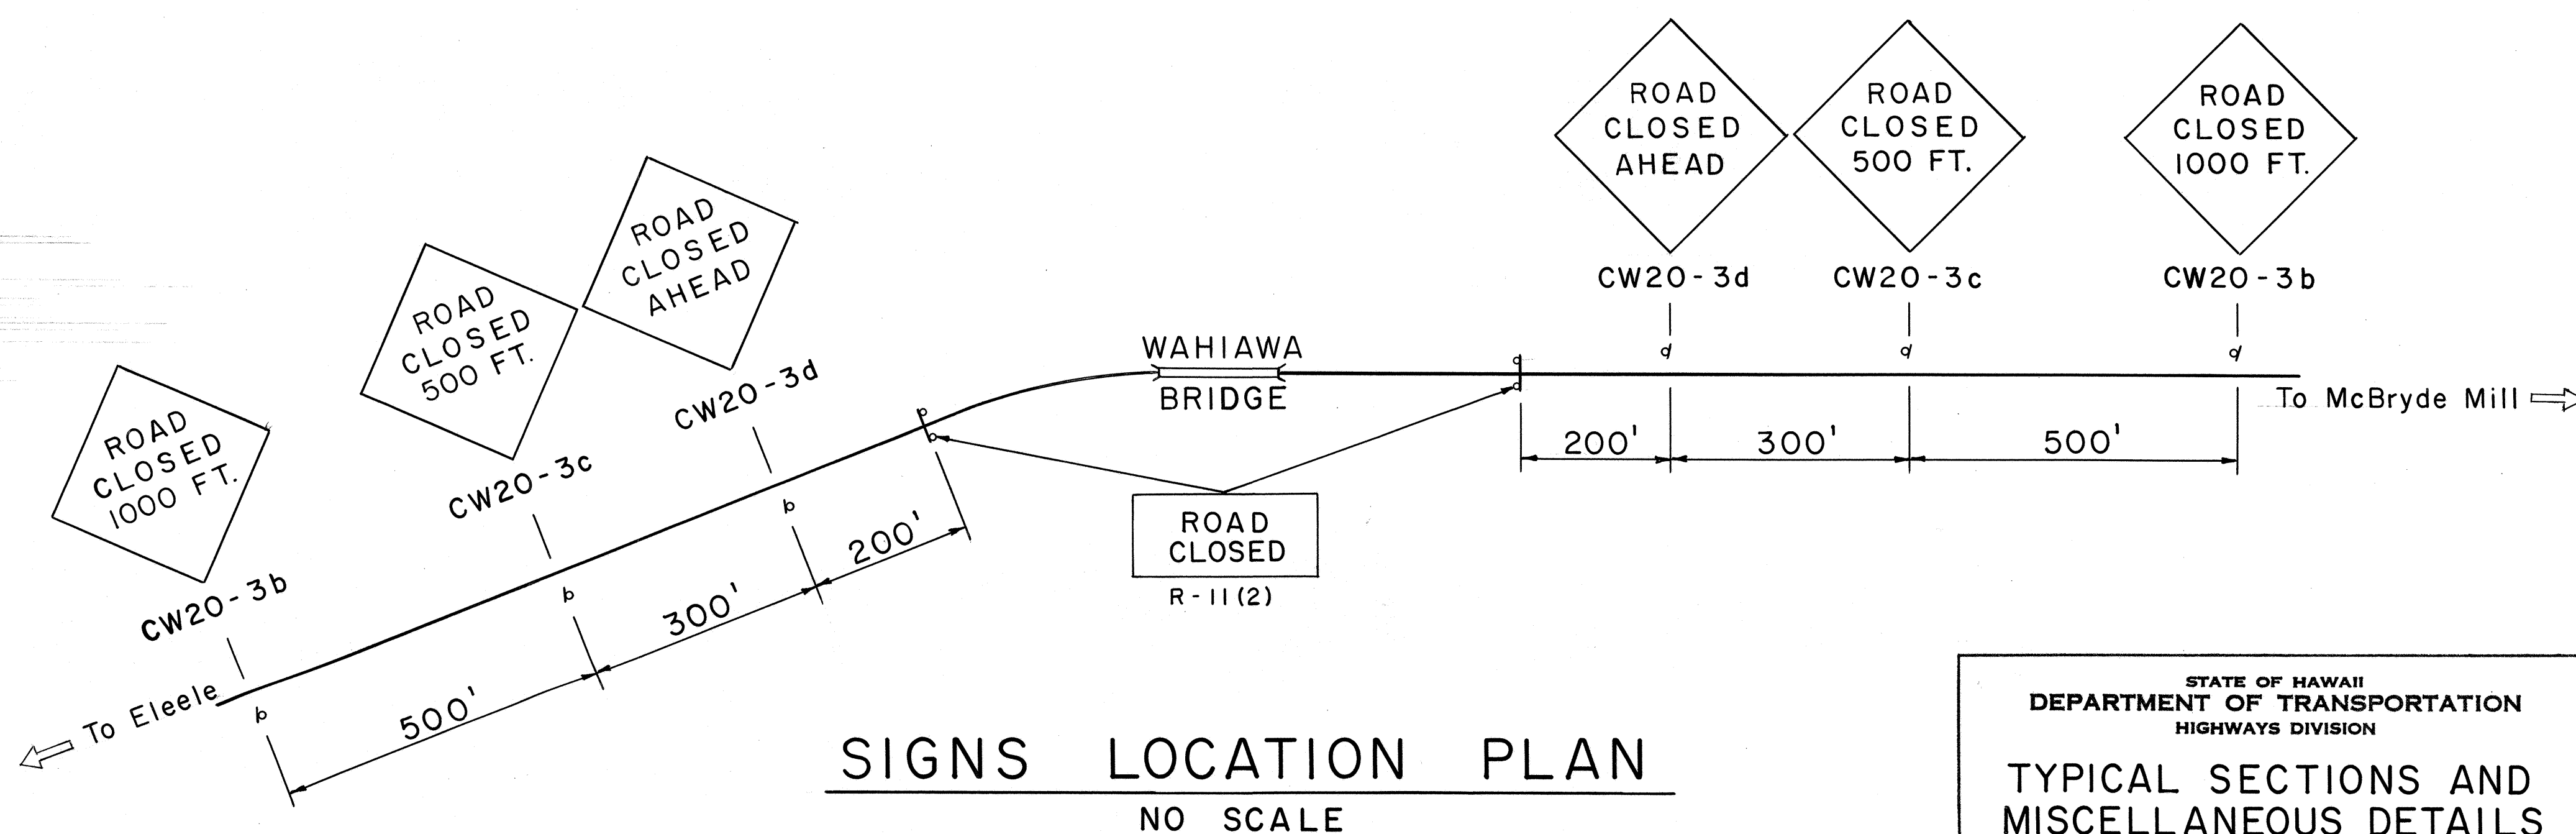
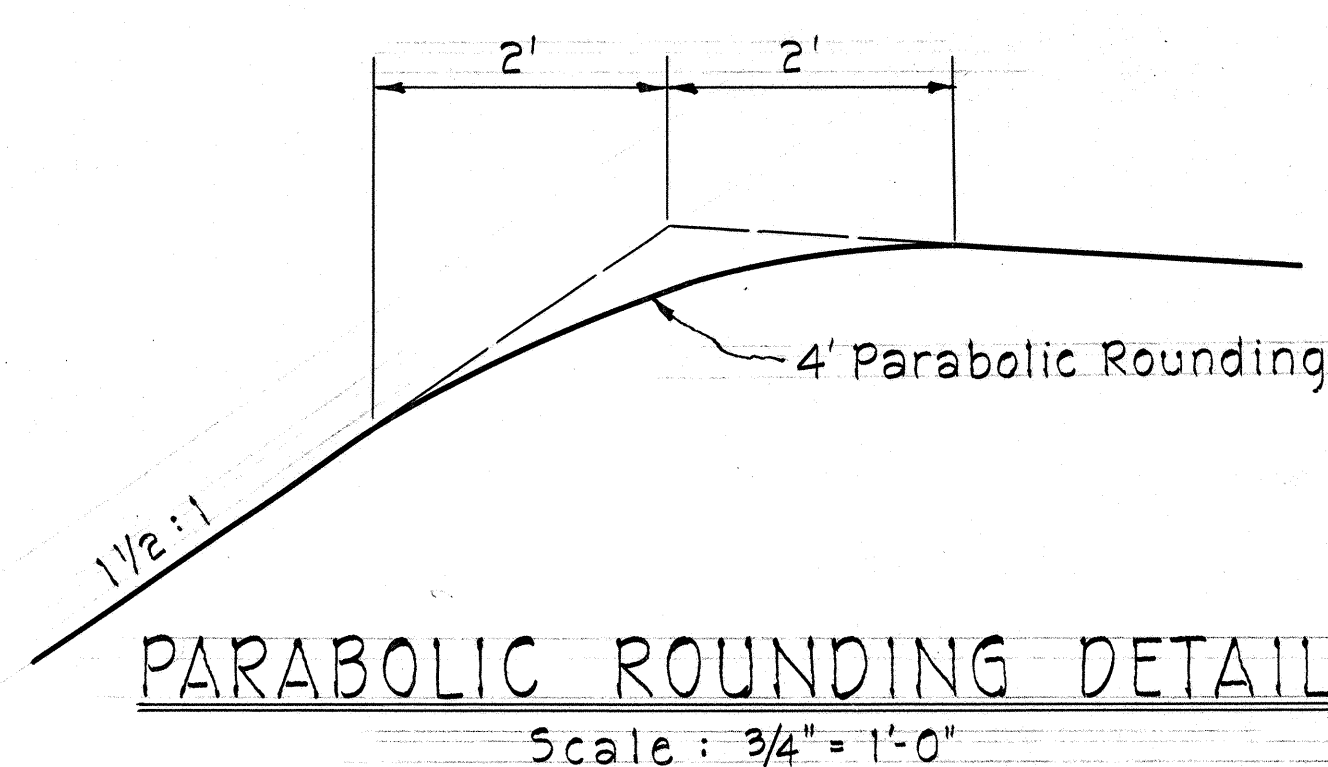
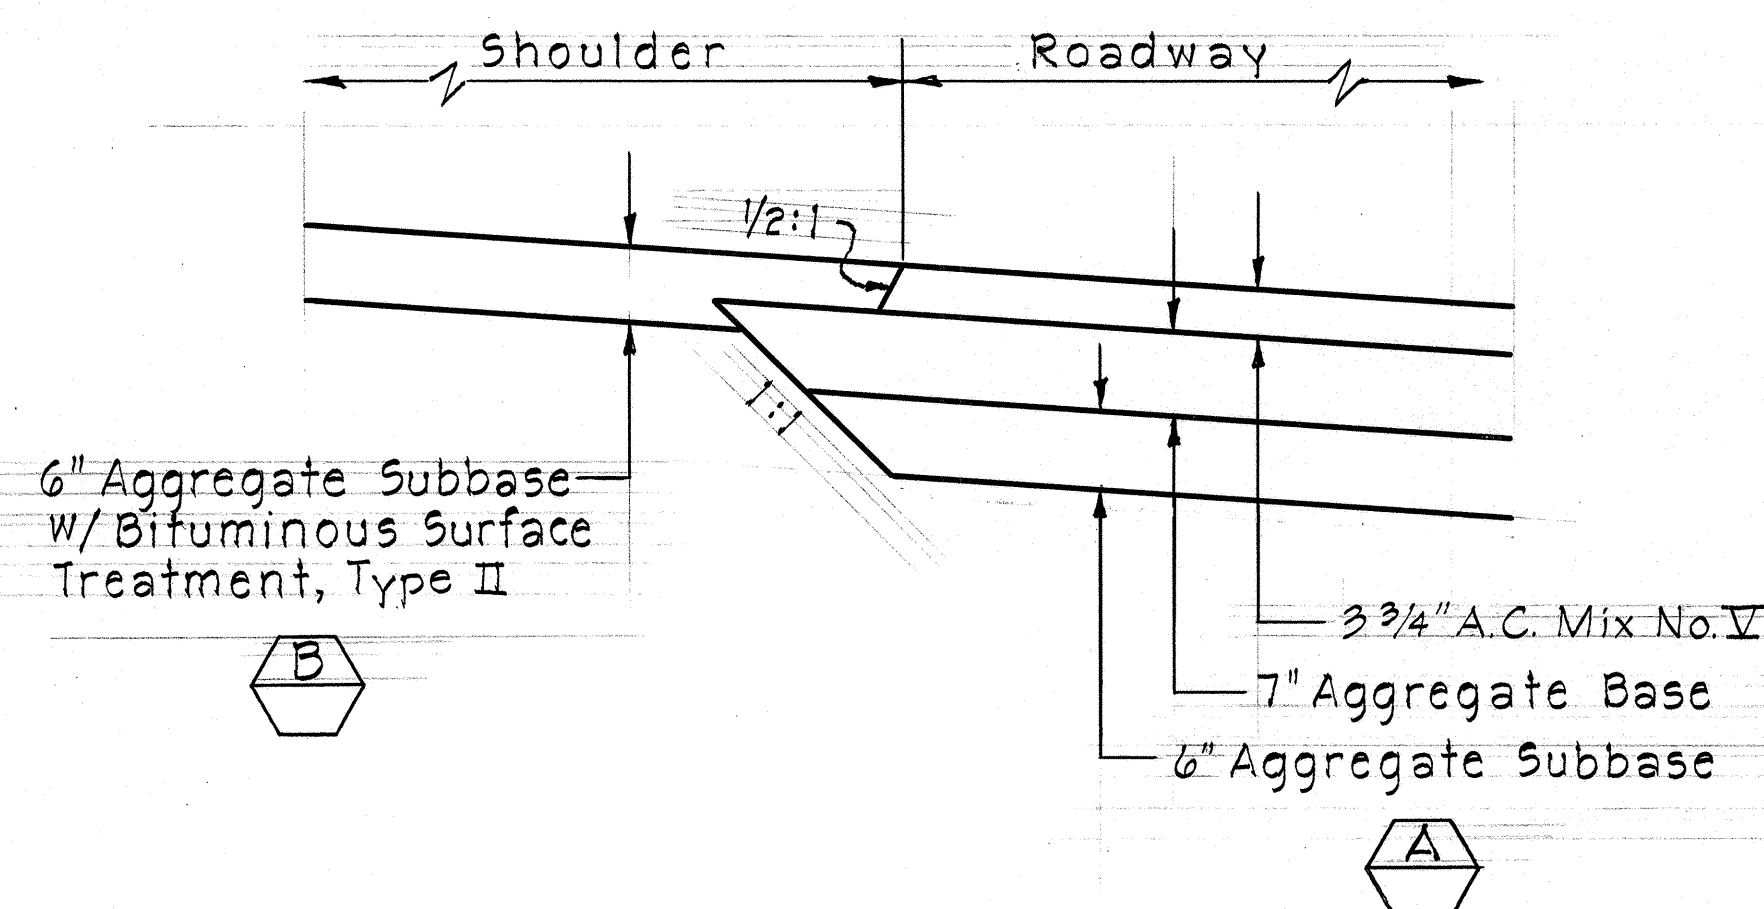
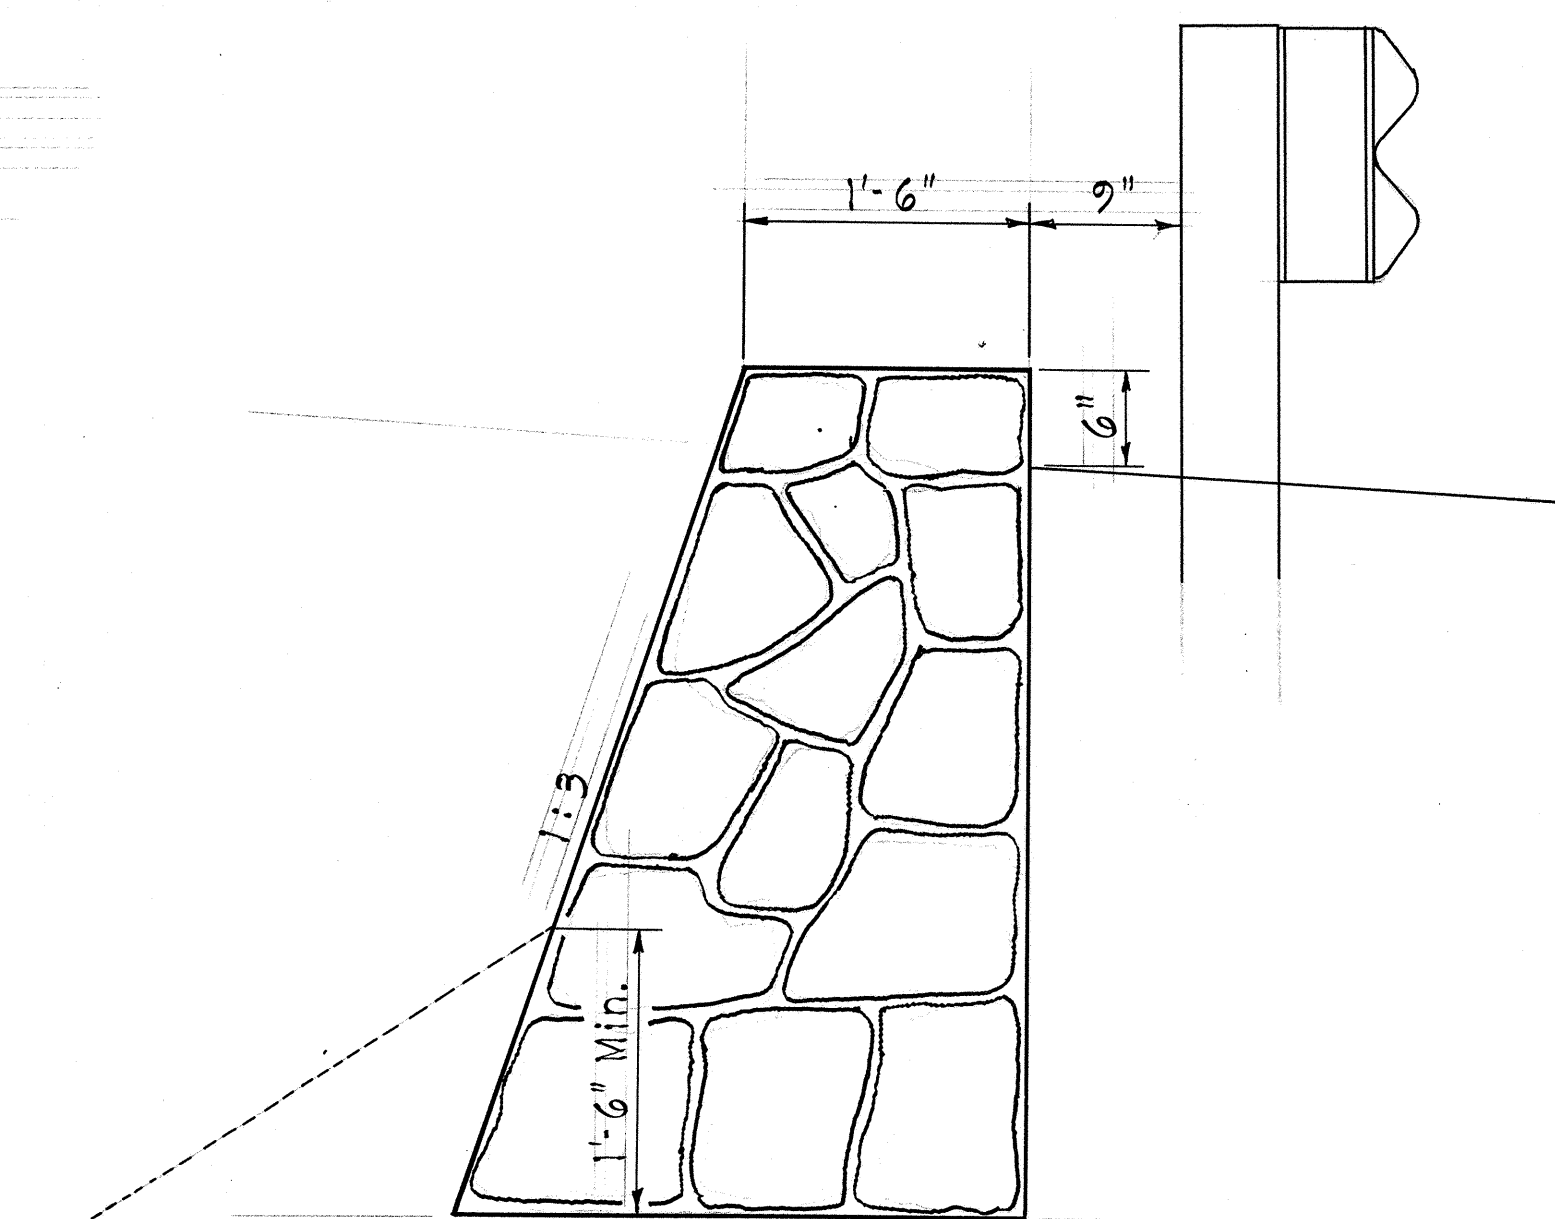
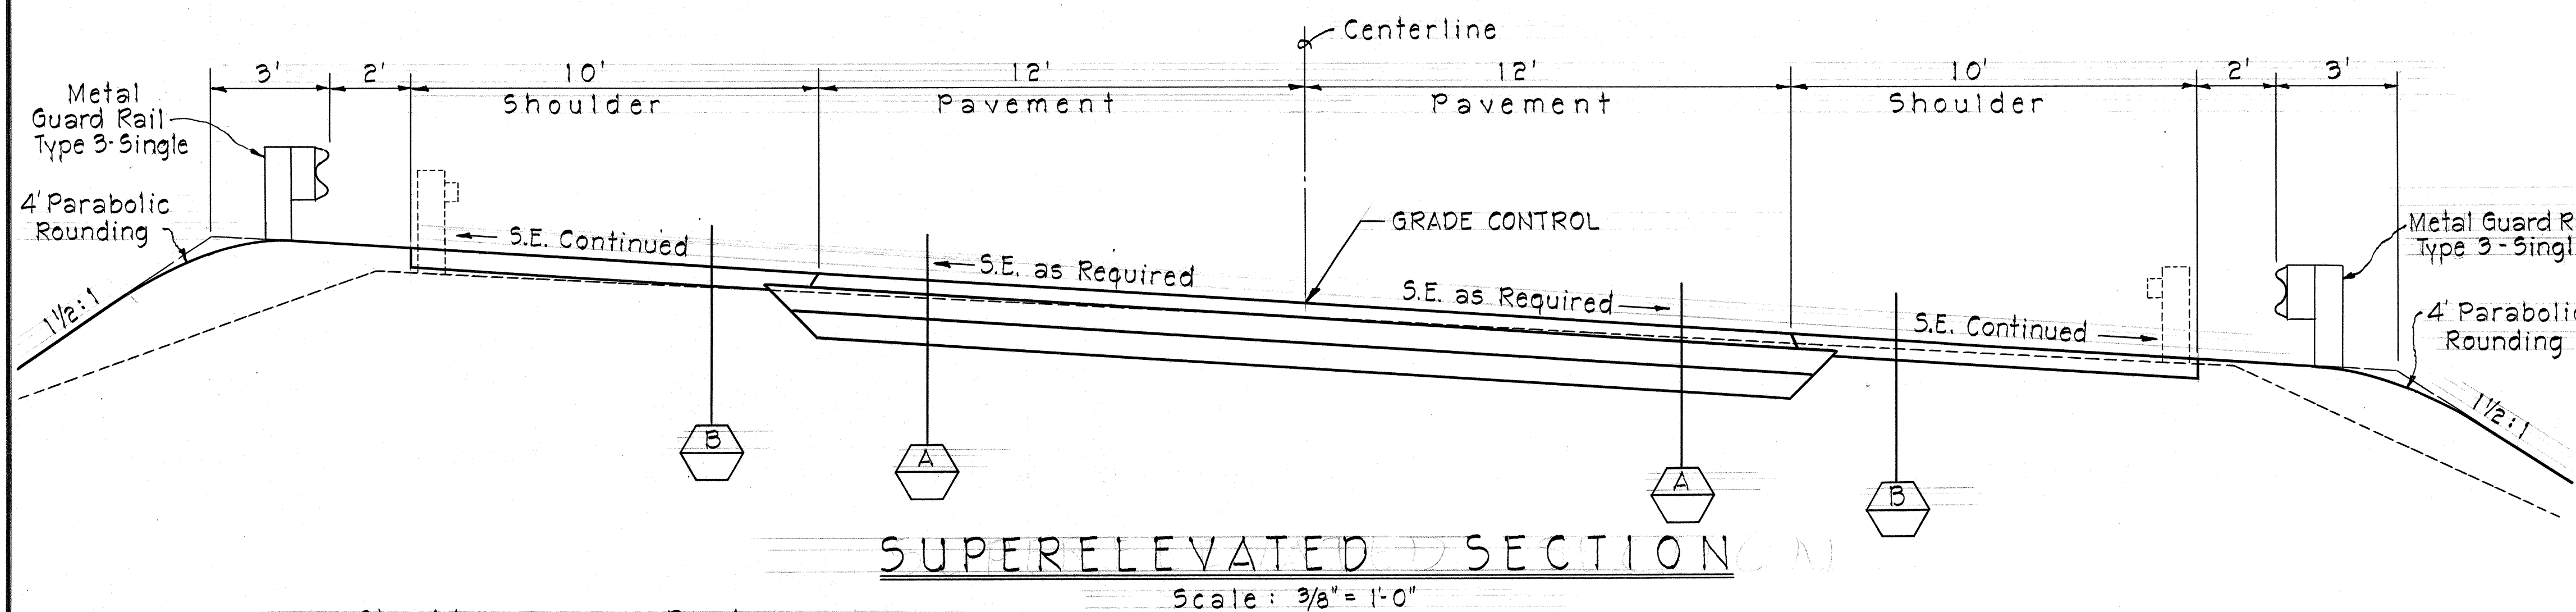


| FED. ROAD DIST. NO. | STATE | FED. AID PROJ. NO. | FISCAL YEAR | SHEET NO. | TOTAL SHEETS |
|---------------------|-------|--------------------|-------------|-----------|--------------|
| HAWAII              | HAW.  | RS-0540(1)         | 1973        | 2         | 46           |

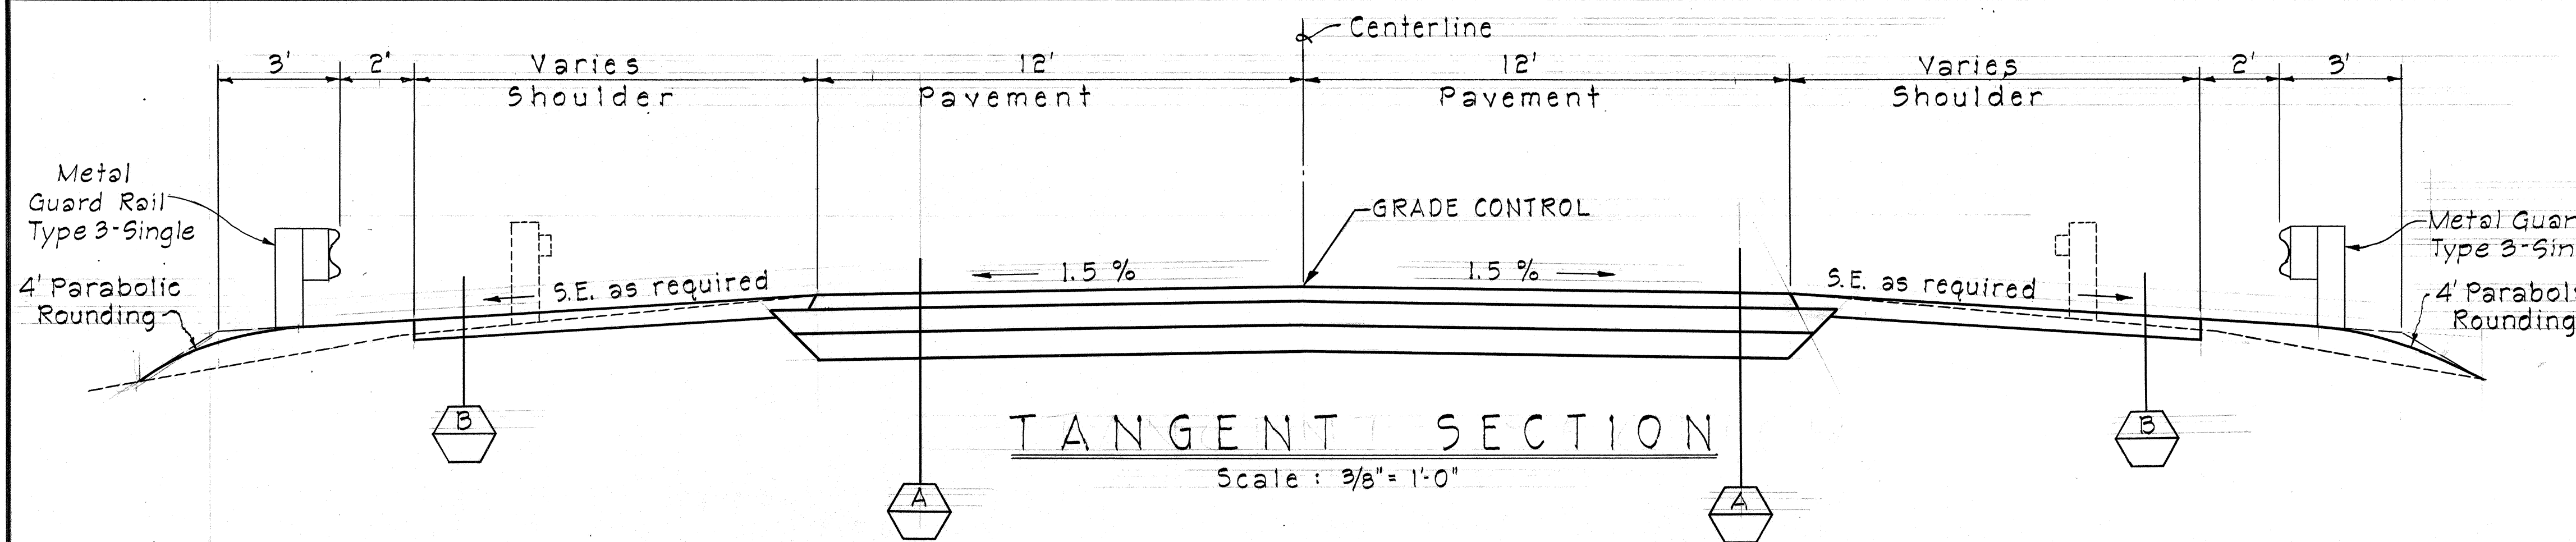

STATE OF HAWAII  
DEPARTMENT OF TRANSPORTATION  
HIGHWAYS DIVISION  
TYPICAL SECTIONS AND  
MISCELLANEOUS DETAILS  
HALEWILI ROAD  
REPLACEMENT OF WAHIAWA BRIDGE  
PROJECT NO. RS-0540(1)  
SHEET No. 1 OF 1 SHEETS

|                   |      |
|-------------------|------|
| SURVEY PLOTTED BY | DATE |
| DESIGNED BY       |      |
| TRACED BY         |      |
| NOTE BOOK         |      |
| CHECKED BY        |      |
| No.               |      |