
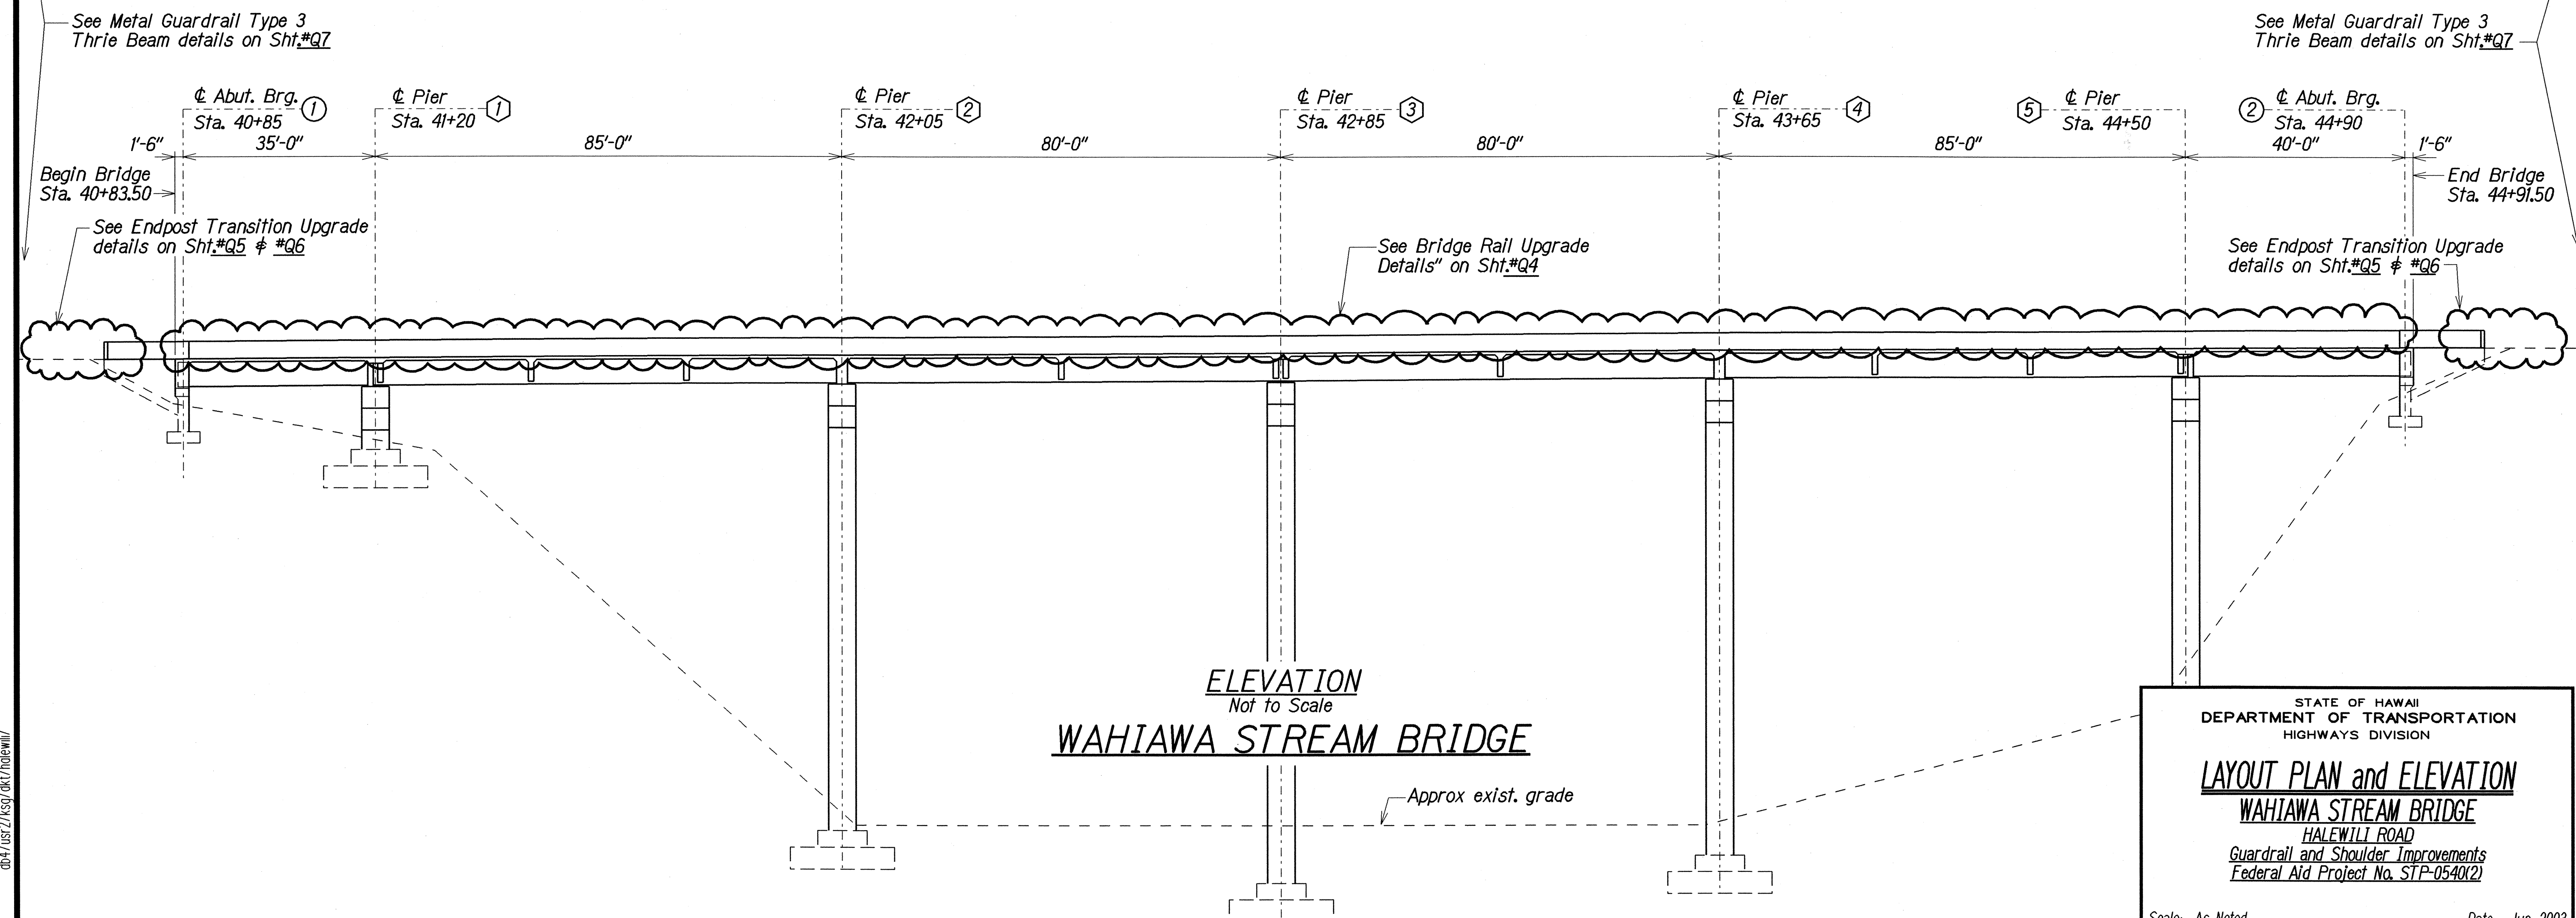


FED. ROAD DIST. NO.	STATE	FED. AID PROJ. NO.	FISCAL YEAR	SHEET NO.	TOTAL SHEETS
HAWAII	HAW.	STP-0540(2)	2004	18	23

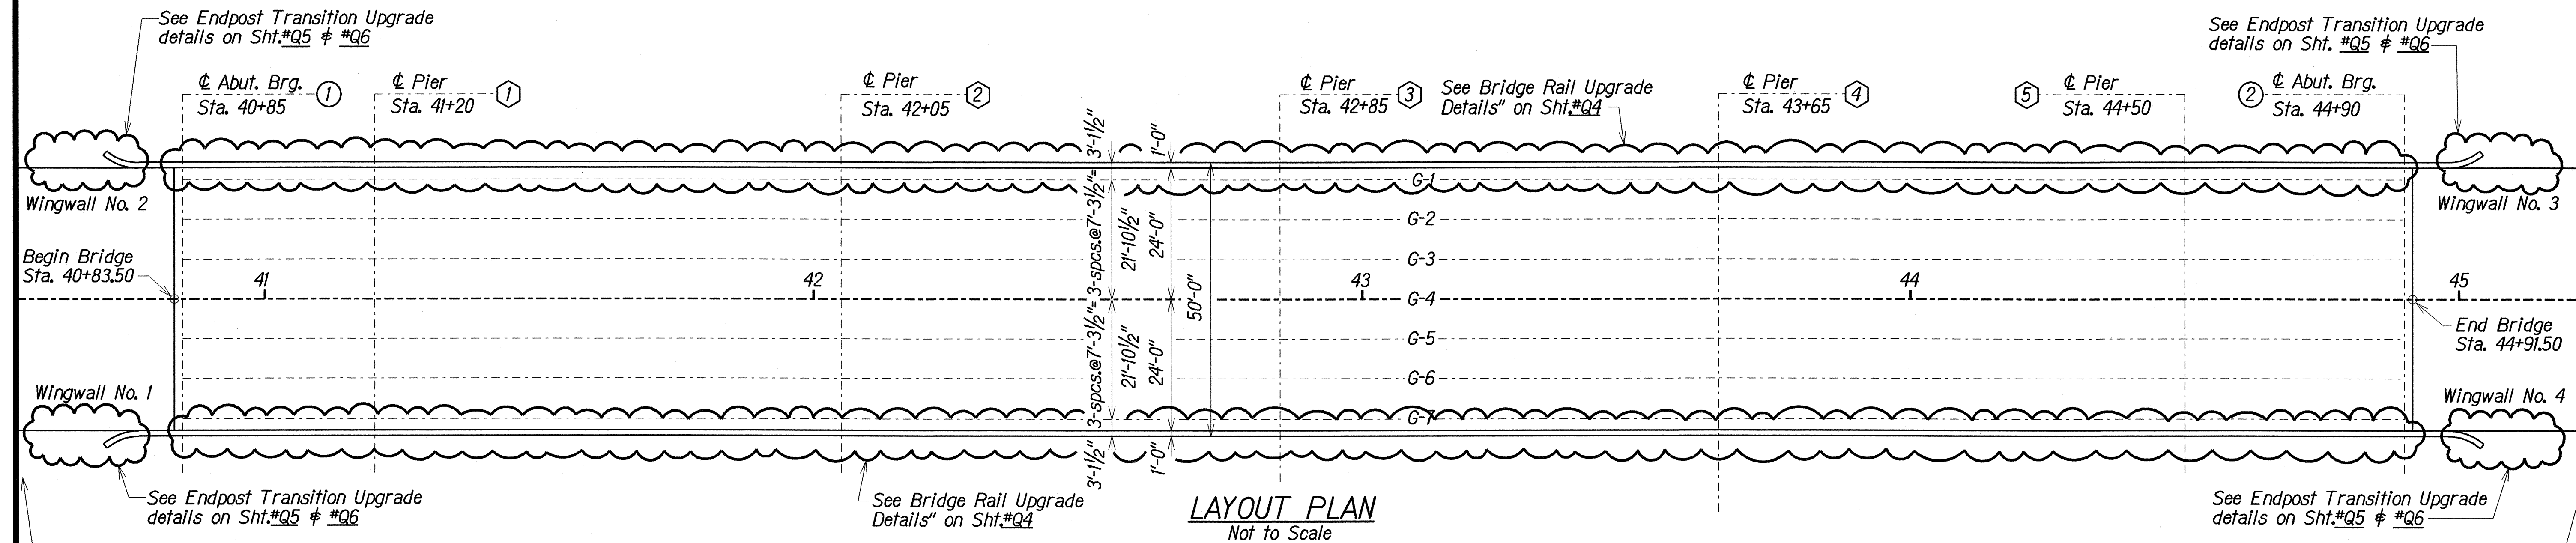

DESIGNED BY	DATE
TRACED BY	MAY 2003
DESIGNED BY	MAY 2003
QUANTITIES BY	MAY 2003
CHECKED BY	MAY 2003

db4 / jsg / dht / holewili

STATE OF HAWAII
DEPARTMENT OF TRANSPORTATION
HIGHWAYS DIVISION

LAYOUT PLAN and ELEVATION
WAHIAWA STREAM BRIDGE
HALEWILI ROAD
Guardrail and Shoulder Improvements
Federal Aid Project No. STP-0540(2)

Scale: As Noted Date: Jun, 2003

SHEET No. Q2 OF 7 SHEETS