


FED. ROAD DIST. NO.	STATE	FED. AID PROJ. NO.	FISCAL YEAR	SHEET NO.	TOTAL SHEETS
HAWAII	HAW.	STP-0540(3)	2006	11	12

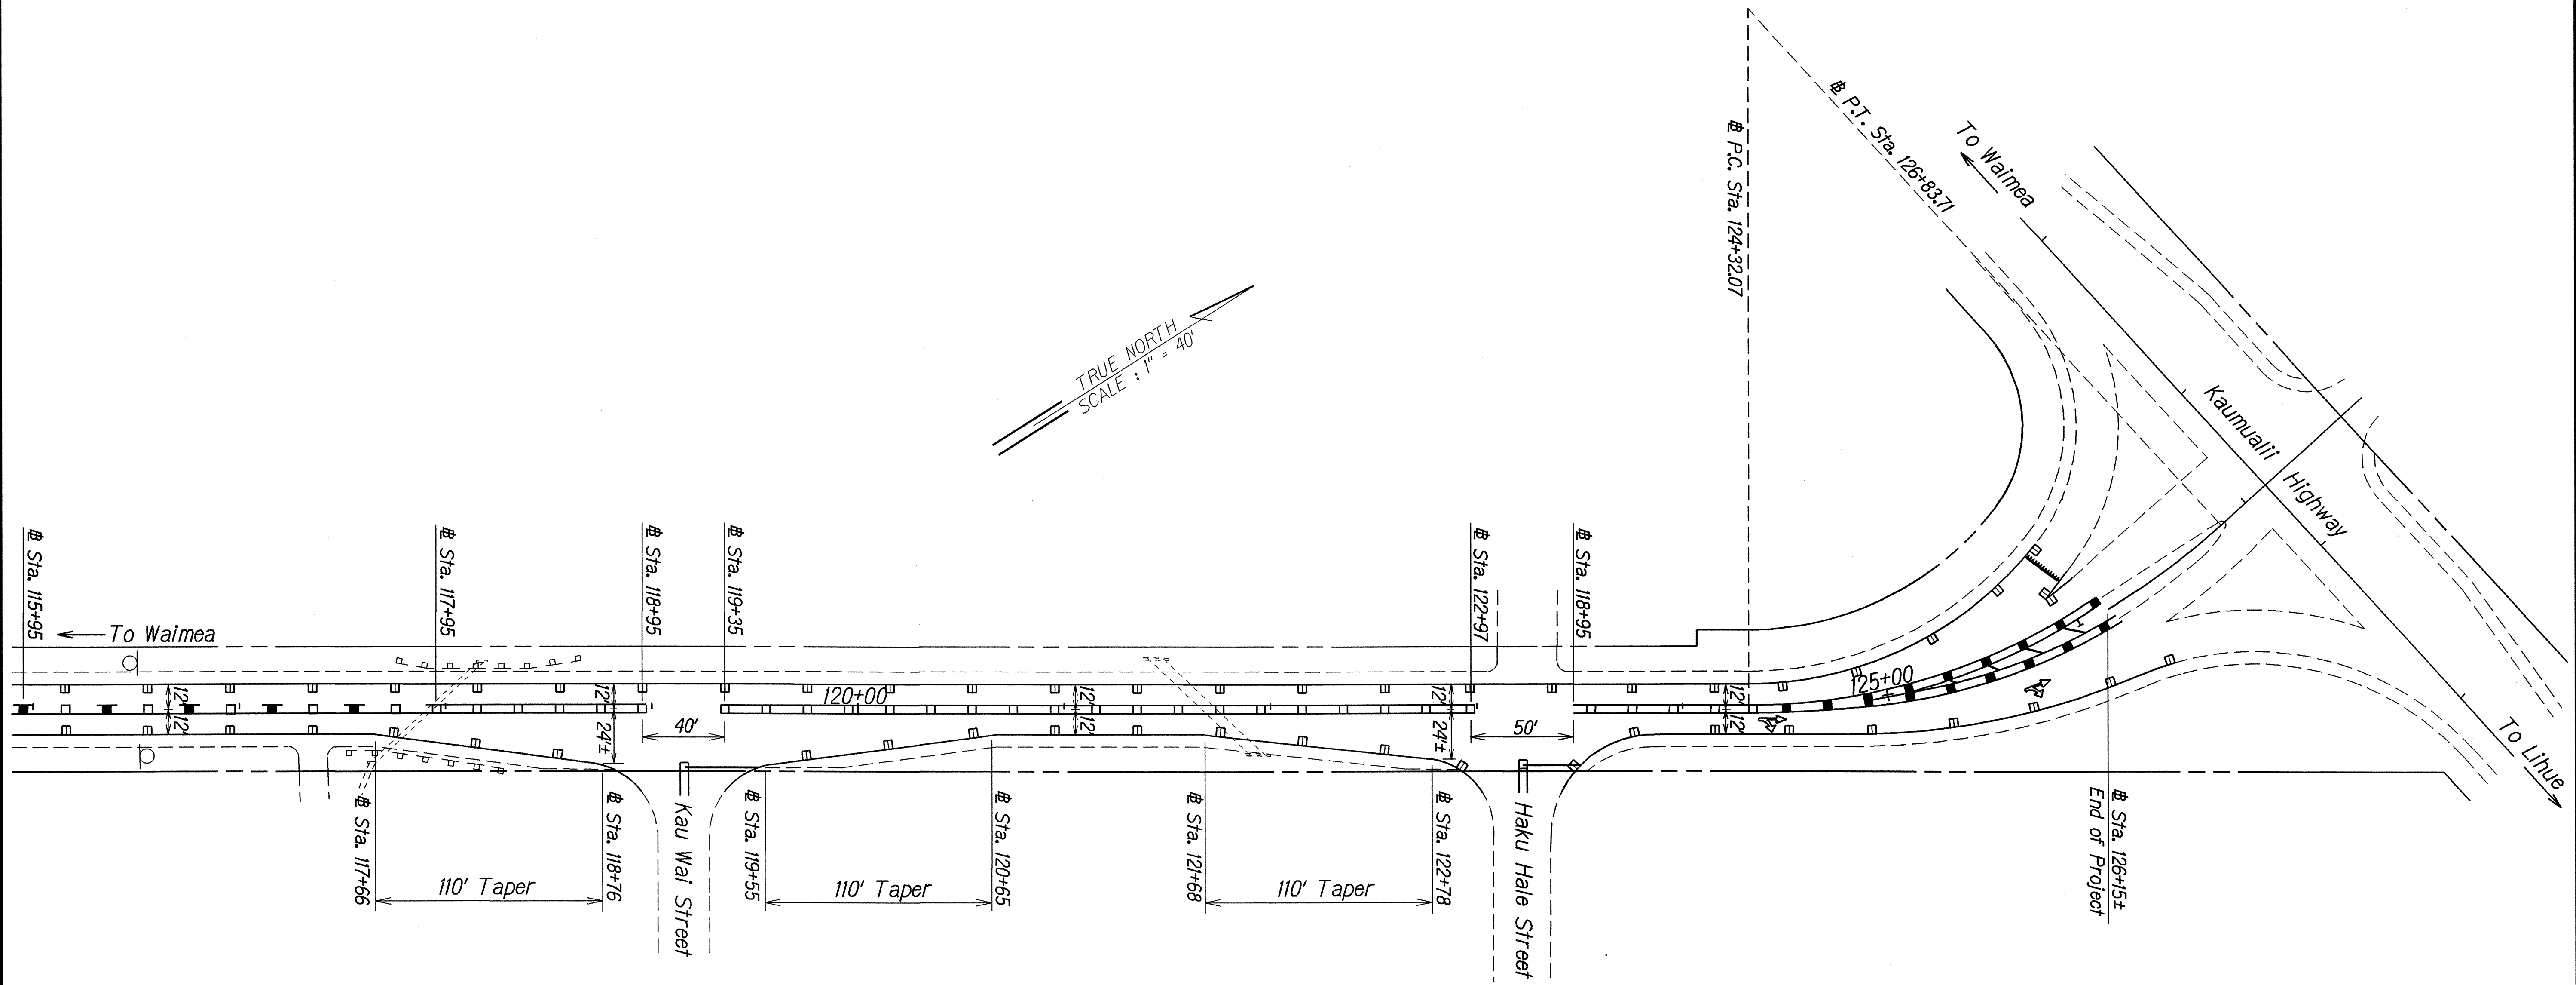

DATE	7/06
SURVEY PLOTTED BY	
DRAWN BY	
TRACED BY	
CHECKED BY	
NOTE BOOK	
ORIGINAL PLAN	

STATE OF HAWAII
DEPARTMENT OF TRANSPORTATION
HIGHWAYS DIVISION

PAVEMENT MARKING & STRIPING
DETAIL AT INTERSECTIONS
HALEWILI ROAD
PAVEMENT PREVENTIVE MAINTENANCE
Vicinity of M.P. 1.0 to Kaunualii Highway
Federal-Aid Project No. STP-0540(3)
Scale: 1" = 40' Date: April 2006

SHEET No. 1 OF 1 SHEETS