

INDEX TO DRAWINGS	
SHEET NO.	DESCRIPTION
1	TITLE SHEET
2 - 3	DETAILS
4 - 9	STANDARD DETAILS
10	PROJECT INFORMATION SIGN

STATE OF HAWAII

DEPARTMENT OF TRANSPORTATION

HIGHWAYS DIVISION

"AS BUILT"



PLANS FOR

WAIMEA CANYON DRIVE IMPROVEMENTS

PROJ. NO. 550A-01-70

DISTRICT OF WAIMEA

ISLAND OF KAUAI

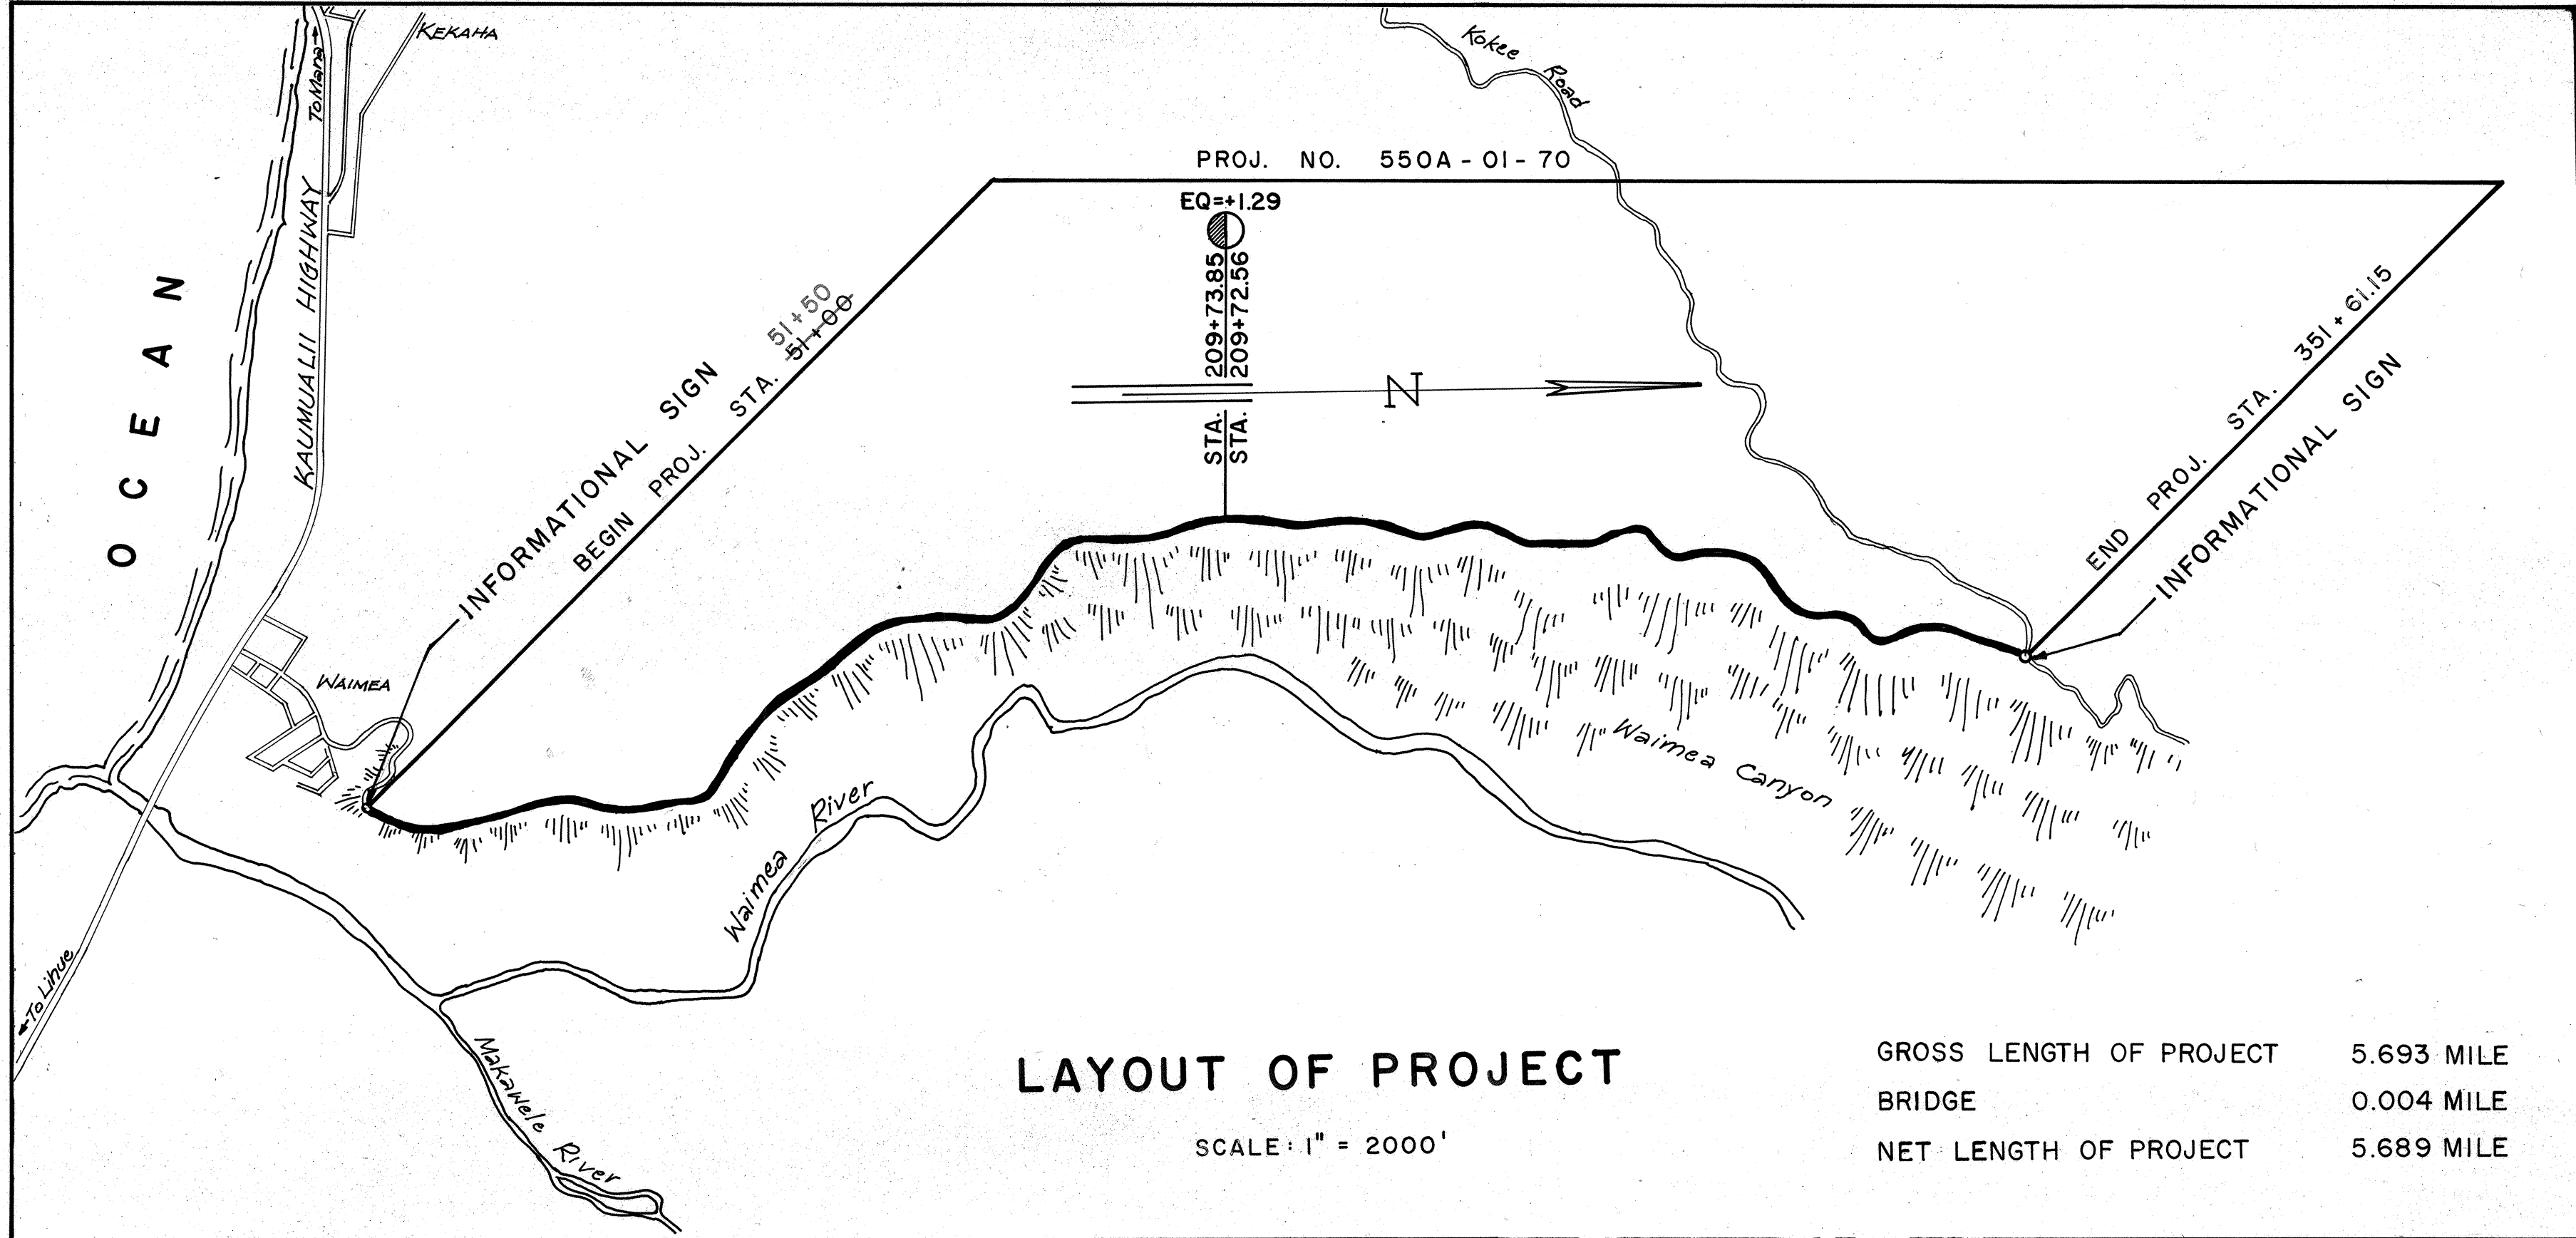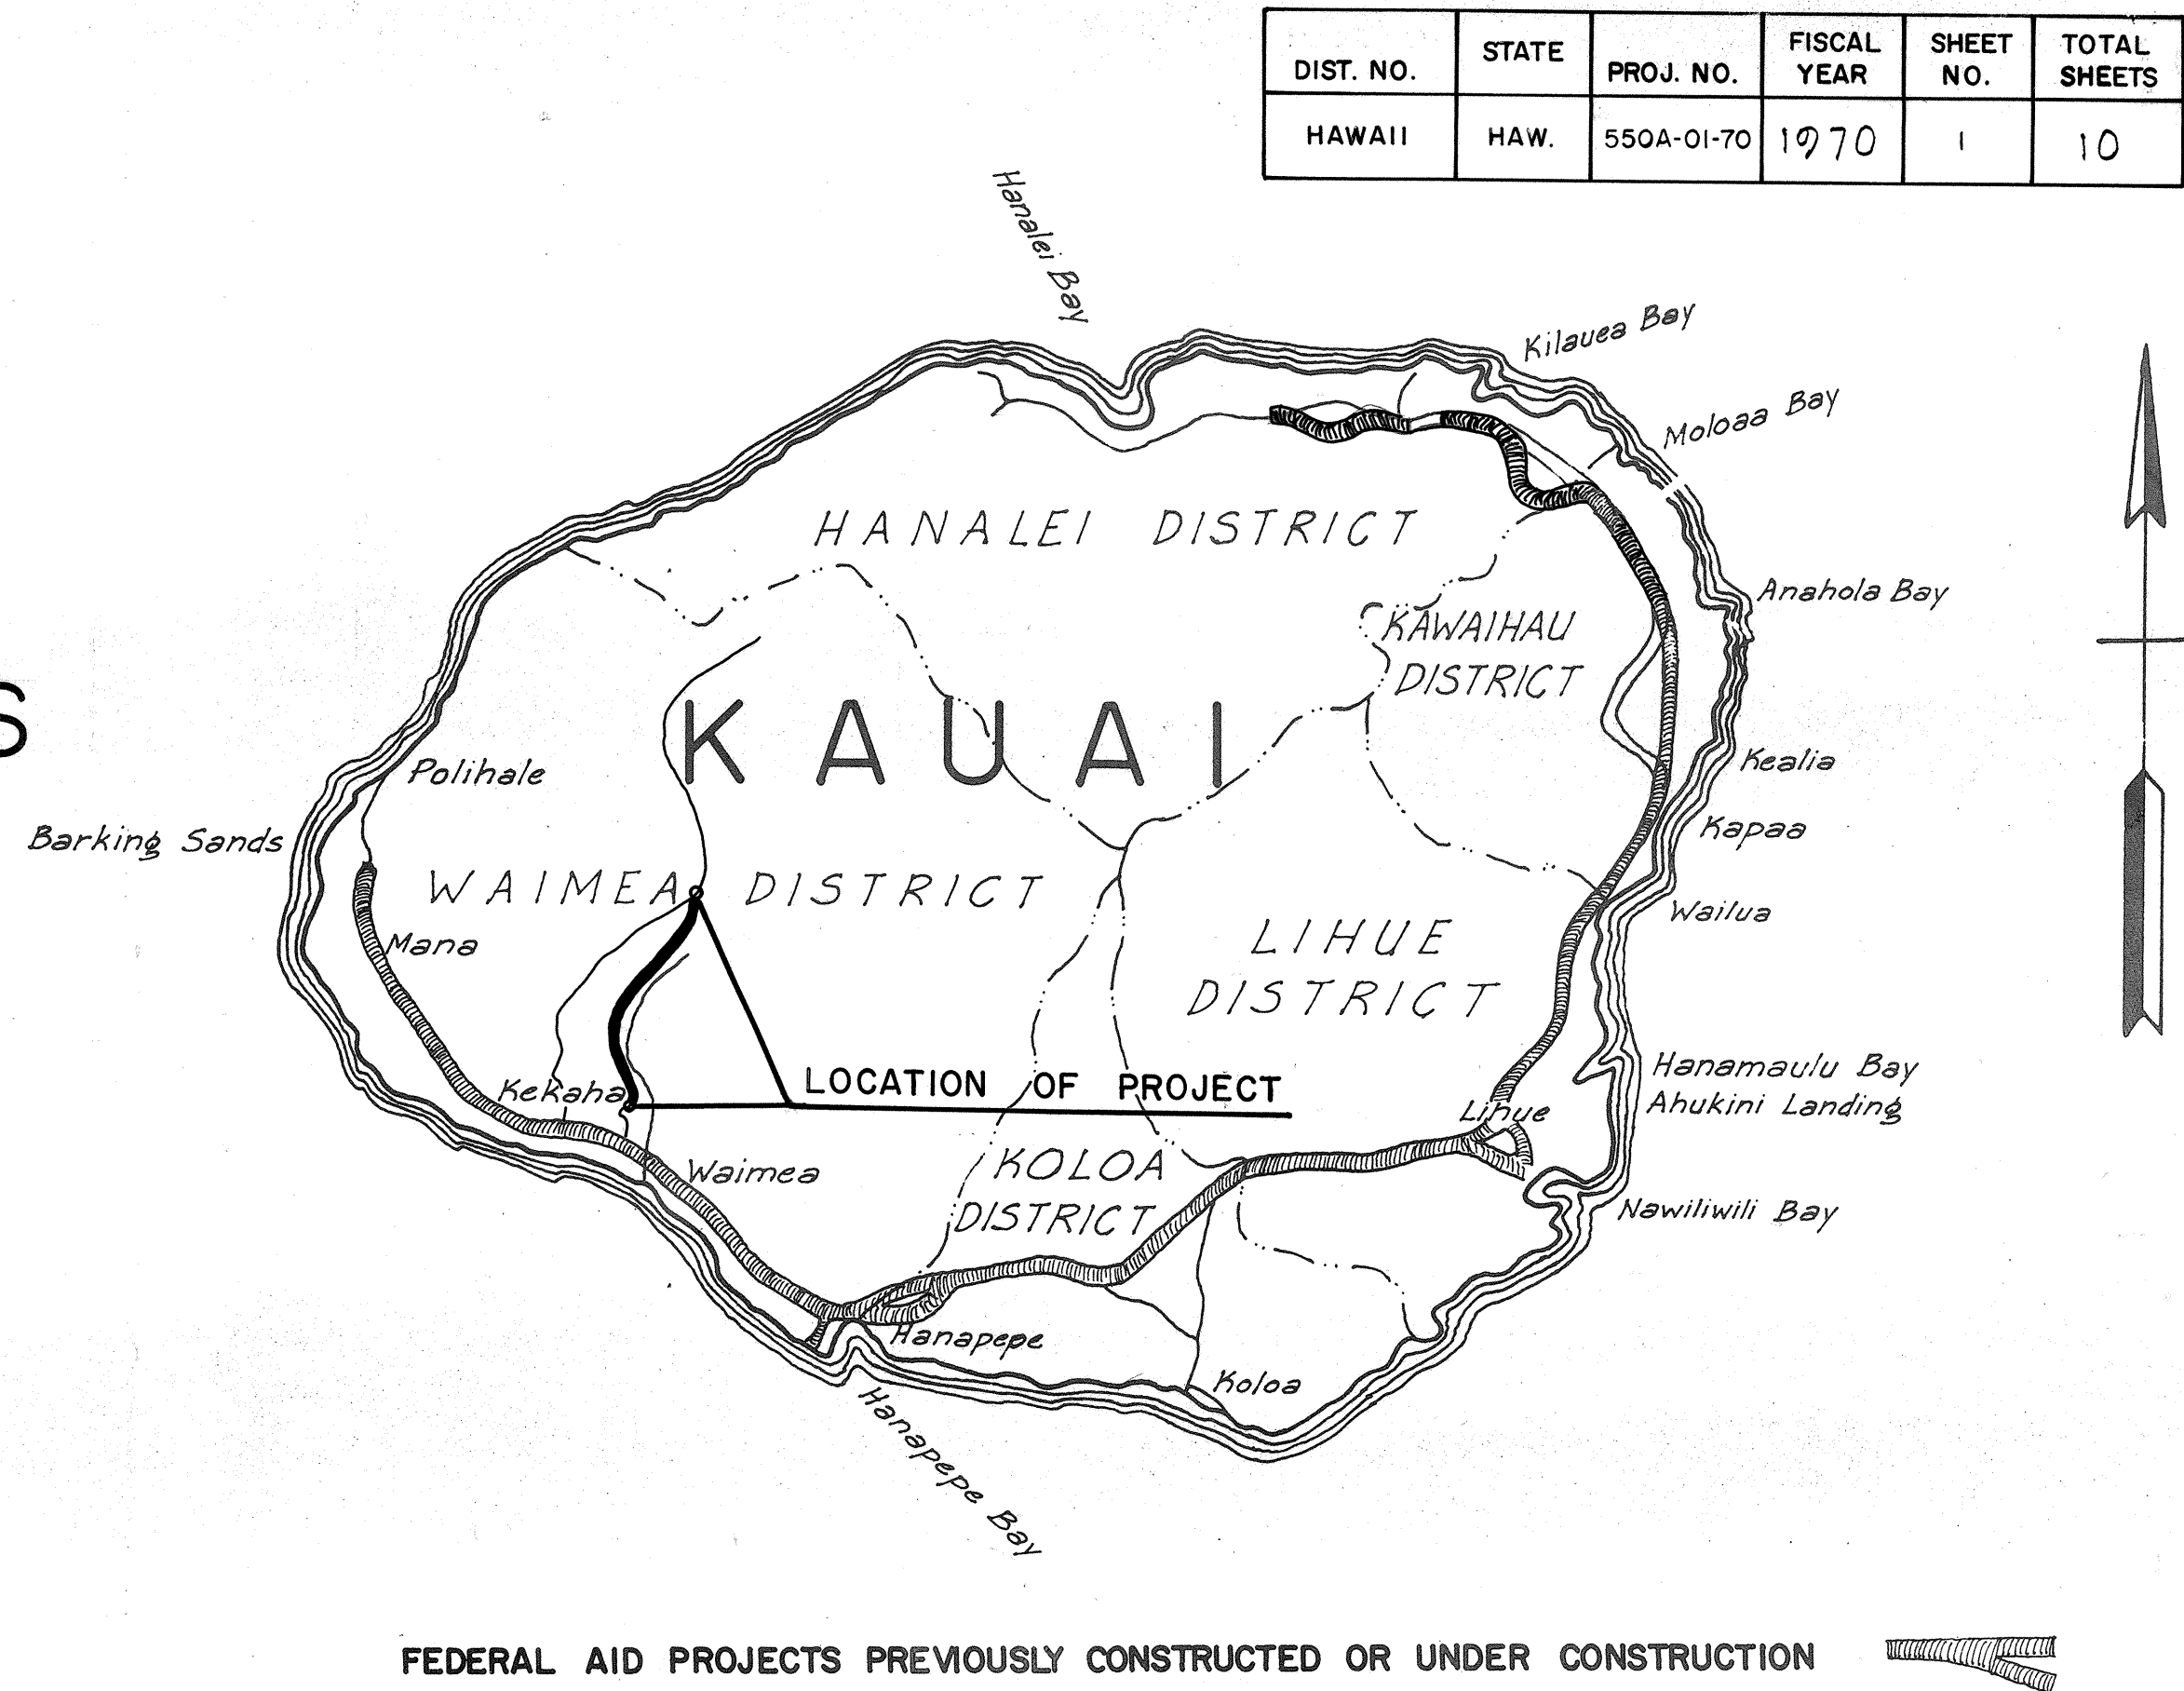

NOTE:

ALL CHANGES MADE DURING CONSTRUCTION
HAVE BEEN INCORPORATED ON THESE
PLANS IN RED EXCEPT CHANGES IN THE
ORIGINAL THEORETICAL QUANTITIES.

Donald Nagamine

PROJECT ENGINEER

3-11-81

DATE

DEPARTMENT OF TRANSPORTATION STATE OF HAWAII	
APPROVED:	
<i>E. Avery Wright</i>	3/18/70
for DIR. OF TRANSPORTATION	DATE

MAR. 1970

Date

Phone- Loc.

D. BEVIER

PS&E By

Kauai District

Designed By

SURVEY PLOTTED BY	DATE
DESIGNED BY	
TRACED BY	
QUANTITIES BY	
CHECKED BY	
NOTE BOOK	
No.	

GROSS LENGTH OF PROJECT	5.693 MILE
BRIDGE	0.004 MILE
NET LENGTH OF PROJECT	5.689 MILE

LAYOUT OF PROJECT

SCALE: 1" = 2000'