



PLAN	SURVEYED	BY	DATE
	PLOTTED		
	NOTE BOOK		
	NO.		

PROFILE	SURVEYED	BY	DATE
	PLOTTED		
	NOTE BOOK		
	NO.		


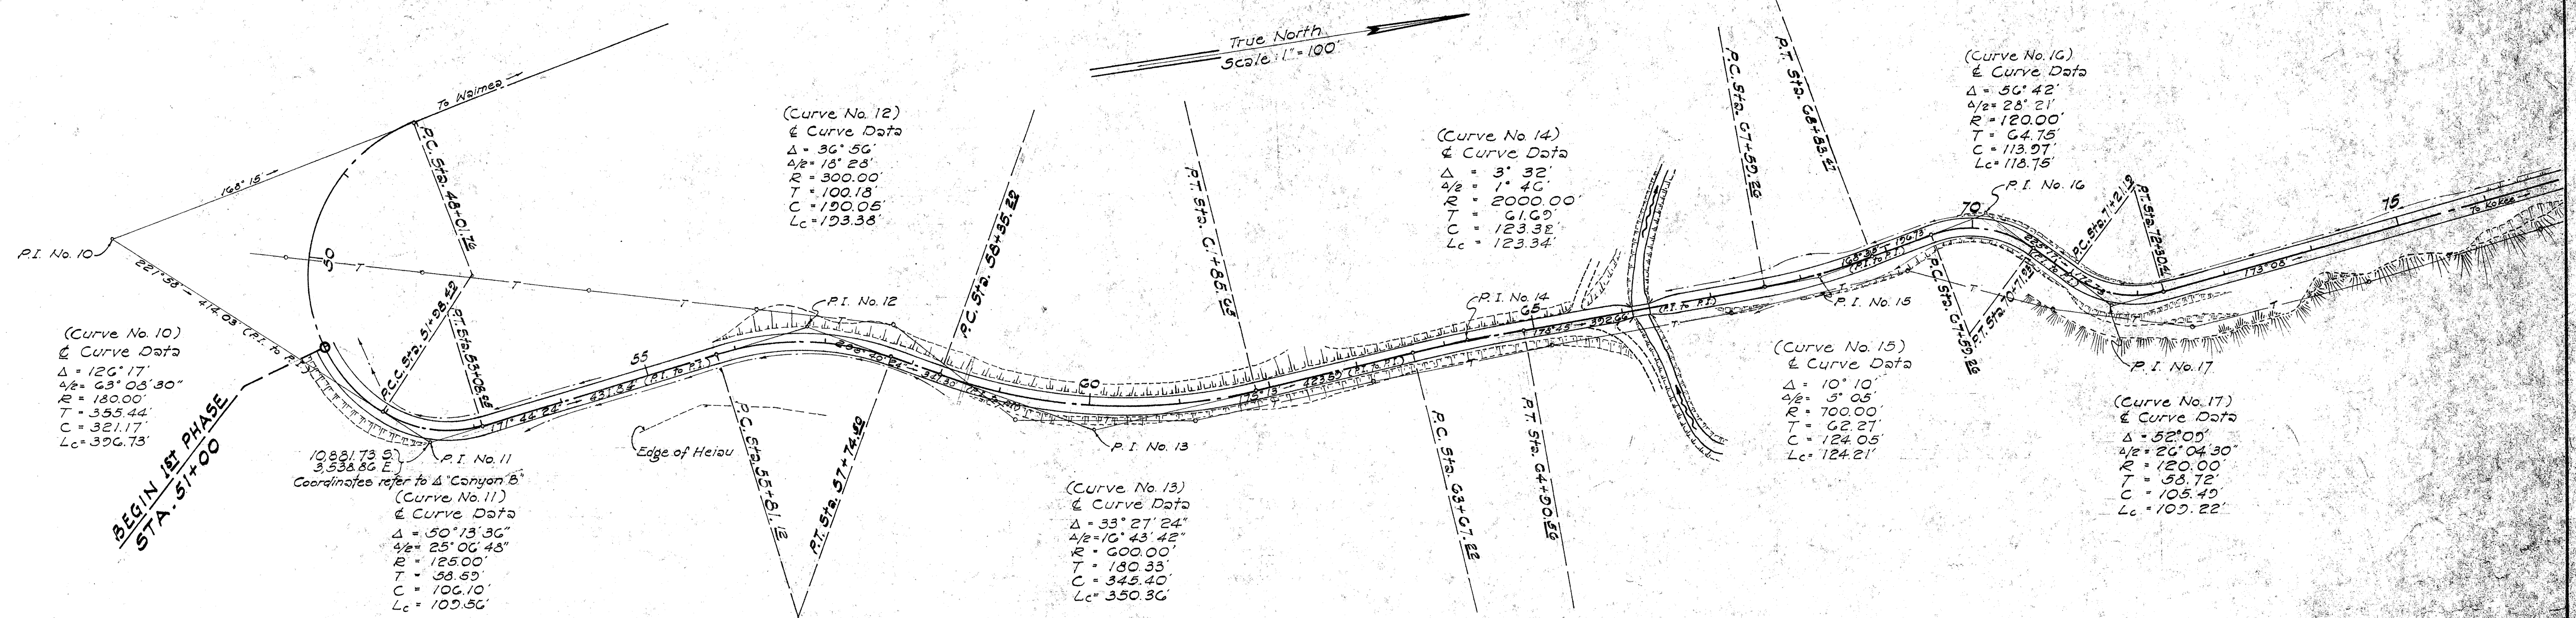


DO NOT REMOVE
USE FOR HORIZONTAL CONTROL
AND CURVE DATA

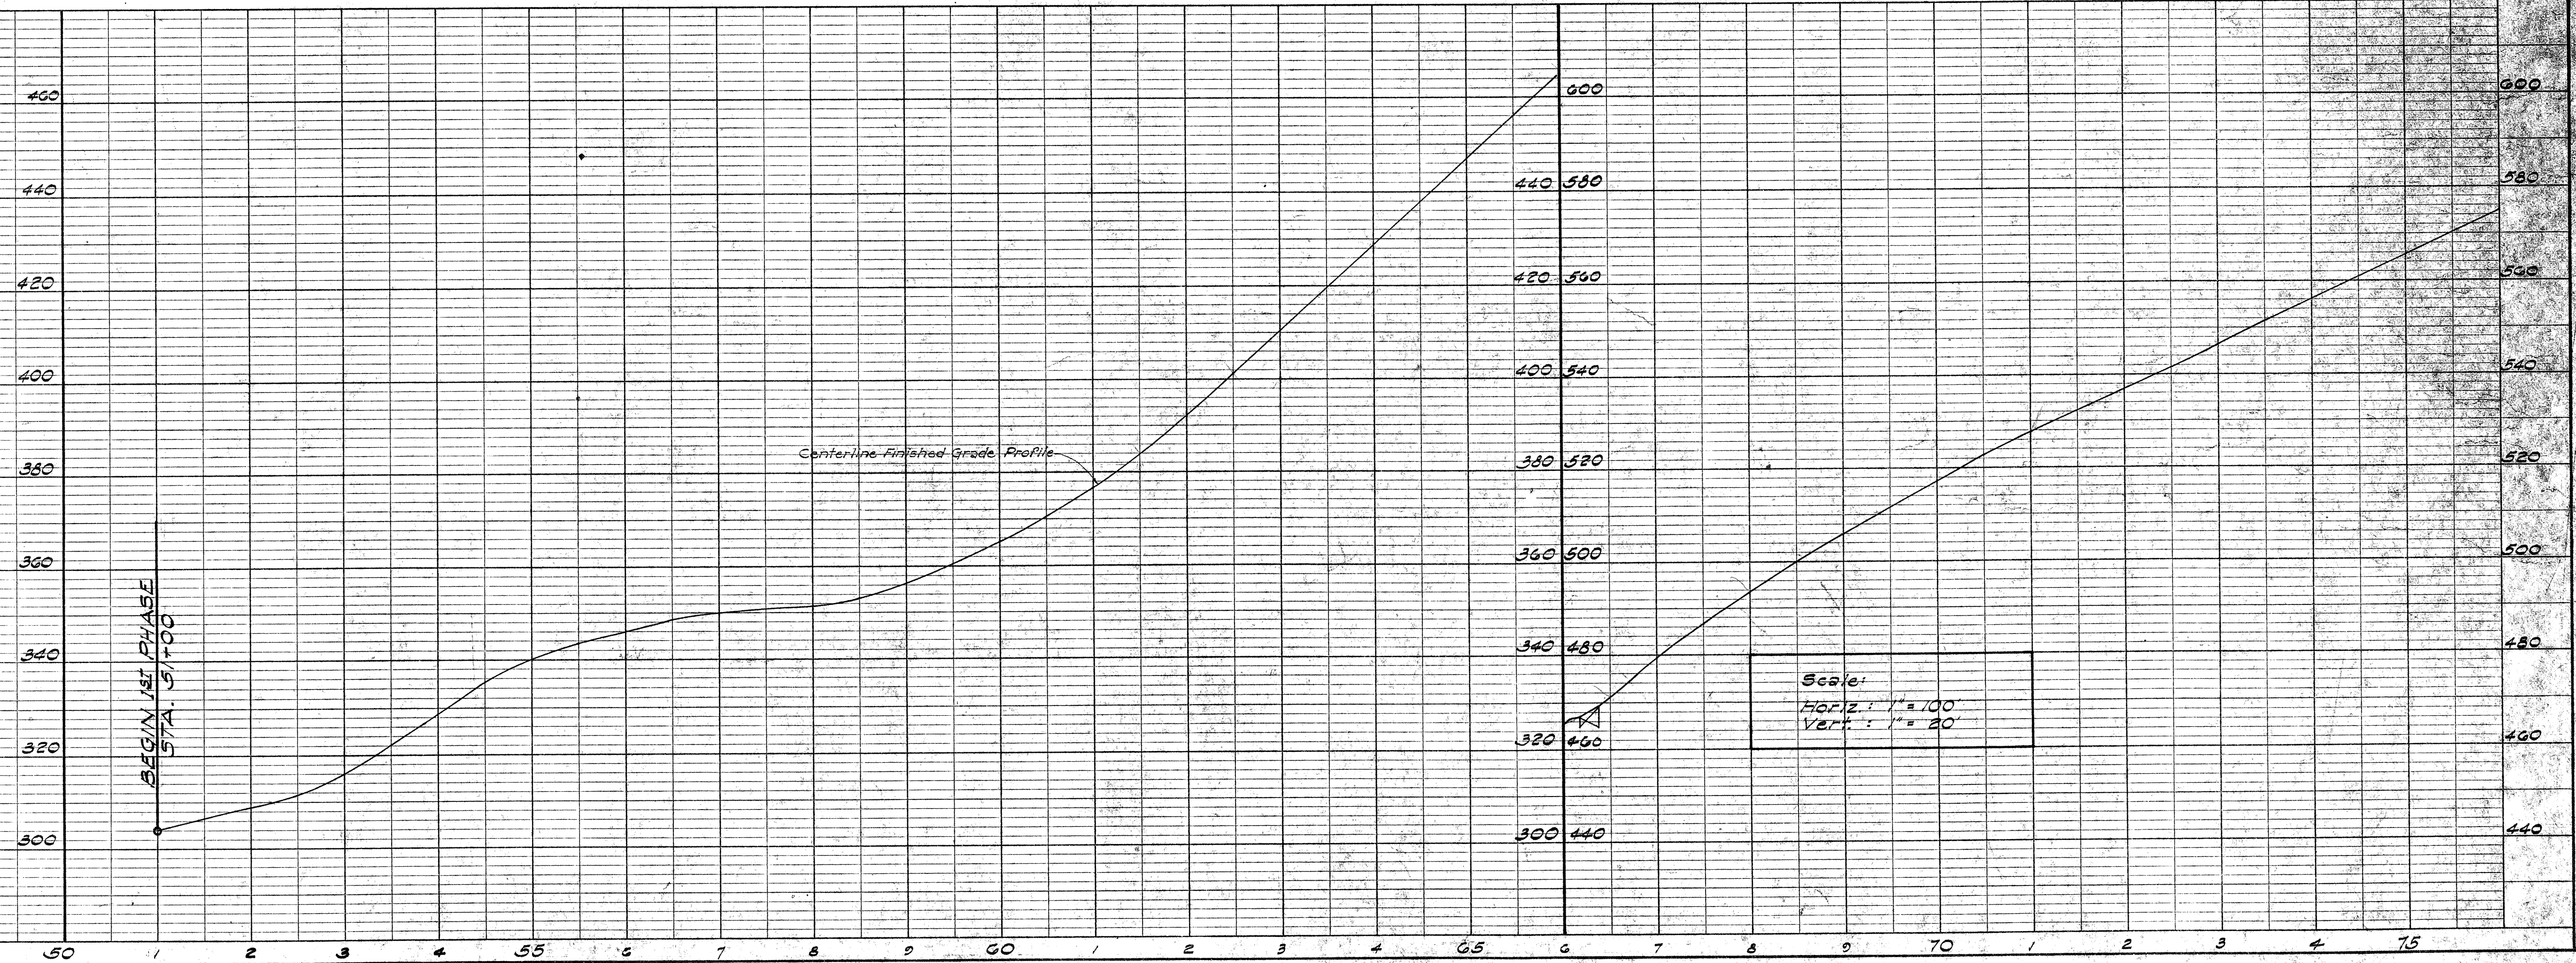


PLAN	DATE
BY	
NO.	
SURVEYED PLOTTED NOTE BOOK ALIGNMENT CHECKED RT. OF WAY CHECKED	

PROFILE	DATE
BY	
NO.	
SURVEYED PLOTTED NOTE BOOK GRADES CHECKED B.M. NOTED STUDY OF GRADES NOTED	

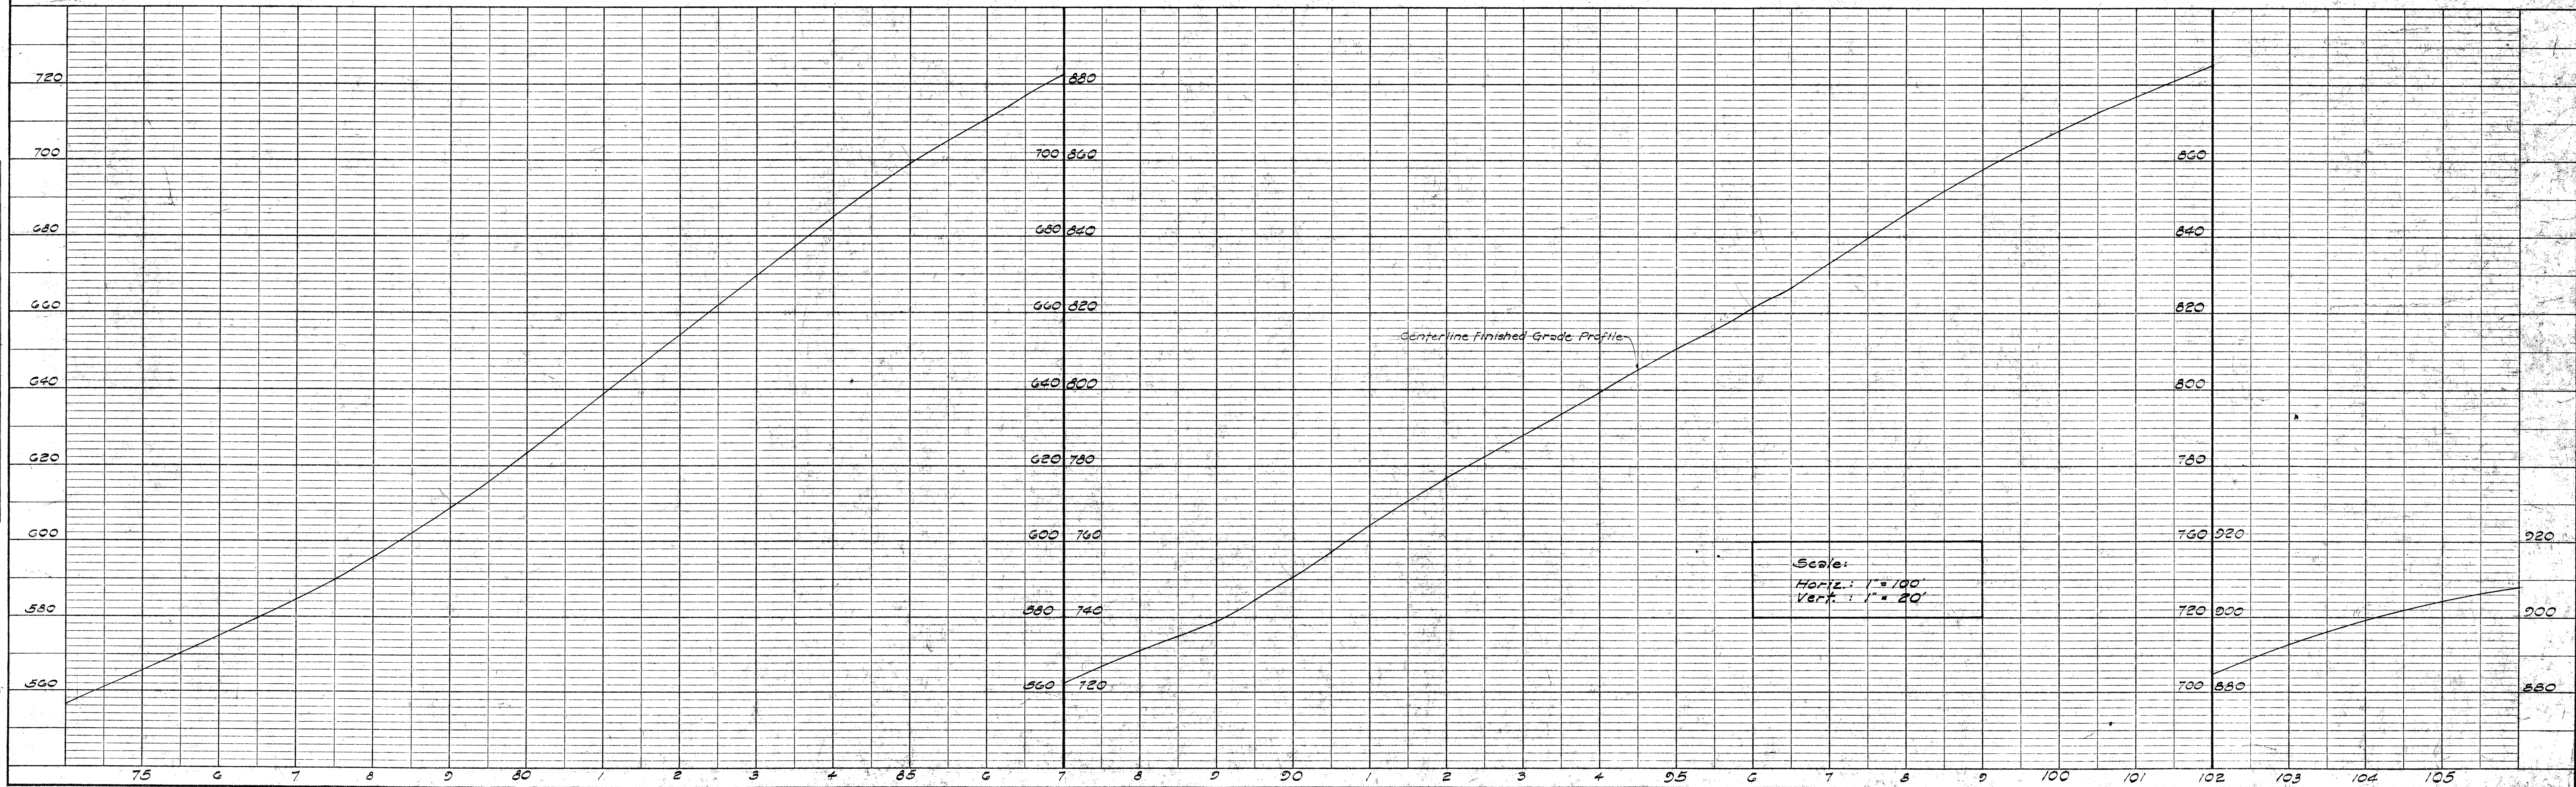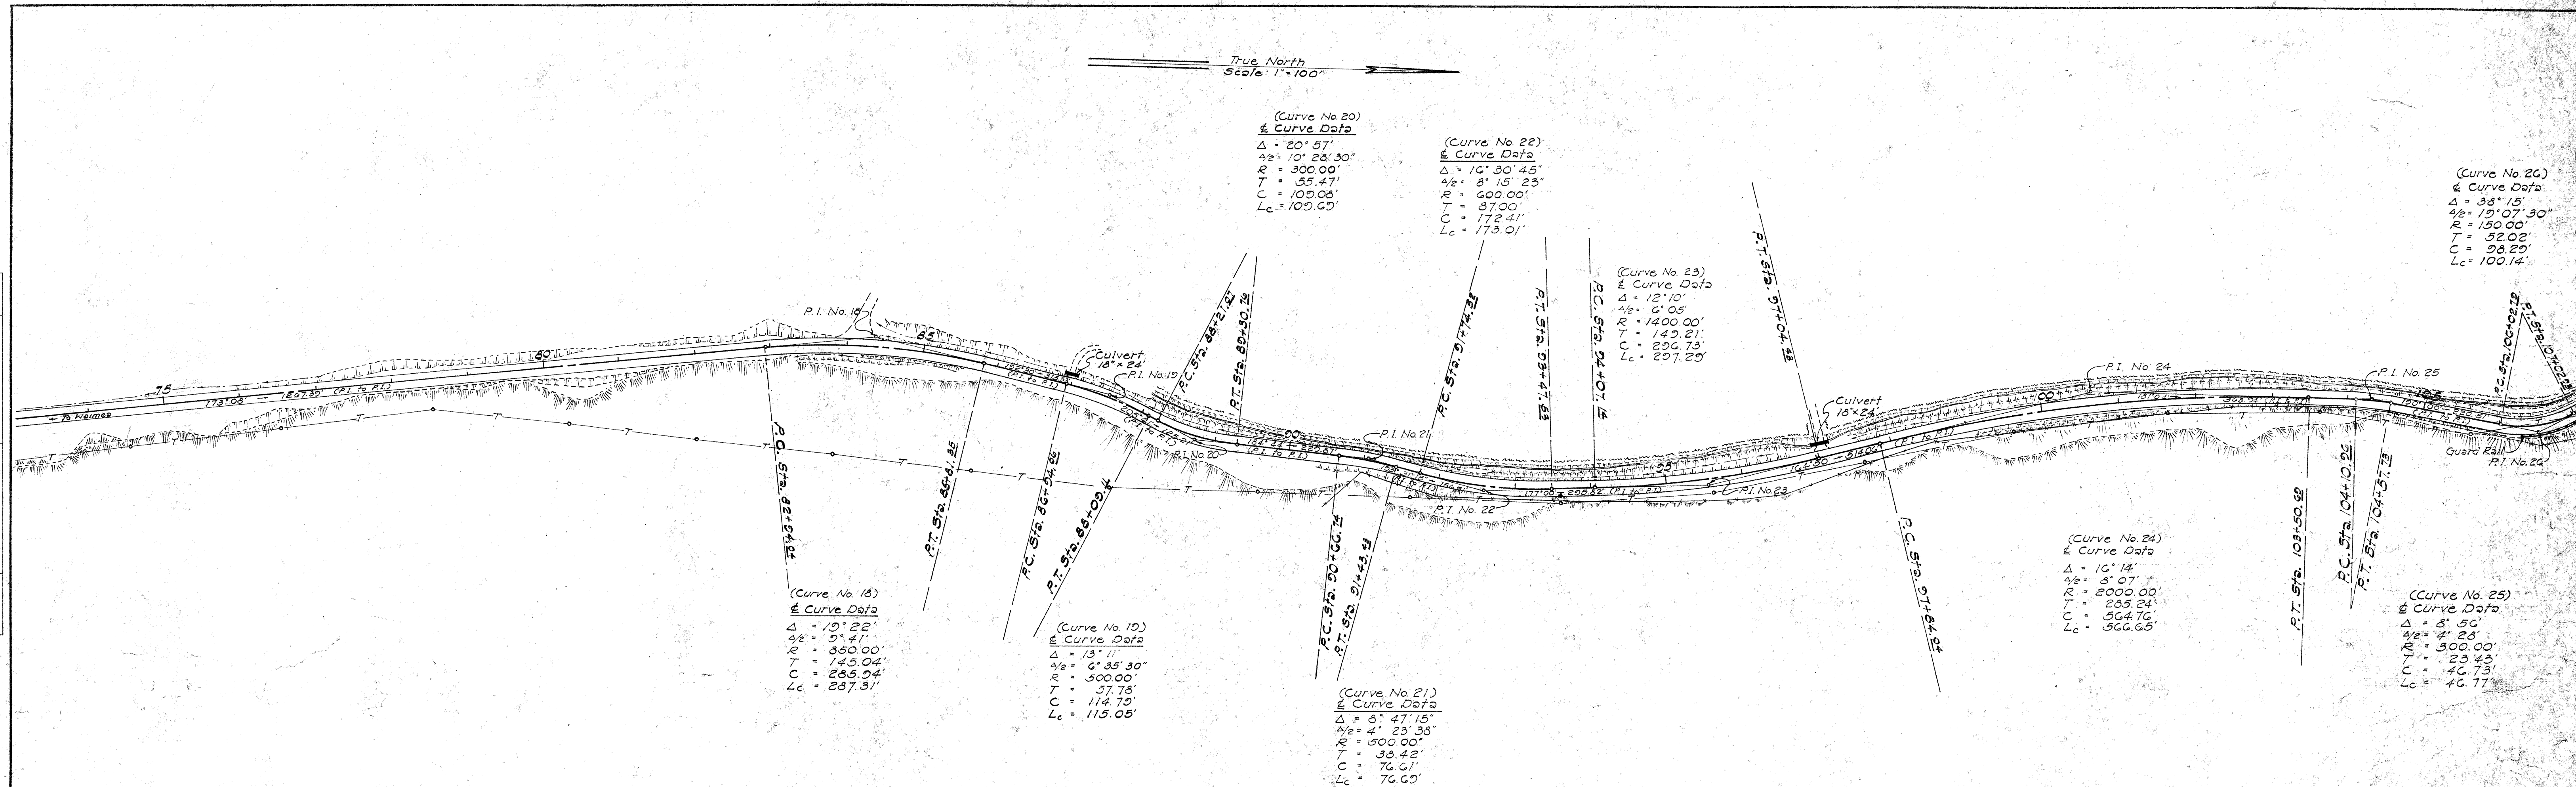



PLAN	SURVEYED	DATE
	PLOTTED	BY
	ALIGNMENT CHECKED	
	RT. OF WAY CHECKED	
NOTE BOOK NO.		

PROFILE	SURVEYED	DATE
	PLOTTED	BY
	GRADES CHECKED	
	STRUCTURE NOTATIONS CHKG	
NOTE BOOK NO.		

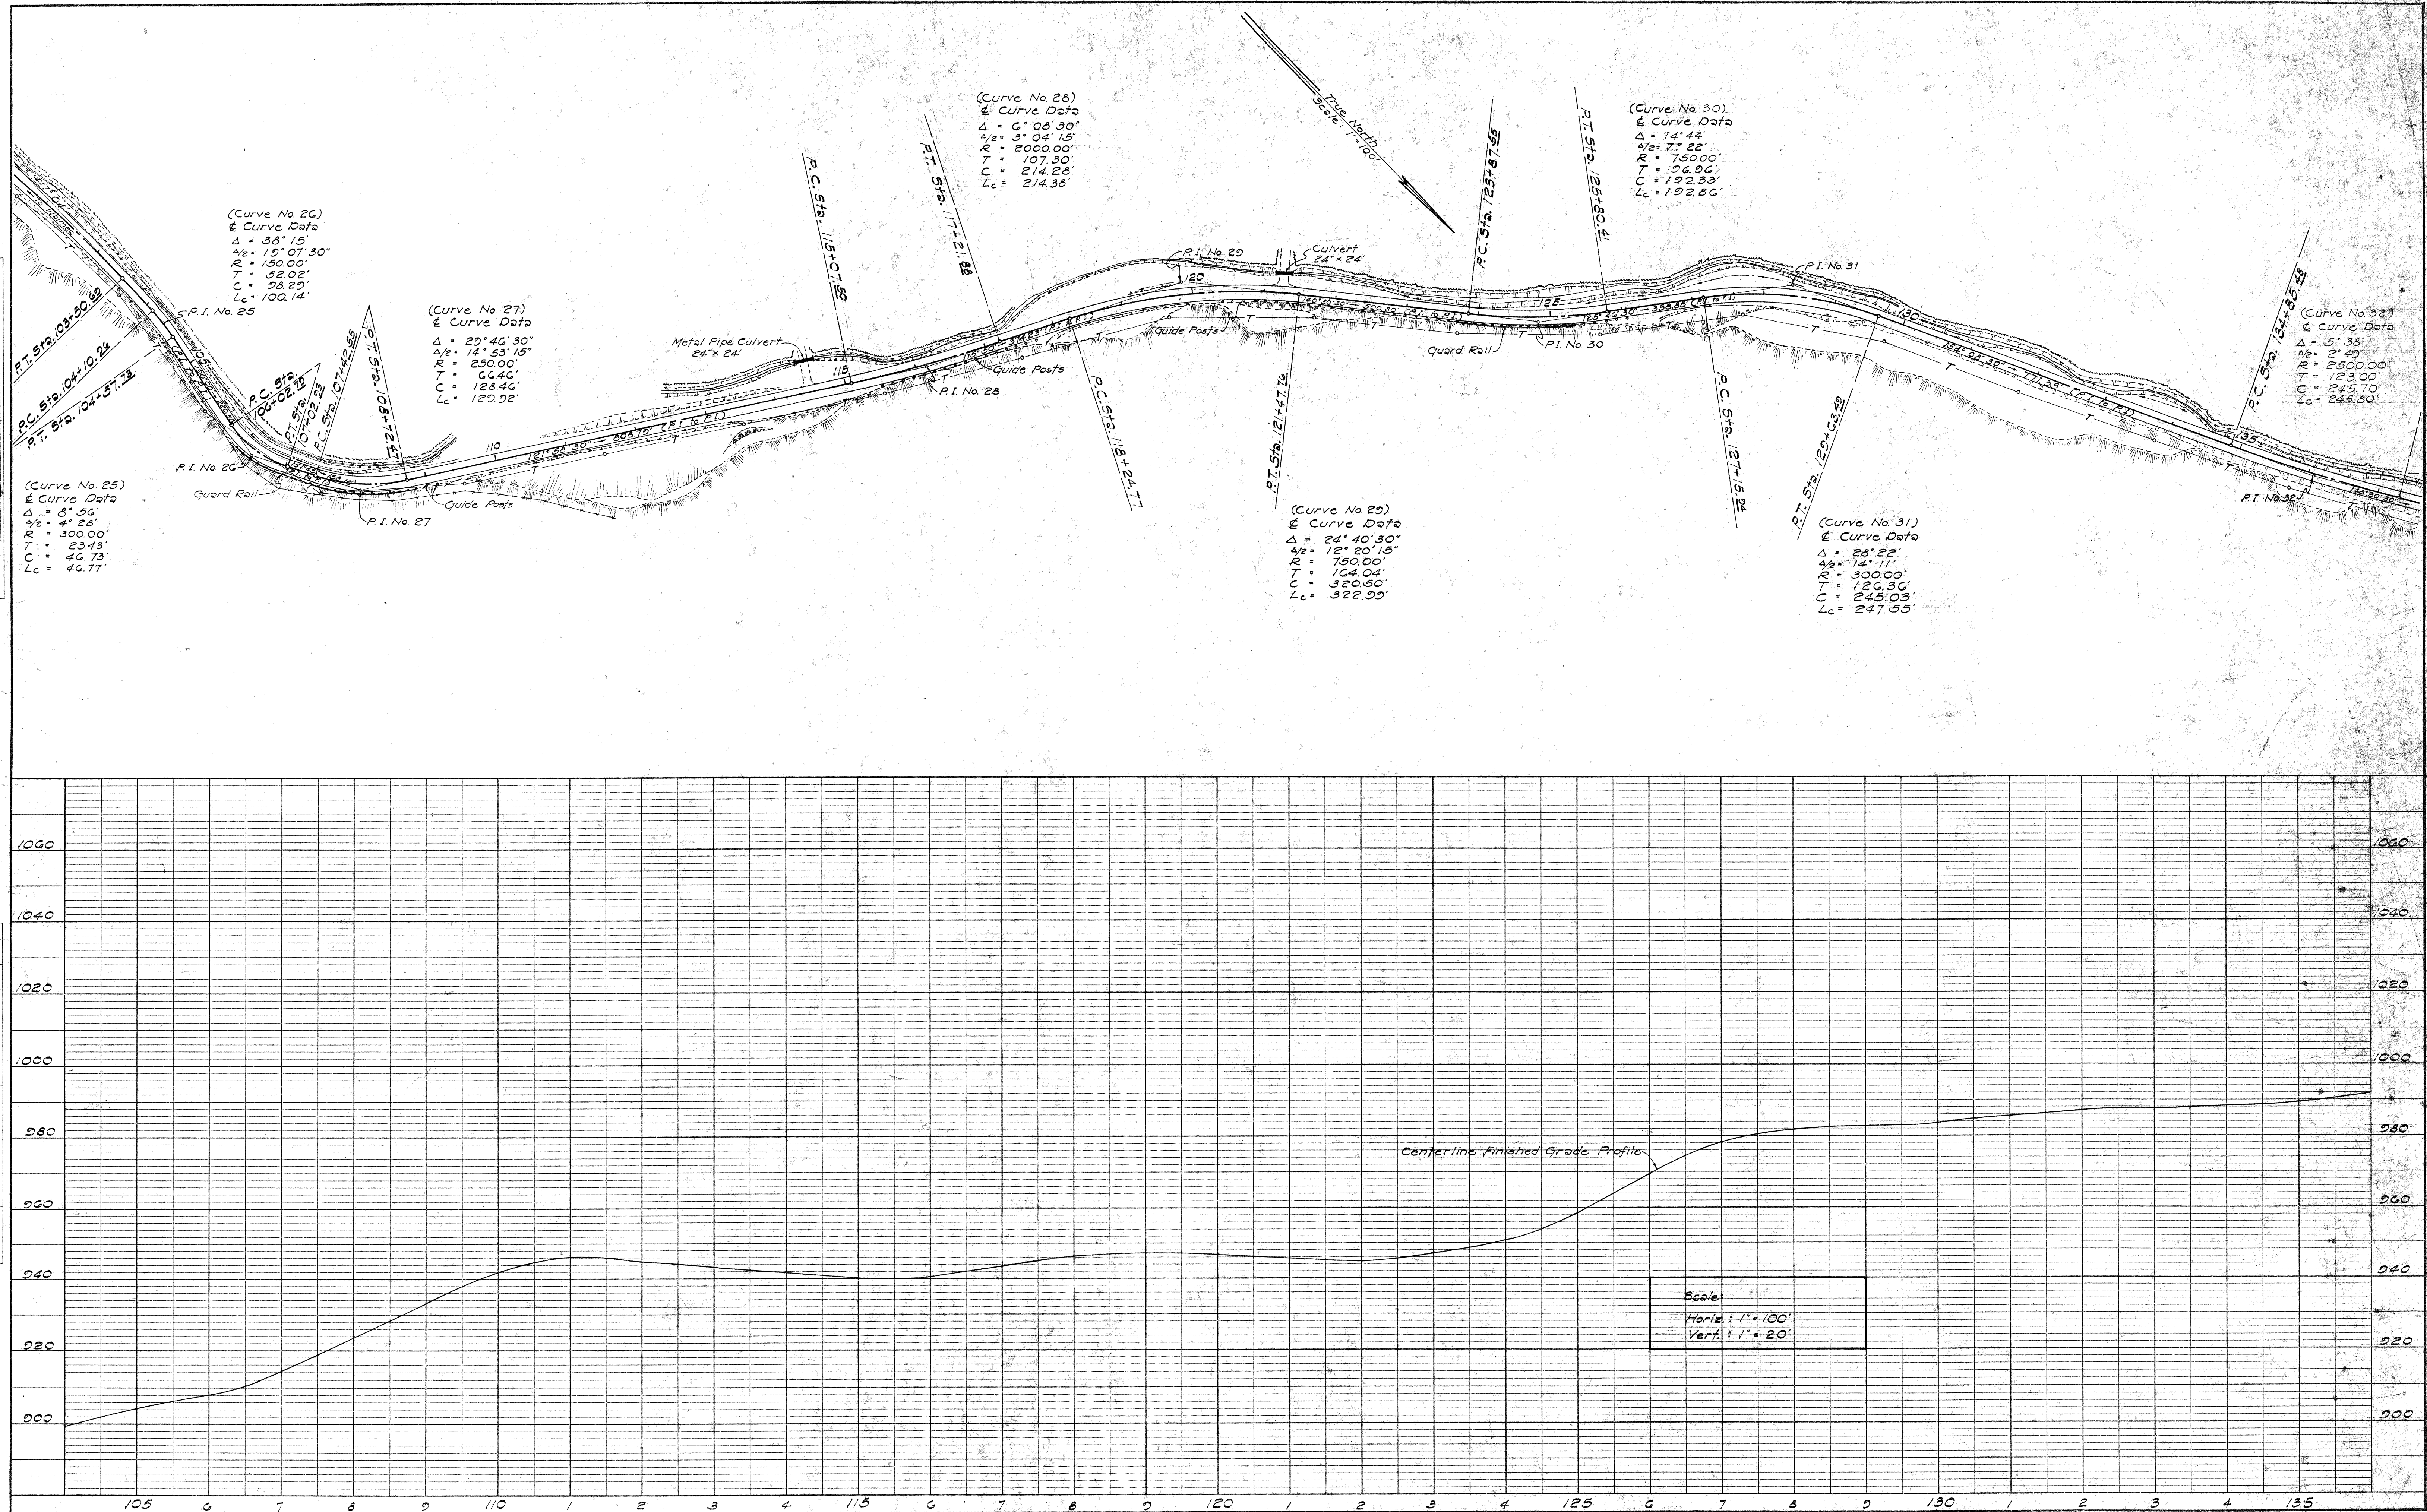



PLAN	SURVEYED	DATE
	PLOTTED	BY
	ALIGNMENT CHECKED	
	RT. OF WAY CHECKED	
NO.		

PROFILE	SURVEYED	DATE
	PLOTTED	BY
	GRADES CHECKED	
	STRUCTURE NOTATIONS	
NO.		

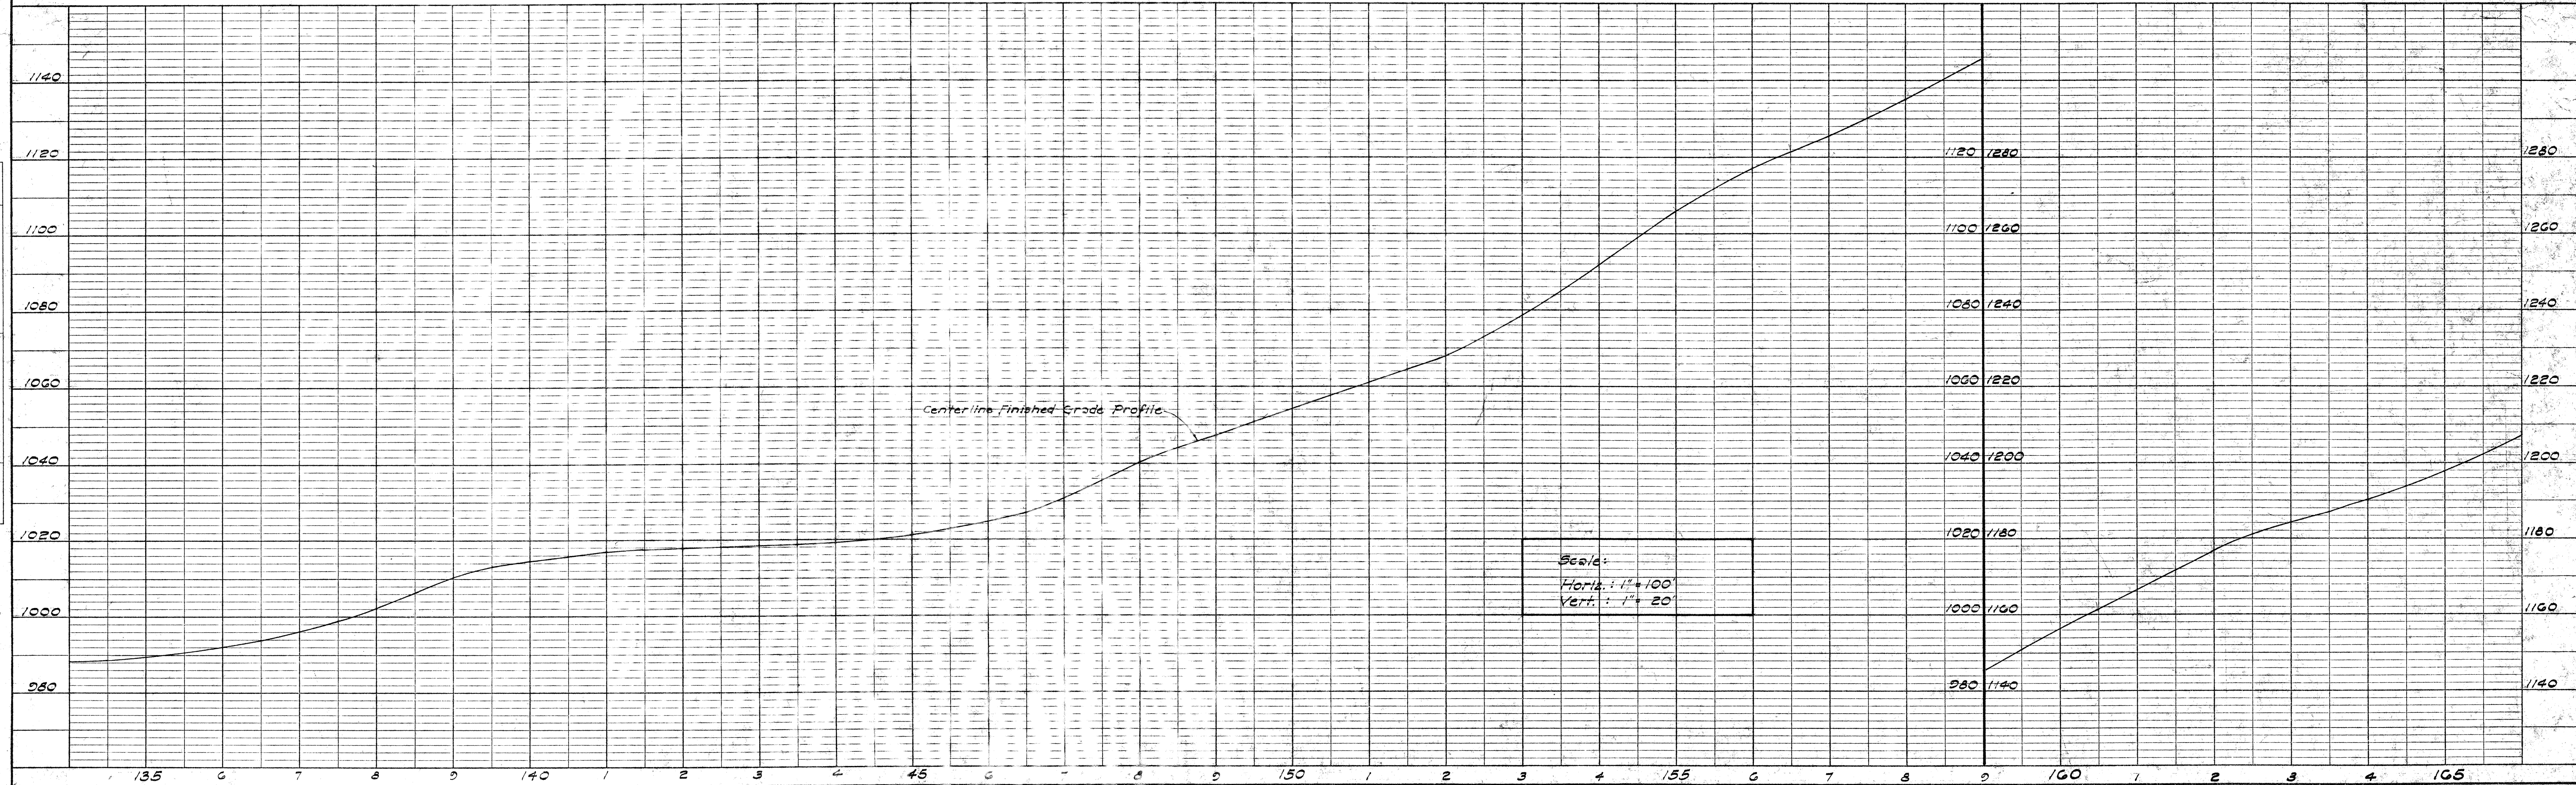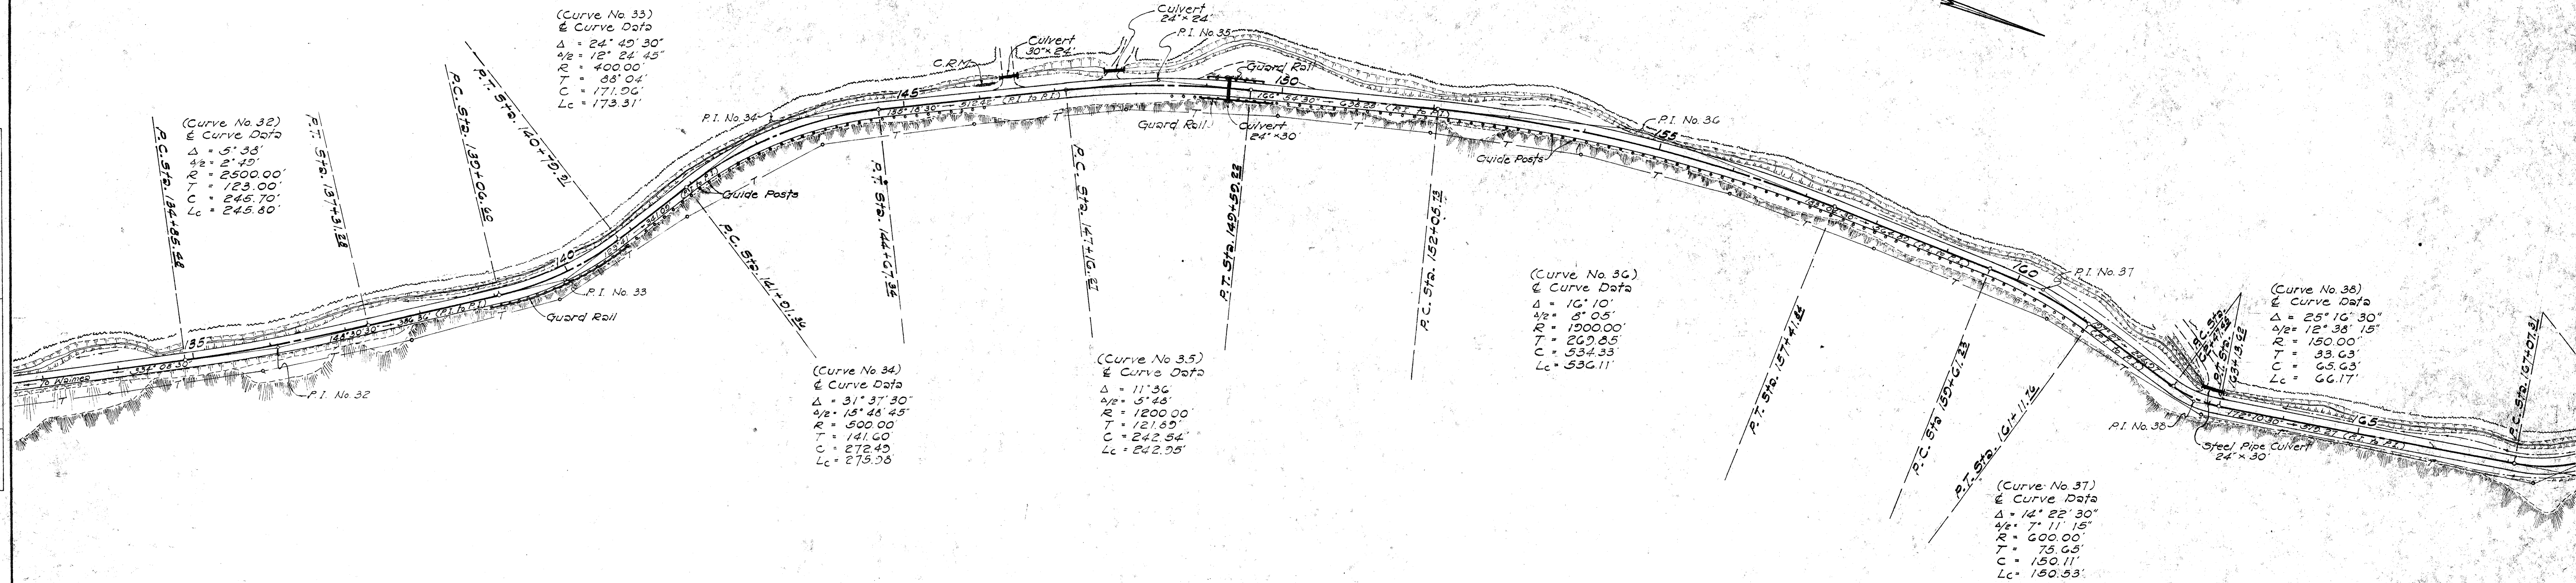


PLAN	DATE
	BY
	SURVEYED
	PLOTTED
NOTE BOOK	CHECKED
NO.	BY WAY CHECKED

PROFILE	DATE
	BY
	SURVEYED
	PLOTTED
NOTE BOOK	CHECKED
NO.	BY WAY CHECKED

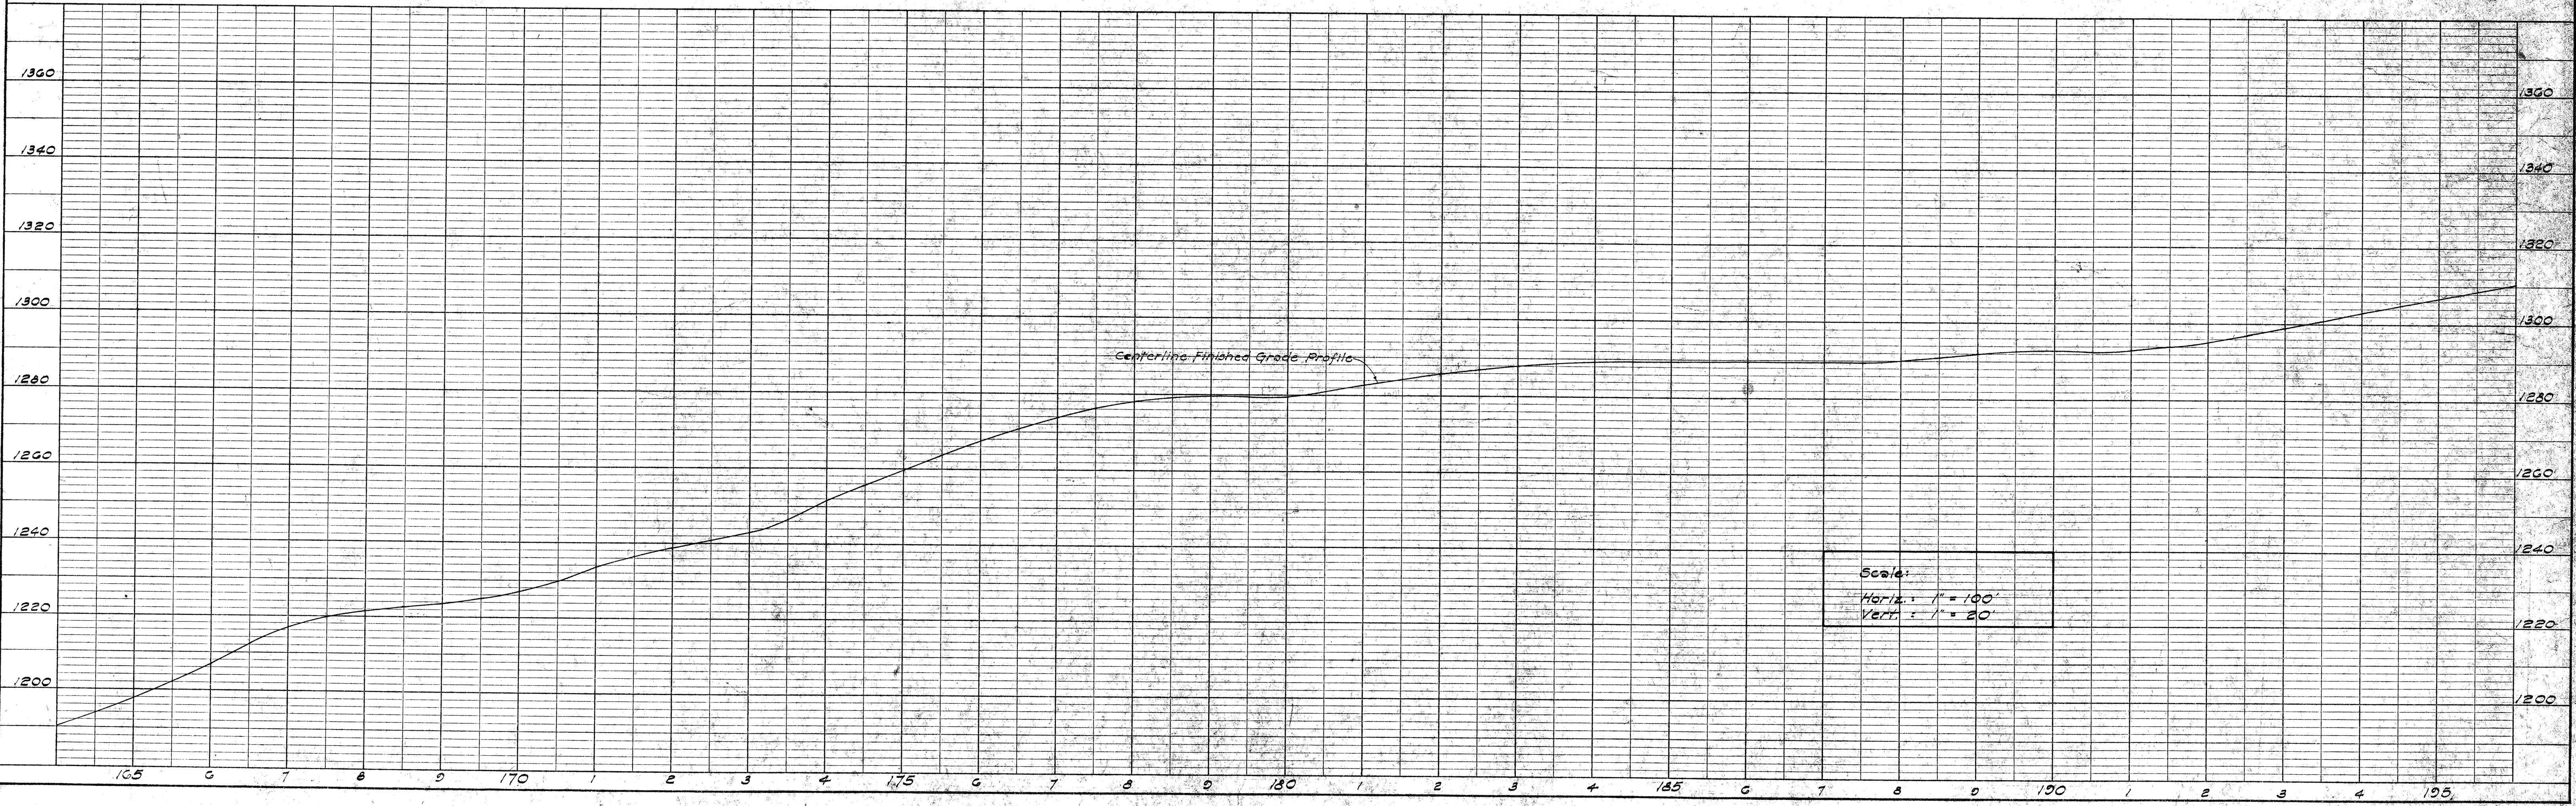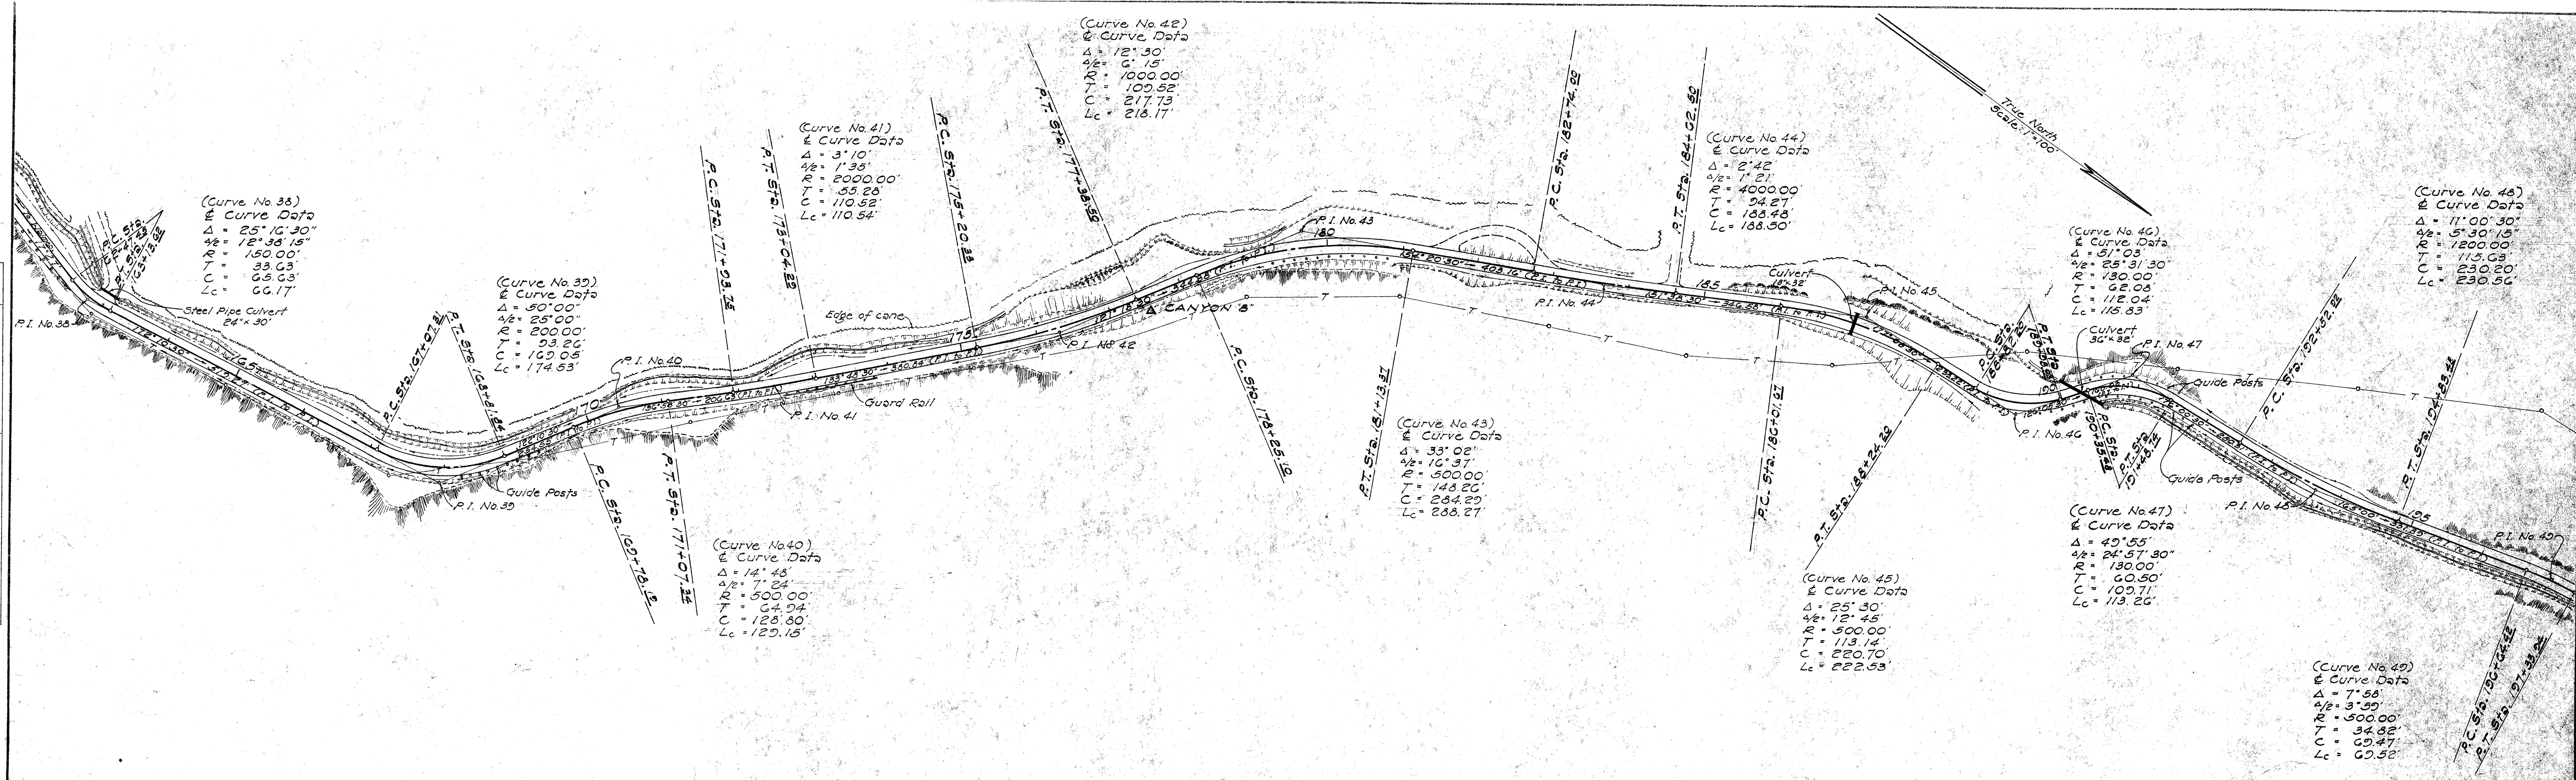

PLAN	DATE	BY	SURVEYED	NOTE BOOK	ALIGNMENT CHECKED	RT. OF WAY CHECKED

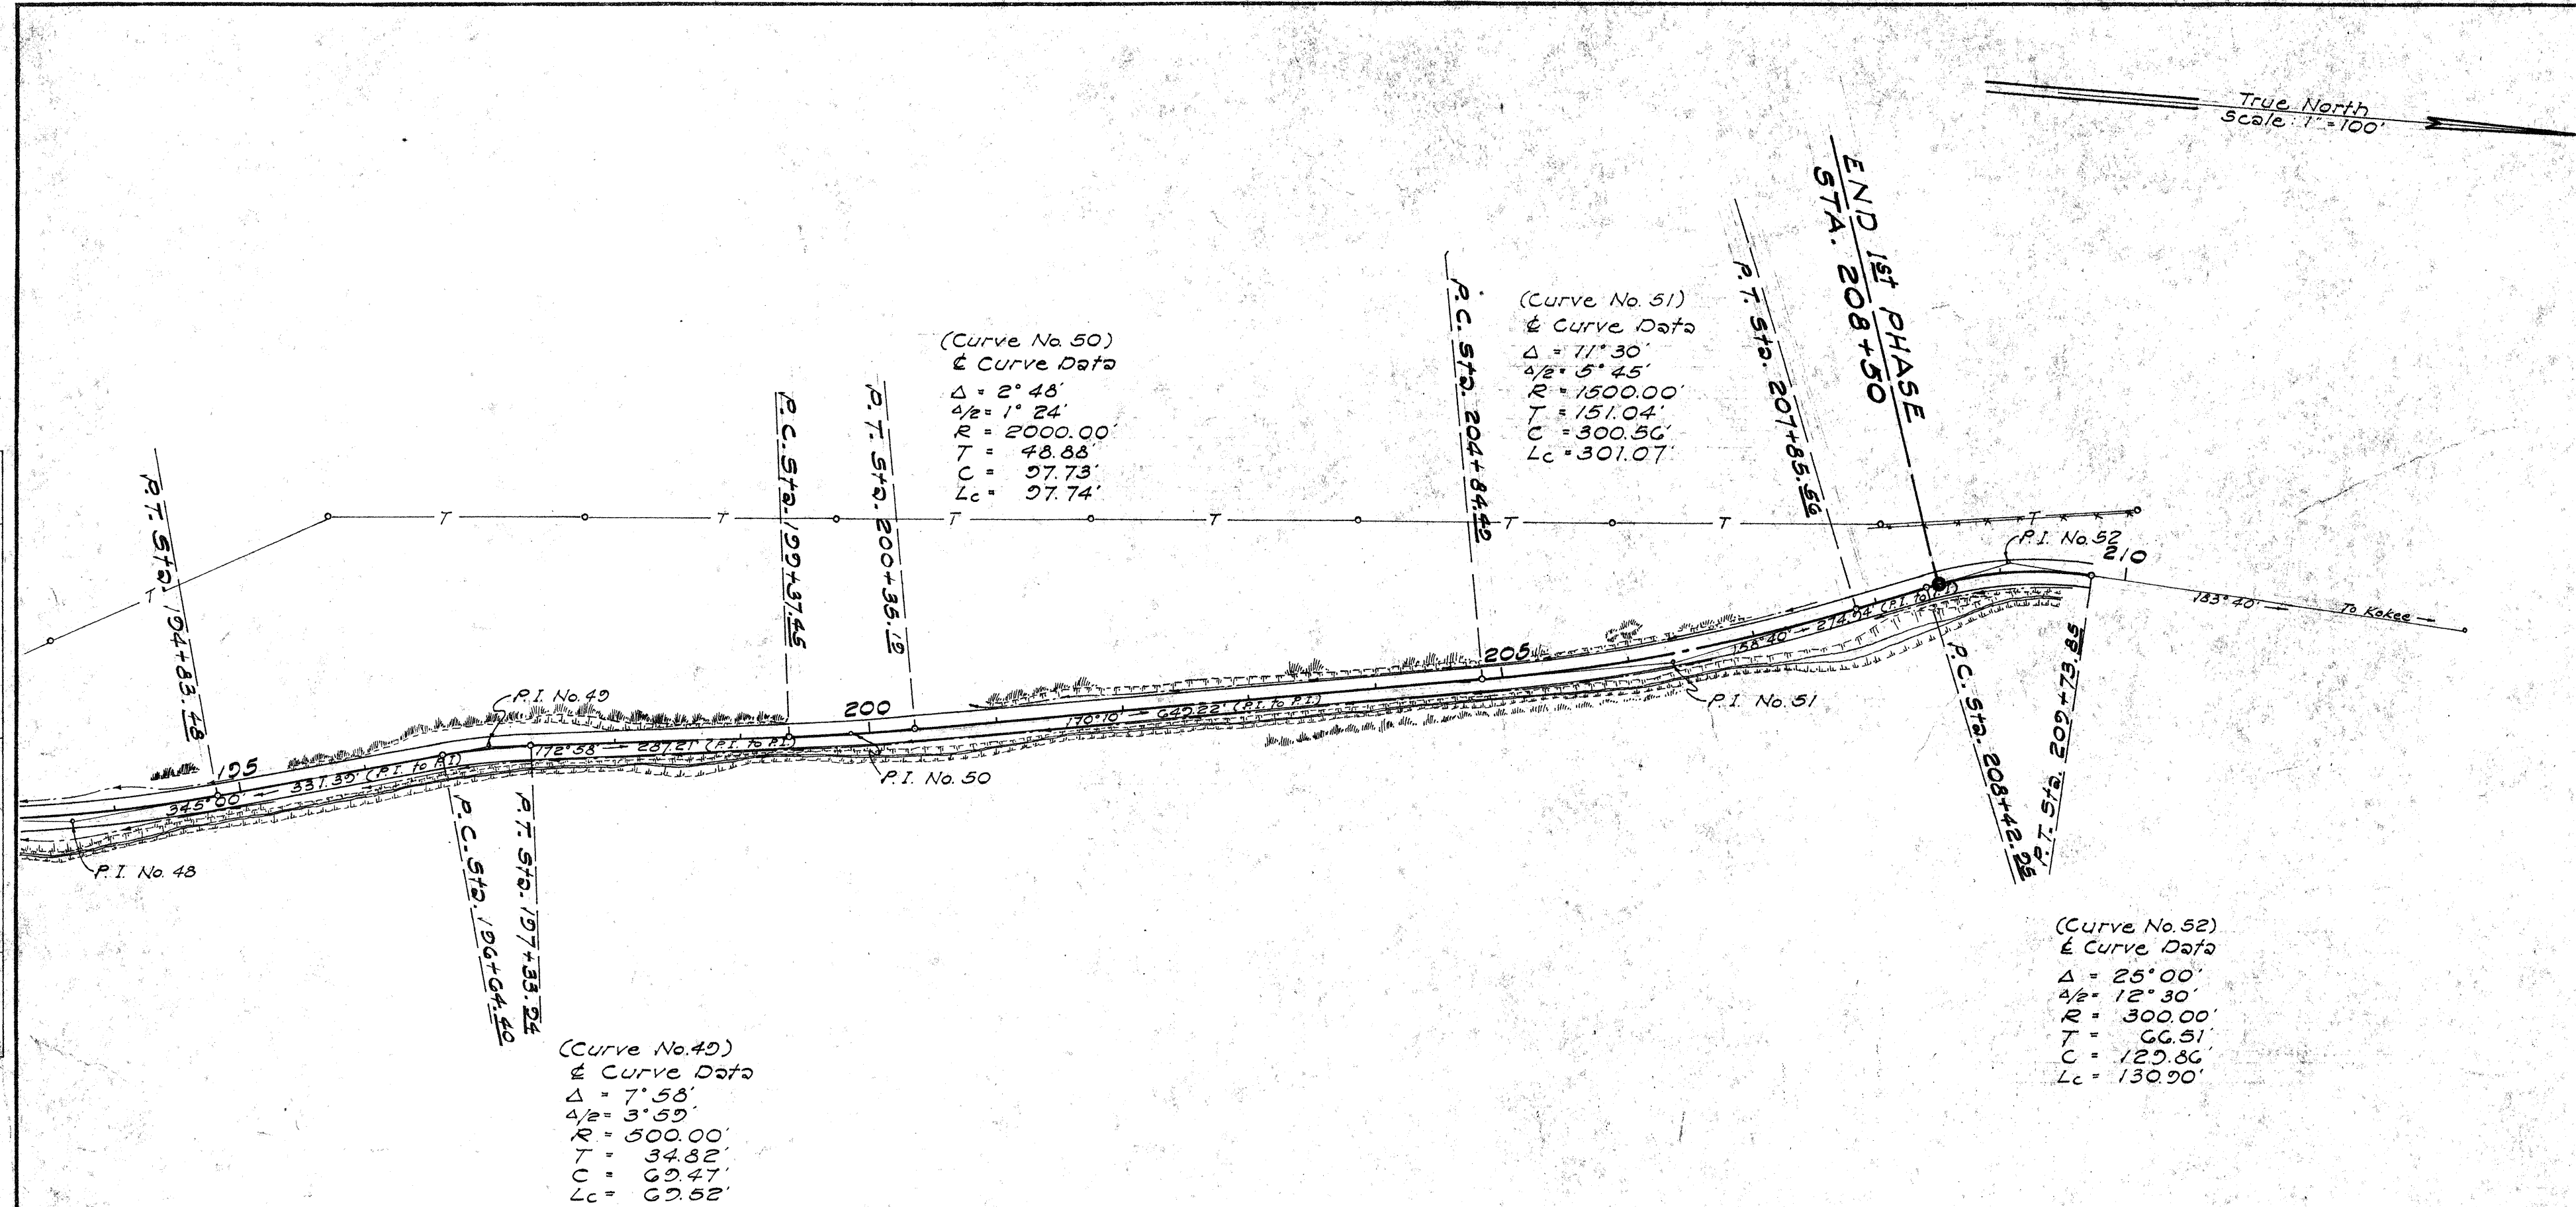

PROFILE	DATE	BY	SURVEYED	NOTE BOOK	GRADES CHECKED	STRUCTURE NOTATIONS

