	INDEX TO DRAWINGS
SHEET NO.	DESCRIPTION
1	TITLE SHEET
2	TYPICAL SECTION, GENERAL
	NOTES & MISC. DETAILS
3-4	PLANS
5-17	STANDARD DETAILS
	장보이었다. 이 경영 경영 경영 경영 경영 경영 경영 경영 기계



STATE OF HAWAII

DEPARTMENT OF TRANSPORTATION

HIGHWAYS DIVISION


"AS BUILT"

PLANS FOR

WAIMEA CANYON DRIVE, RESURFACING AND SAFETY IMPROVEMENTS


FEDERAL AID PROJ. NO. RS-0550(2)


DISTRICT OF WAIMEA
ISLAND OF KAUAI

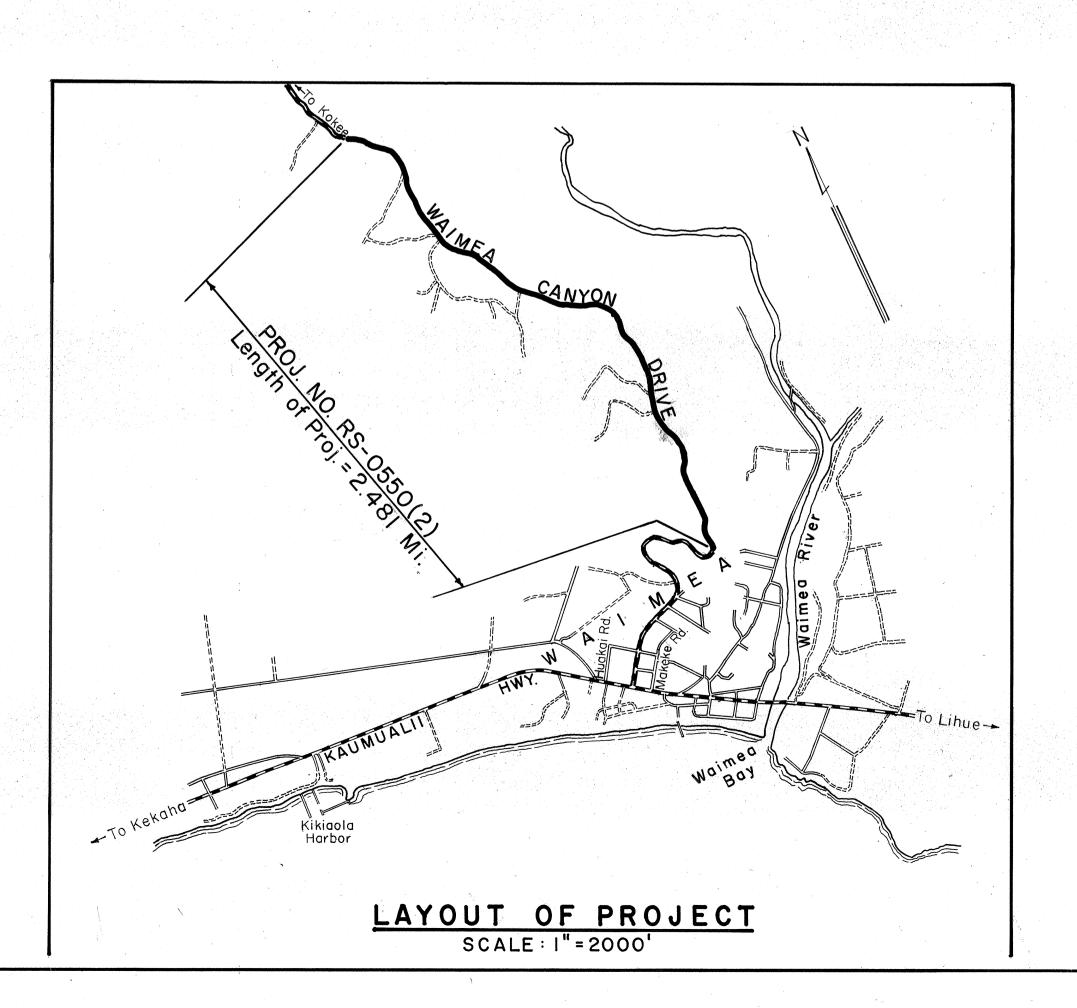

FED. ROAD DIST. NO. STATE FED. AID PROJ. NO. FISCAL SHEET TOTAL YEAR NO. SHEETS

HAWAII HAW. RS-0550(2) 1981 | 17

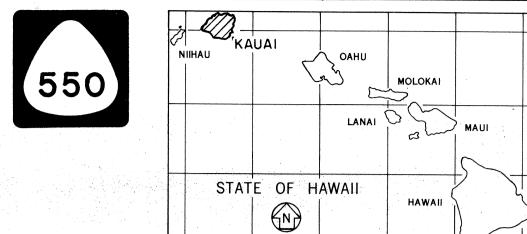

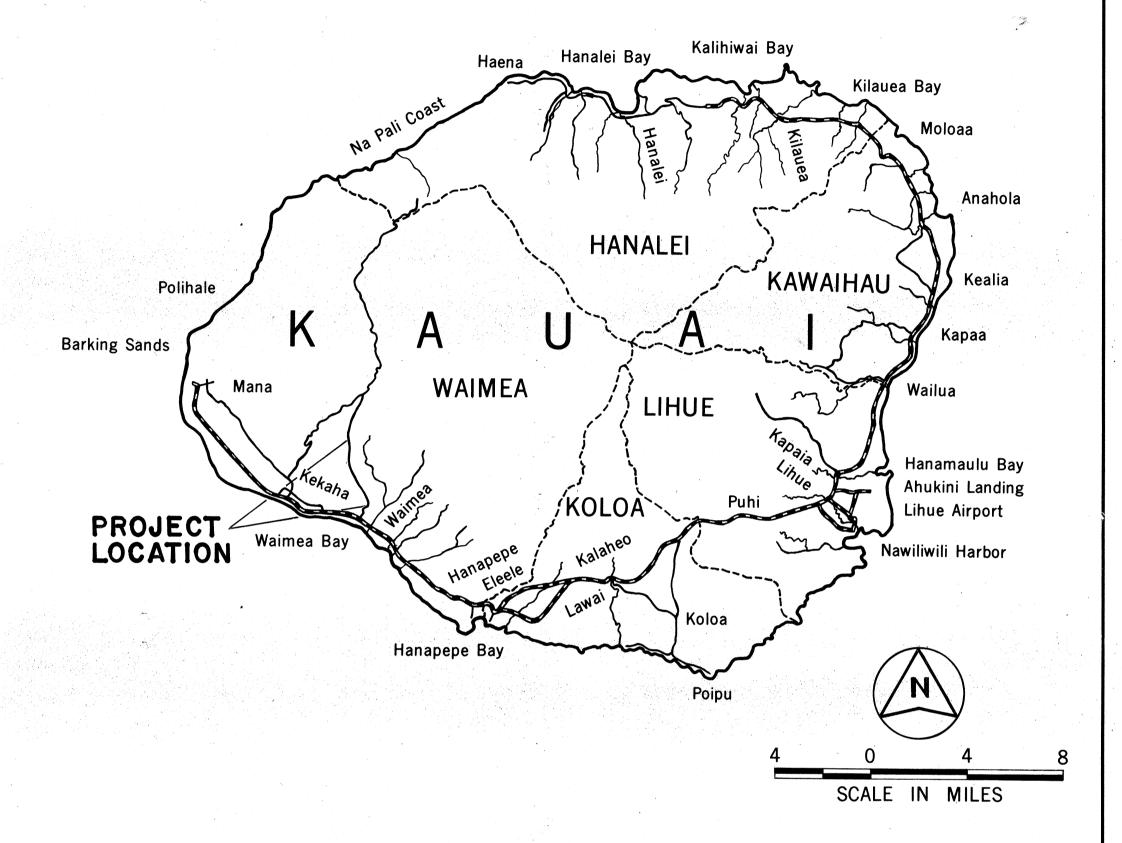

FEDERAL AID PROJECTS PREVIOUSLY CONSTRUCTED
OR UNDER CONSTRUCTION

ALL CHANGES MADE DURING CONSTRUCTION HAVE BEEN INCORPORATED ON THESE PLANS IN RED EXCEPT CHANGES IN THE ORIGINAL THEORETICAL QUANTITIES. FOR ACTUAL QUANTITIES, REFER TO PROJECT LEDGER AND/OR COMPUTATION BOOK.

RESIDENT ENGINEER DATE

DEPARTMENT OF TRANSPORTATION
STATE OF HAWAII

APPROVED:

Ryofish Higashianna 12/29/80

DIR. OF TRANSPORTATION DATE

KAUAI DISTRICT DESIGNED BY