


FED. ROAD DIST. NO.	STATE	PROJ. NO.	FISCAL YEAR	SHEET NO.	TOTAL SHEETS
HAWAII	HAW.	550A-01-90M	1990	4	6

Sta. 142+00 to Sta. 352+16±
Resurface existing paved roadway and install centerline pavement markers and pavement striping. See Typ Sections & Details on Sht. No. 3.

Estimated Quantities
A.C. Marshall Mix = ~~4300T~~
4292.56T

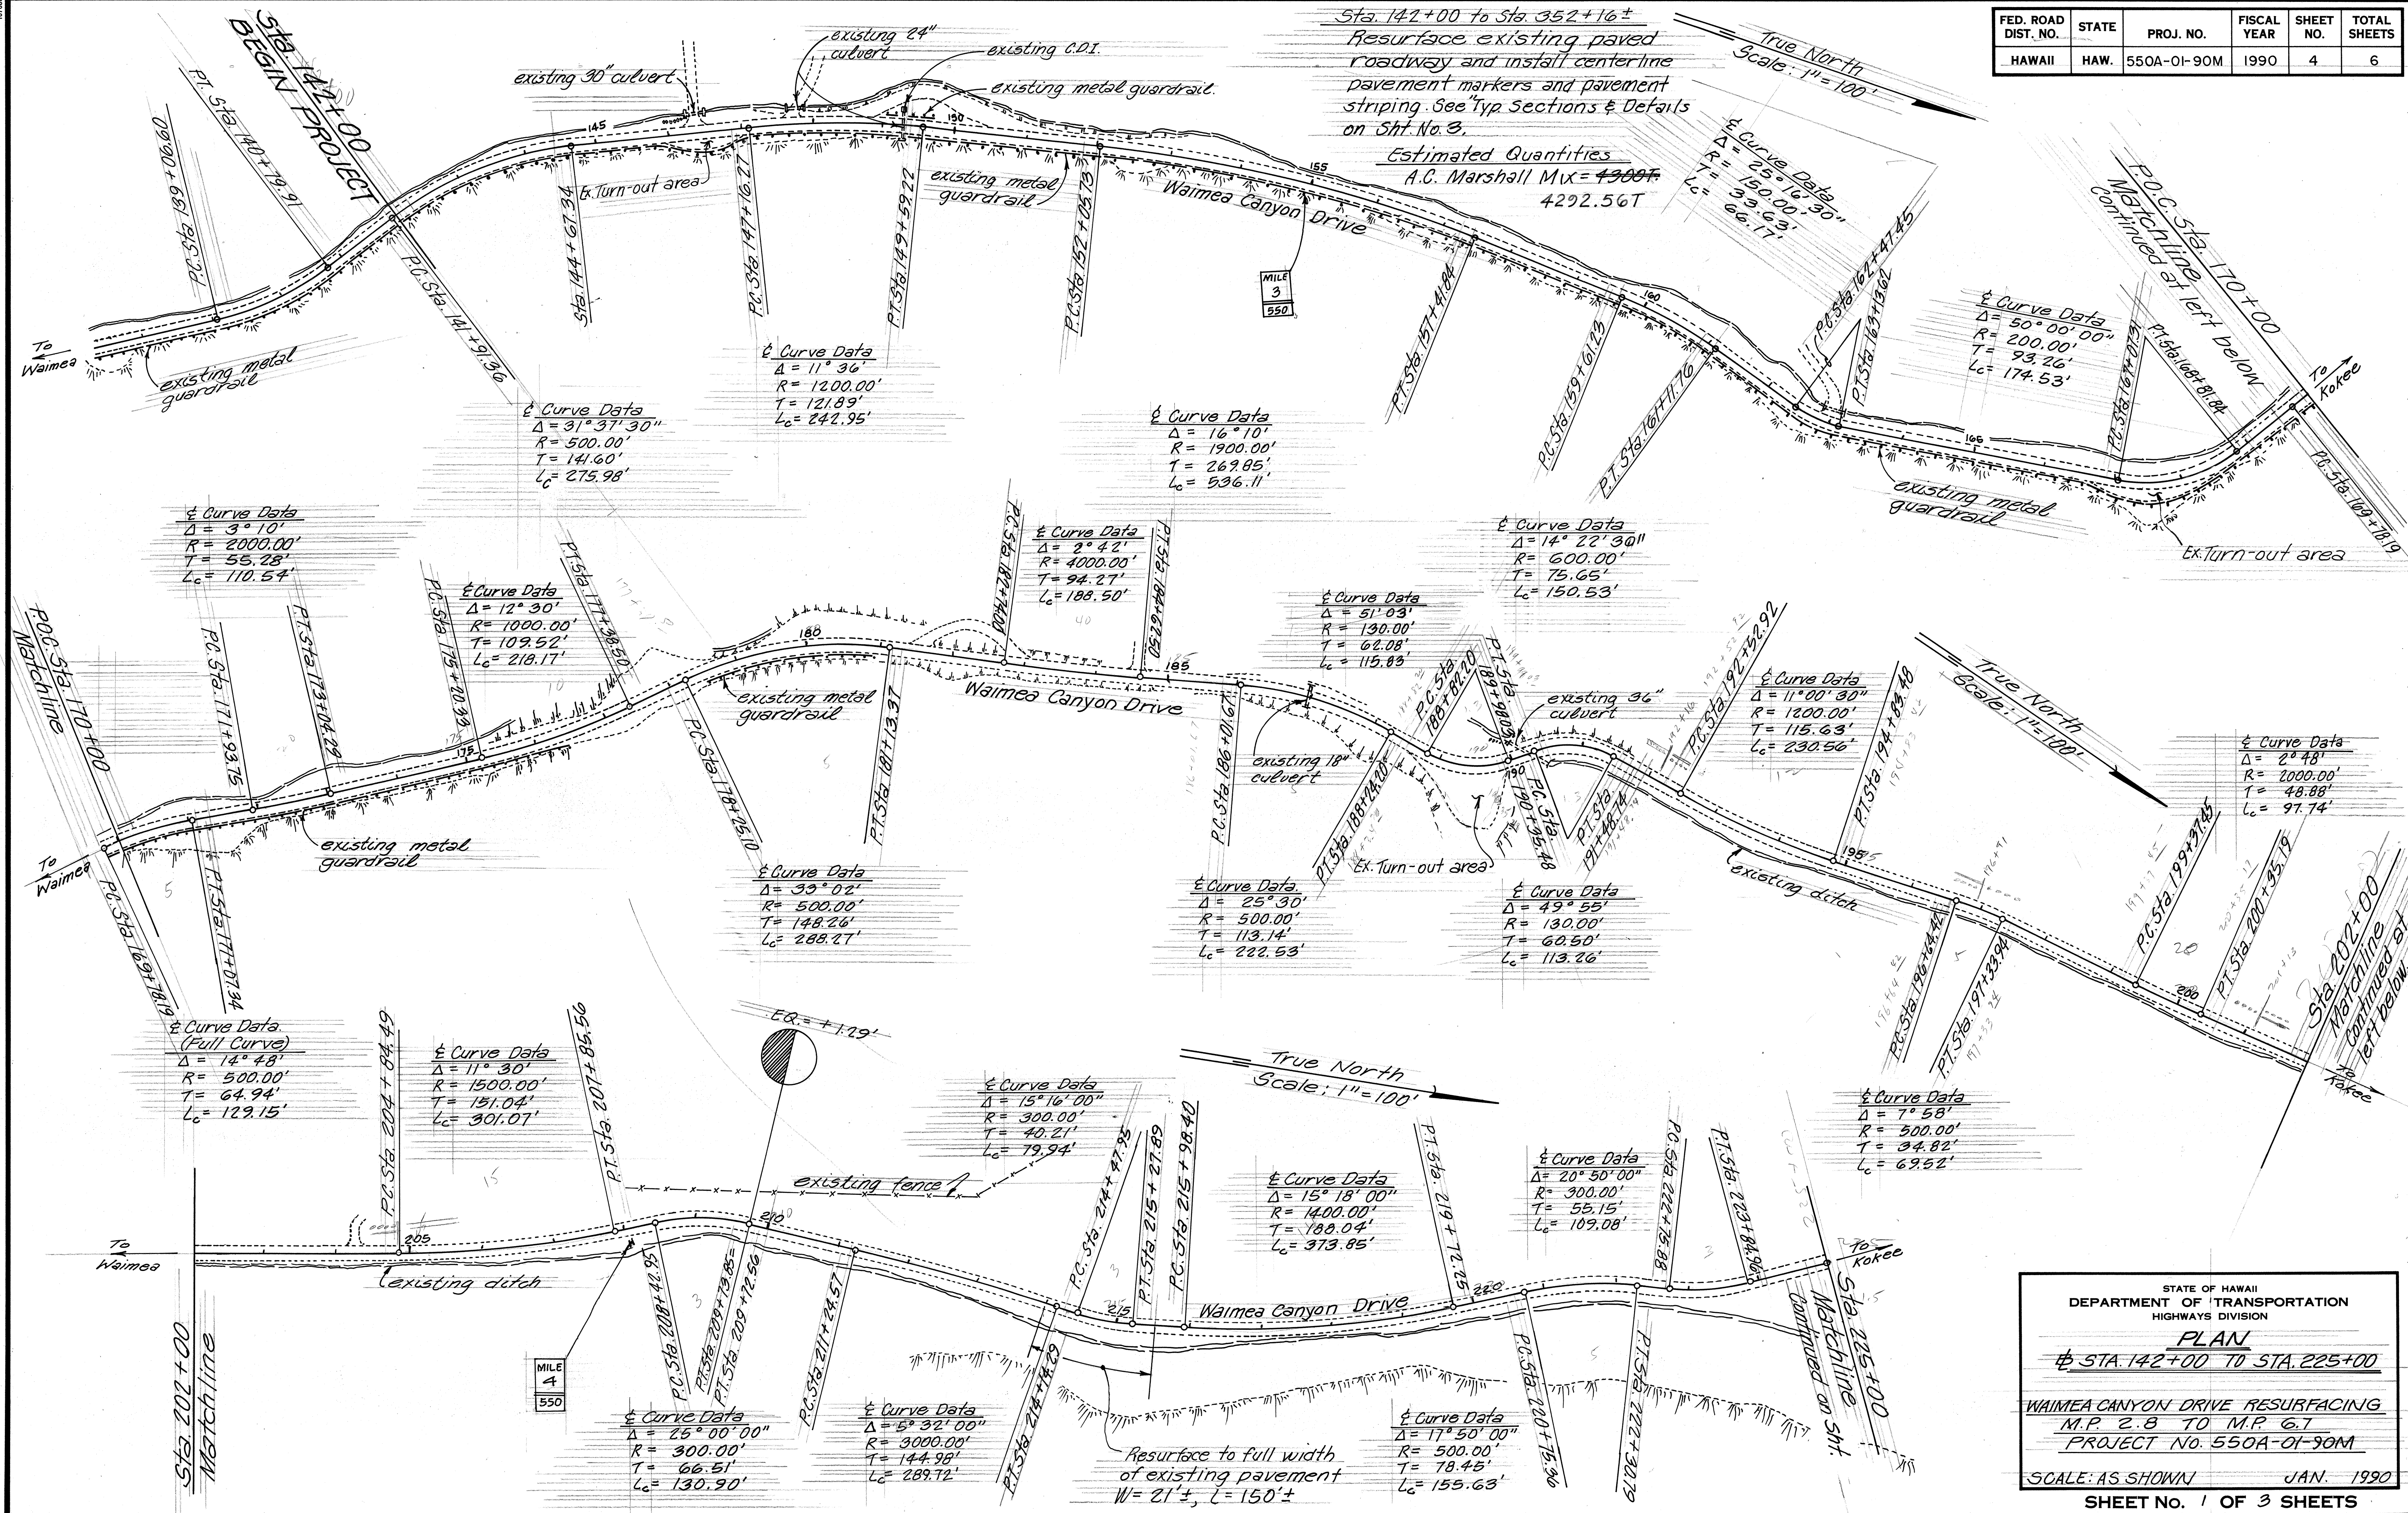

DATE	_____
SURVEY PLOTTED BY	_____
ORIGINAL PLAN	_____
DESIGNED BY	_____
NOTED BY	_____
CHECKED BY	_____
NO.	_____


STATE OF HAWAII
DEPARTMENT OF TRANSPORTATION
HIGHWAYS DIVISION

PLAN
STA. 142+00 TO STA. 225+00

WAIMEA CANYON DRIVE RESURFACING
M.P. 2.8 TO M.P. 6.1
PROJECT NO. 550A-01-90M

SCALE: AS SHOWN JAN. 1990
SHEET NO. 1 OF 3 SHEETS

FED. ROAD DIST. NO.	STATE	PROJ. NO.	FISCAL YEAR	SHEET NO.	TOTAL SHEETS
HAWAII	HAW.	550A-01-90M	1990	5	6

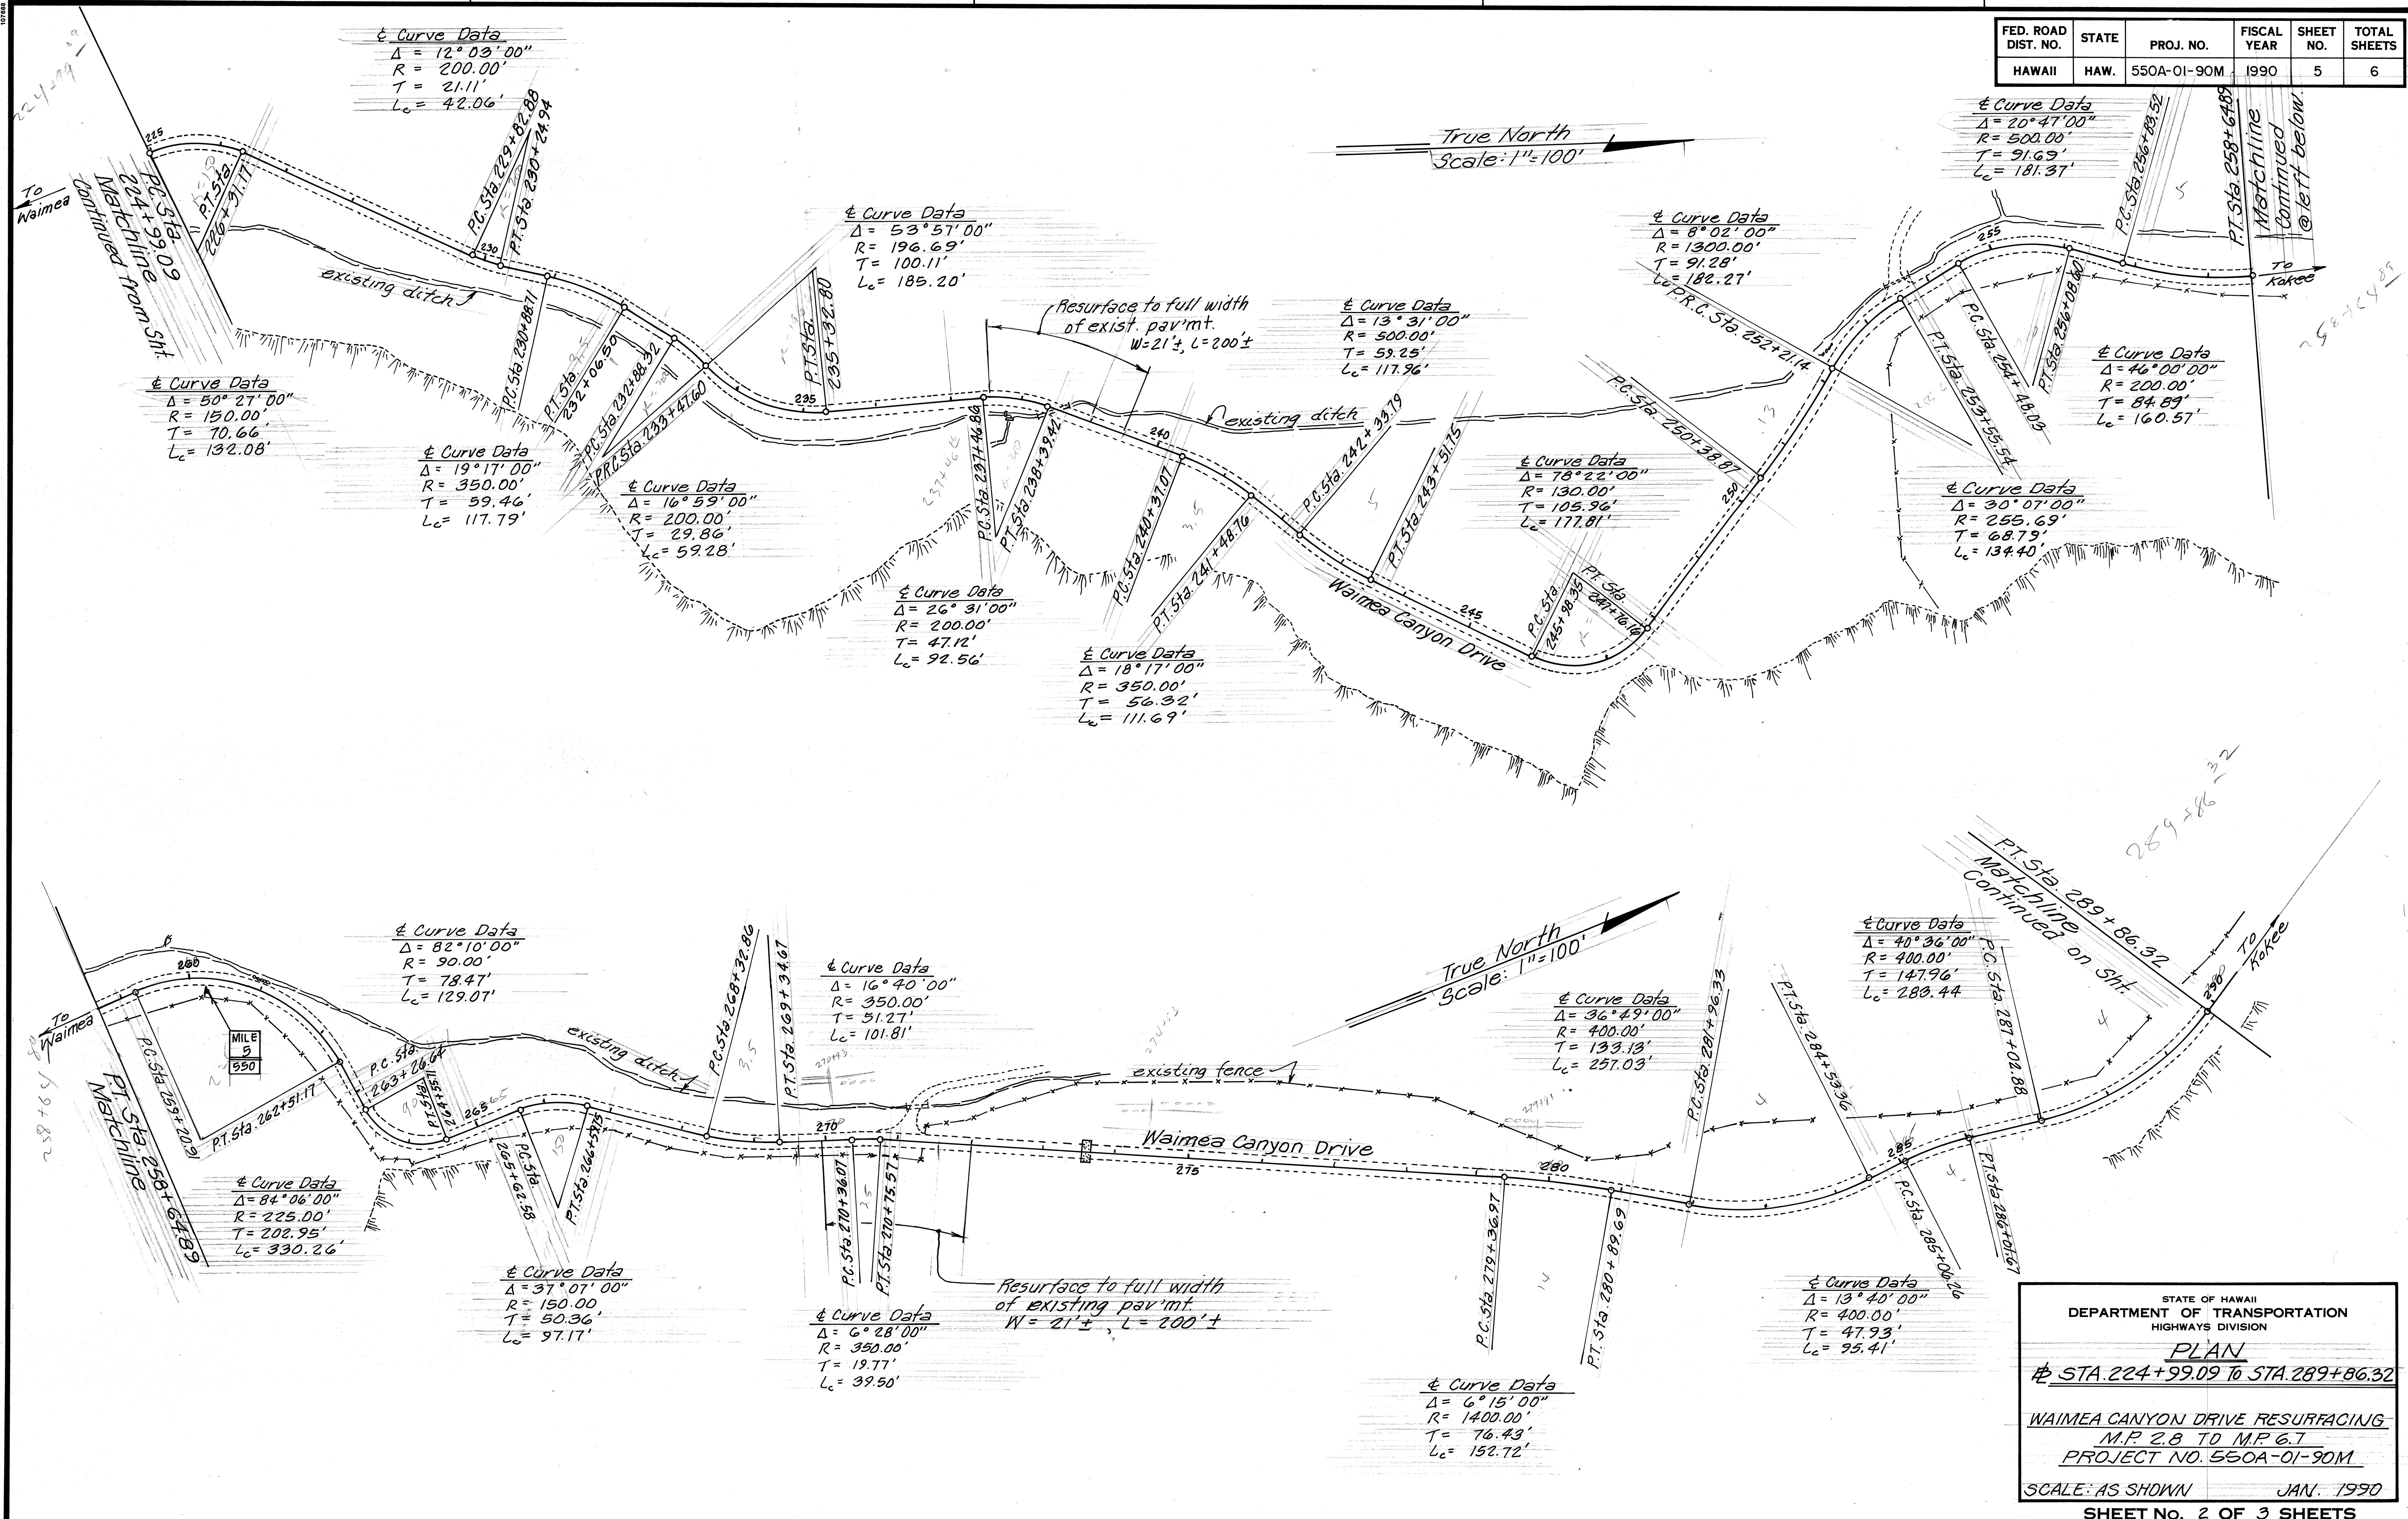

DATE	
SURVEY PLOTTED BY	
DRAWN BY	
DESIGNED BY	
CHECKED BY	
NOTE BOOK NO.	

STATE OF HAWAII
DEPARTMENT OF TRANSPORTATION
HIGHWAYS DIVISION

PLAN

STA. 224+99.09 TO STA. 289+86.32


WAIMEA CANYON DRIVE RESURFACING
M.P. 2.8 TO M.P. 6.7
PROJECT NO. 550A-01-90M

SCALE: AS SHOWN JAN. 1990

SHEET NO. 2 OF 3 SHEETS

10700

FED. ROAD DIST. NO.	STATE	PROJ. NO.	FISCAL YEAR	SHEET NO.	TOTAL SHEETS
HAWAII	HAW.	550A-01-90M	1990	6	6

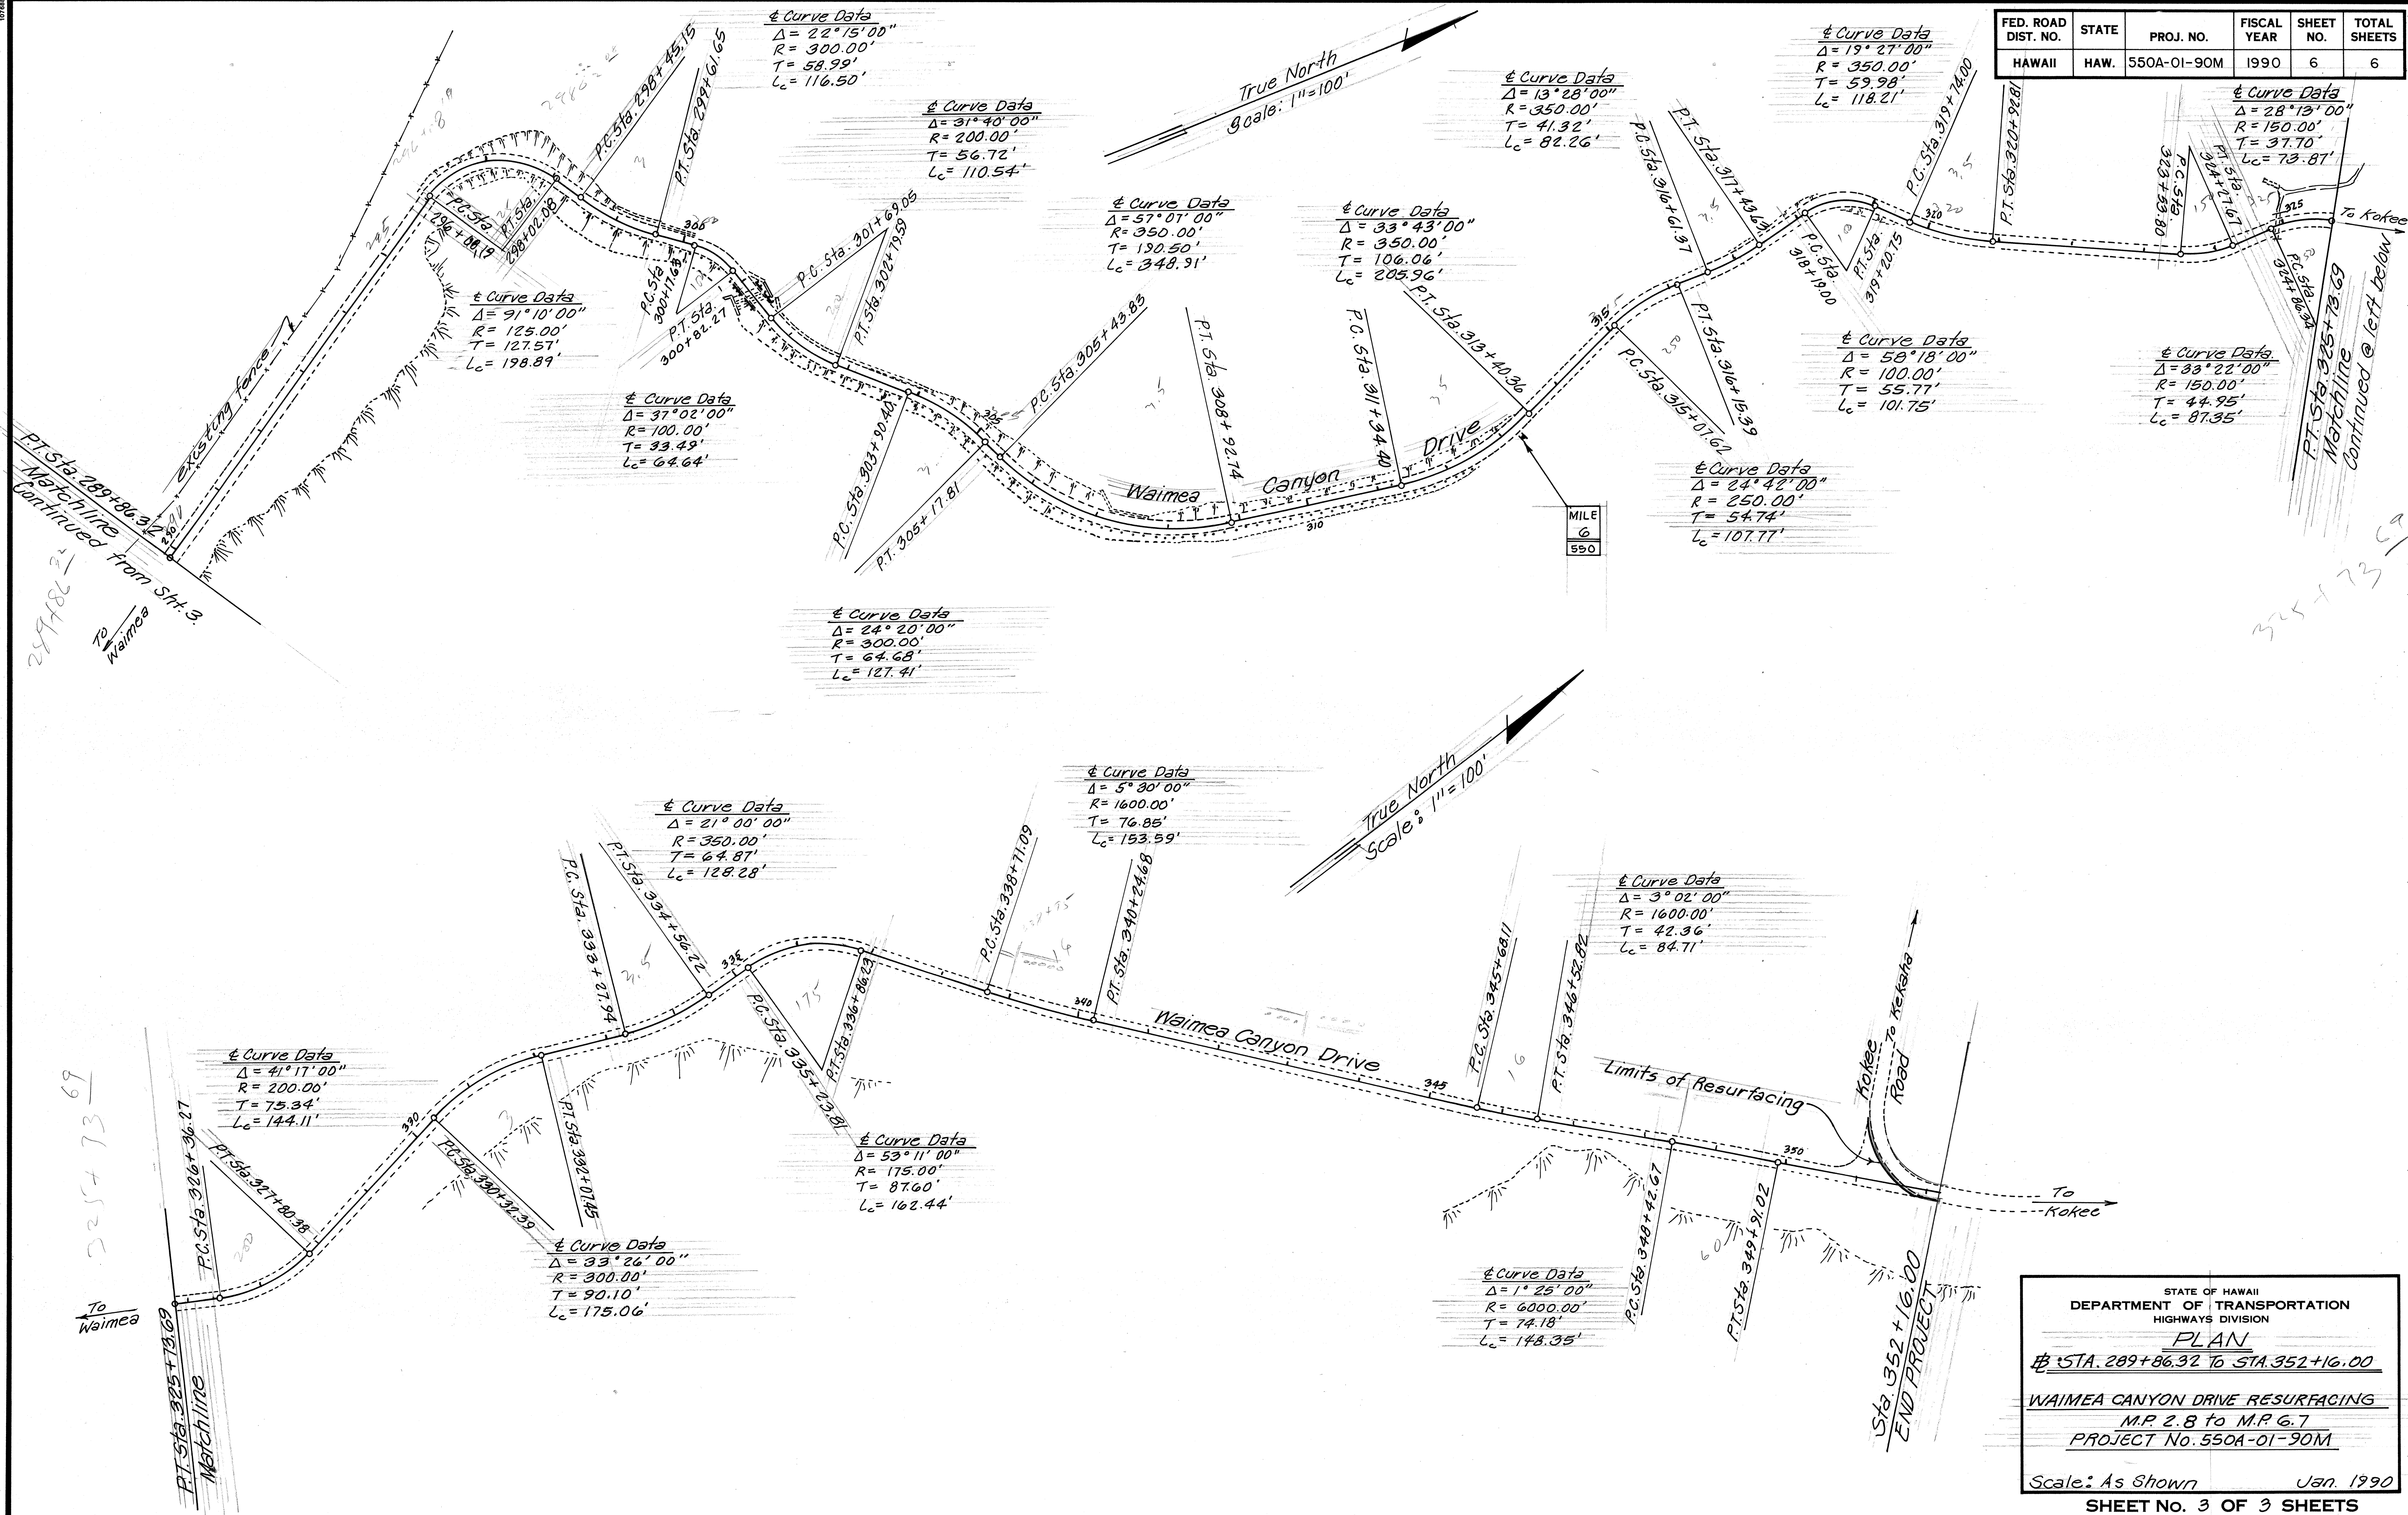

ORIGINAL PLAN	DATE
DRAWN BY	
DESIGNED BY	
NOTED BY	
CHECKED BY	

STATE OF HAWAII
DEPARTMENT OF TRANSPORTATION
HIGHWAYS DIVISION
PLAN
STA. 289+86.32 TO STA. 352+16.00
WAIMEA CANYON DRIVE RESURFACING
M.P. 2.8 TO M.P. 6.7
PROJECT No. 550A-01-90M
Scale: As Shown Jan. 1990
SHEET No. 3 OF 3 SHEETS