	And the second s
r I	INDEX TO DRAWINGS
SHEET NO.	DESCRIPTION
	TITLE SHEET
2	STANDARD PLANS SUMMARY
3	GENERAL NOTES & TYPICAL
	SECTIONS
4-6	PLAN
£ .	ų variotinininininininininininininininininini
and the state of t	
V	
#g	
	:


STATE OF HAWAII

DEPARTMENT OF TRANSPORTATION
HIGHWAYS DIVISION
HONOLULU, HAWAII
"AS-BUILT"
PLANS FOR

WAIMEA CANYON DRIVE RESURFACING M.P. 2.8 TO M.P. 6.7

PROJECT NO. 550A-01-90M


DISTRICT OF WAIMEA
ISLAND OF KAUAI

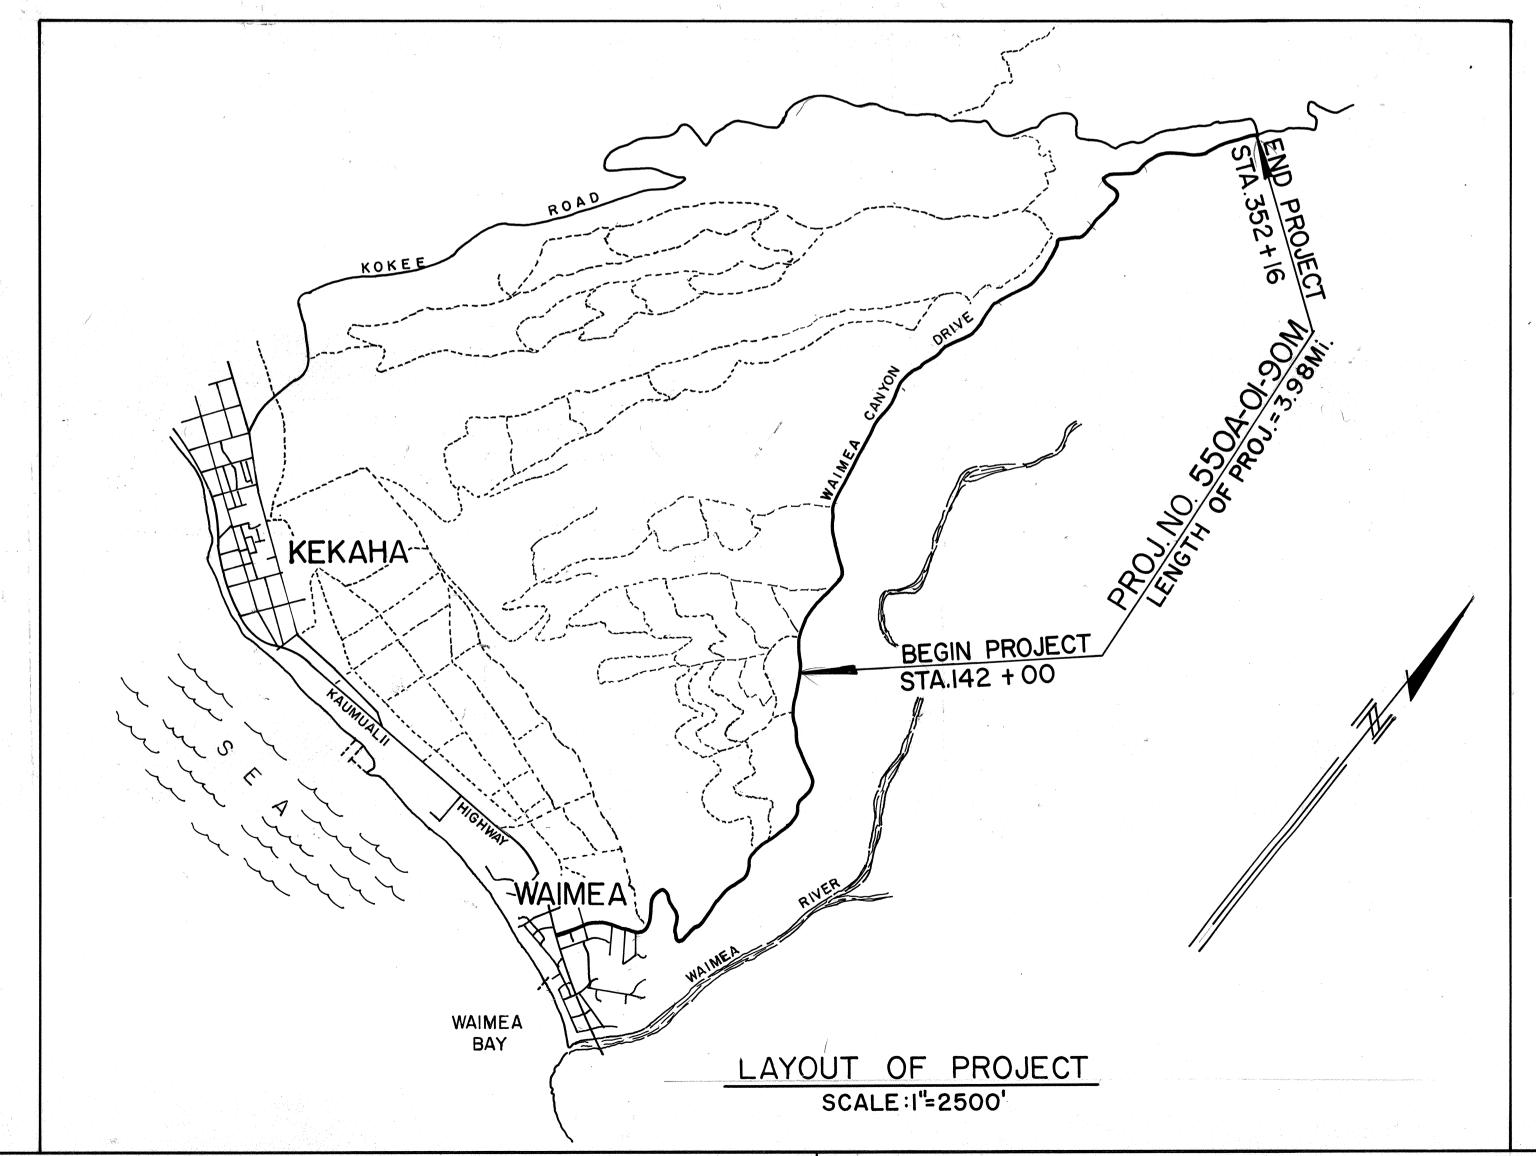


FED. ROAD DIST. NO. STATE PROJ. NO. FISCAL SHEET TOTAL SHEETS

HAWAII HAW. 550A-01-90M 1990 1 6



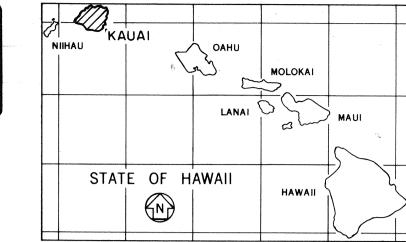

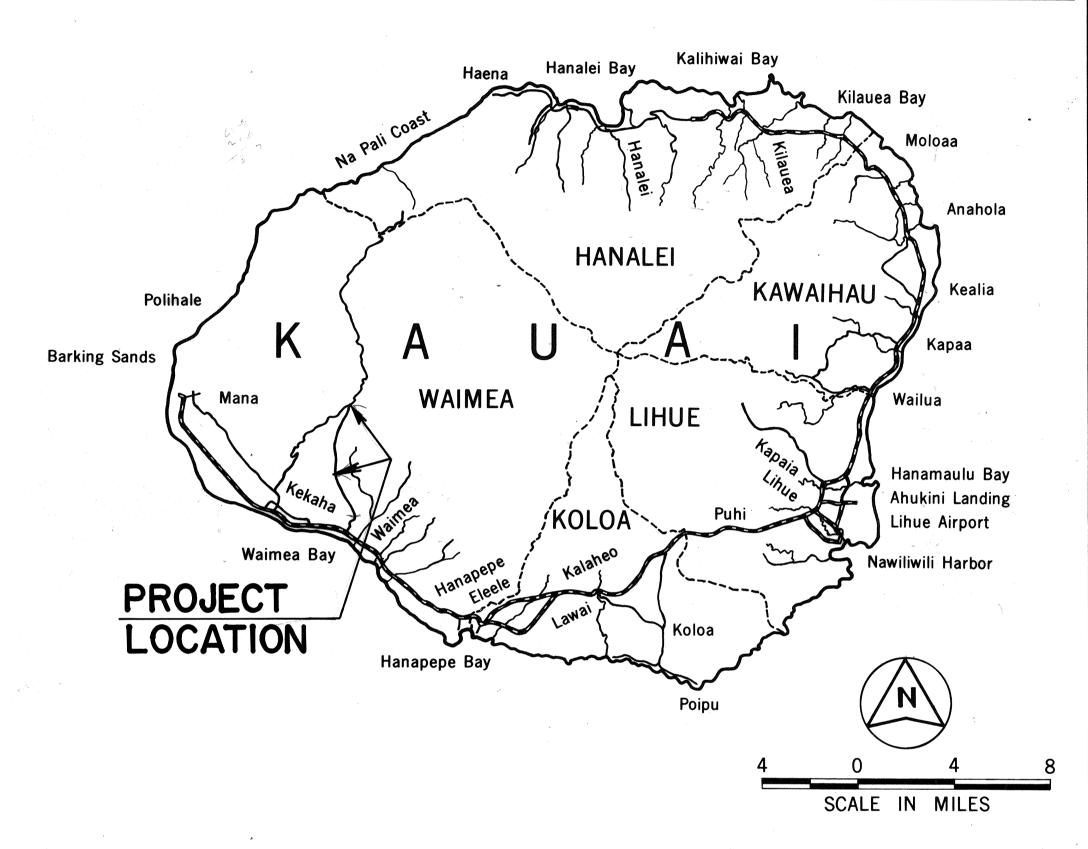

FEDERAL AID PROJECTS PREVIOUSLY CONSTRUCTED OR UNDER CONSTRUCTION

MILE POST 2.8 ± TO MILE POST 6.7±

CHANGES MADE DURING CONSTRUCTION HAVE
BEEN INCORPORATED ON THESE PLANS EXCEPT
CHANGES IN THE ORIGINAL THEORETICAL
QUANTITIES, FOR ACTUAL QUANTITIES, REFER TO
PROJECT LEDGER AND/OR COMPUTATION BOOK.

RESIDENT ENGINEER

12/11/90 DATE

DEPARTMENT OF TRANSPORTATION
STATE OF HAWAII

APPROVED:

| Solgon | Solgon

0-1-1-17