



FED. ROAD DIST. NO.	STATE	PROJ. NO.	FISCAL YEAR	SHEET NO.	TOTAL SHEETS
HAWAII	HAW.	550B-01-91M	1991	9	10

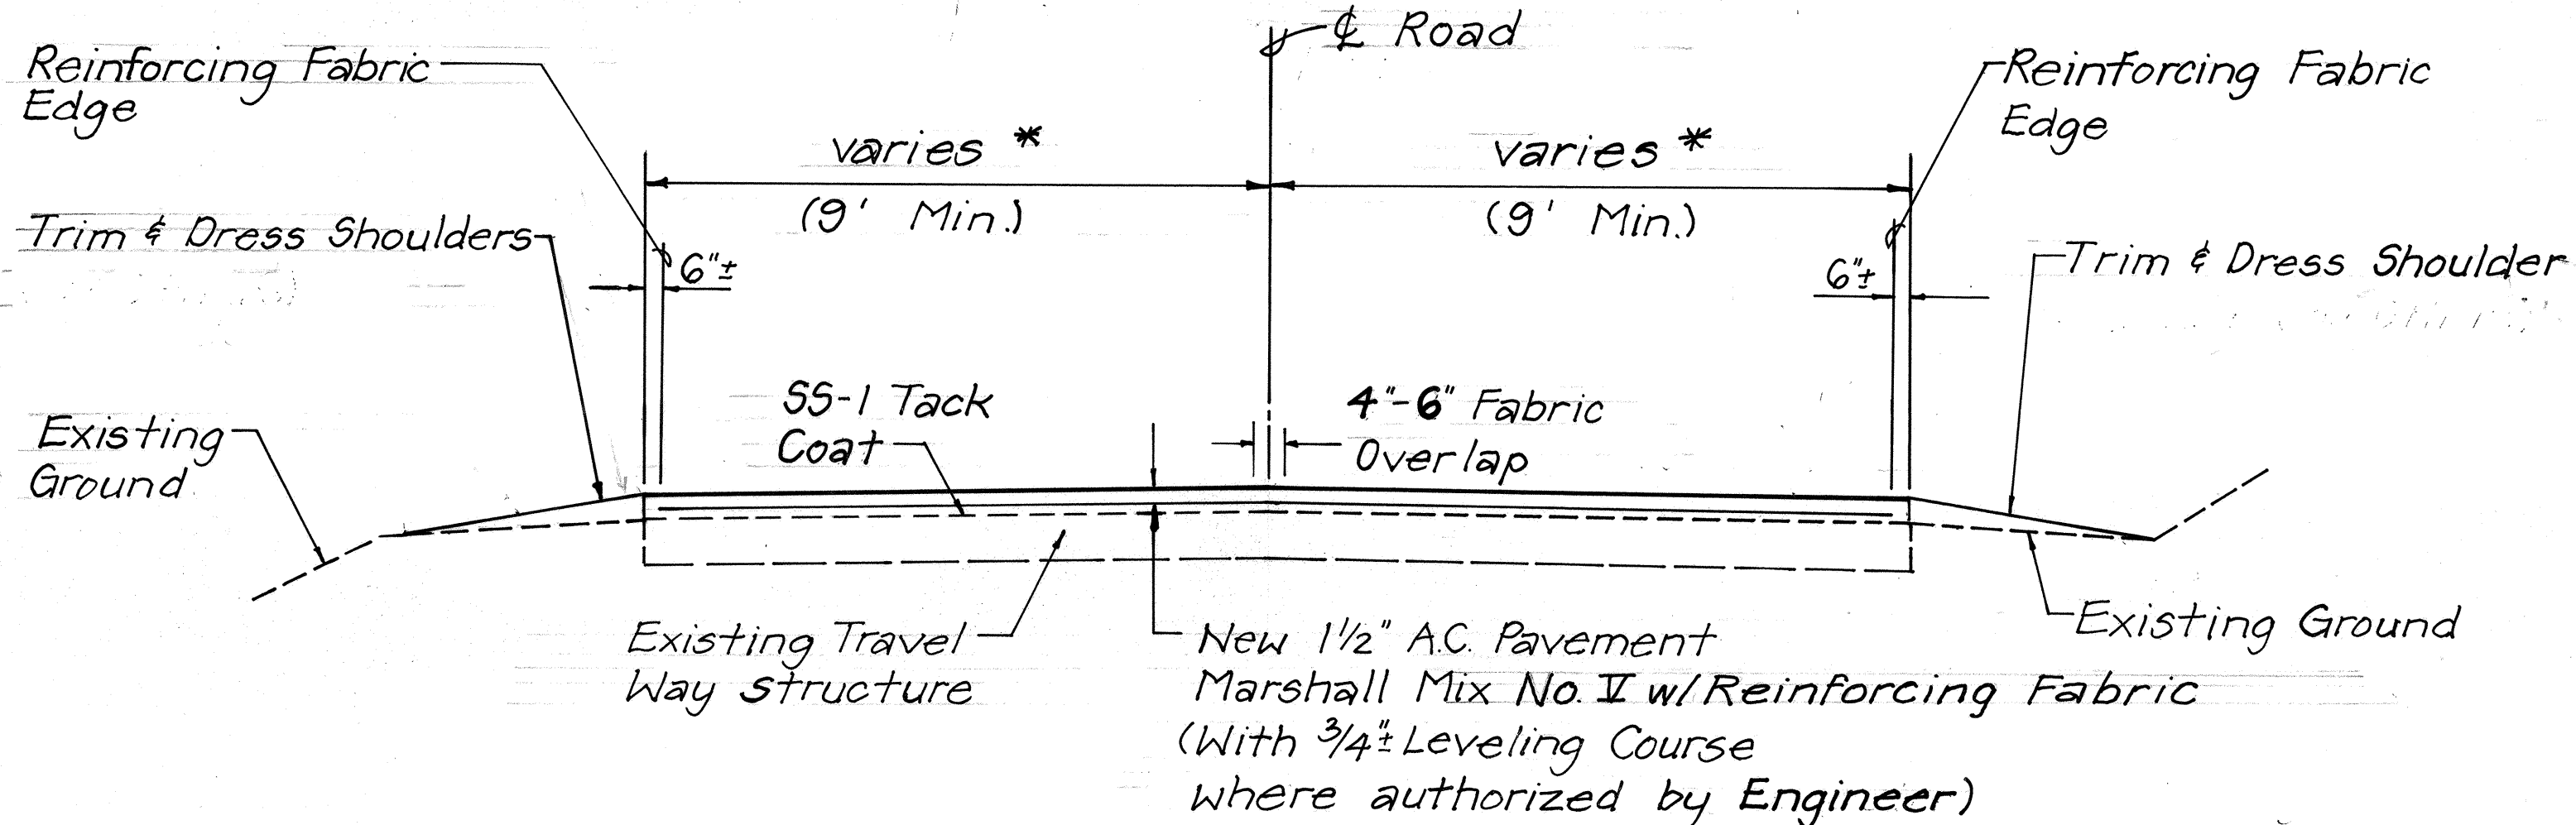


TYPICAL ROADWAY SECTION
Not to Scale

* Contractor shall pave over all existing Asphalt Concrete and/or A.T.B. unless otherwise instructed by the Engineer.

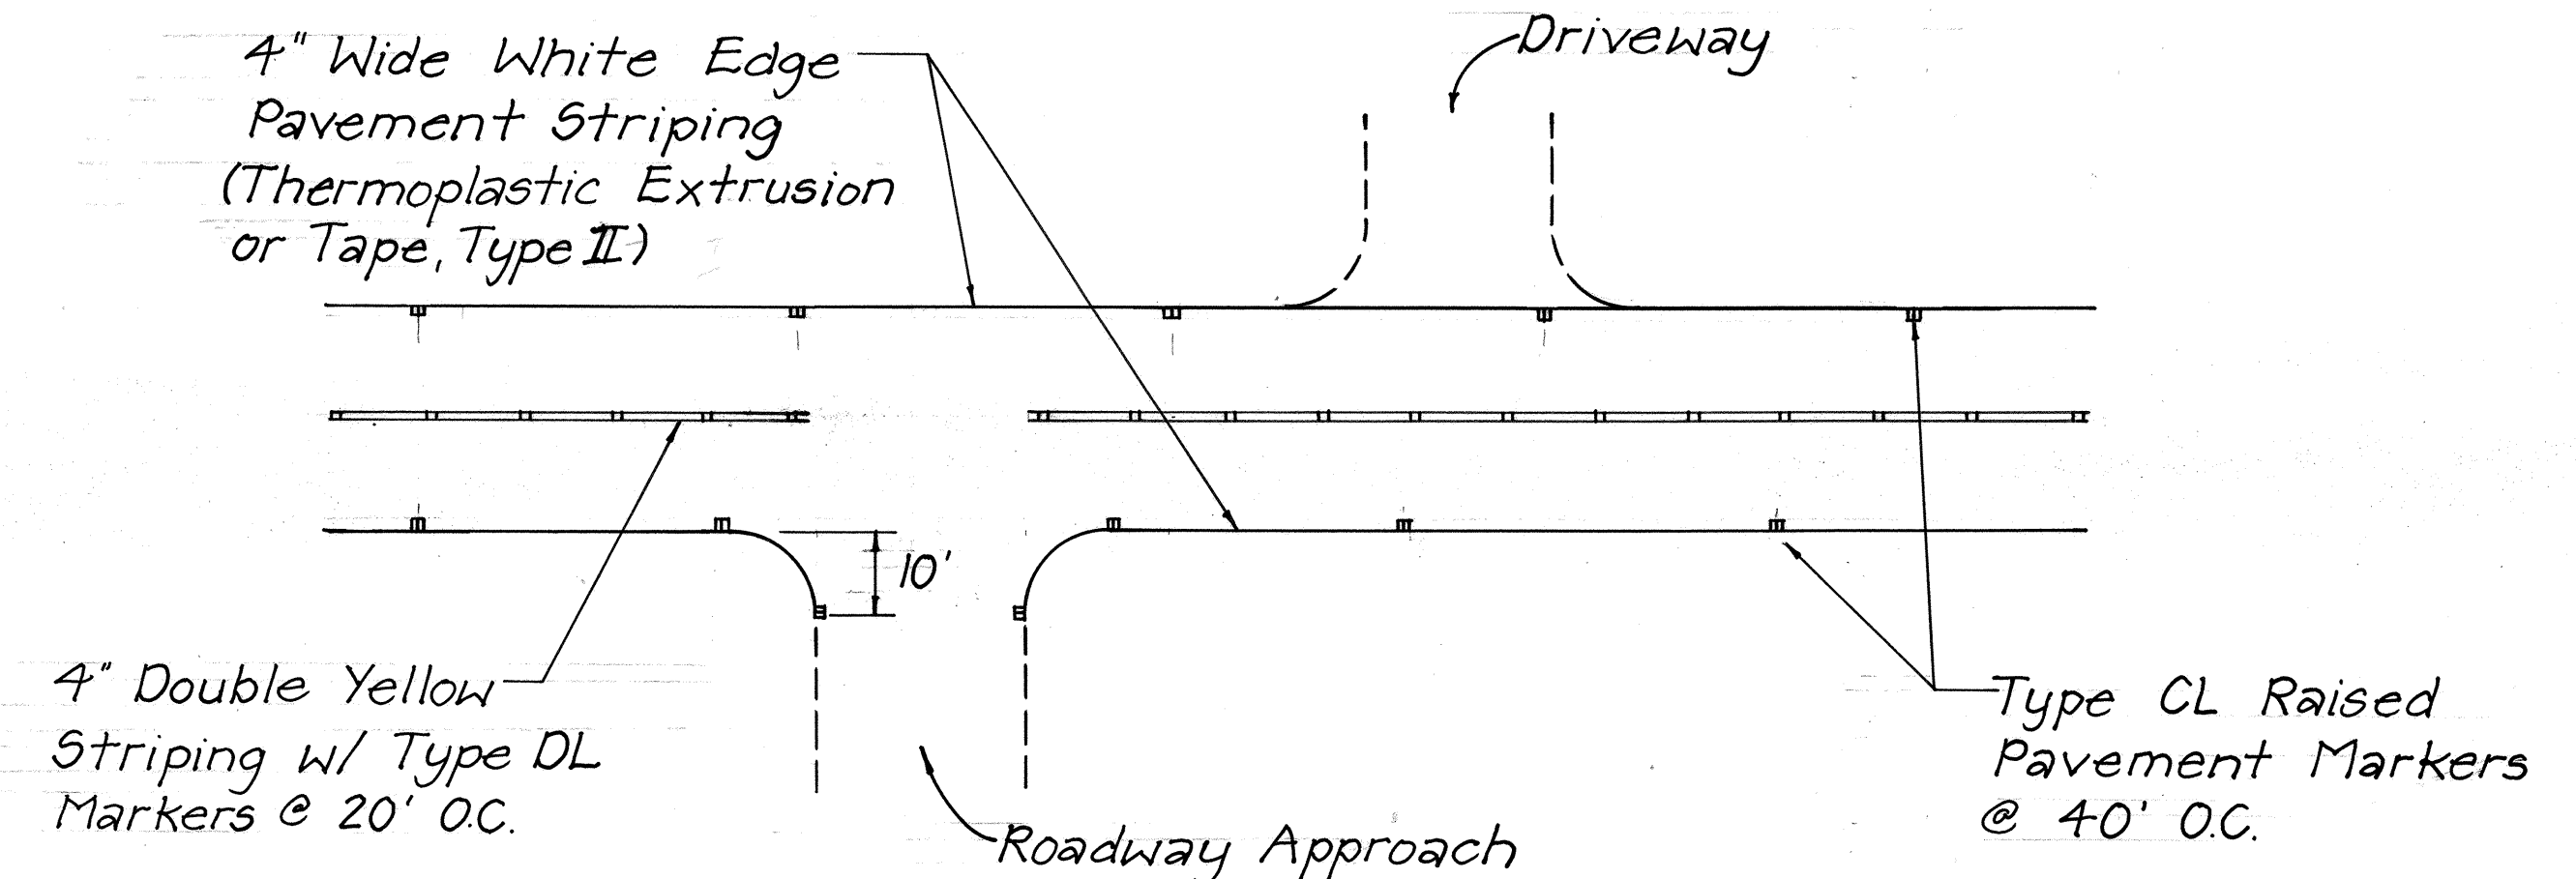


TYPICAL EDGE LINE WITH RAISED PAVEMENT MARKERS
Not to Scale

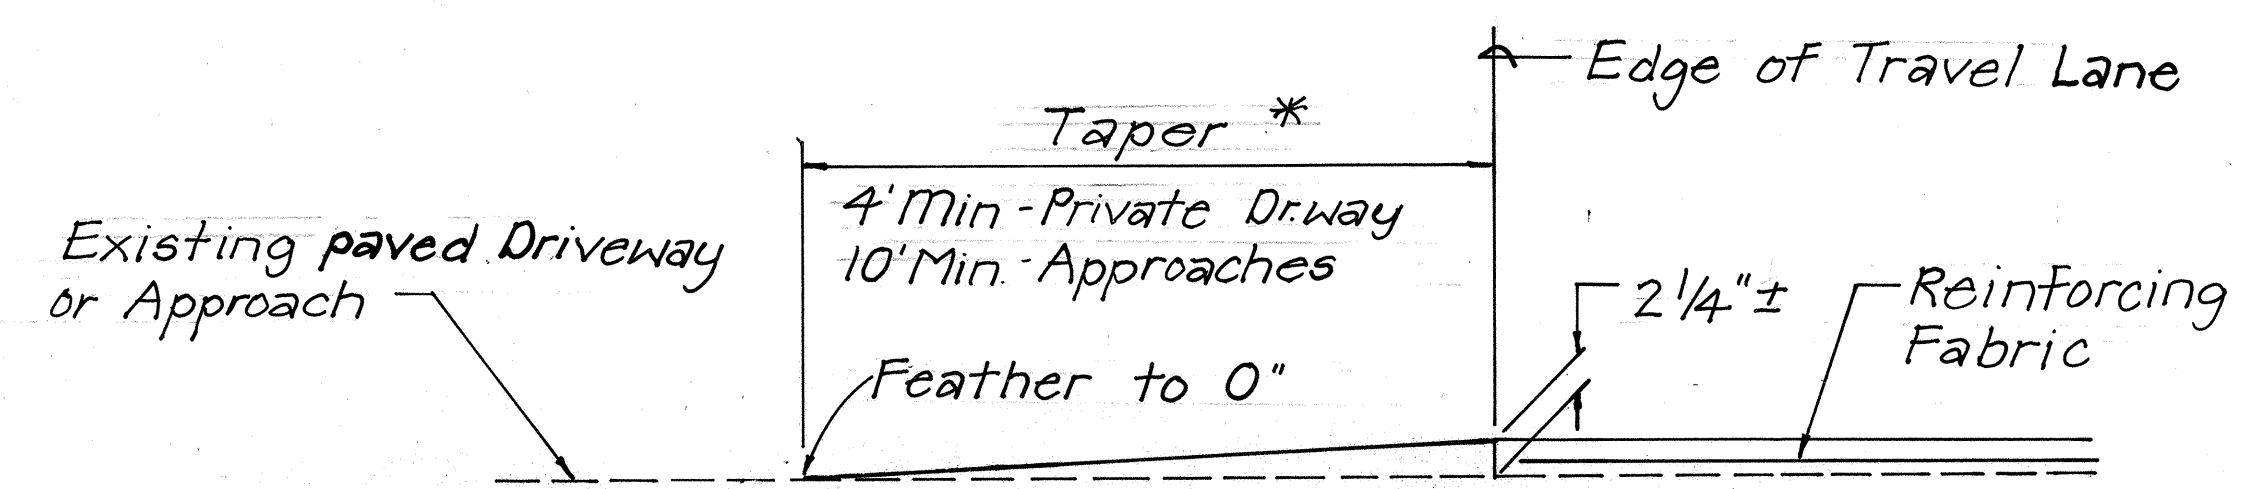

TYPICAL LONGITUDINAL SECTION AT DRIVEWAYS AND APPROACHES
Not to Scale

All existing swales shall be maintained

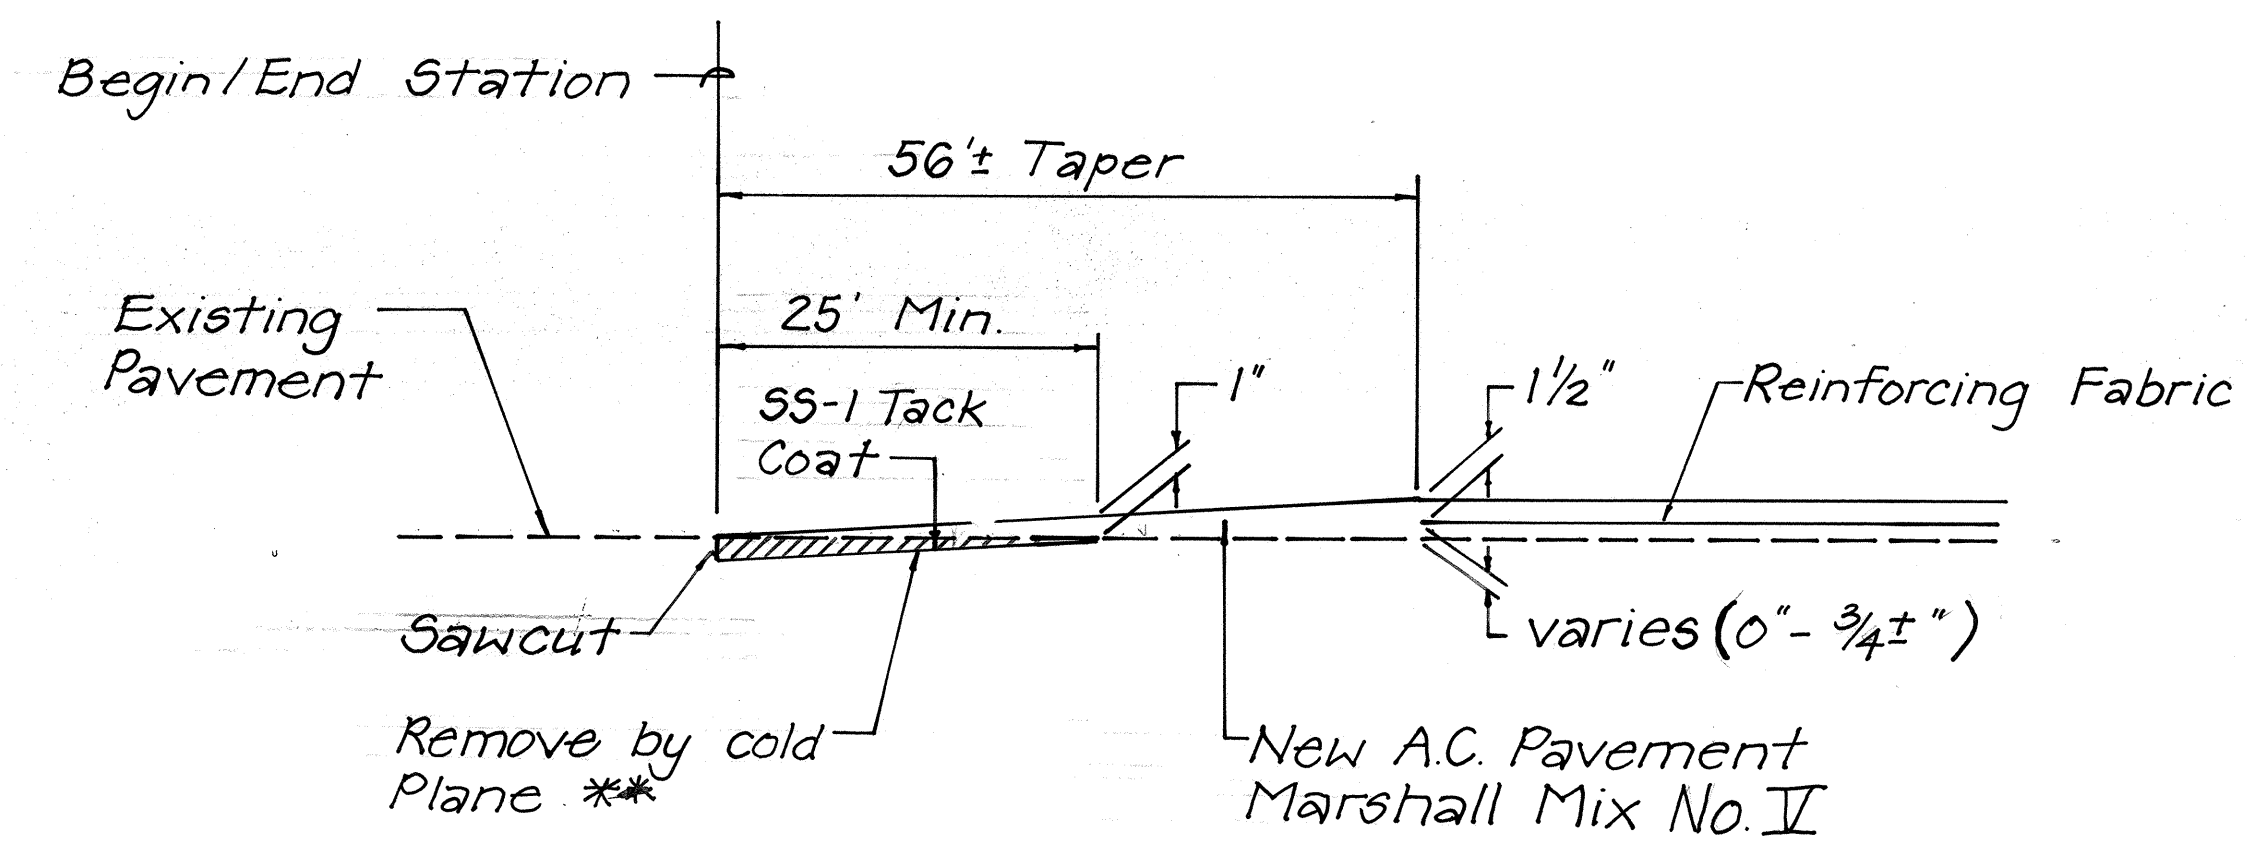

PAVEMENT TRANSITION AT BEGIN/END OF PROJECT
Not to Scale

** Cold Plane shall not be measured nor paid for seperately but shall be incidental to the various pay items.

PAVEMENT MARKING TABLE

STATION (100' Sta)	LENGTH (Ft)	ZONE	TYPE DL @ 20'	TYPE CL EDGE @ 40'	STRIPING			
					NO PASS INTER	EDGE @ 40'	DbL CL	2 Edge 1 Edge
445+10			4	5				
469+10	2400	NP	120	120	2400	4800		
502+50	3340	NP	167	167	3340	6680		
536+10	3360	NP	168	168	3360	6720		
543+10	700	NP	35	35	700	1400		
543+30	20	INTER		1		40	60	50
544+10	80	NP	4	4	80	160		
544+50	40	INTER		2		80	120	20
570+10	2560	NP	128	128	2560	5120		
597+10	2700	NP	135	135	2700	5400		
623+10	2600	NP	130	130	2600	5200		
648+30	2520	NP	126	126	2520	5040		
678+10	2980	NP	149	149	2980	5960		
709+10	3100	NP	155	155	3100	6200		
717+30	820	NP	41	41	820	1640		
717+70	40	INTER		2		80	180	20
740+78	2308	NP	116	116	2308	4616		
	29,568		1478	1484	29,468	59,136	360	90
	FT.		EA.	EA.		FT.		

ROADWAY LENGTH = 29,568 Ft.
 STRIPING LENGTH
 Single 4" Wide(White) = 59,496 Ft. — 59,146 Ft.
 Double 4" Wide(Yellow) = 29,468 Ft. — 29,521 Ft.
 Stop Bars 12" Wide(White) = 90 Ft. — 27 Ft.
 TYPE DL = 1,478 Ea. — 1,456 Ft.
 TYPE CL = 1484 Ea. — 1,457 Ft.
 (ACTUAL QUANTITIES)

STATE OF HAWAII
DEPARTMENT OF TRANSPORTATION
HIGHWAYS DIVISION

TYPICAL SECTIONS, PAV'T
MARK'G PLAN & TABLE
KOEKE RD. RESURFACING
PROJ. NO. 550B-01-91M
Scale : As Shown Date : Nov 1990
SHEET No. 1 OF 1 SHEETS

SURVEY PLOTTED BY	DATE
DRAWN BY	
DESIGNED BY	
CHECKED BY	
ORIGINAL PLAN	
NOTE BOOK	
No.	