


FED. ROAD DIST. NO.	STATE	PROJ. NO.	FISCAL YEAR	SHEET NO.	TOTAL SHEETS
HAWAII	HAW.	550A-01-95M	1995	16	25

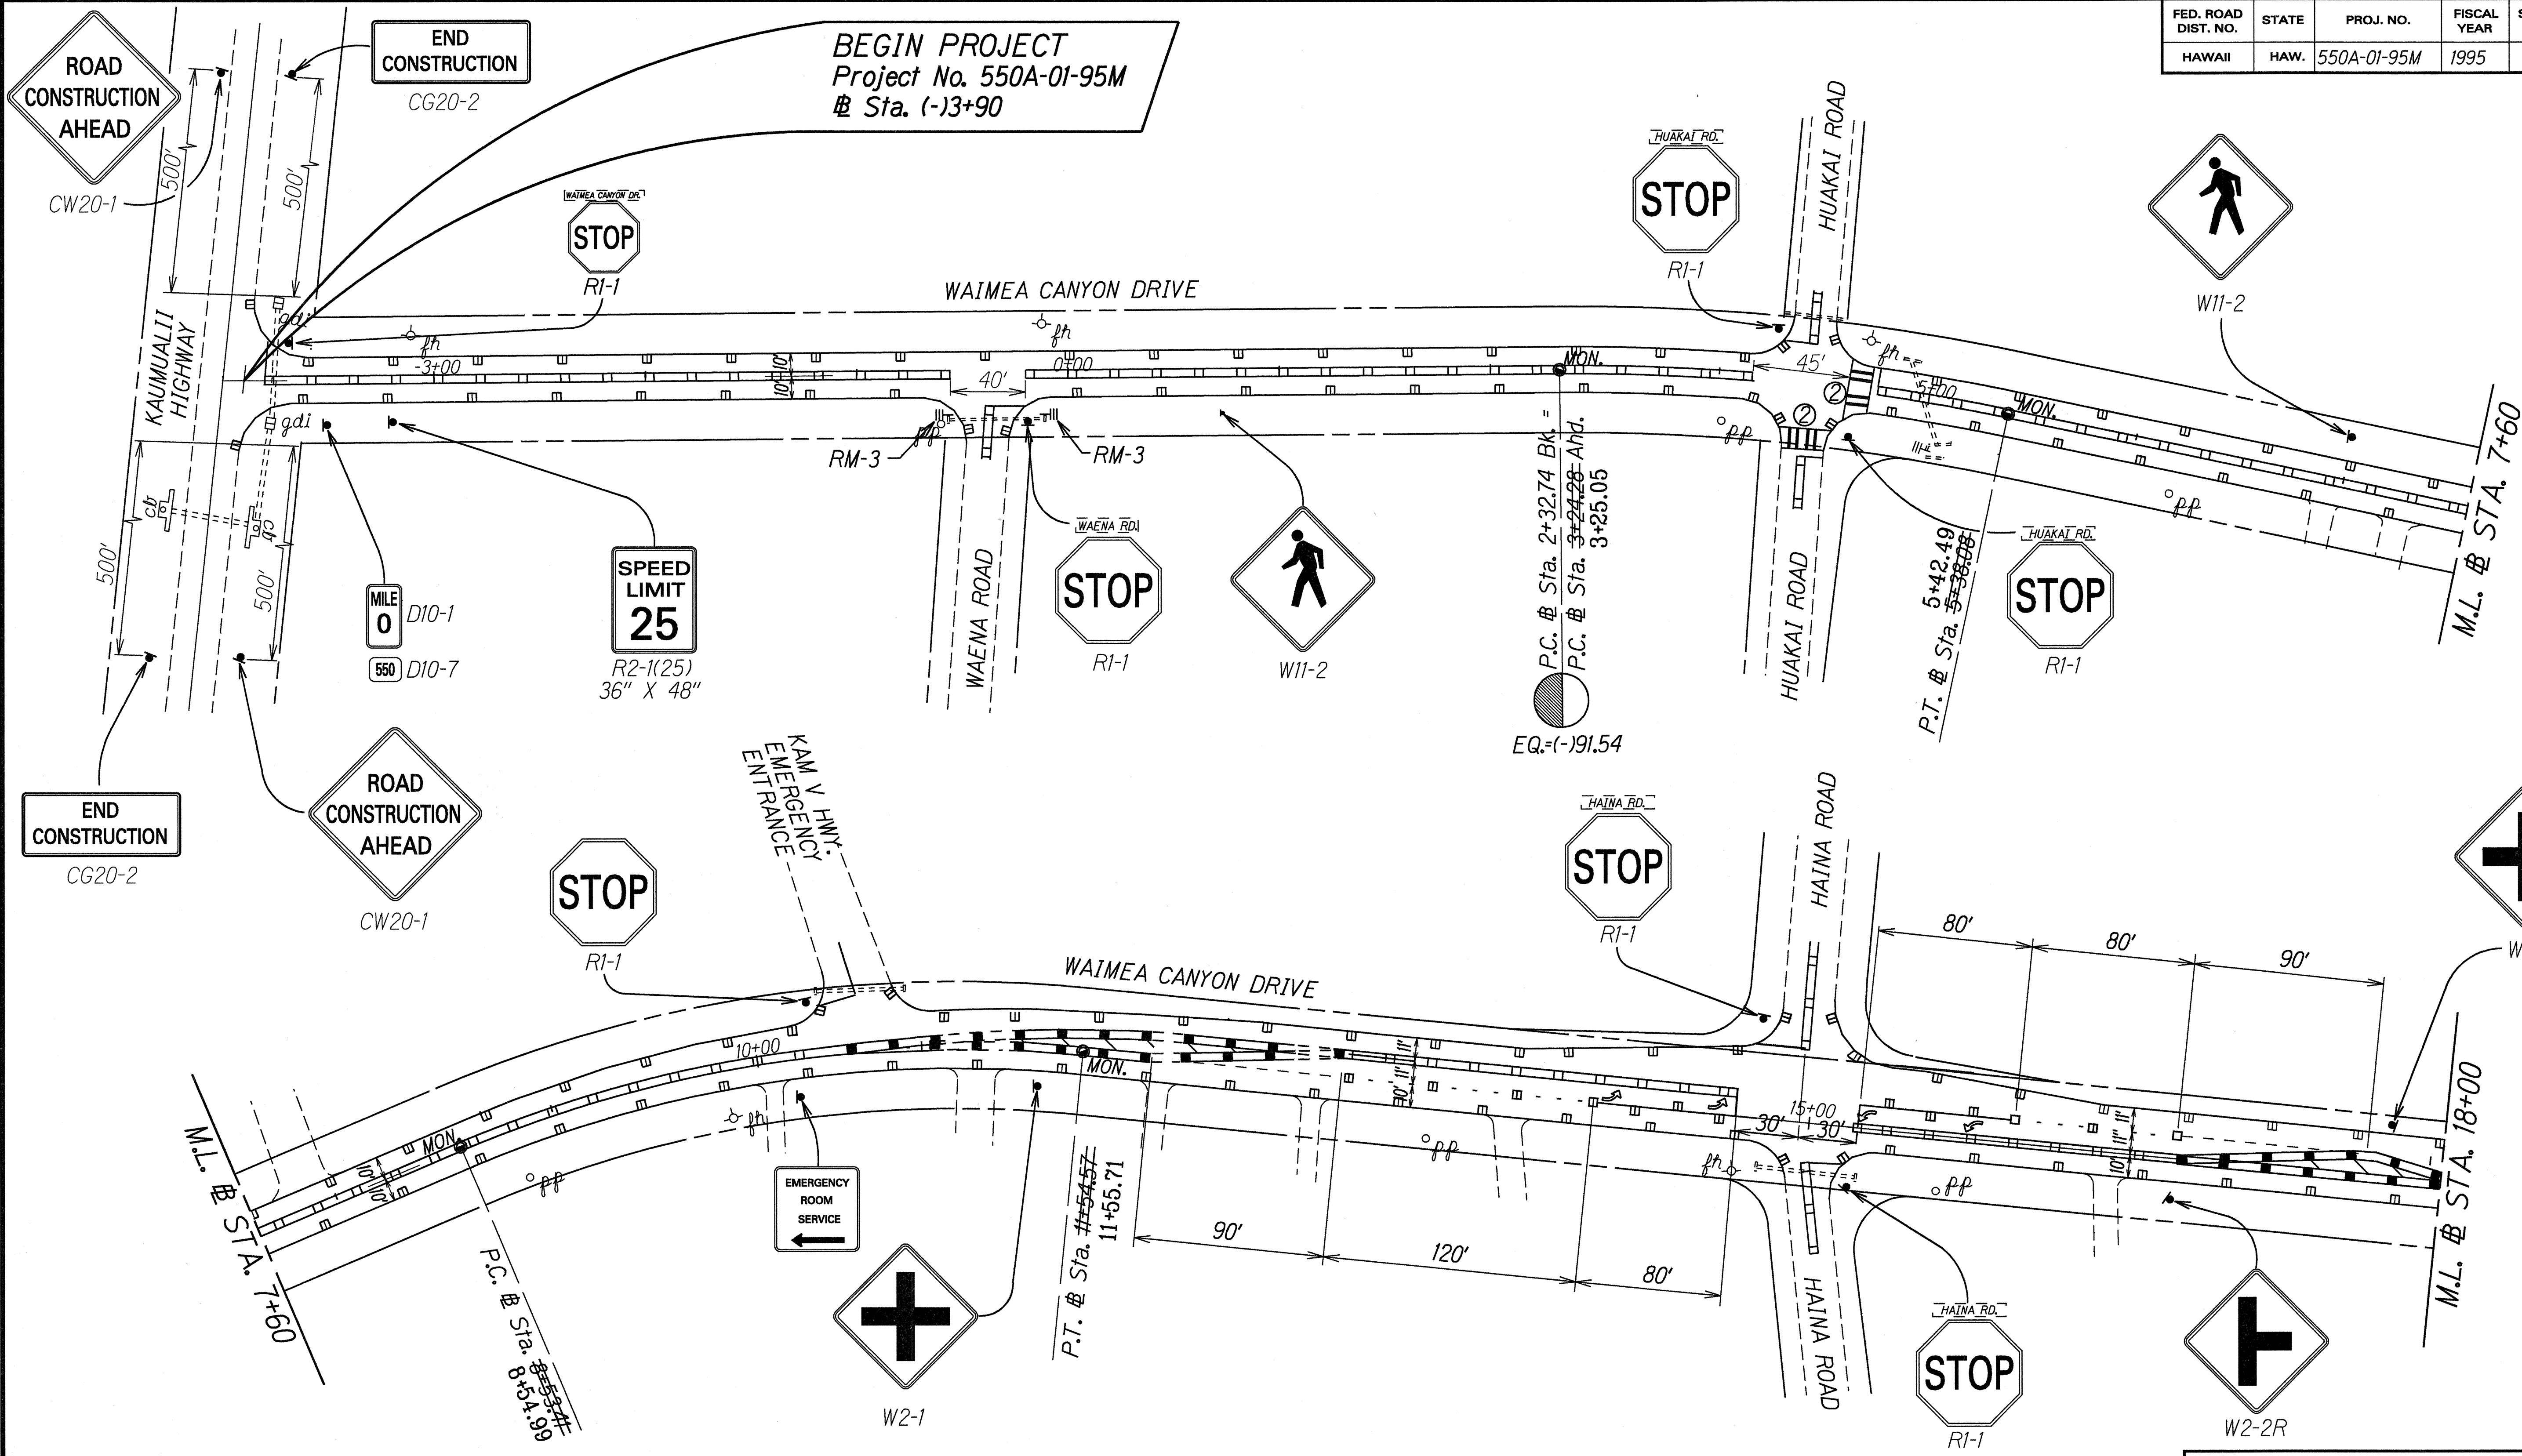

ORIGINAL PLAN	SURVEY PLOTTED BY	DATE
NOTED BOOK	DRAWN BY	
DESIGNED BY	CHECKED BY	
QUANTITIES BY		
INVESTIGATED BY		
CHECKED BY		

LEGEND FOR AS-BUILT POSTINGS	
	Squiggly line for as-built deletion
	Double line for as-built deletion
Roadway	Text for as-built posting

STATE OF HAWAII
DEPARTMENT OF TRANSPORTATION
HIGHWAYS DIVISION

PAVEMENT MARKINGS.
STRIPING & TRAFFIC SIGNS

WAIMEA CANYON DRIVE RESURFACING


M.P. 0.00 TO M.P. 2.75

Project No. 550A-01-95M

Scale: 1"=40' Date: Feb, 1995

SHEET No. 1 OF 8 SHEETS

FED. ROAD DIST. NO.	STATE	PROJ. NO.	FISCAL YEAR	SHEET NO.	TOTAL SHEETS
HAWAII	HAW.	550A-01-95M	1995	19	25

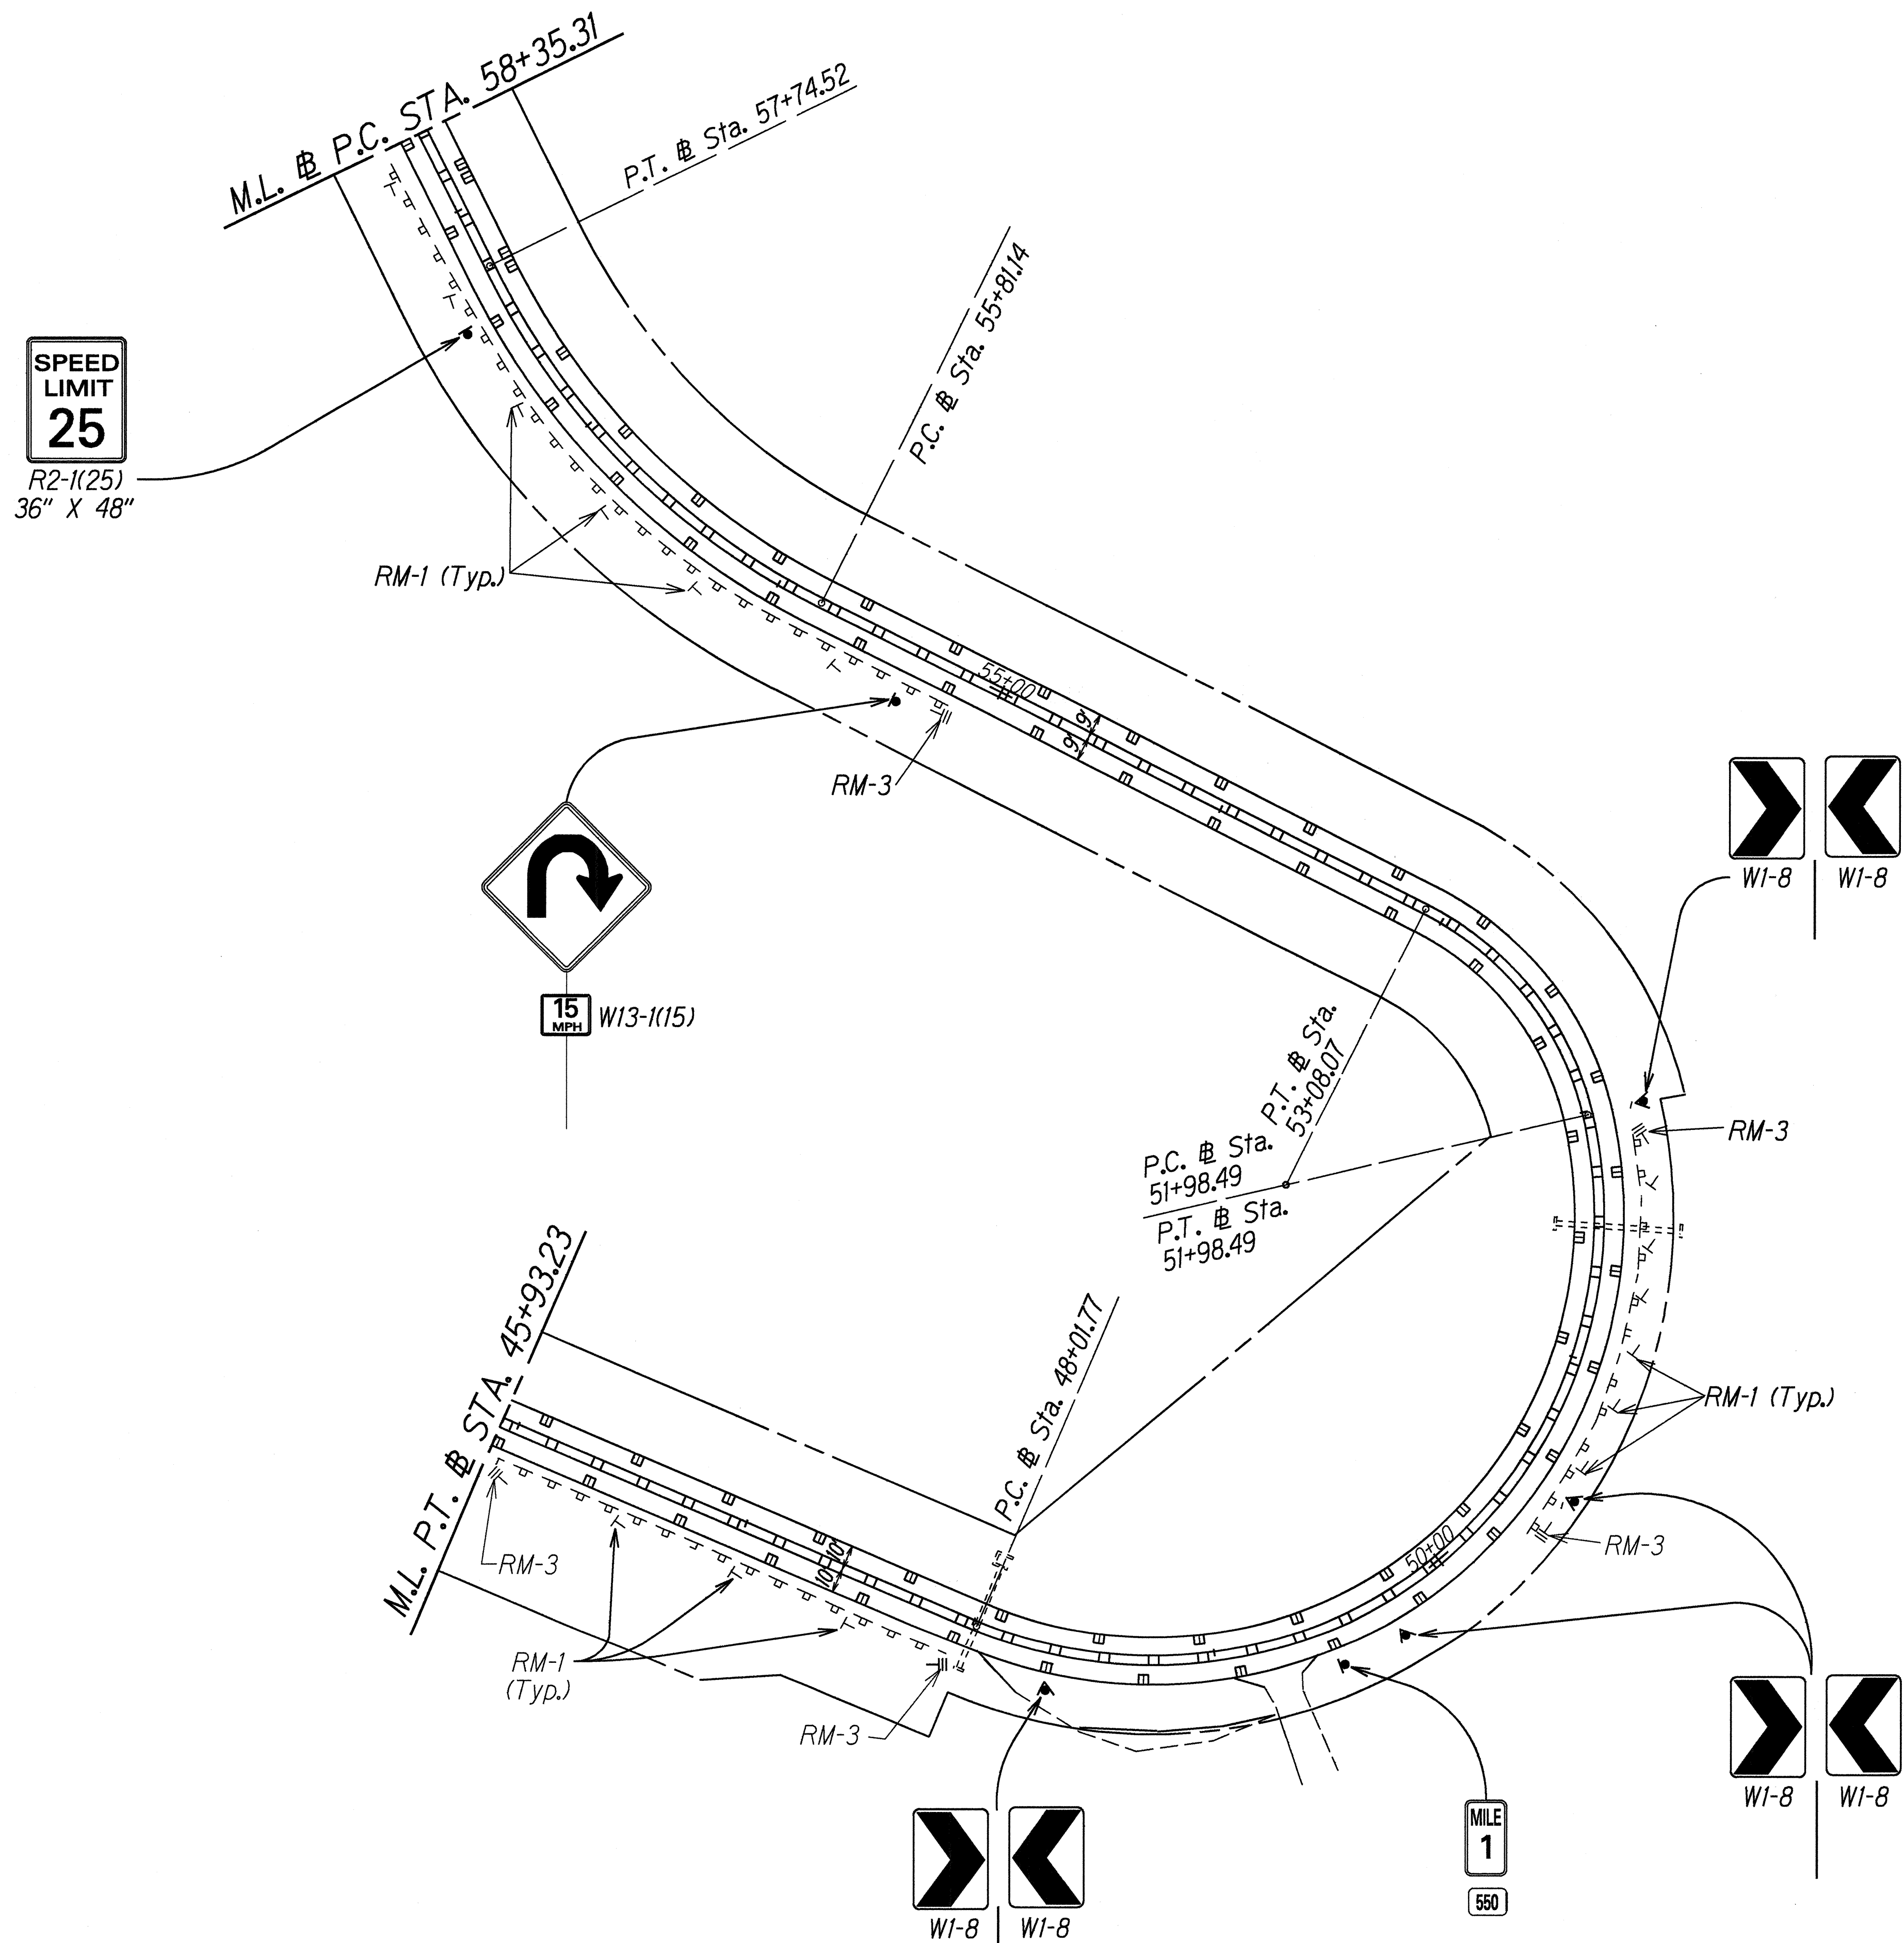

SURVEY PLOTTED BY	DATE
DESIGNED BY	
QUANTITIES BY	
CHECKED BY	
ORIGINAL PLAN	
NOTE BOOK	
INSTRUMENT	
SCALE	

STATE OF HAWAII
DEPARTMENT OF TRANSPORTATION
HIGHWAYS DIVISION

**PAVEMENT MARKINGS,
STRIPING & TRAFFIC SIGNS**

WAIMEA CANYON DRIVE RESURFACING


M.P. 0.00 TO M.P. 2.75

Project No. 550A-01-95M

Scale: 1"=40' Date: Feb, 1995

SHEET No. 4 OF 8 SHEETS

FED. ROAD DIST. NO.	STATE	PROJ. NO.	FISCAL YEAR	SHEET NO.	TOTAL SHEETS
HAWAII	HAW.	550A-01-95M	1995	20	25

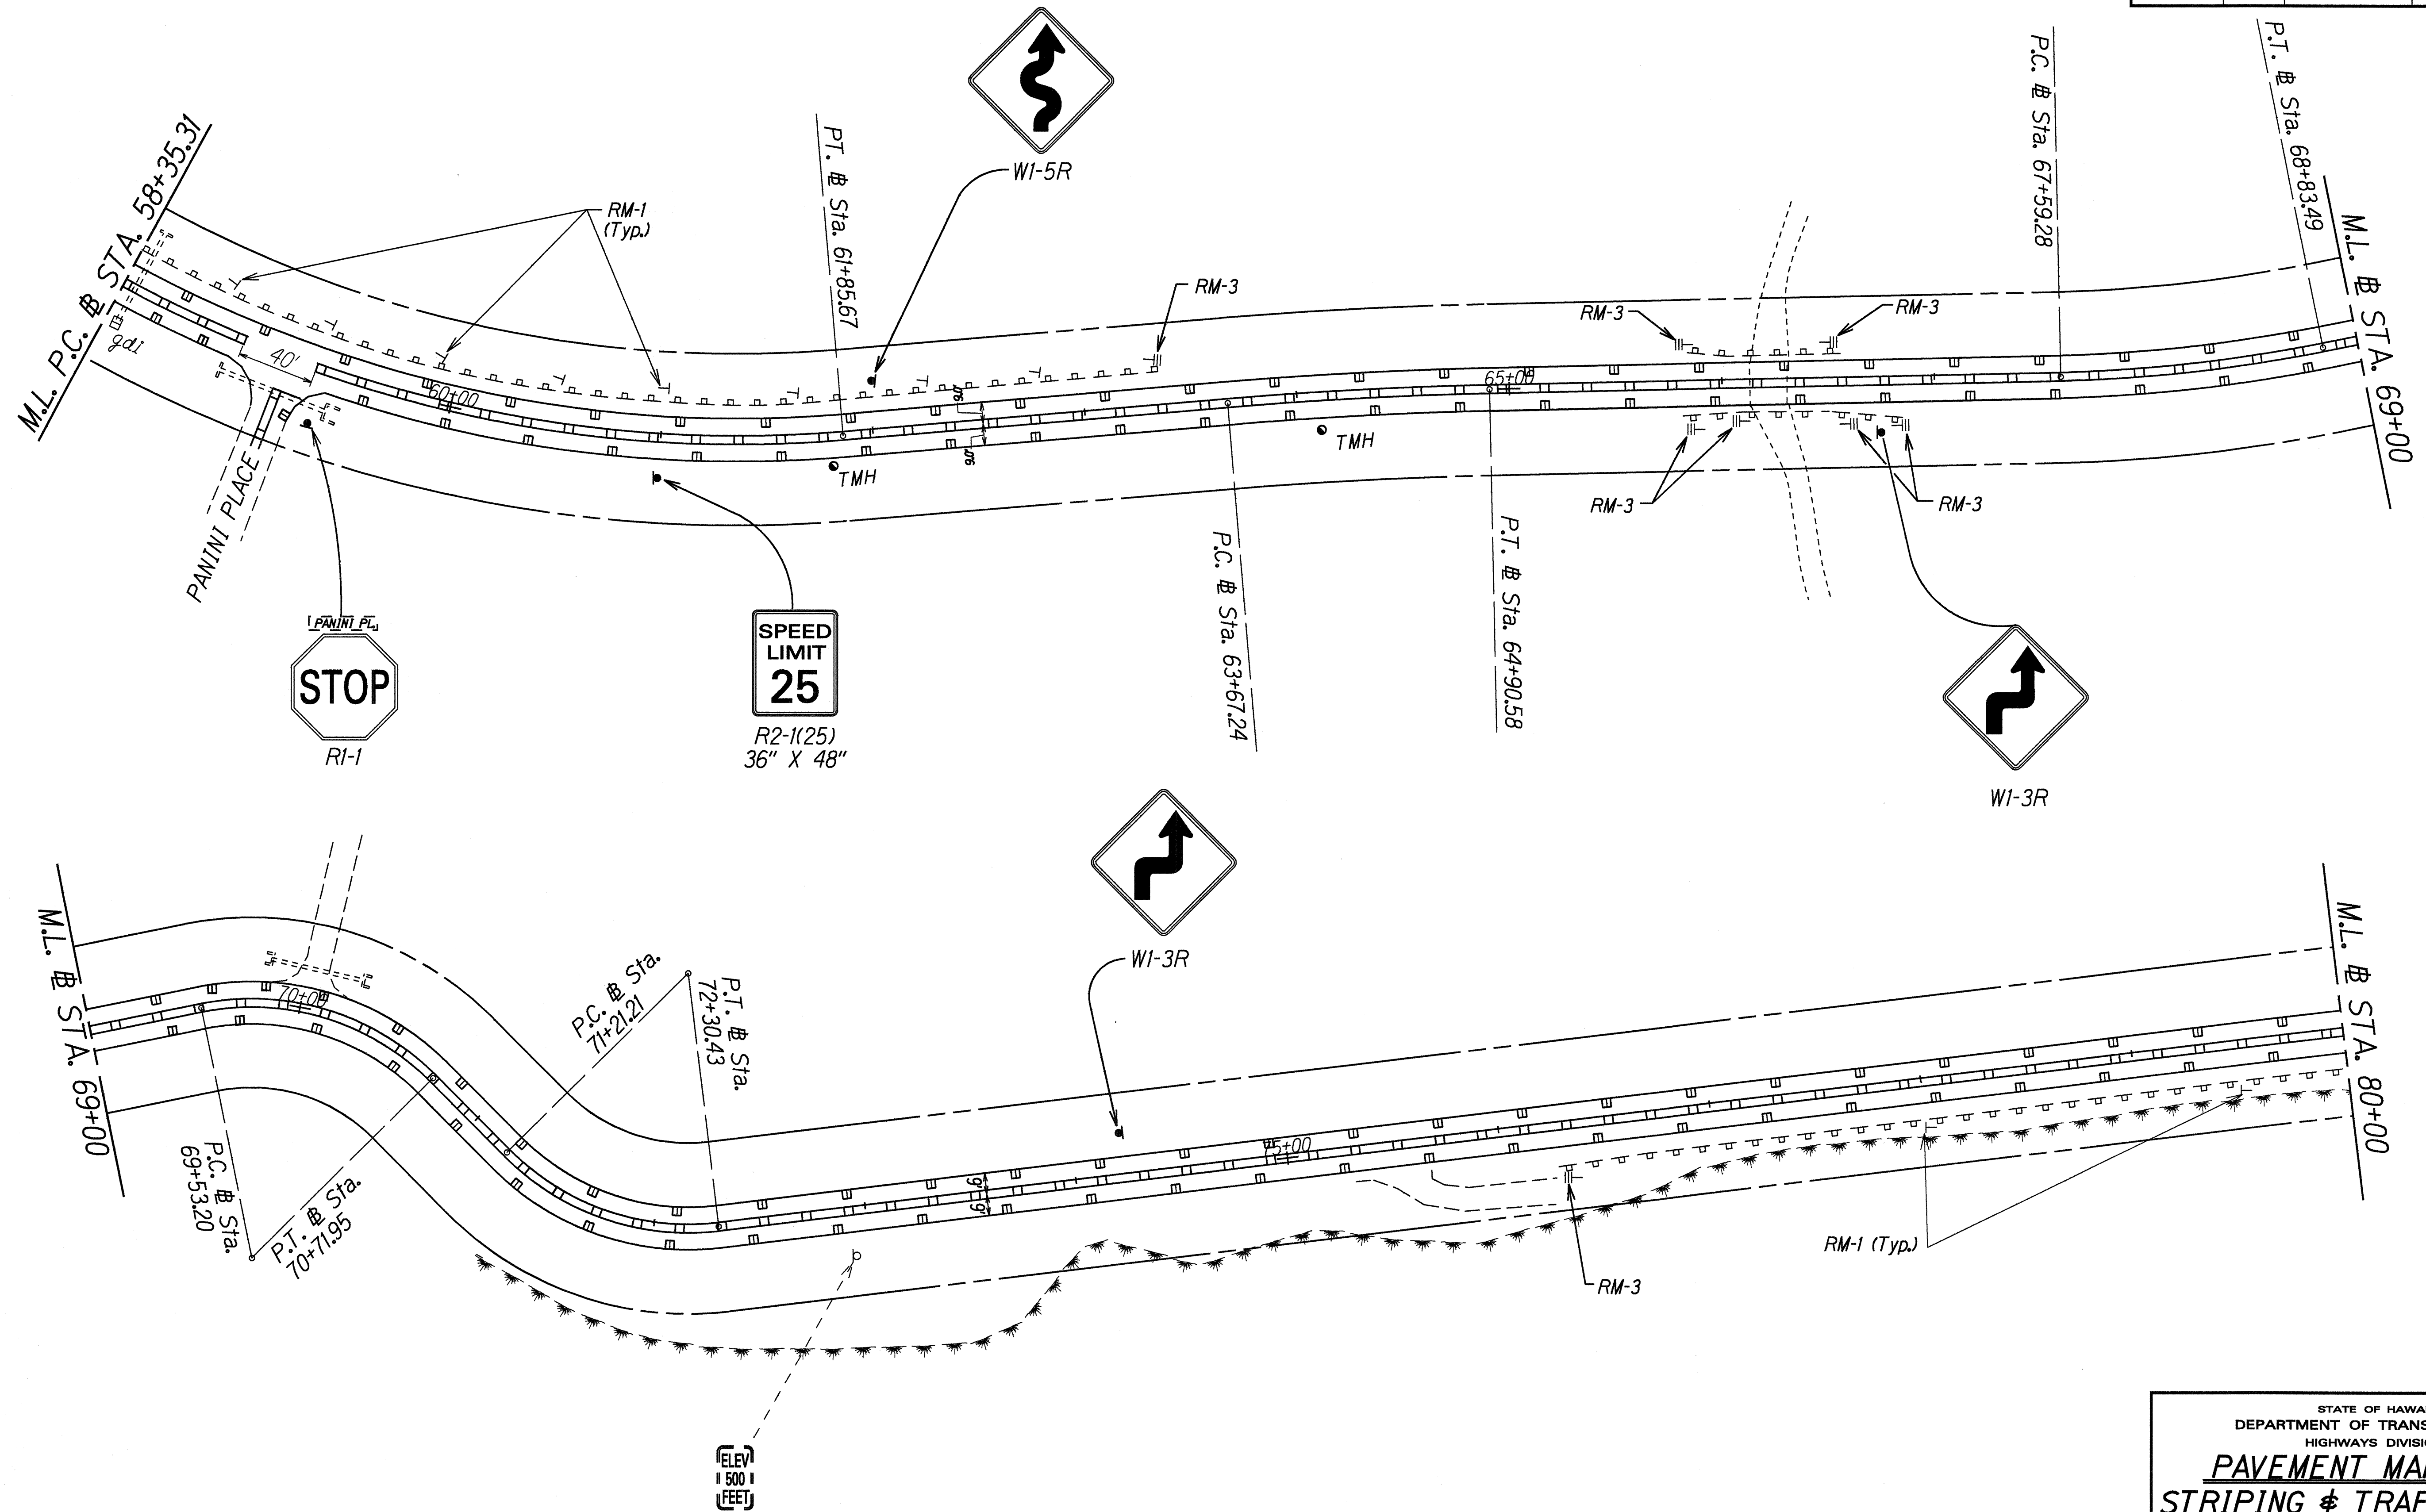

ORIGINAL PLAN	DATE
SURVEY PLOTTED BY	
DRAWN BY	
DESIGNED BY	
QUANTITIES BY	
CHECKED BY	

STATE OF HAWAII
DEPARTMENT OF TRANSPORTATION
HIGHWAYS DIVISION

**PAVEMENT MARKINGS,
STRIPING & TRAFFIC SIGNS**

WAIMEA CANYON DRIVE RESURFACING


M.P. 0.00 TO M.P. 2.75

Project No. 550A-01-95M

Scale: 1"=40' Date: Feb, 1995

SHEET No. 5 OF 8 SHEETS


FED. ROAD DIST. NO.	STATE	PROJ. NO.	FISCAL YEAR	SHEET NO.	TOTAL SHEETS
HAWAII	HAW.	550A-01-90M	1995	21	25

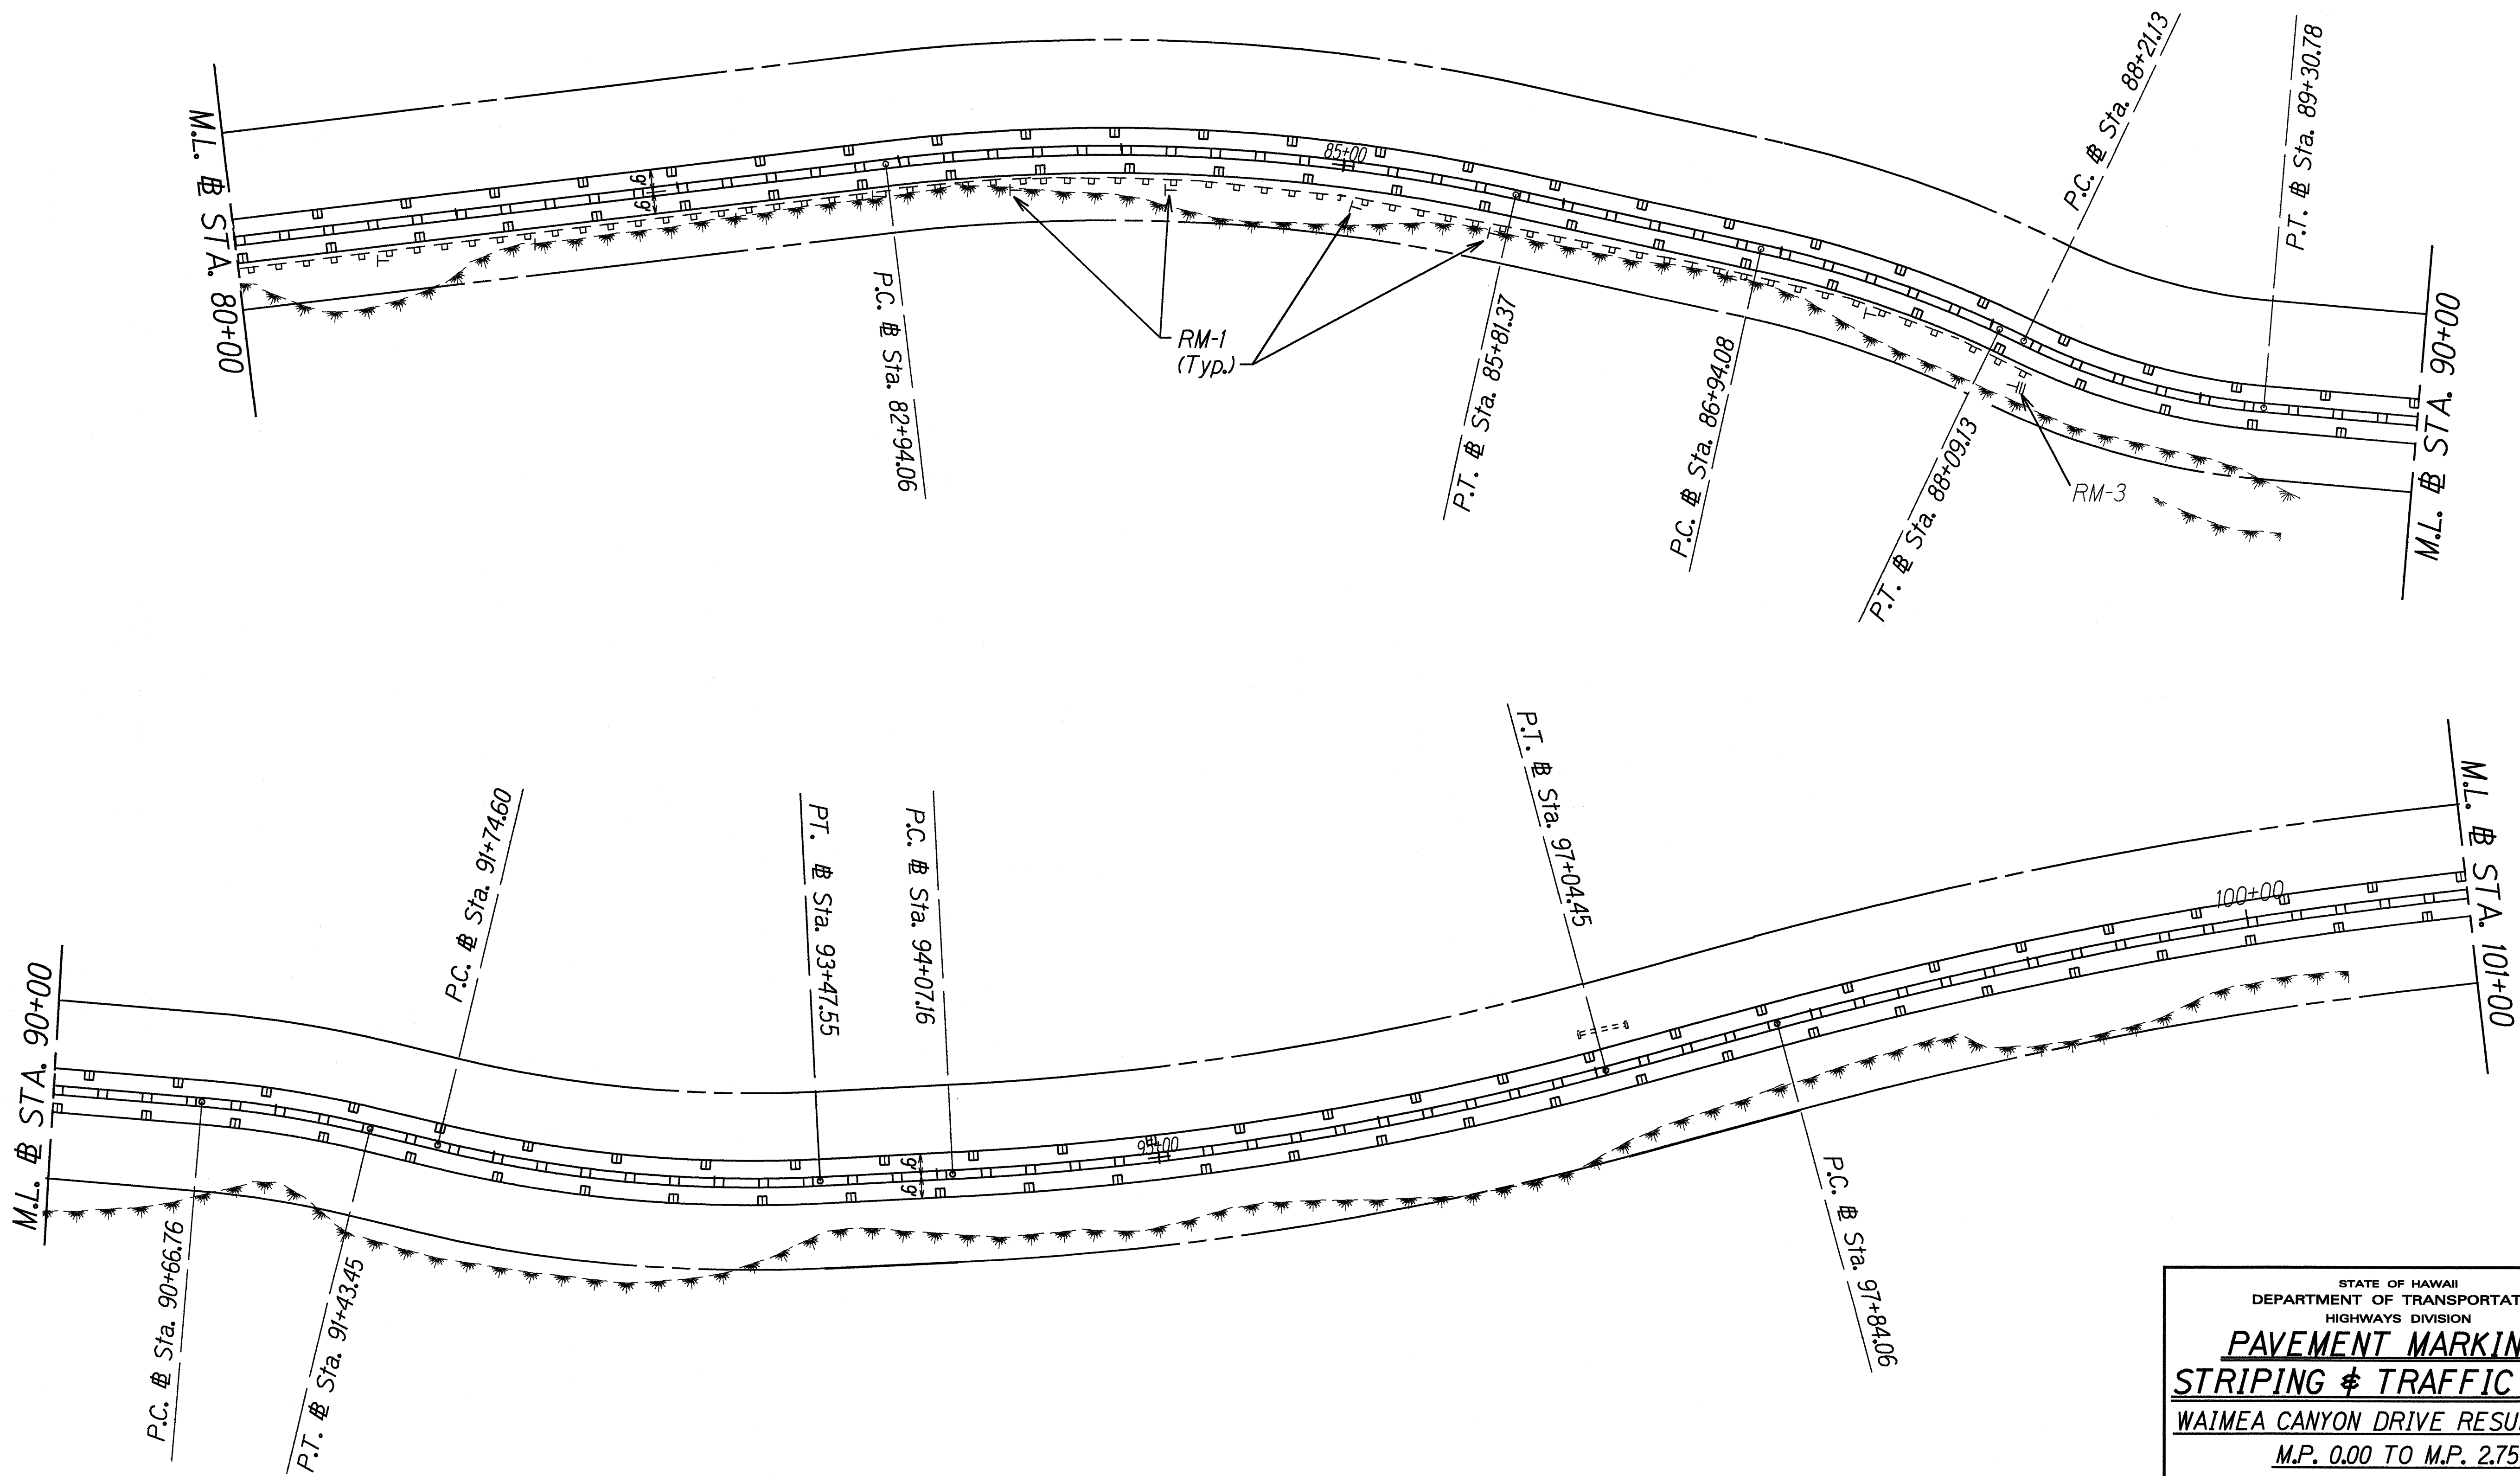

ORIGINAL PLAN	SURVEY PLOTTED BY	DATE
NOTE BOOK	DESIGNED BY	
INVESTIGATION	QUANTITIES BY	
	CHECKED BY	

STATE OF HAWAII
DEPARTMENT OF TRANSPORTATION
HIGHWAYS DIVISION
**PAVEMENT MARKINGS,
STRIPING & TRAFFIC SIGNS**
WAIMEA CANYON DRIVE RESURFACING
M.P. 0.00 TO M.P. 2.75
Project No. 550A-01-95M
Scale: 1"=40' Date: Feb, 1995
SHEET No. 6 OF 8 SHEETS

FED. ROAD DIST. NO.	STATE	PROJ. NO.	FISCAL YEAR	SHEET NO.	TOTAL SHEETS
HAWAII	HAW.	550A-01-95M	1995	22	25

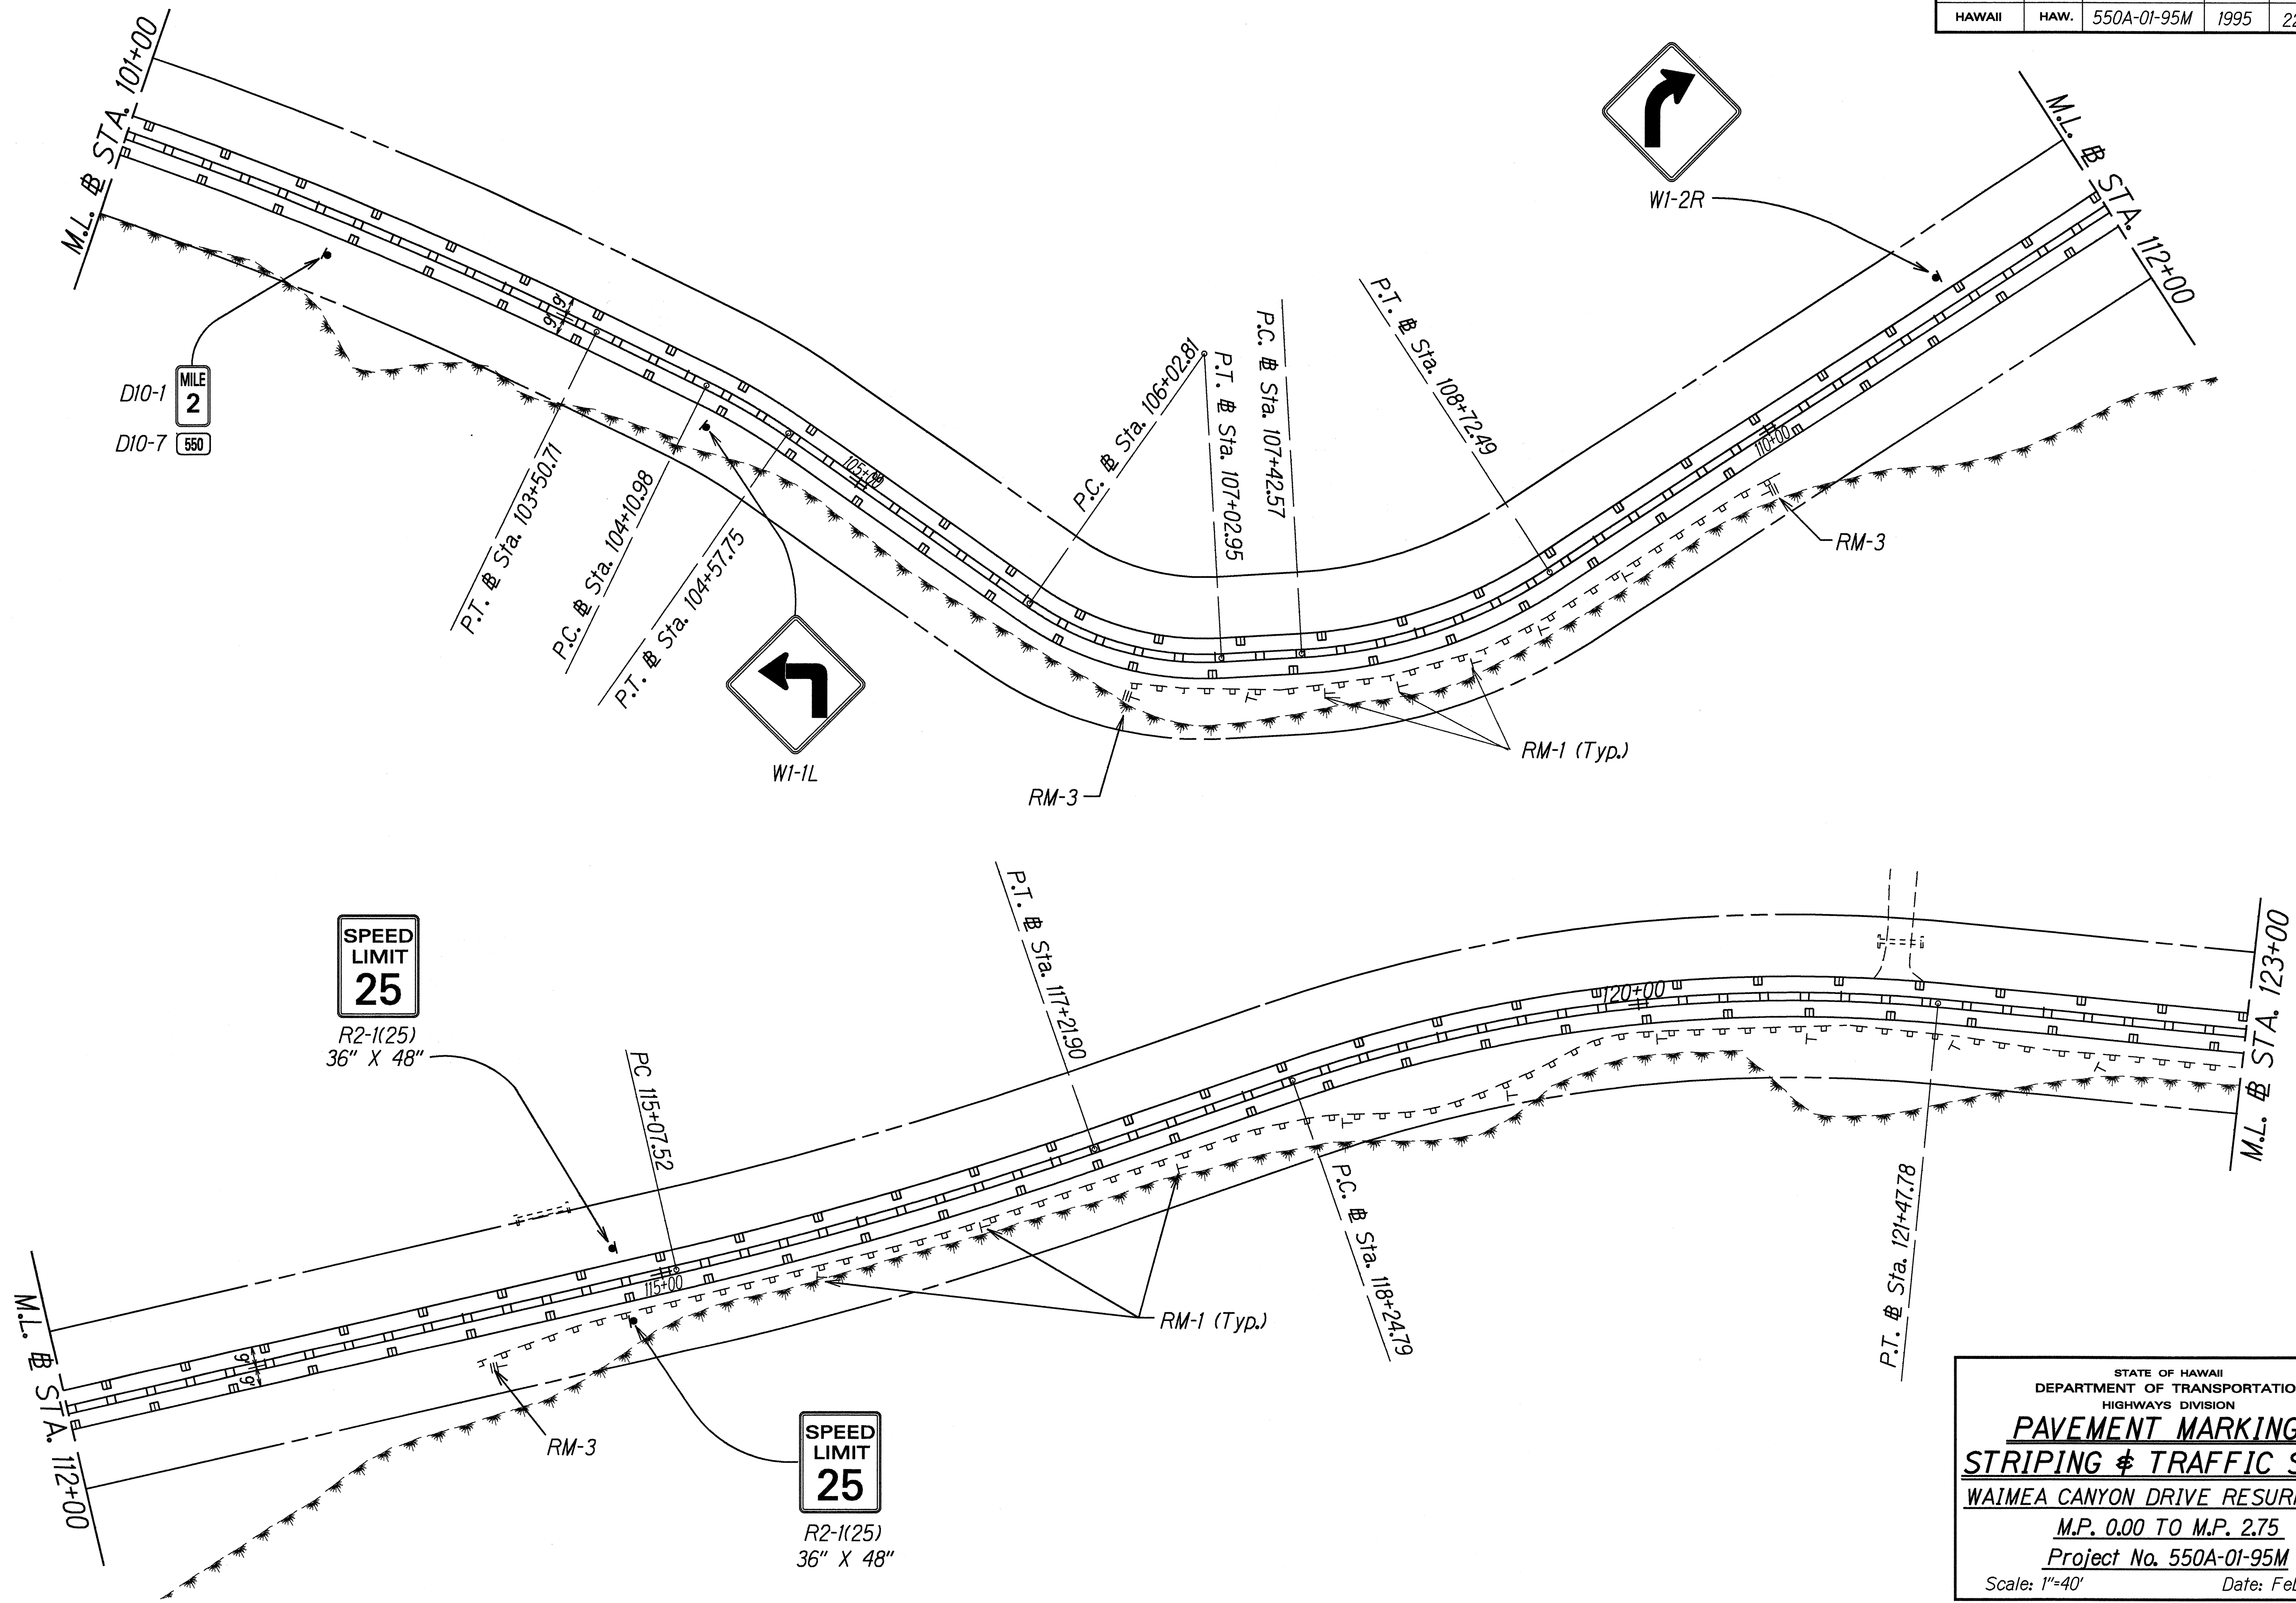

ORIGINAL PLAN	DATE
SURVEY PLOTTED BY	
DESIGNED BY	
QUANTITIES BY	
CHECKED BY	

STATE OF HAWAII
DEPARTMENT OF TRANSPORTATION
HIGHWAYS DIVISION

**PAVEMENT MARKINGS,
STRIPING & TRAFFIC SIGNS**

WAIMEA CANYON DRIVE RESURFACING


M.P. 0.00 TO M.P. 2.75

Project No. 550A-01-95M

Scale: 1"=40' Date: Feb, 1995

SHEET No. 7 OF 8 SHEETS

FED. ROAD DIST. NO.	STATE	PROJ. NO.	FISCAL YEAR	SHEET NO.	TOTAL SHEETS
HAWAII	HAW.	550A-01-95M	1995	23	25

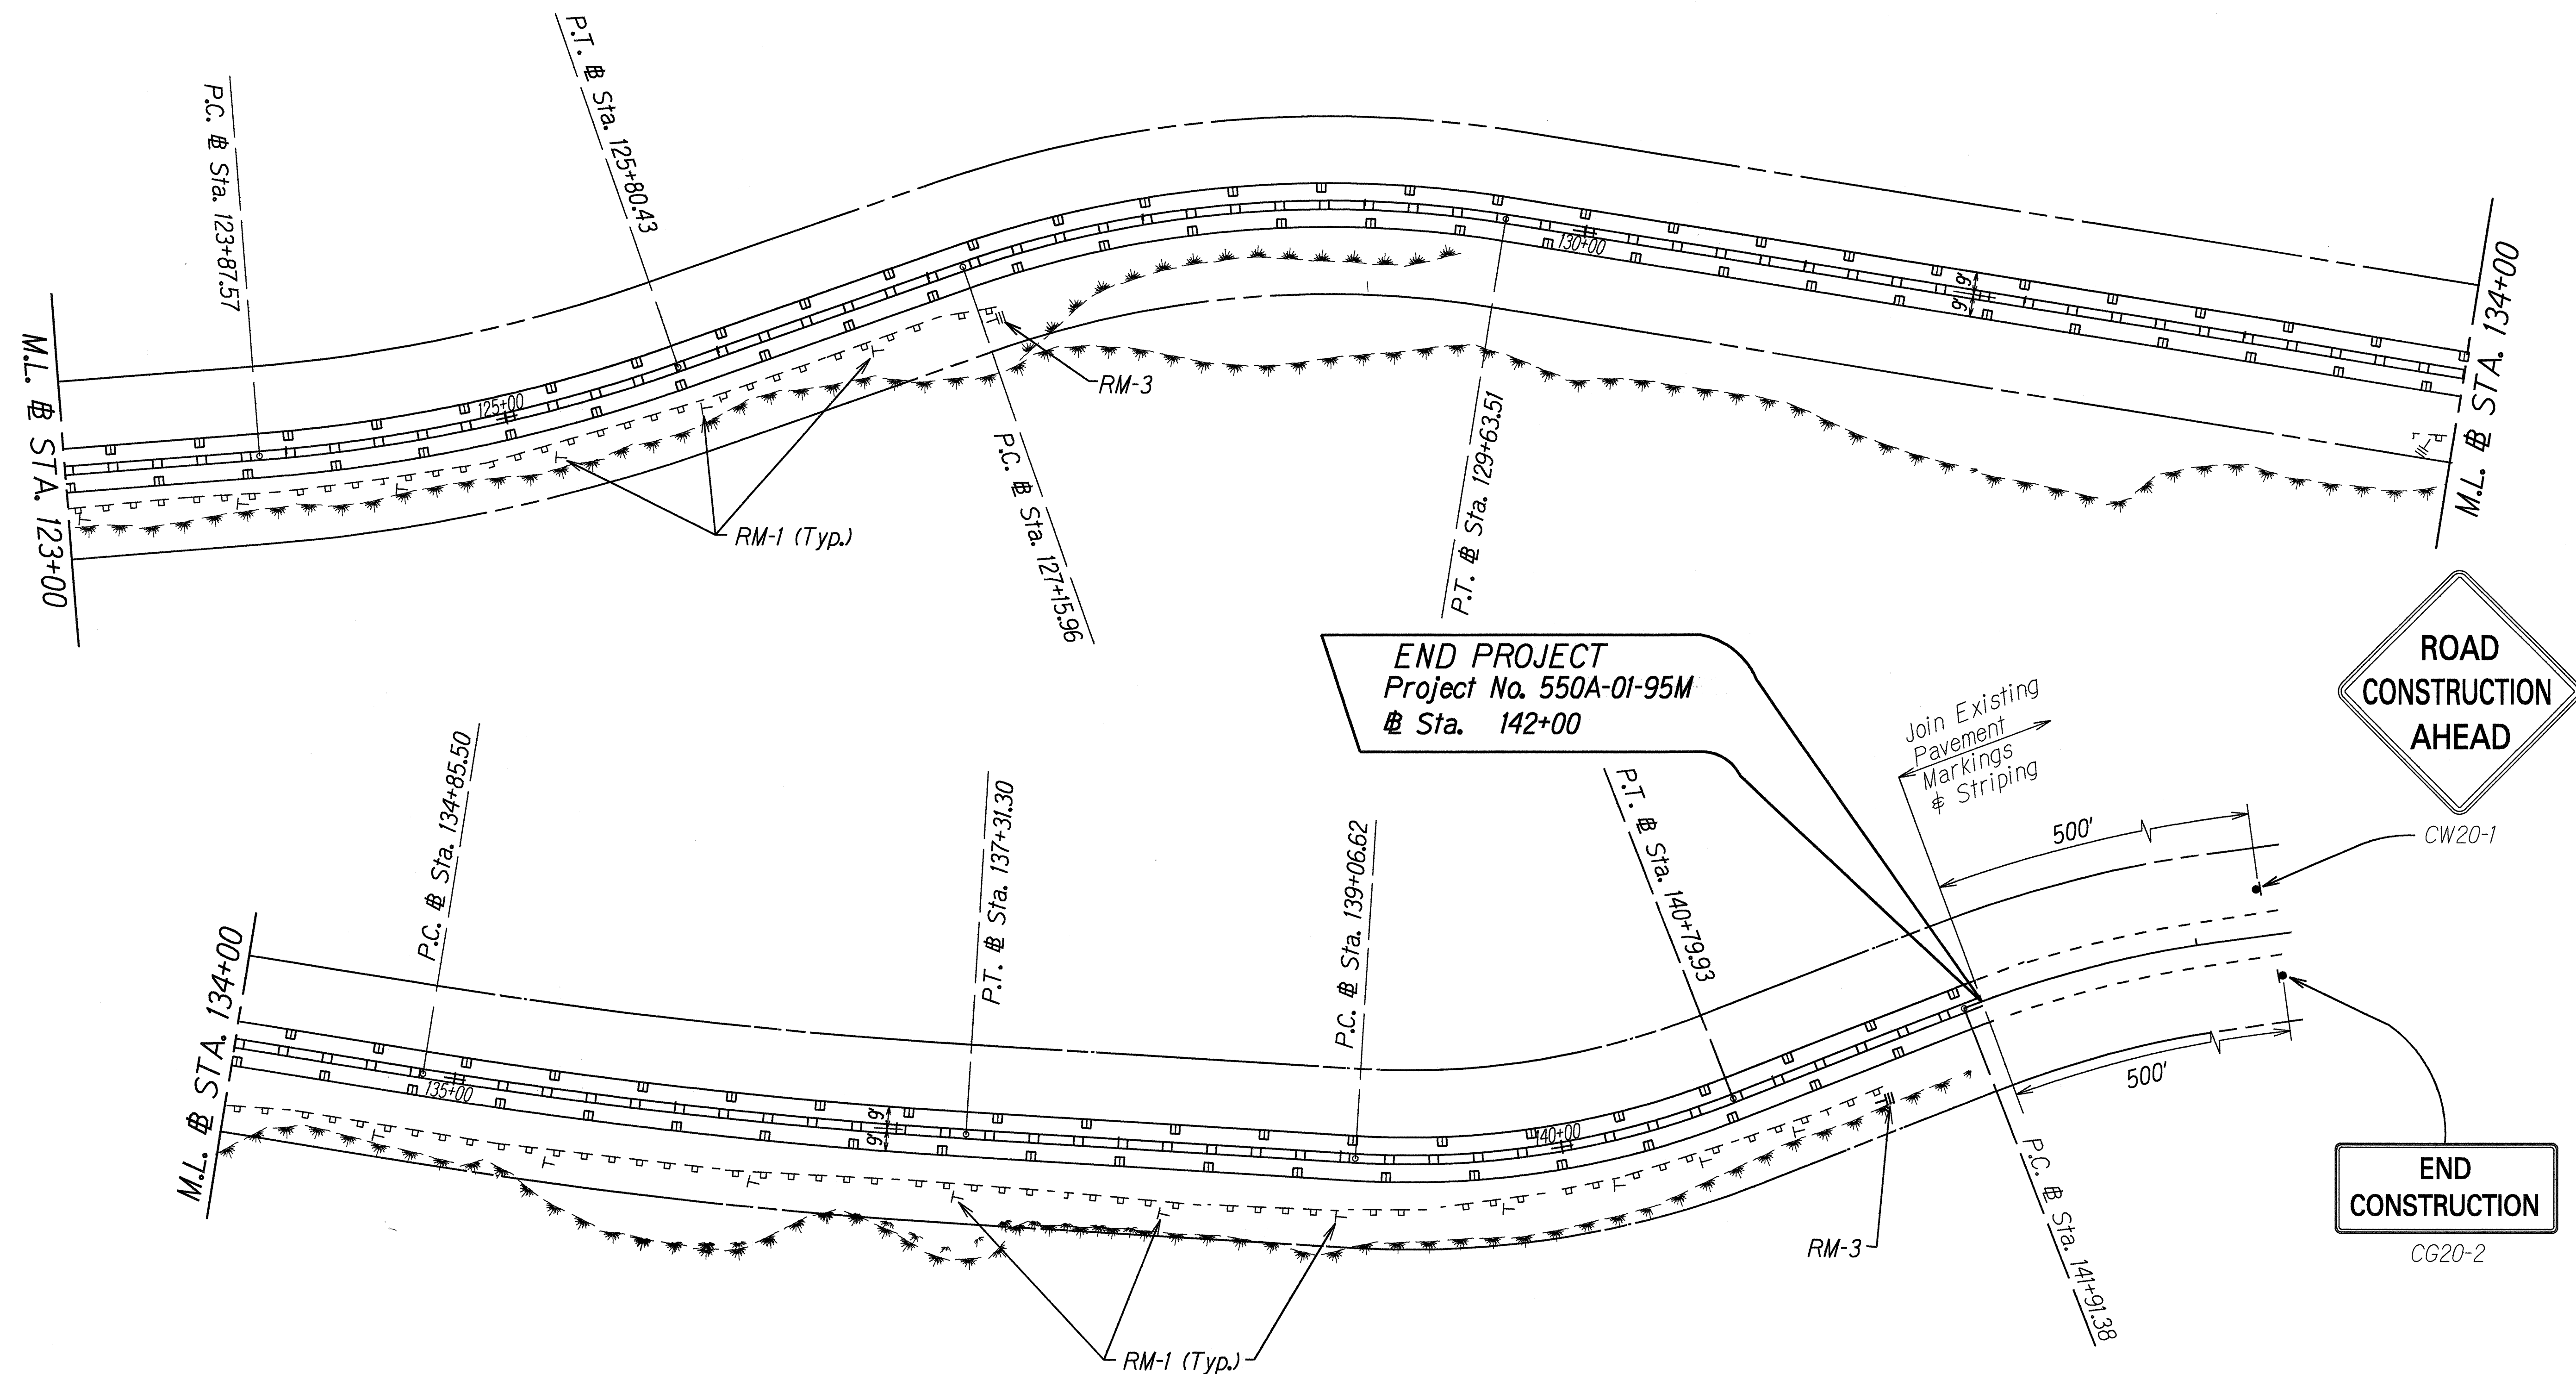

ORIGINAL PLAN	SURVEY PLOTTED BY	DATE
NOTES BOOK	DESIGNED BY	
INVESTIGATOR	CHECKED BY	

STATE OF HAWAII
DEPARTMENT OF TRANSPORTATION
HIGHWAYS DIVISION

**PAVEMENT MARKINGS,
STRIPING & TRAFFIC SIGNS**

WAIMEA CANYON DRIVE RESURFACING

M.P. 0.00 TO M.P. 2.75

Project No. 550A-01-95M

Scale: 1"=40' Date: Feb, 1995

SHEET No. 8 OF 8 SHEETS