
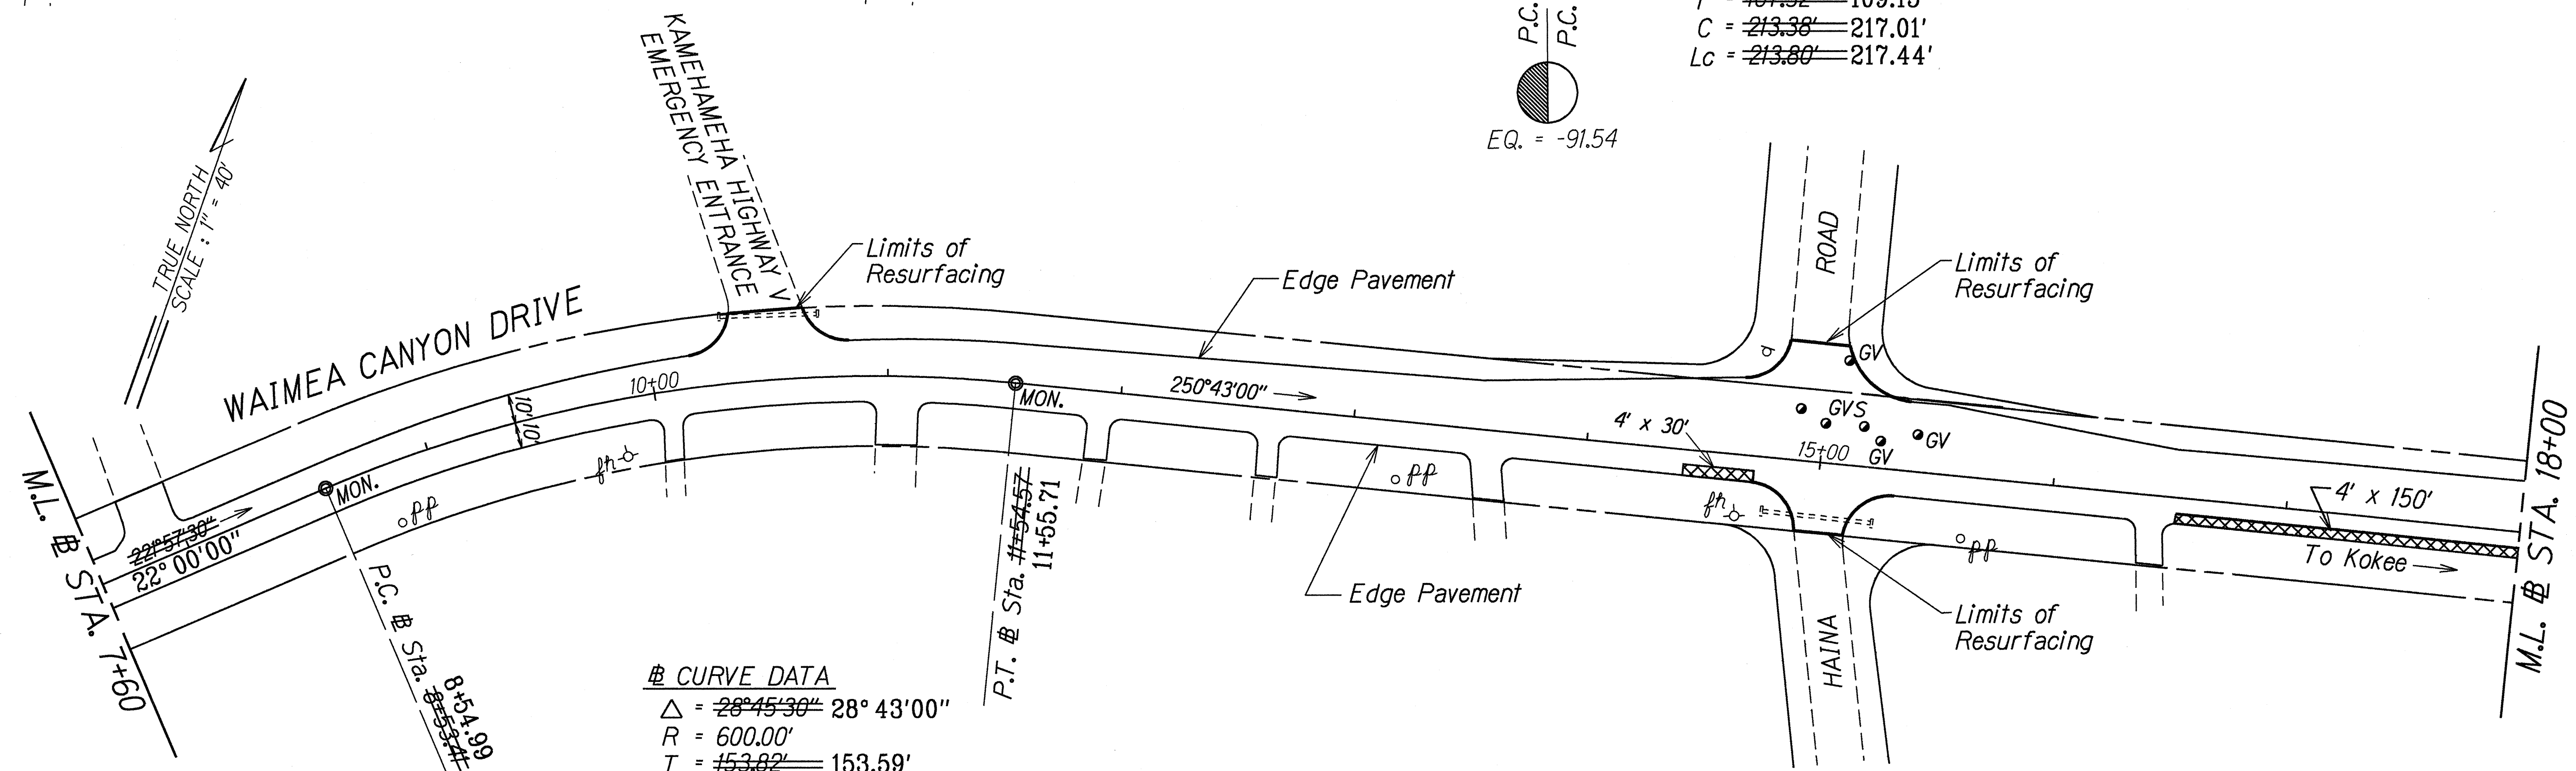


FED. ROAD DIST. NO.	STATE	PROJ. NO.	FISCAL YEAR	SHEET NO.	TOTAL SHEETS
HAWAII	HAW.	550A-01-95M	1995	8	25

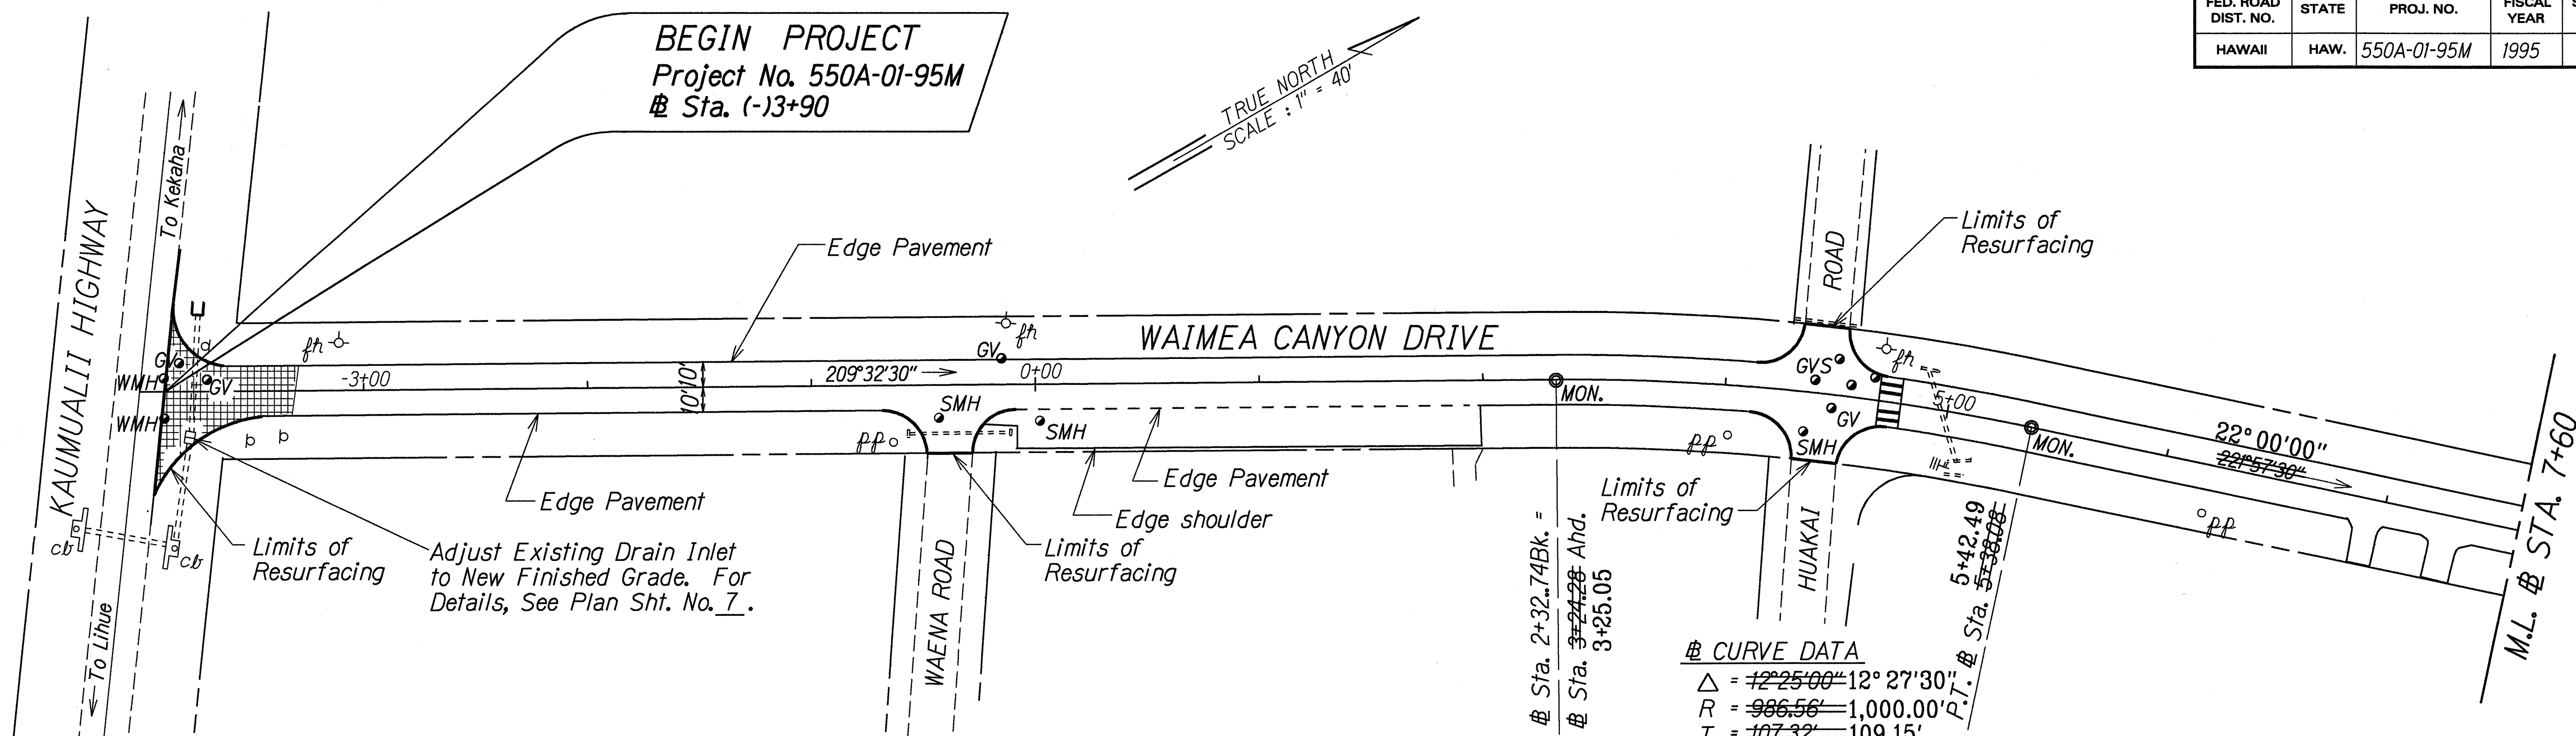

LEGEND FOR AS-BUILT POSTINGS	
	Squiggly line for as-built deletion
	Double line for as-built deletion
Roadway	Text for as-built posting

STATE OF HAWAII
DEPARTMENT OF TRANSPORTATION
HIGHWAYS DIVISION

ROADWAY PLAN

WAIMEA CANYON DRIVE RESURFACING

M.P. 0.00 TO M.P. 2.75

Project No. 550A-01-95M


Scale: 1"=40' Date: Feb., 1995

SHEET No. 1 OF 8 SHEETS

ORIGINAL PLAN	DATE
DESIGNED BY	
NOTED BY	
CHECKED BY	

"AS-BUILT"

FED. ROAD DIST. NO.	STATE	PROJ. NO.	FISCAL YEAR	SHEET NO.	TOTAL SHEETS
HAWAII	HAW.	550A-01-95M	1995	9	25

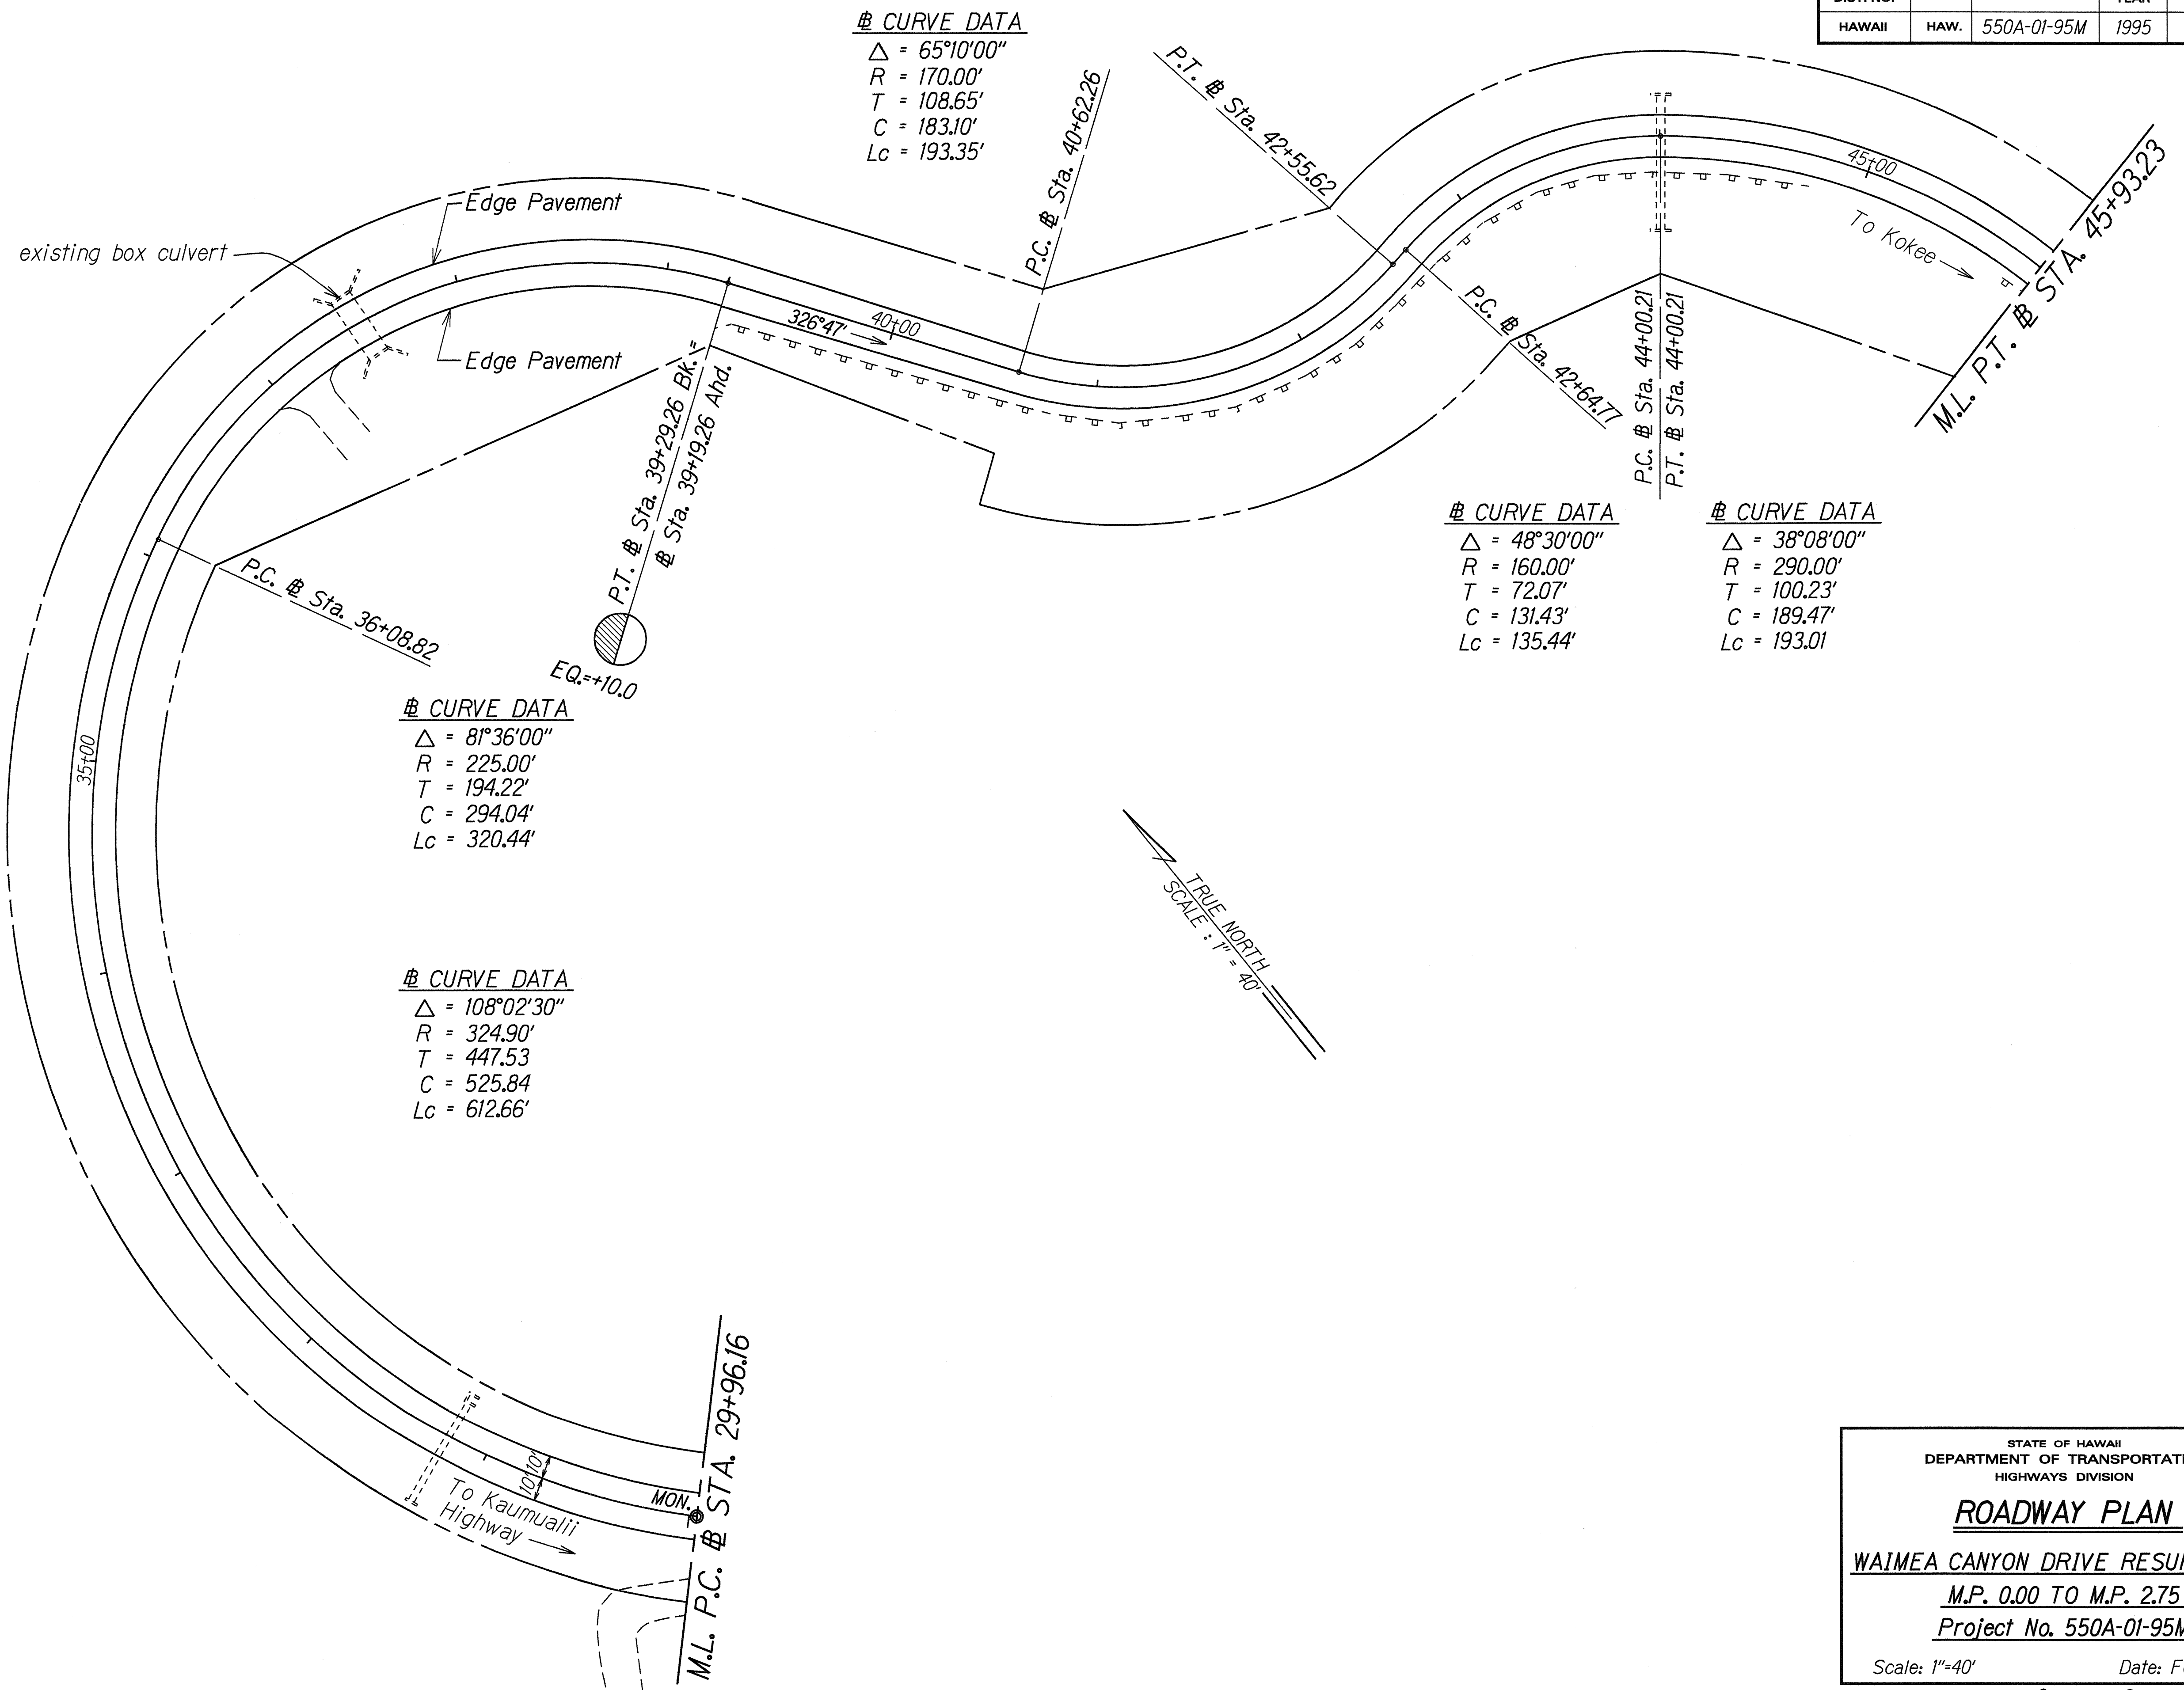

ORIGINAL PLAN	DATE
DESIGNED BY	
TRACED BY	
DESIGNED BY	
QUANTITIES BY	
CHECKED BY	


STATE OF HAWAII
DEPARTMENT OF TRANSPORTATION
HIGHWAYS DIVISION

ROADWAY PLAN
WAIMEA CANYON DRIVE RESURFACING
M.P. 0.00 TO M.P. 2.75
Project No. 550A-01-95M

Scale: 1"=40'
Date: Feb., 1995

SHEET No. 3 OF 8 SHEETS

FED. ROAD DIST. NO.	STATE	PROJ. NO.	FISCAL YEAR	SHEET NO.	TOTAL SHEETS
HAWAII	HAW.	550A-01-95M	1995	10	25

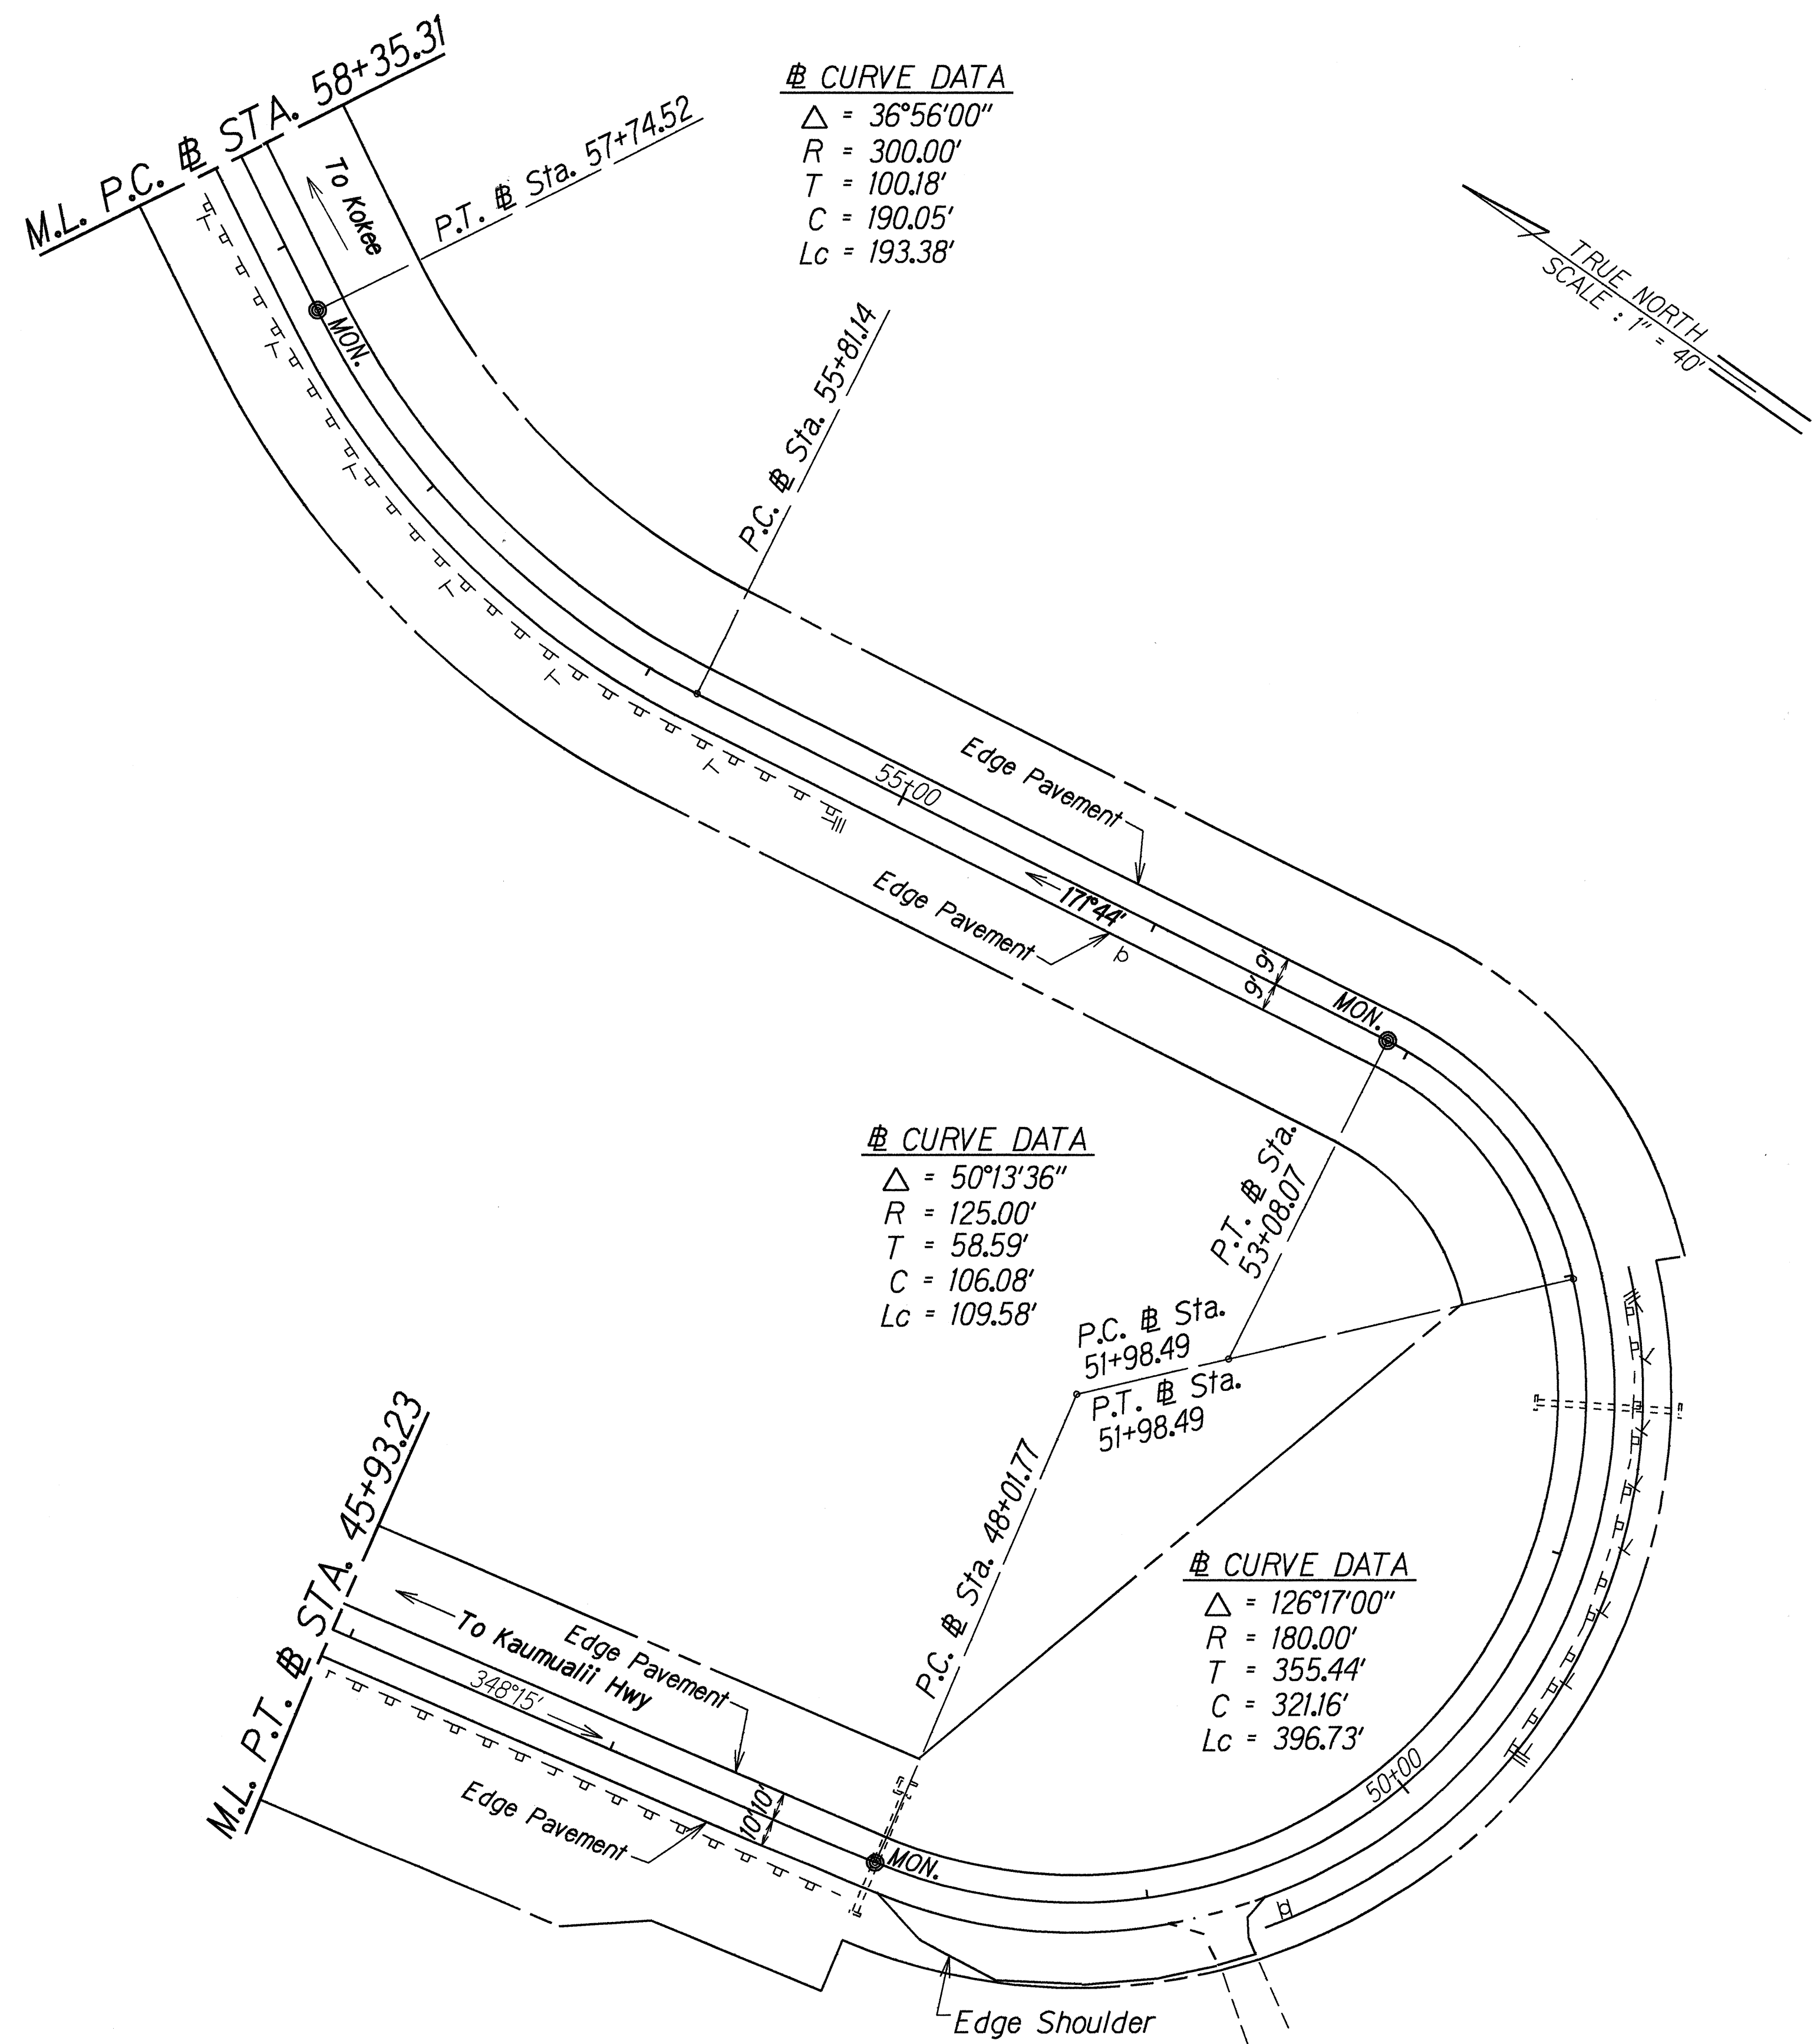

SURVEY PLOTTED BY	DATE
DRAWN BY	
DESIGNED BY	
QUANTITIES BY	
CHECKED BY	

STATE OF HAWAII
DEPARTMENT OF TRANSPORTATION
HIGHWAYS DIVISION



ROADWAY PLAN

WAIMEA CANYON DRIVE RESURFACING
M.P. 0.00 TO M.P. 2.75
Project No. 550A-01-95M

Scale: 1"=40' Date: Feb., 1995

SHEET No. 4 OF 8 SHEETS

FED. ROAD DIST. NO.	STATE	PROJ. NO.	FISCAL YEAR	SHEET NO.	TOTAL SHEETS
HAWAII	HAW.	550A-01-95M	1995	11	25

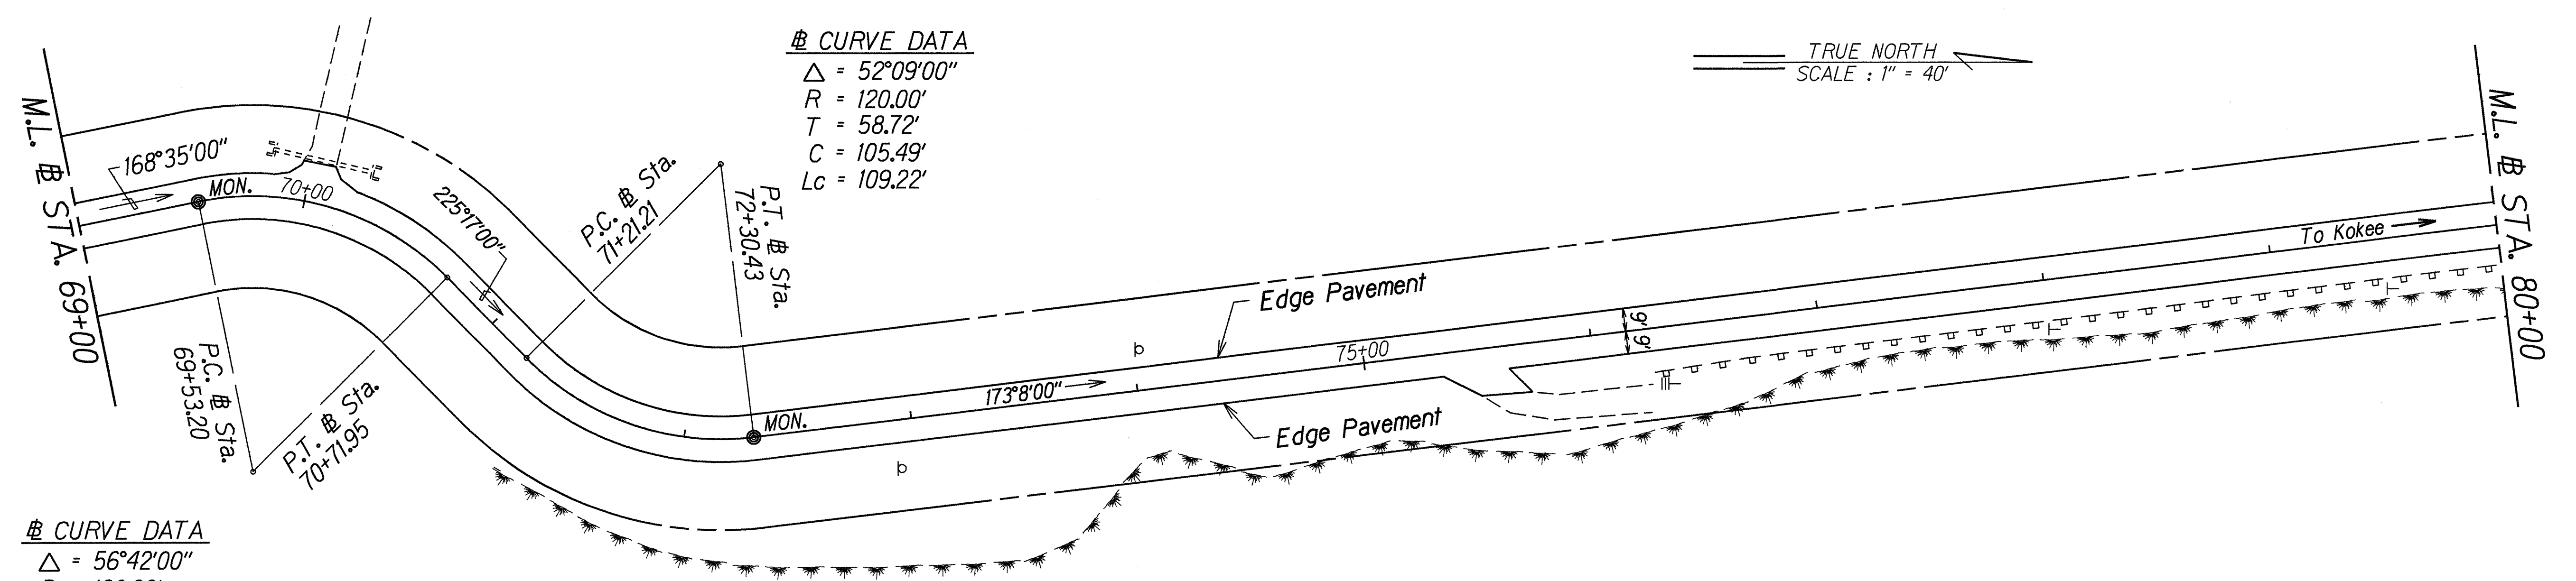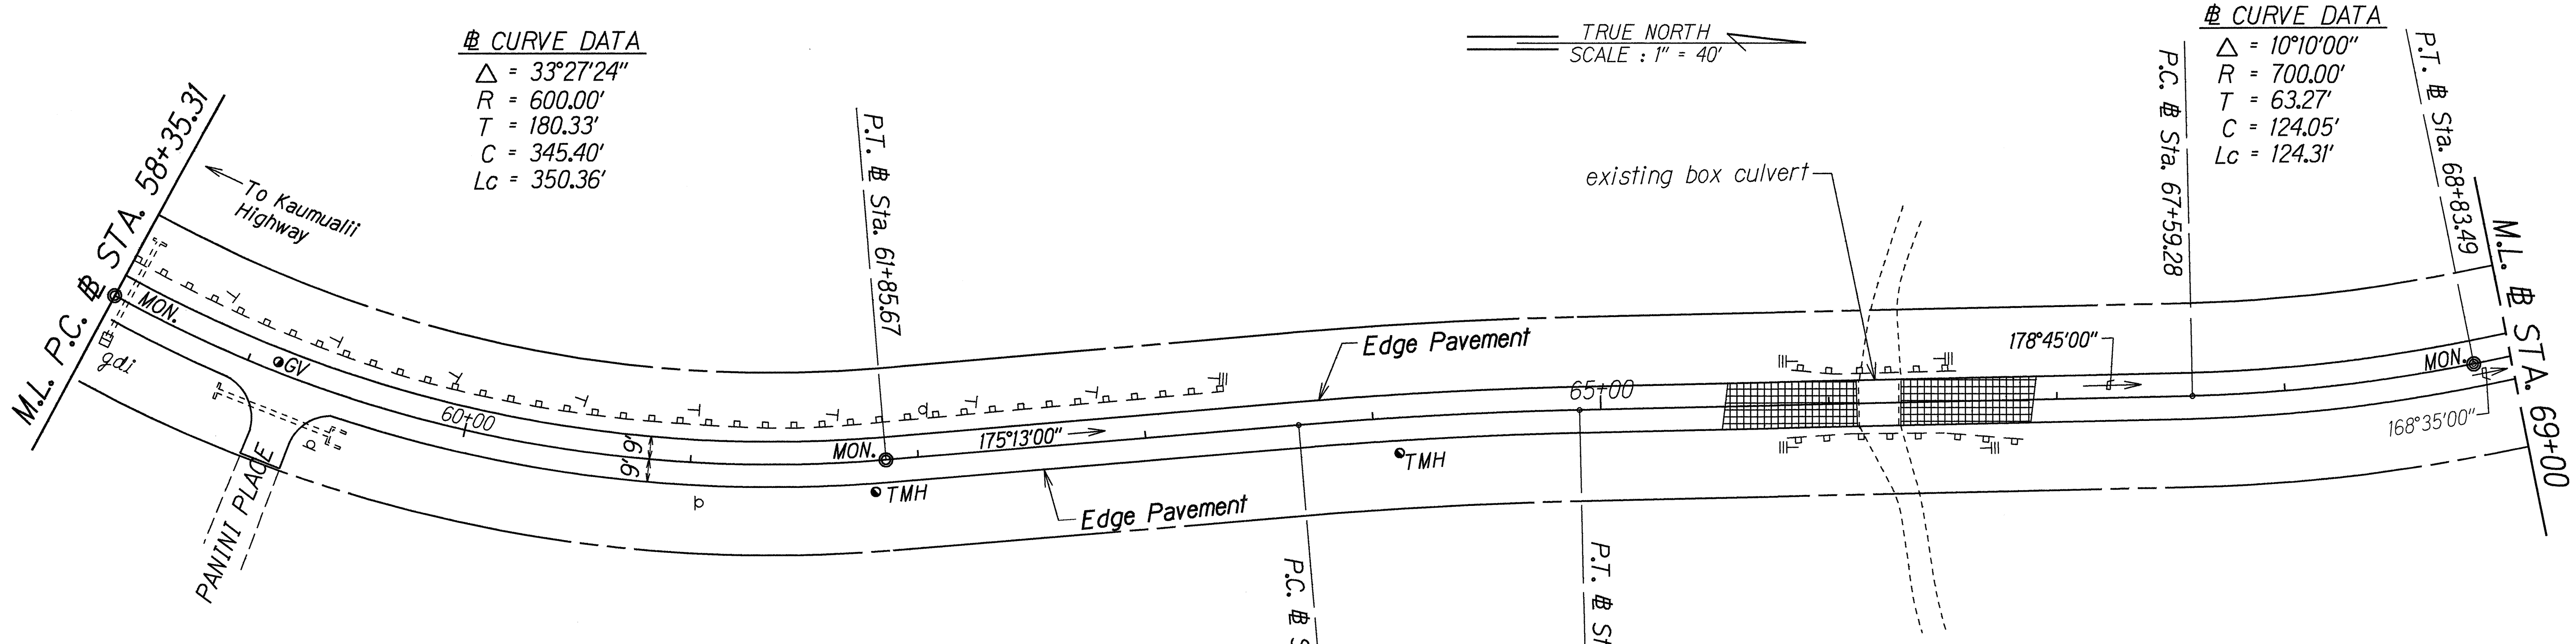

DATE	_____
SURVEY PLOTTED BY	_____
DRAWN BY	_____
DESIGNED BY	_____
QUANTITIES BY	_____
CHECKED BY	_____
ORIGINAL PLAN	_____
NOTE BOOK	_____
TELEPHONE	_____
ADDRESS	_____

STATE OF HAWAII
DEPARTMENT OF TRANSPORTATION
HIGHWAYS DIVISION

ROADWAY PLAN

STA. 68+83.49 TO # STA. 80+00

WAIMEA CANYON DRIVE RESURFACING

M.P. 0.00 TO M.P. 2.75


Project No. 550-01-95M

Scale: 1"=40' Date: Feb., 1995

SHEET No. 5 OF 8 SHEETS

FED. ROAD DIST. NO.	STATE	PROJ. NO.	FISCAL YEAR	SHEET NO.	TOTAL SHEETS
HAWAII	HAW.	550A-01-90M	1995	12	25

CURVE DATA
 $\Delta = 00^{\circ}00'00''$
 $R = 0,000$
 $T = 0,000$
 $C = 0,000$
 $Lc = 0,000$

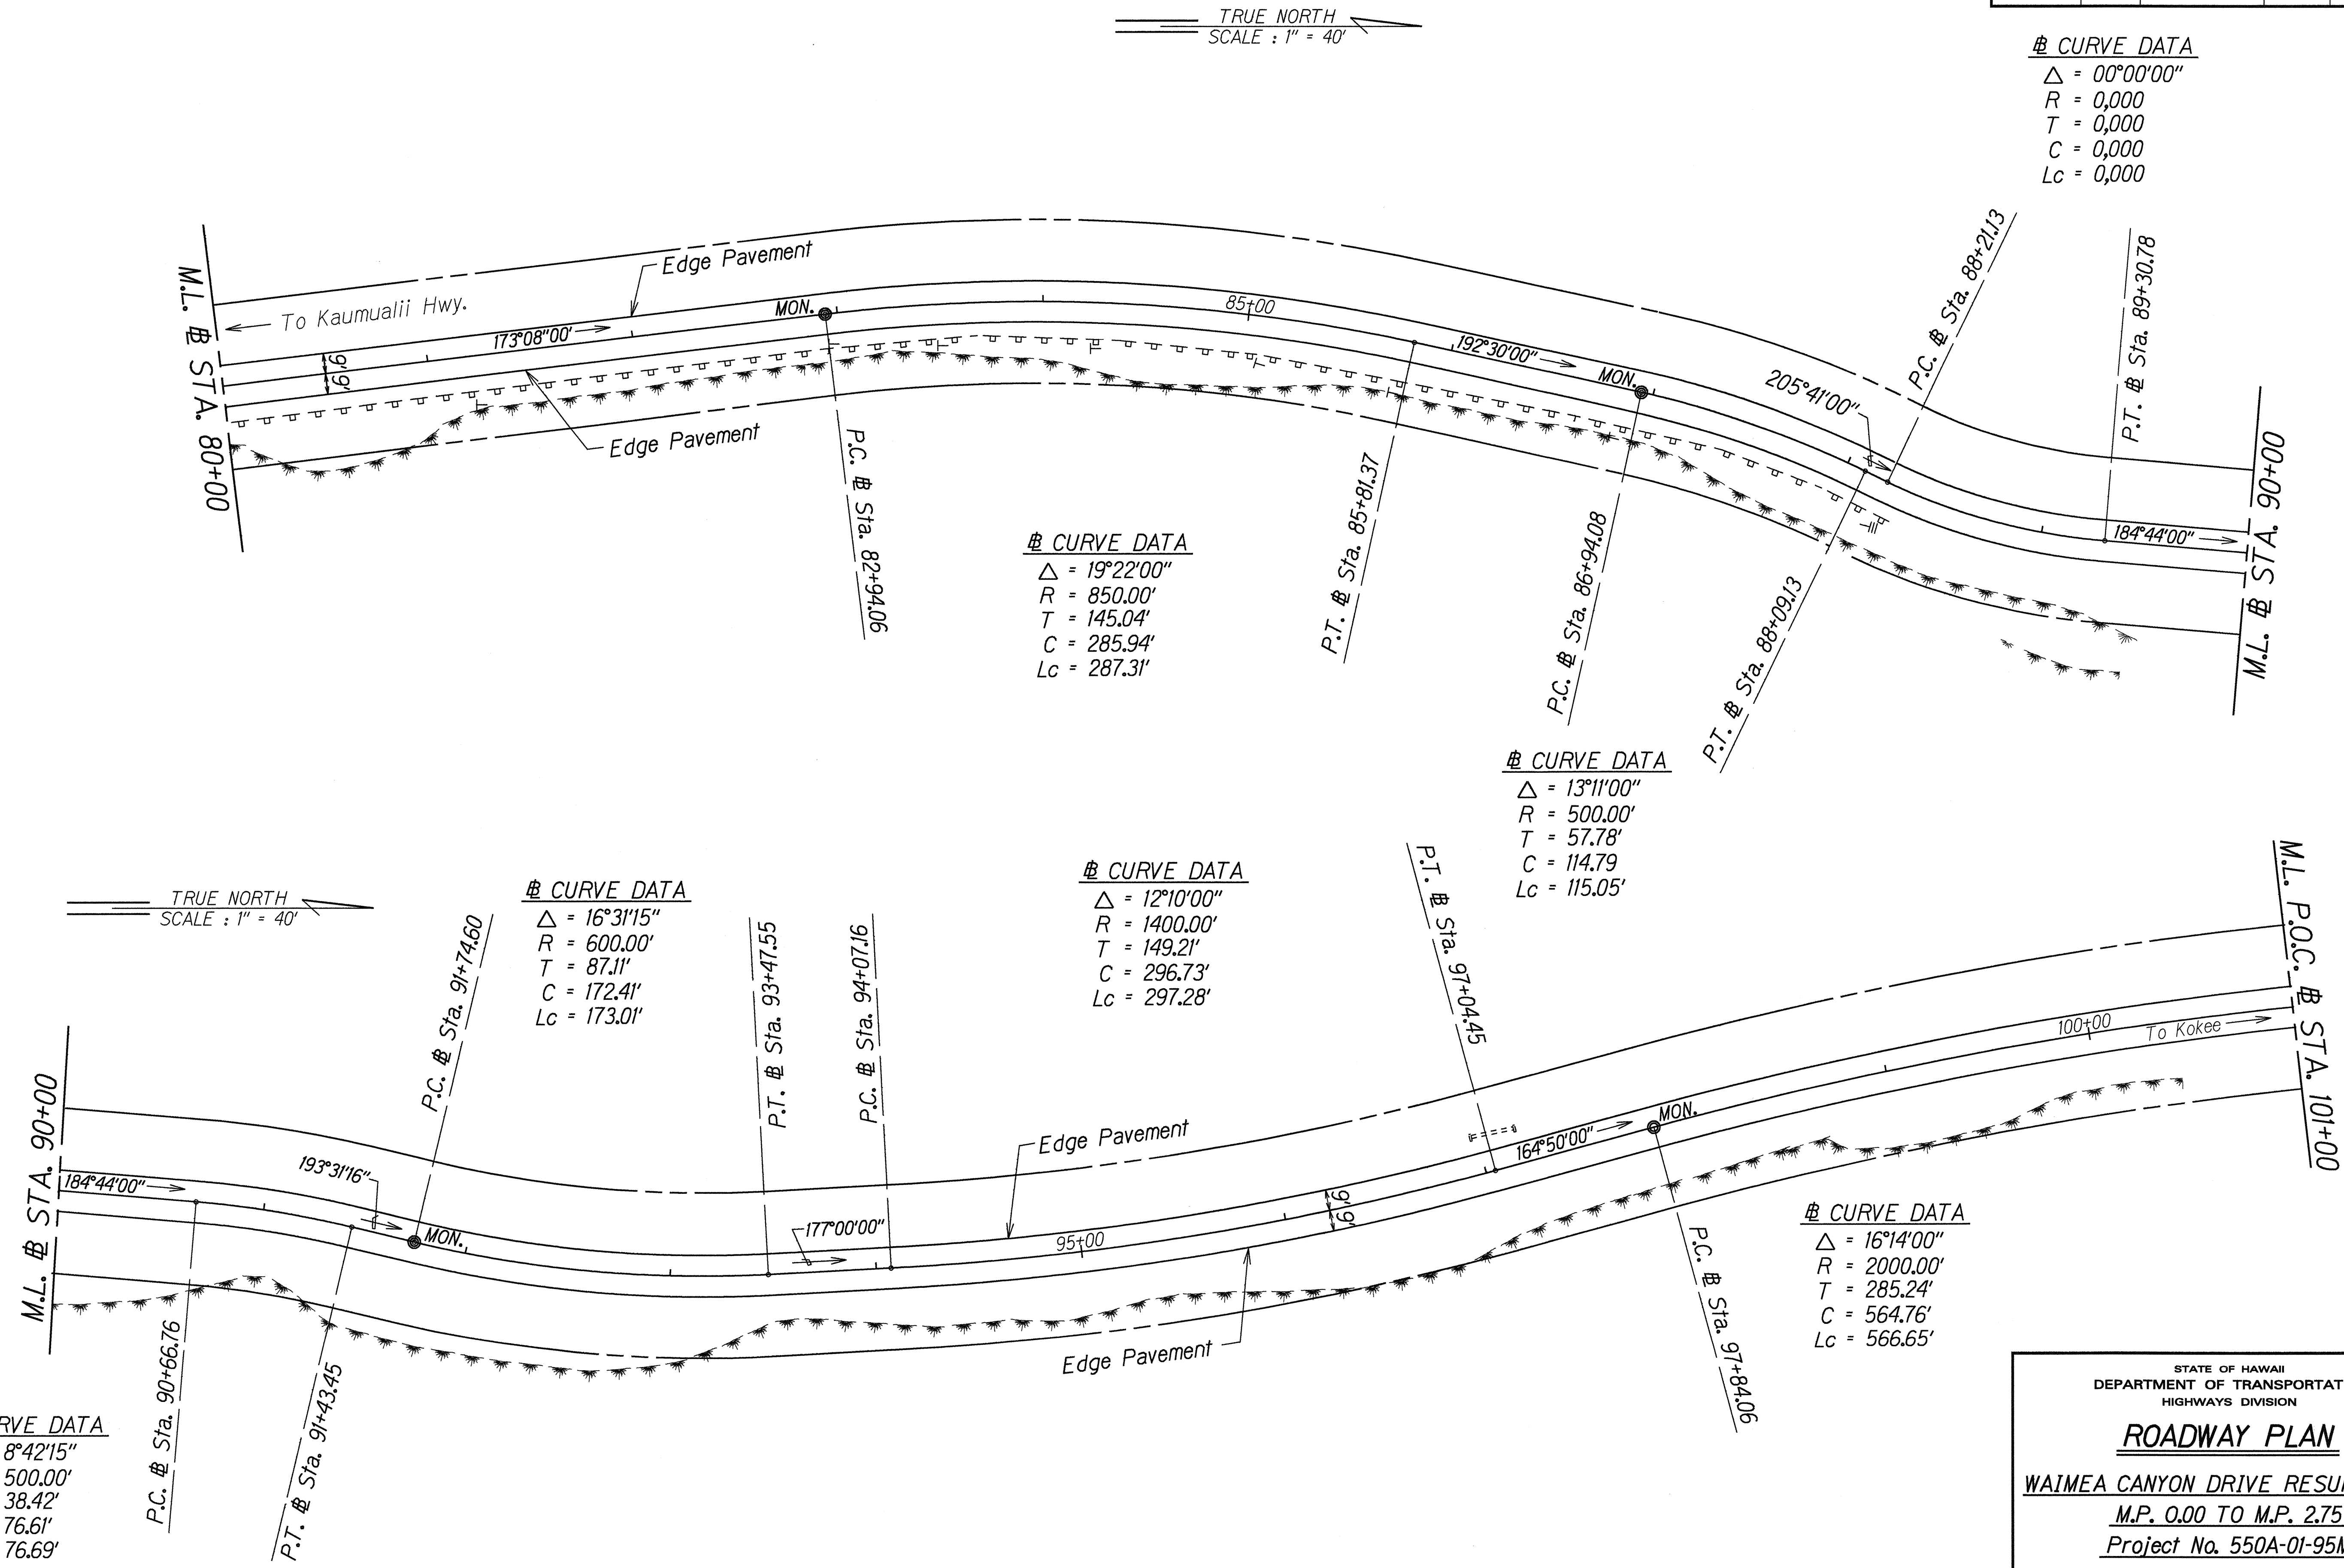

ORIGINAL PLAN	SURVEY PLOTTED BY	DATE
NOTED BOOK	DRAWN BY	
DESIGNED BY	CHECKED BY	
QUANTITIES BY		
INCHES		

STATE OF HAWAII
DEPARTMENT OF TRANSPORTATION
HIGHWAYS DIVISION

ROADWAY PLAN

WAIMEA CANYON DRIVE RESURFACING


M.P. 0.00 TO M.P. 2.75

Project No. 550A-01-95M

Scale: 1"=40' Date: Feb., 1995

SHEET No. 6 OF 8 SHEETS

FED. ROAD DIST. NO.	STATE	PROJ. NO.	FISCAL YEAR	SHEET NO.	TOTAL SHEETS
HAWAII	HAW.	550A-01-95M	1995	13	25

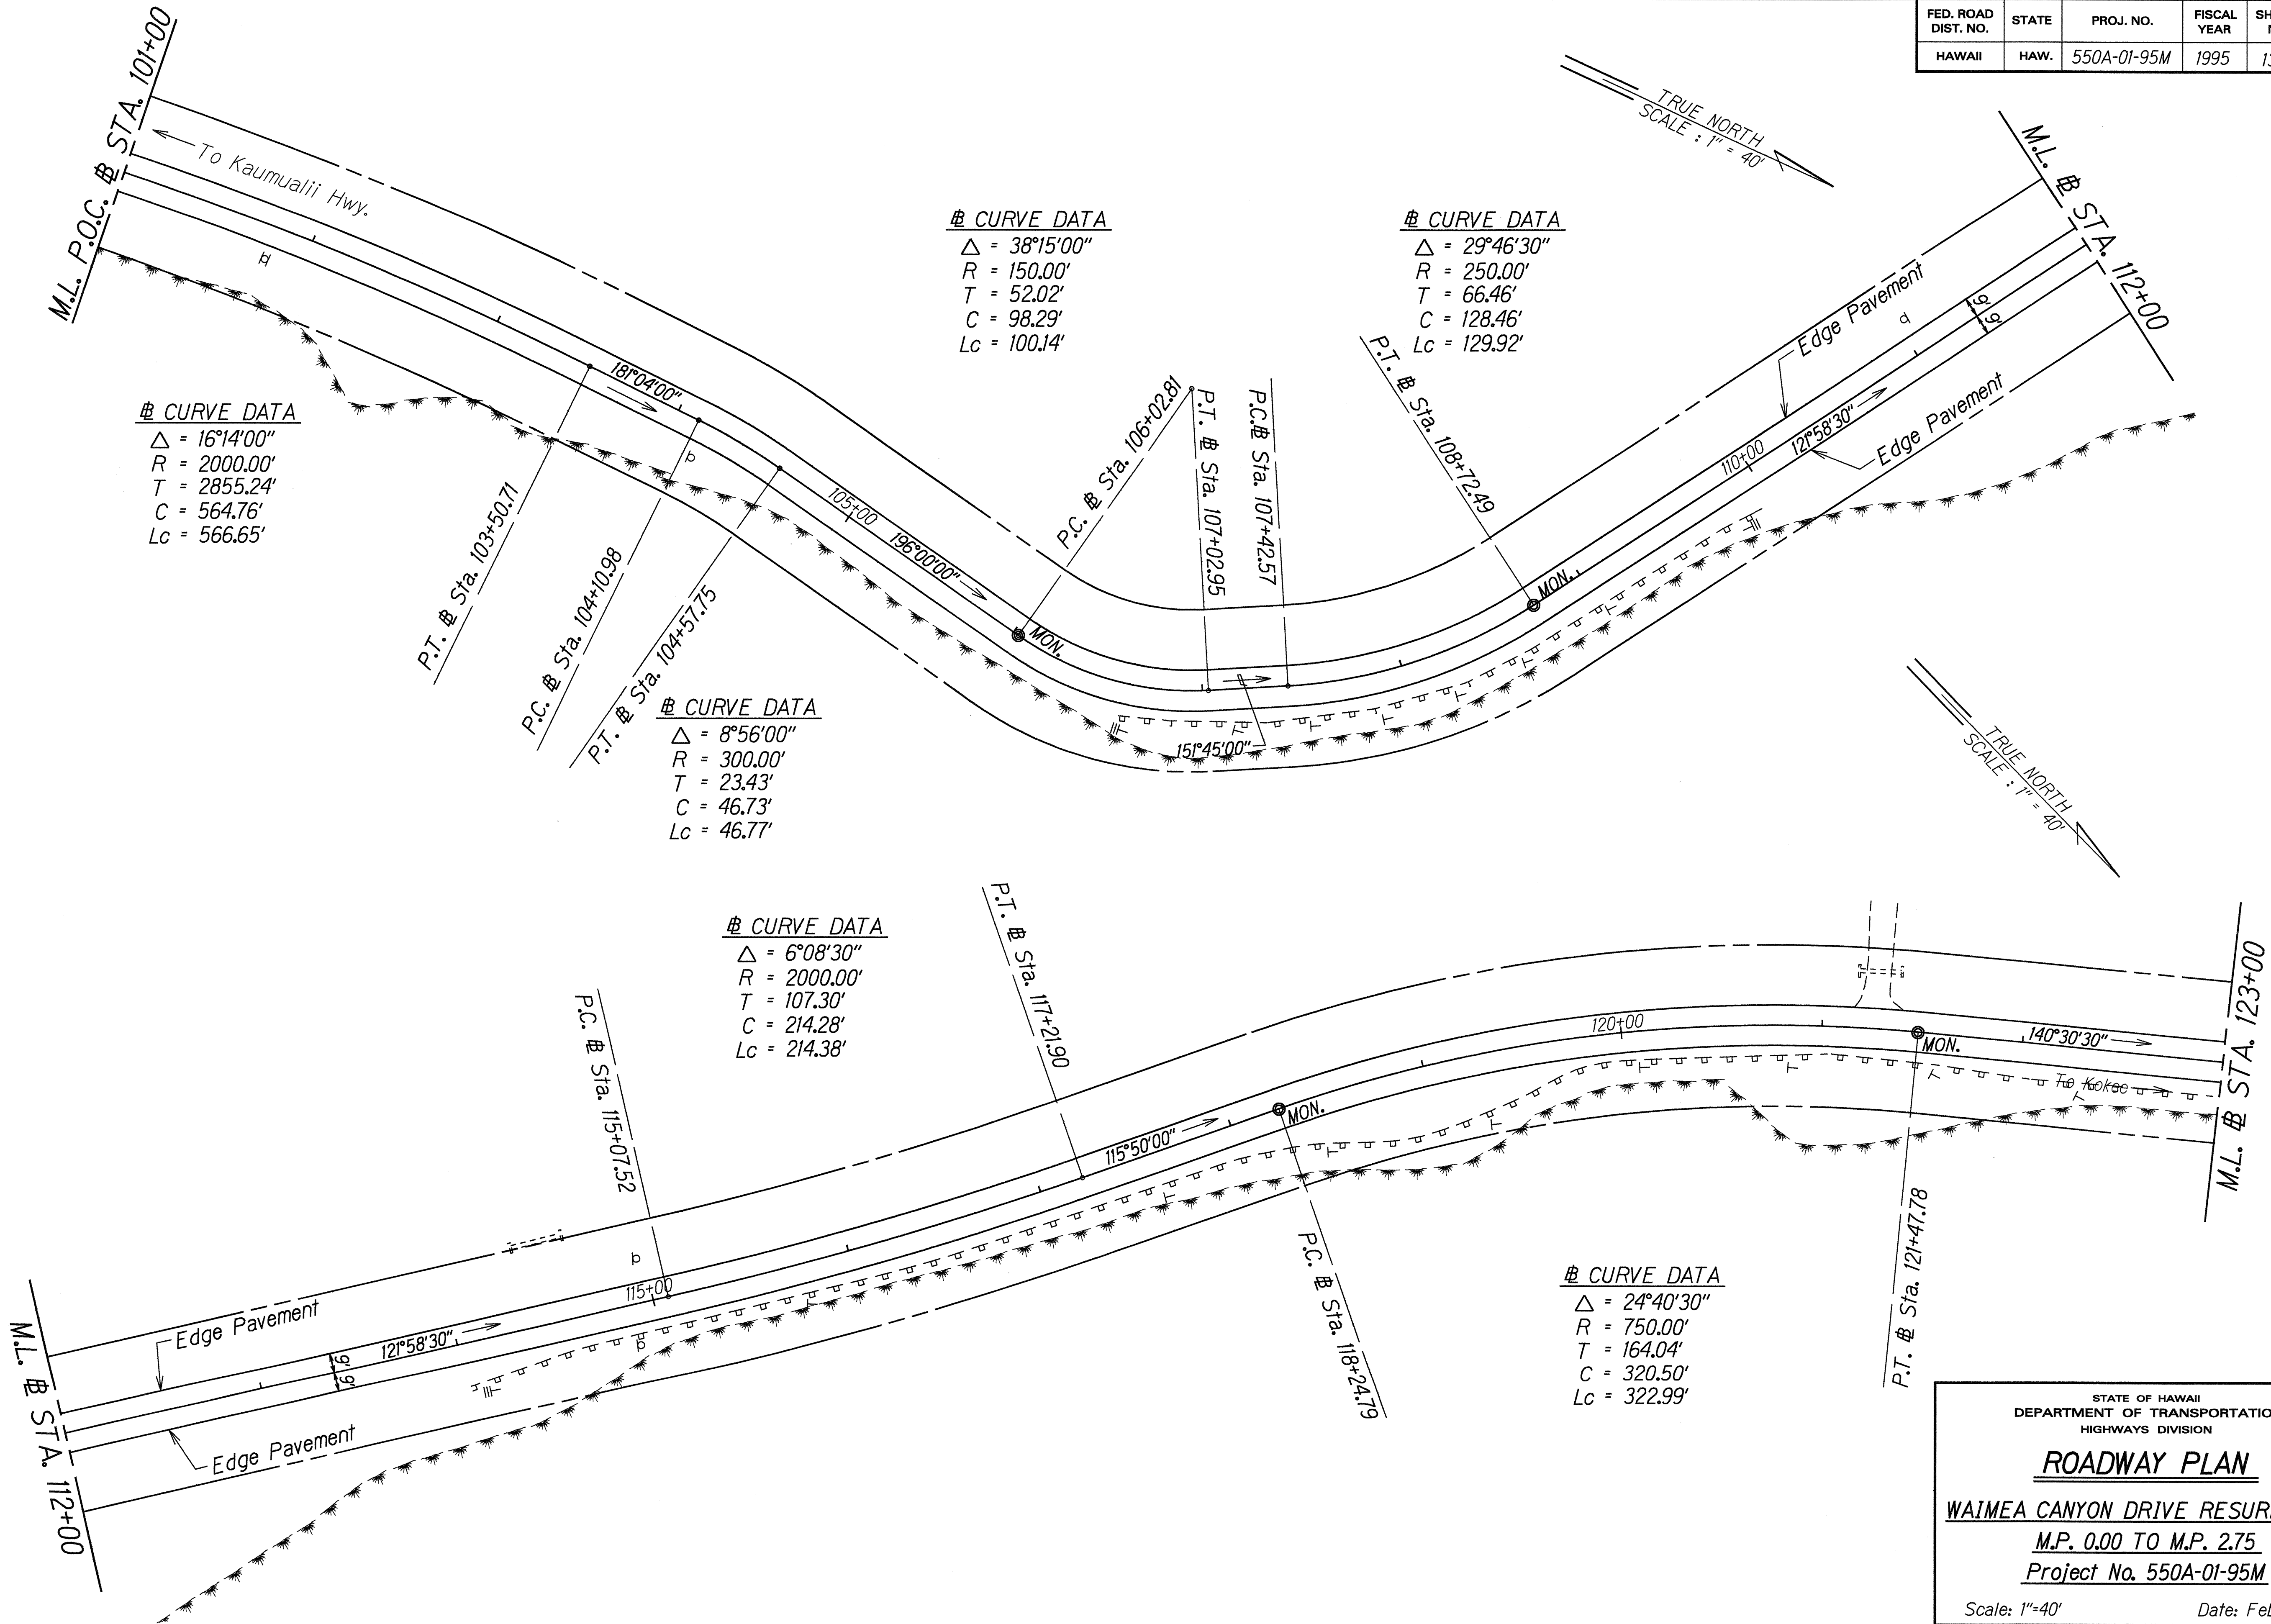

DATE	_____
SURVEY PLOTTED BY	_____
DRAWN BY	_____
DESIGNED BY	_____
QUANTITIES BY	_____
CHECKED BY	_____
ORIGINAL PLAN	_____
NOTE BOOK	_____
REVISION	_____
INVESTIGATION	_____

STATE OF HAWAII
DEPARTMENT OF TRANSPORTATION
HIGHWAYS DIVISION

ROADWAY PLAN

WAIMEA CANYON DRIVE RESURFACING

M.P. 0.00 TO M.P. 2.75

Project No. 550A-01-95M

Scale: 1"=40'

Date: Feb, 1995

SHEET No. 7 OF 8 SHEETS

