	INDEX TO DRAWINGS
SHEET NO.	DESCRIPTION
1	TITLE SHEET
2	STANDARD PLANS SUMMARY
3	GENERAL NOTES
4 – 6	TYPICAL SECTIONS
7 – 14	ROADWAY PLANS
15	PAVEMENT MARKINGS LEGEND
	DETAILS AND NOTES
16 – 23	PAVEMENT MARKINGS, STRIPING
	AND TRAFFIC SIGNS
24	TRAFFIC SUMMARIES
25	PAVEMENT MARKING SUMMARY

STATE OF HAWAII


DEPARTMENT OF TRANSPORTATION

HIGHWAYS DIVISION
HONOLULU, HAWAII
"AS-BUILT"
PLANS FOR

WAIMEA CANYON DRIVE RESURFACING M.P. 0.00 TO M.P. 2.75

PROJECT NO. 550A-01-95M


DISTRICT OF WAIMEA ISLAND OF KAUAI

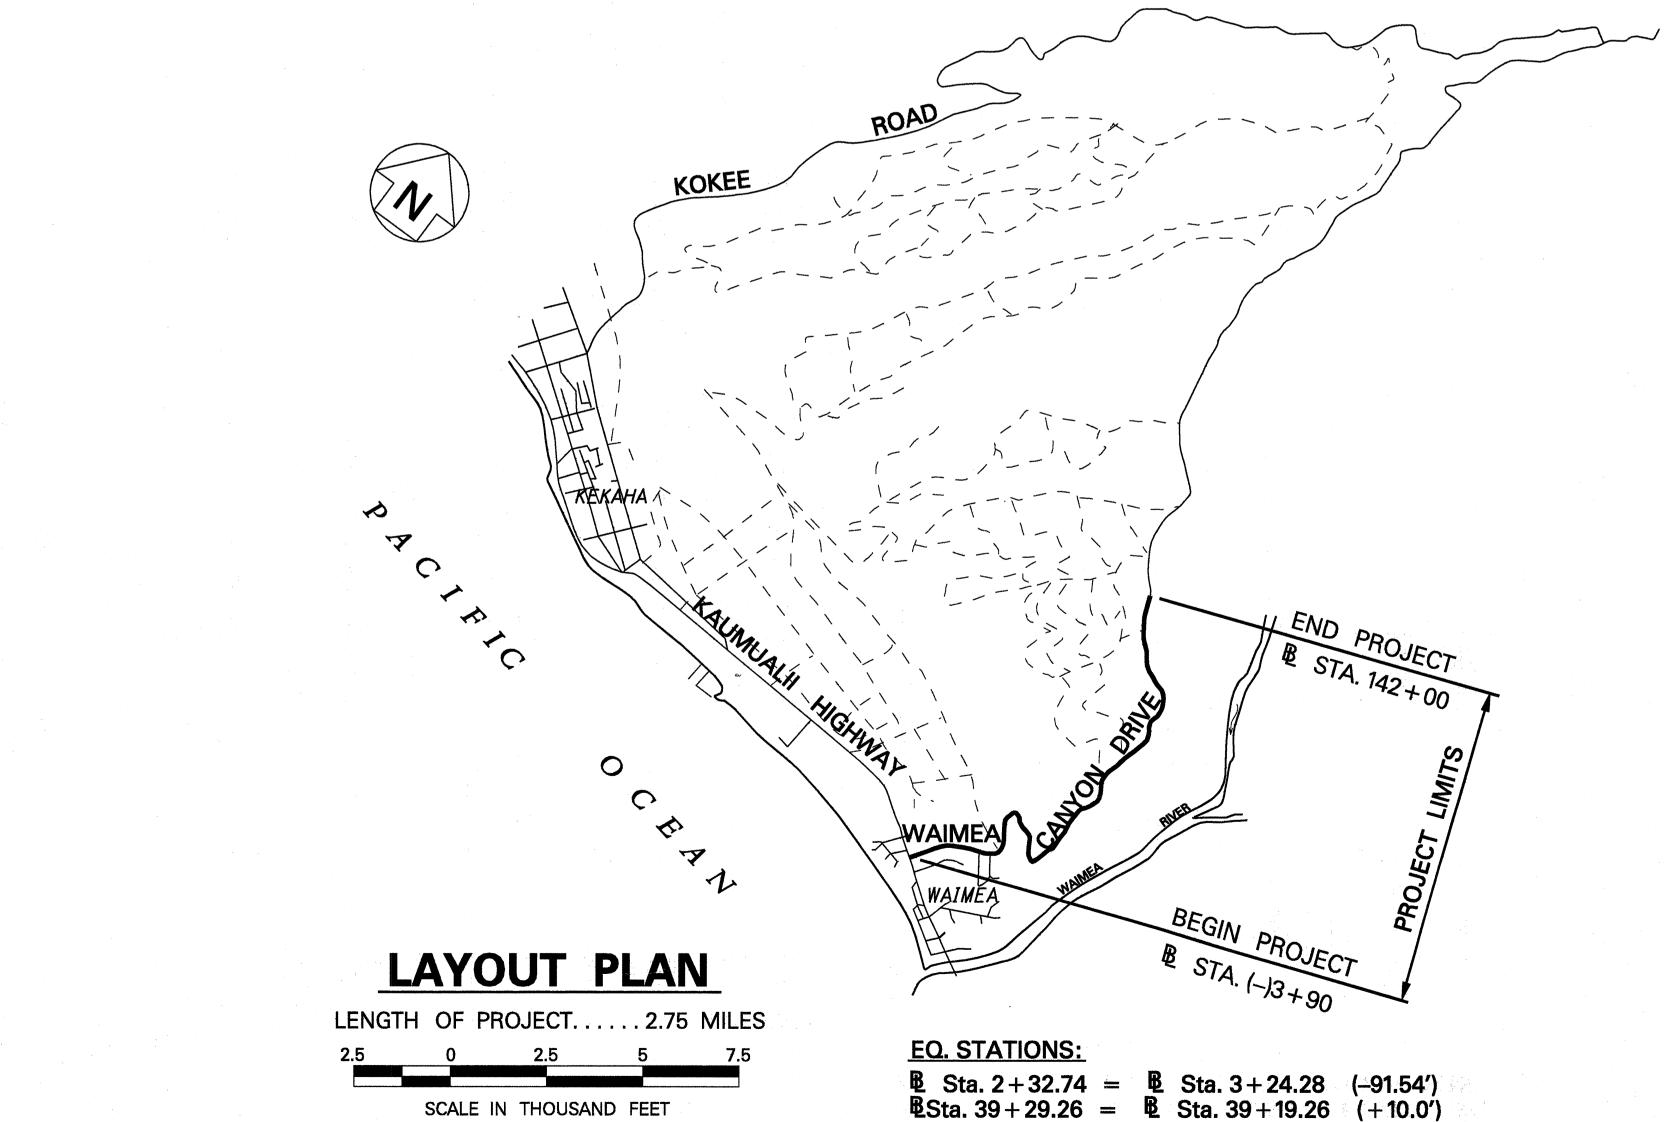


FED. ROAD DIST. NO. STATE PROJ. NO. FISCAL SHEET NO. SHEETS

HAWAII HAW. 550A-01-95M 1995 1 25



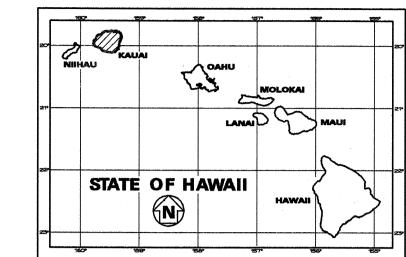

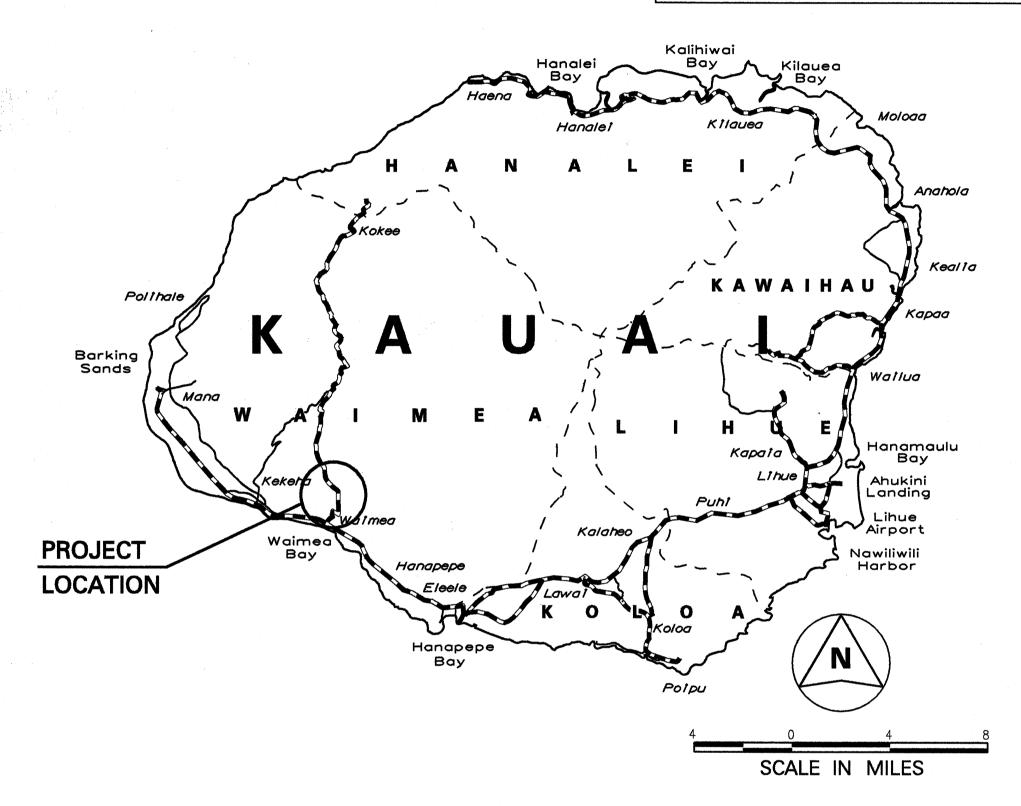

FEDERAL AID PROJECTS PREVIOUSLY CONSTRUCTED OR UNDER CONSTRUCTION

CHANGES MADE DURING CONSTRUCTION HAVE BEEN INCORPORATED ON THESE PLANS EXCEPT CHANGES IN THE ORIGINAL THEORETICAL QUANTITIES, FOR ACTUAL QUANTITIES, REFER TO PROJECT LEDGER AND/OR COMPUTATION BOOK.

RESIDENT ENGINEER

8/27/97 DATE

DEPARTMENT OF TRANSPORTATION STATE OF HAWAII

APPROVED:

Lay byachil 5/18/95

DIR. OF TRANSPORTATION DATE