
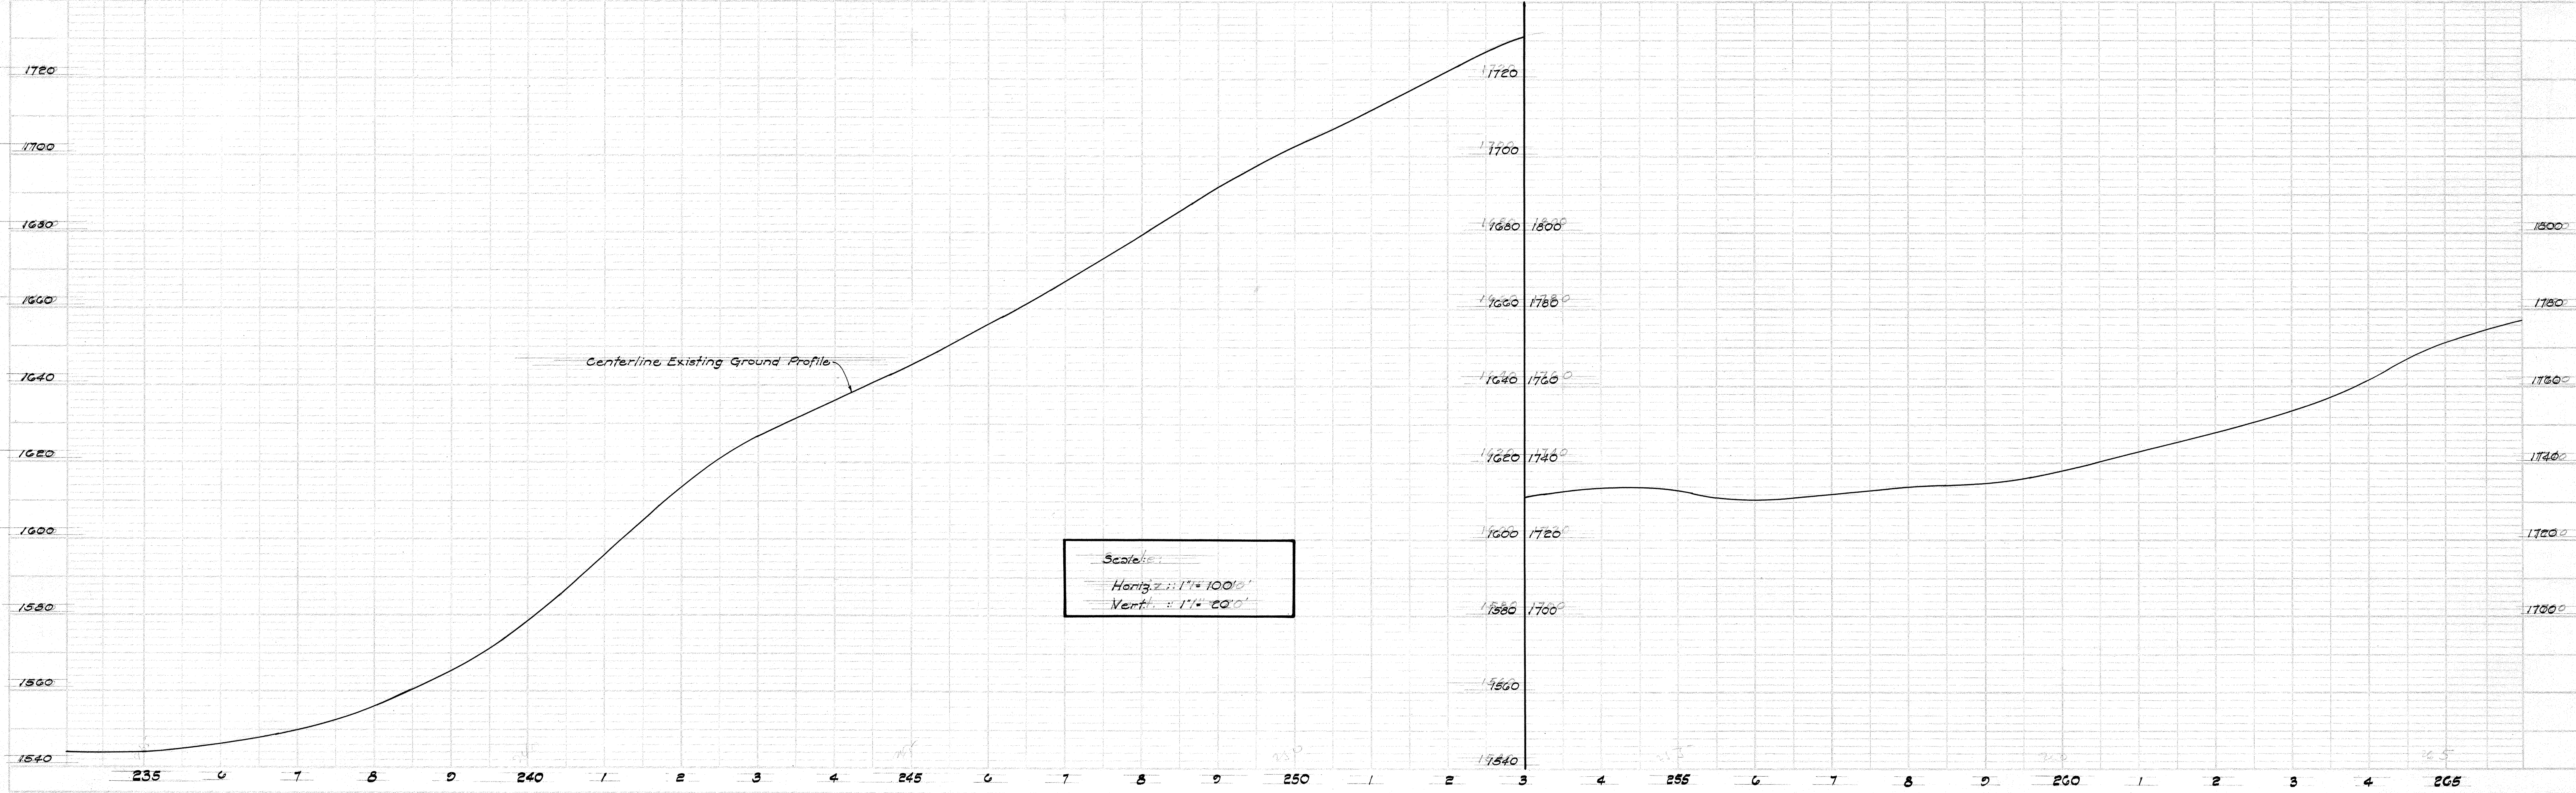




PLAN	DATE	BY	CHKD
SURVEYED			
PLATTED			
NOTE BOOK			
NO.			

PROFILE	DATE	BY	CHKD
SURVEYED			
PLATTED			
NOTE BOOK			
NO.			

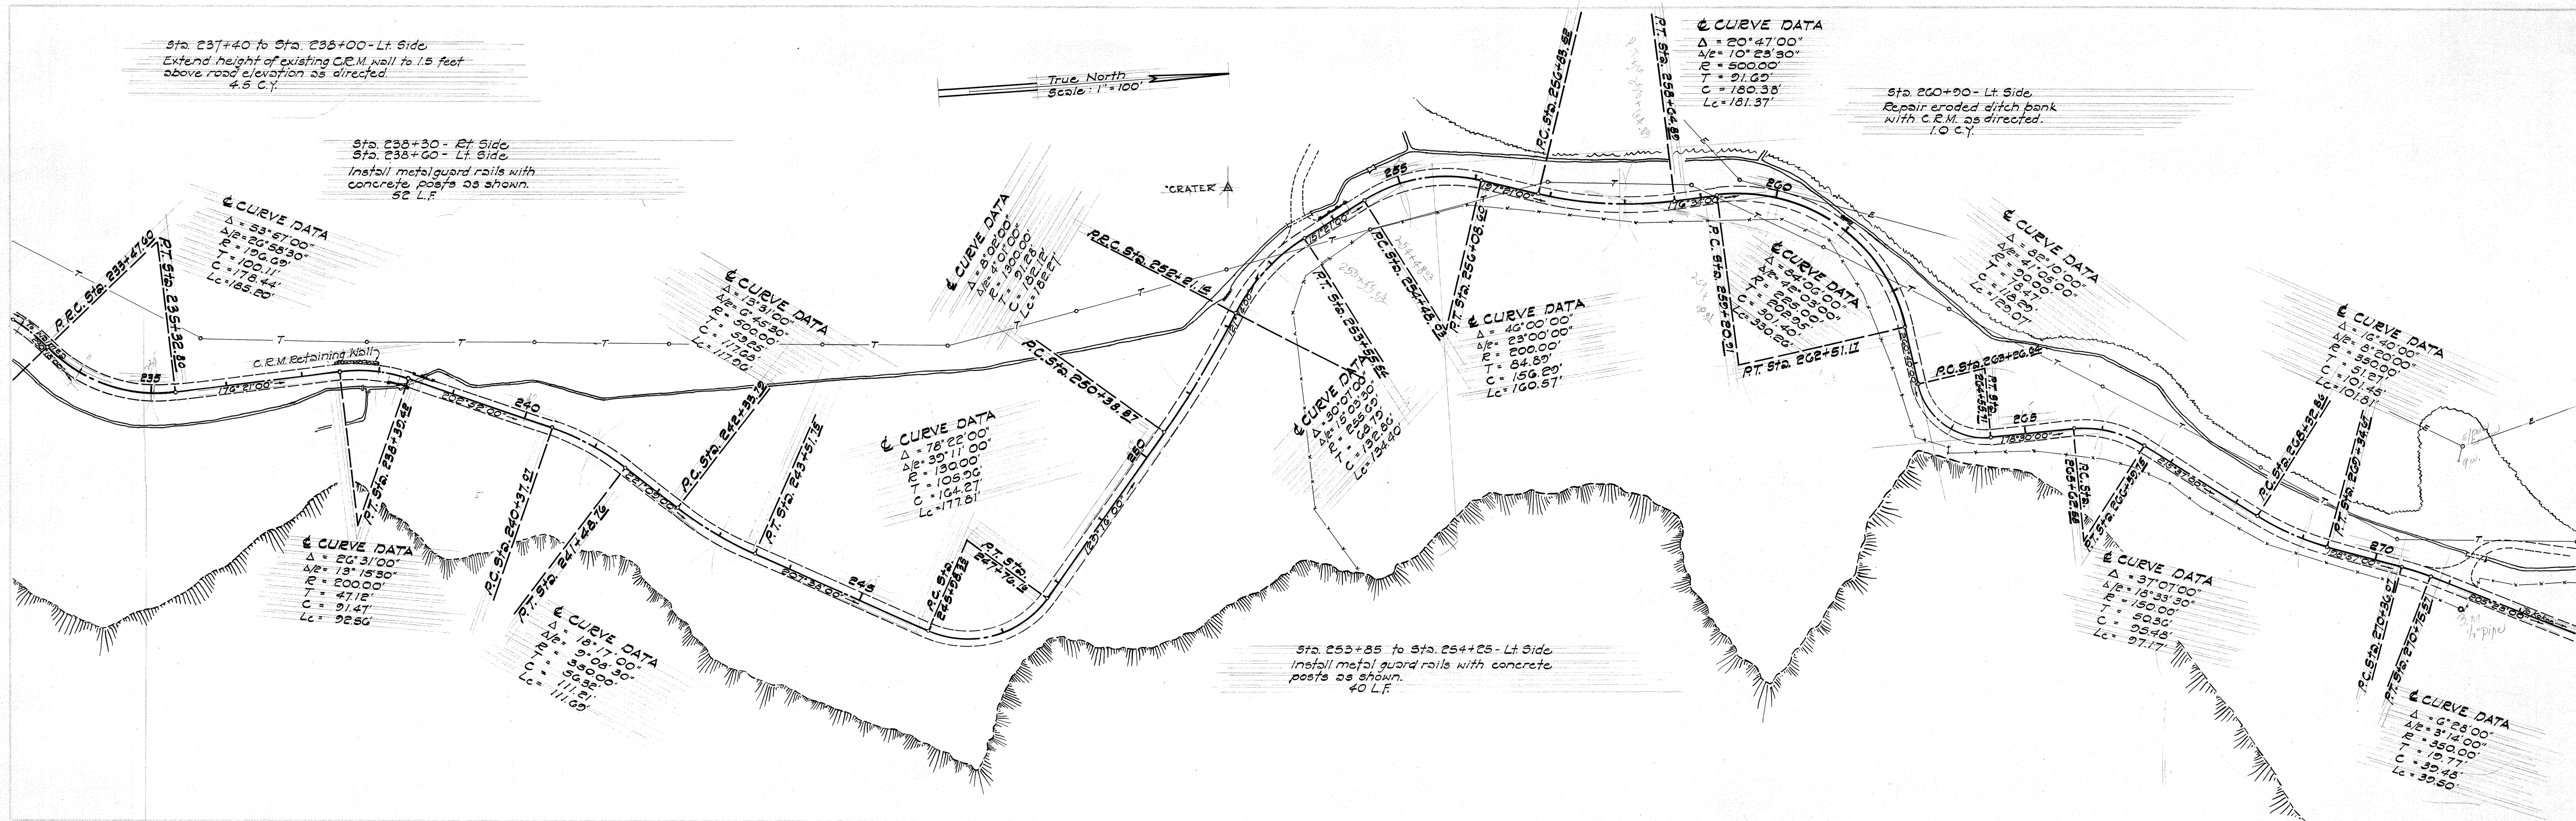



PLAN
SURVEYED
PLOTTED
NOTE BOOK
DATE
BY
CHECKED
DATE
BY

PROFILE
SURVEYED
PLOTTED
NOTE BOOK
DATE
BY
CHECKED
DATE
BY

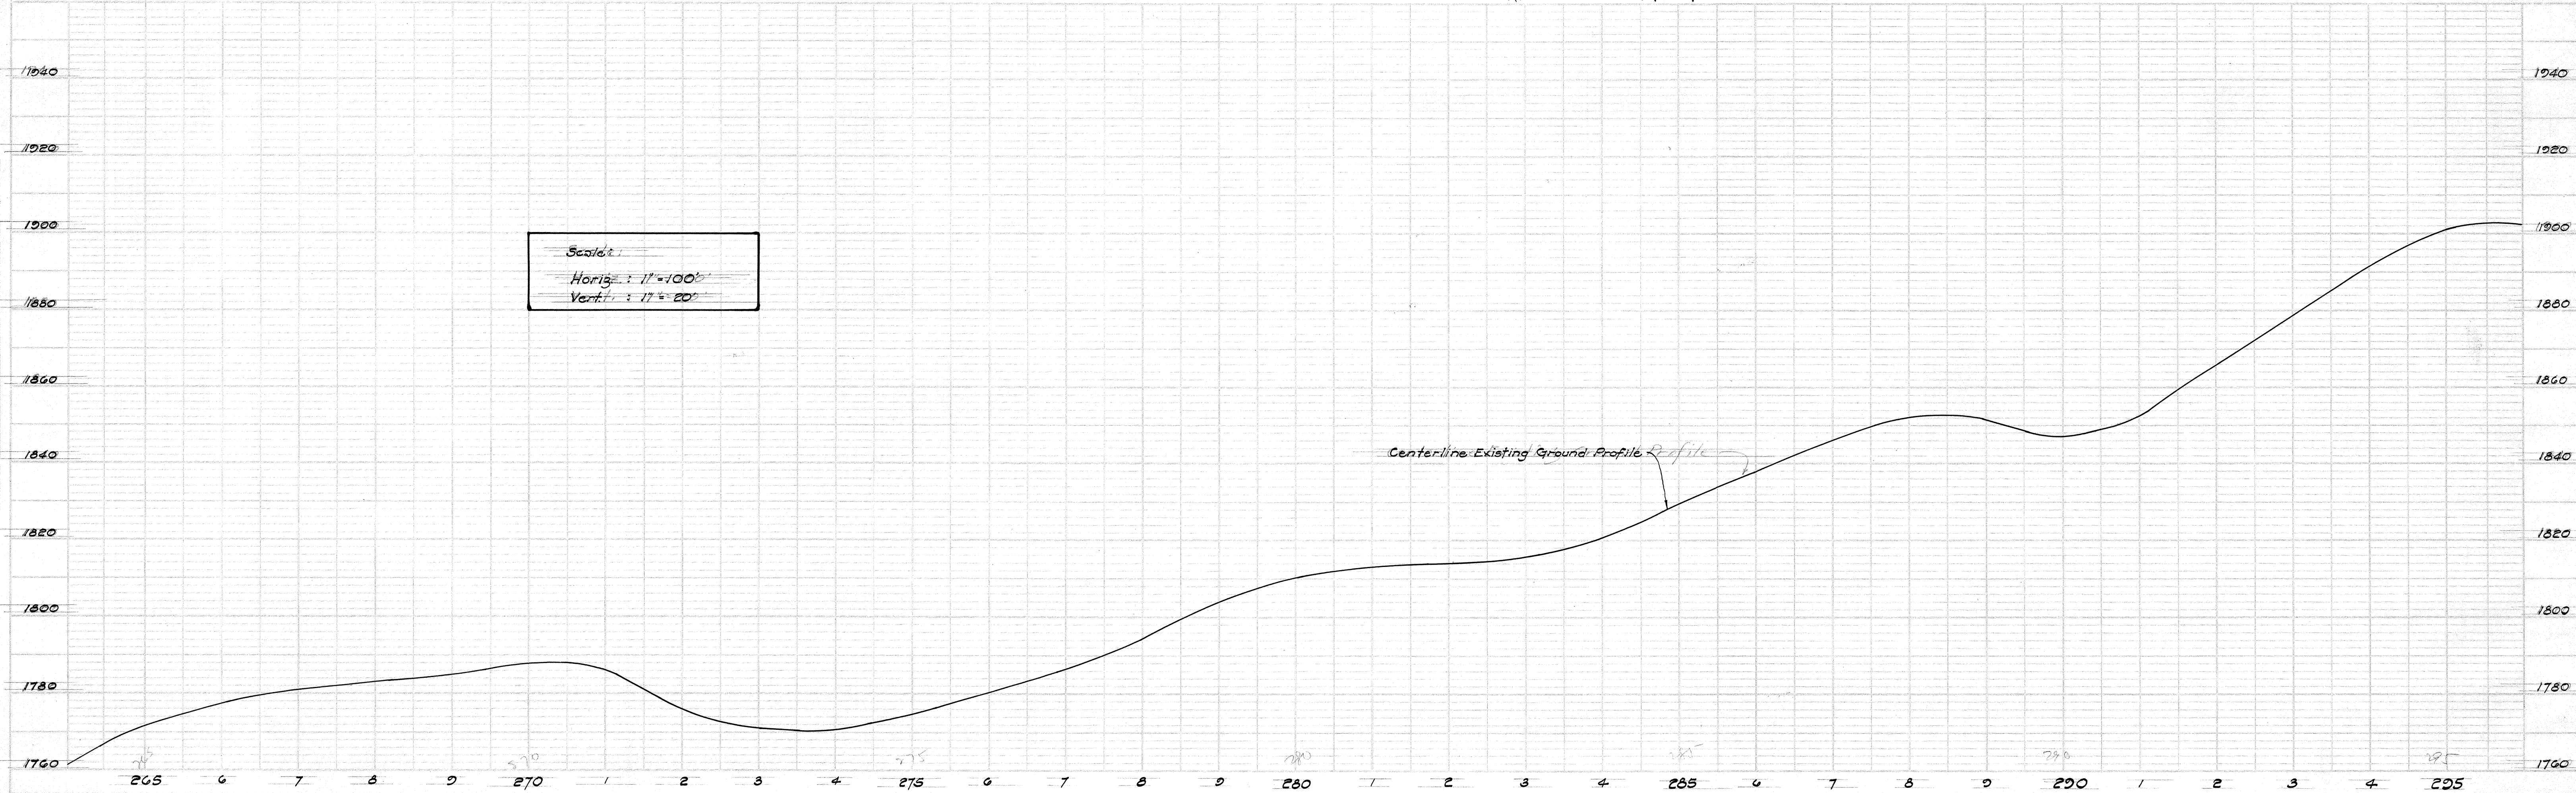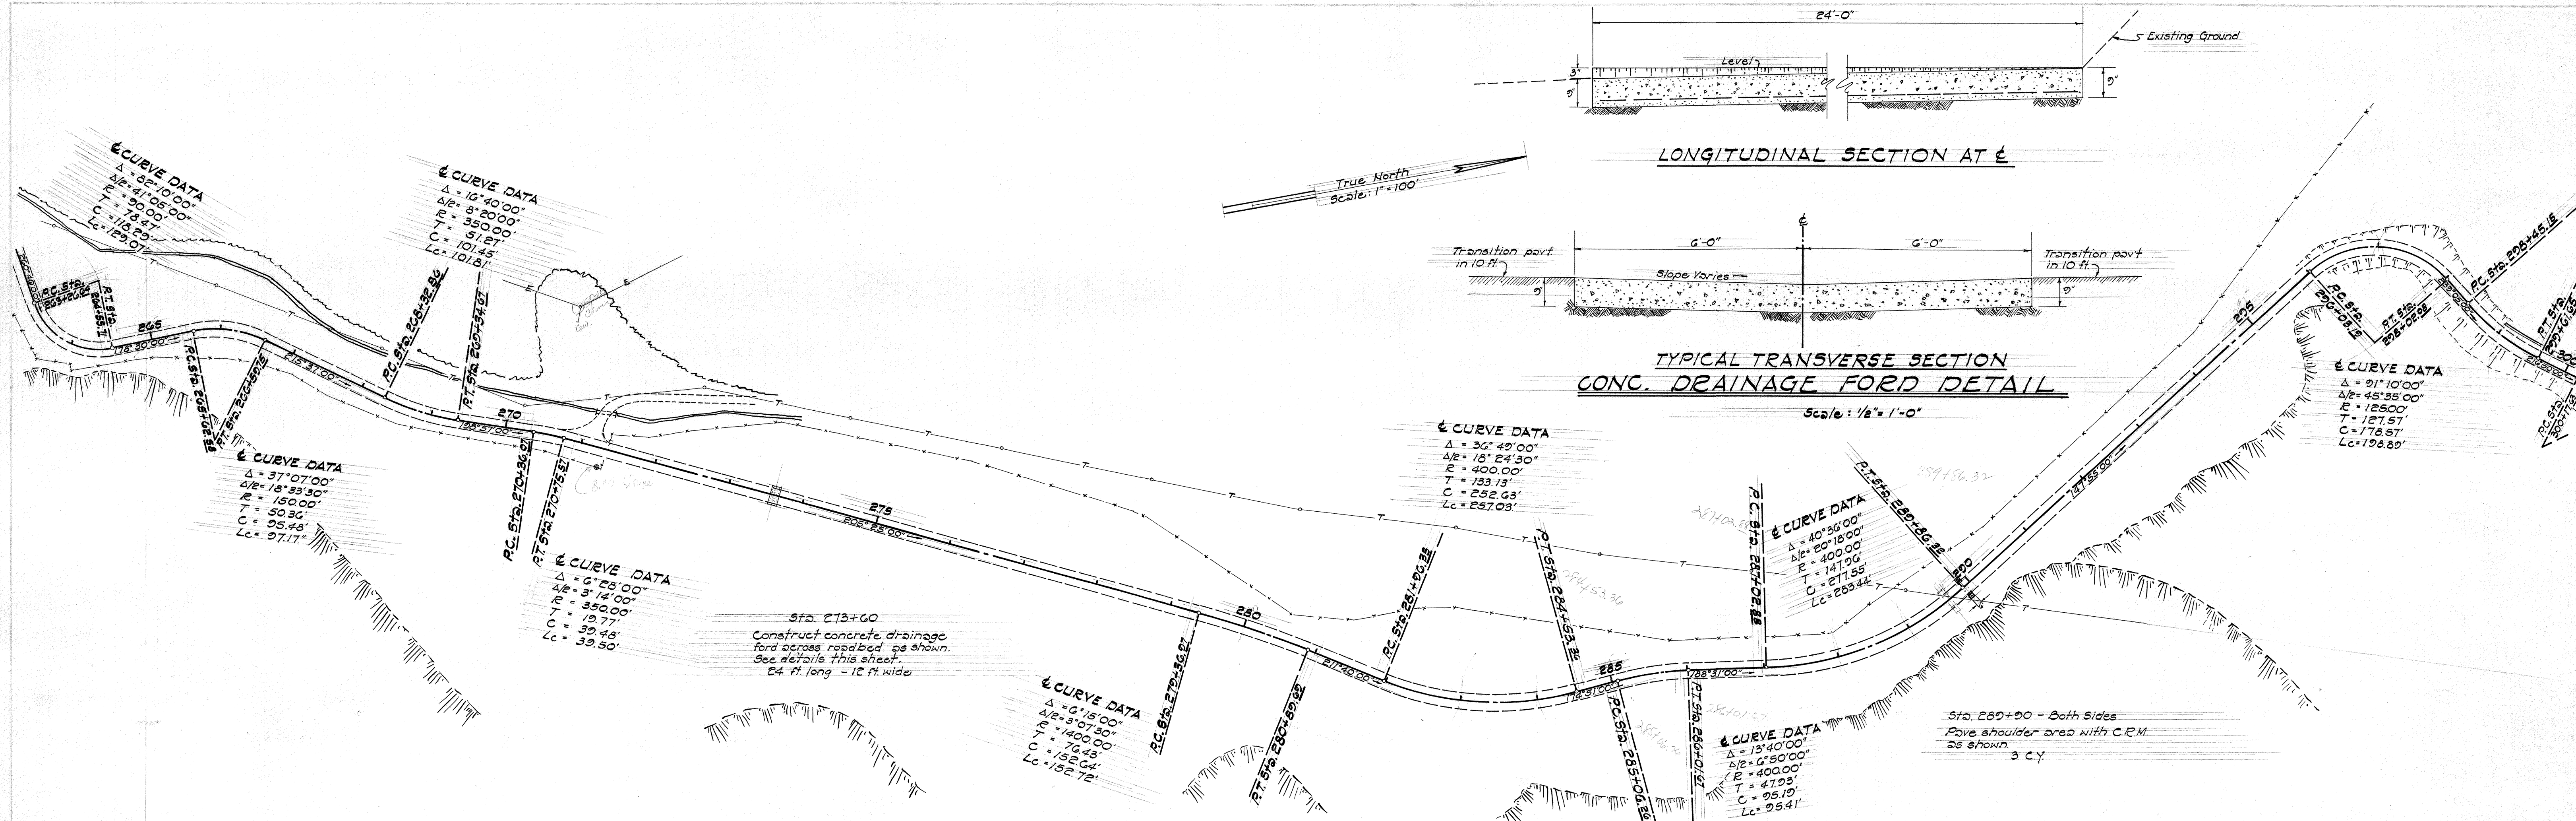

PLAN	DATE
SURVEYED	
PLANNED	
NOTE BOOK	
RT. OF WAY CHECKED	

PROFILE	DATE
SURVEYED	
PLANNED	
NOTE BOOK	
STRUCTURE INFORMATION SHEET	

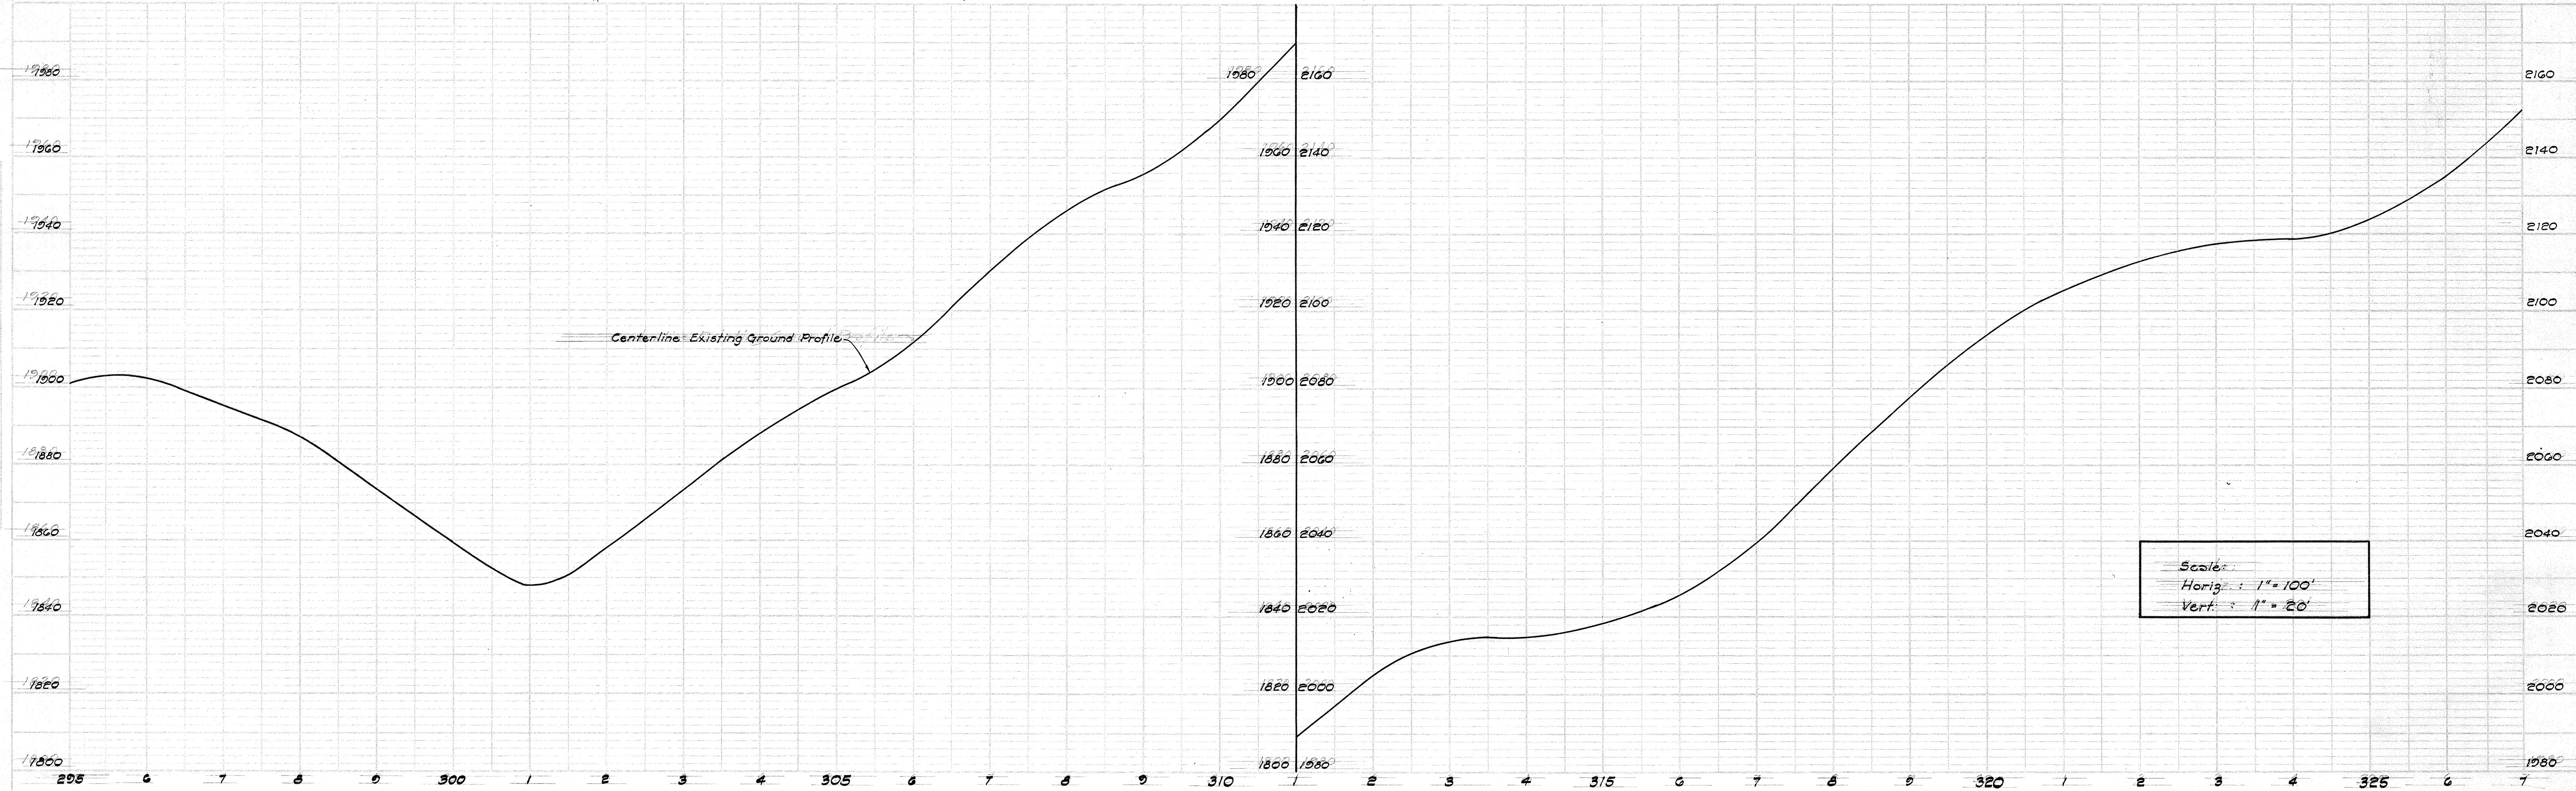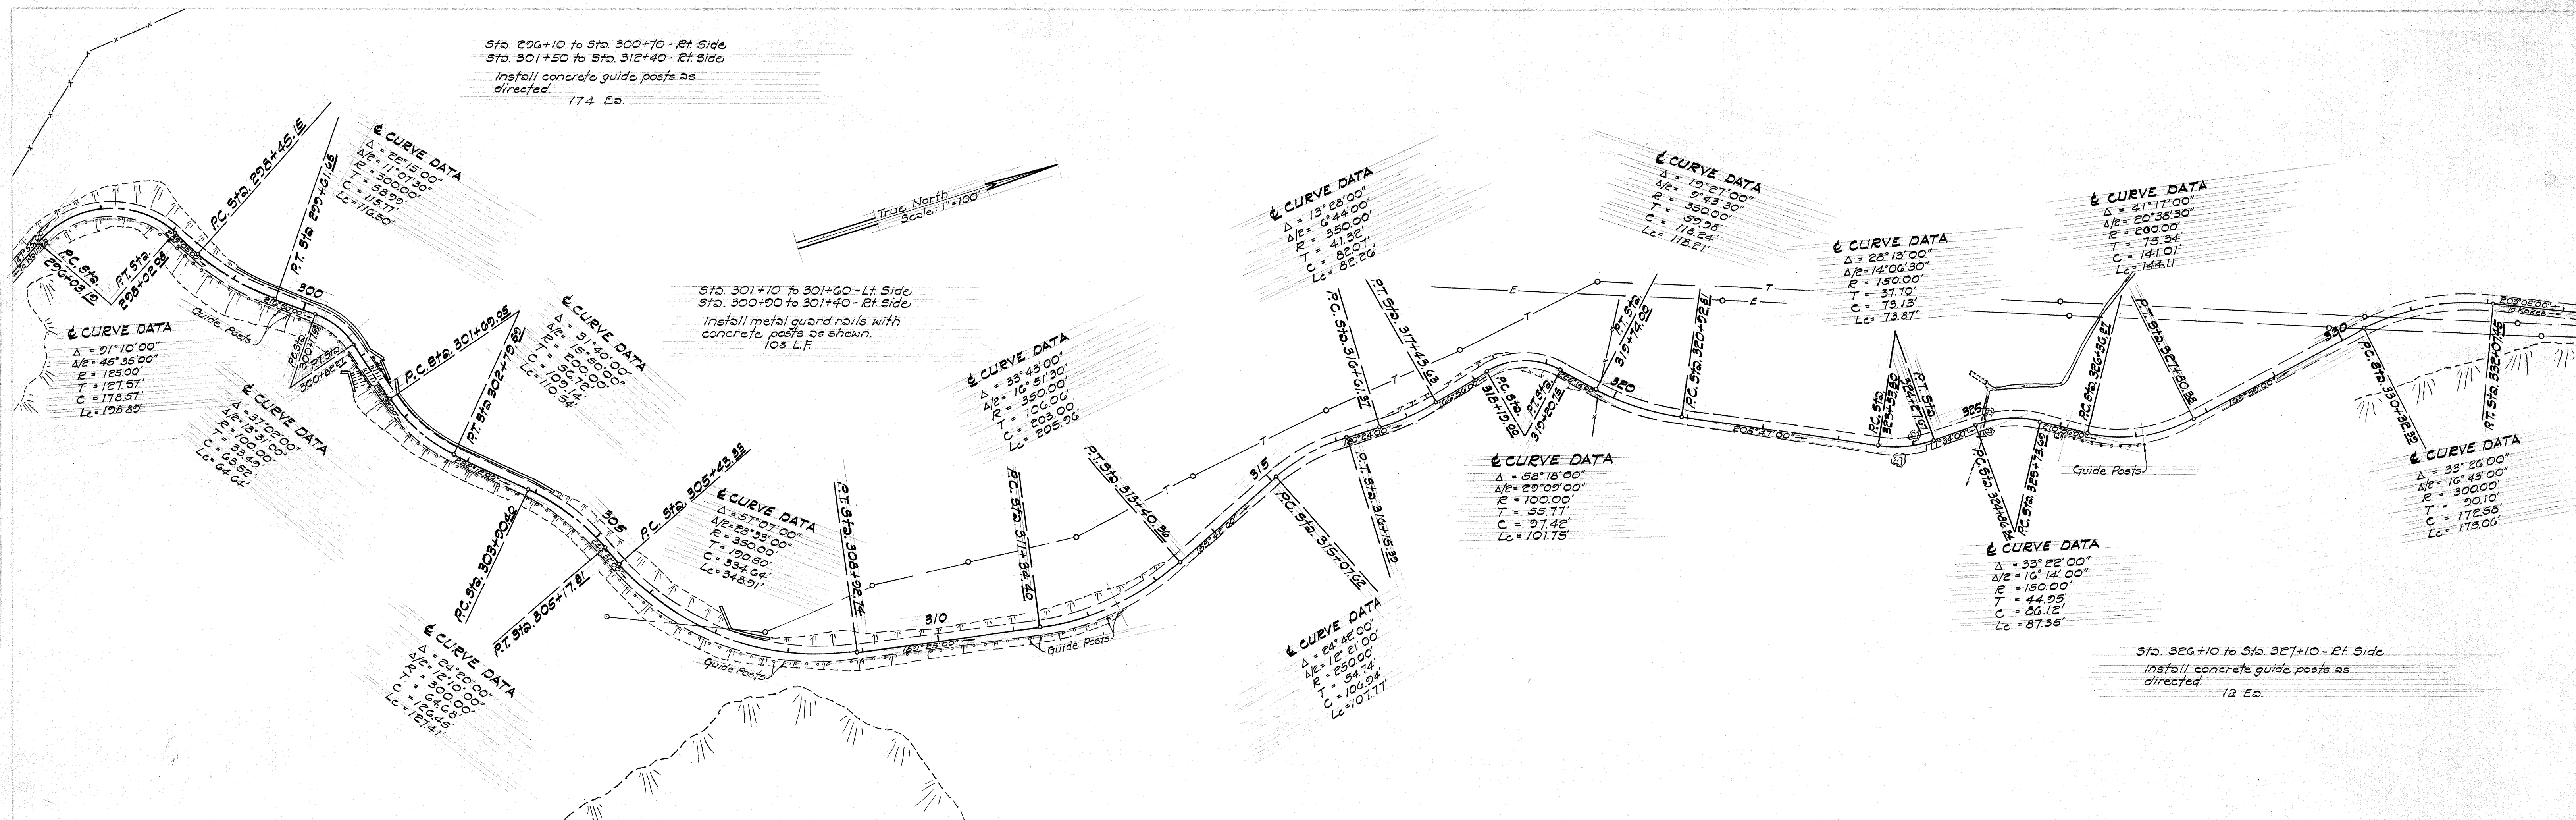

PLAN	DATE	BY
DESIGNED		
PLANNED		
NOTE BOOK		
NO.		

PROFILE	DATE	BY
DESIGNED		
PLANNED		
NOTE BOOK		
NO.		

