


INDEX TO DRAWINGS	
SHEET NO.	DESCRIPTION

STATE OF HAWAII
DEPARTMENT OF TRANSPORTATION
HIGHWAYS DIVISION
PLANS OF
A PORTION OF
KOKEE - WAIMEA HEIGHTS ROAD
PROJECT NO. *G-3928-01-69*
DISTRICT OF WAIMEA
ISLAND OF KAUAI

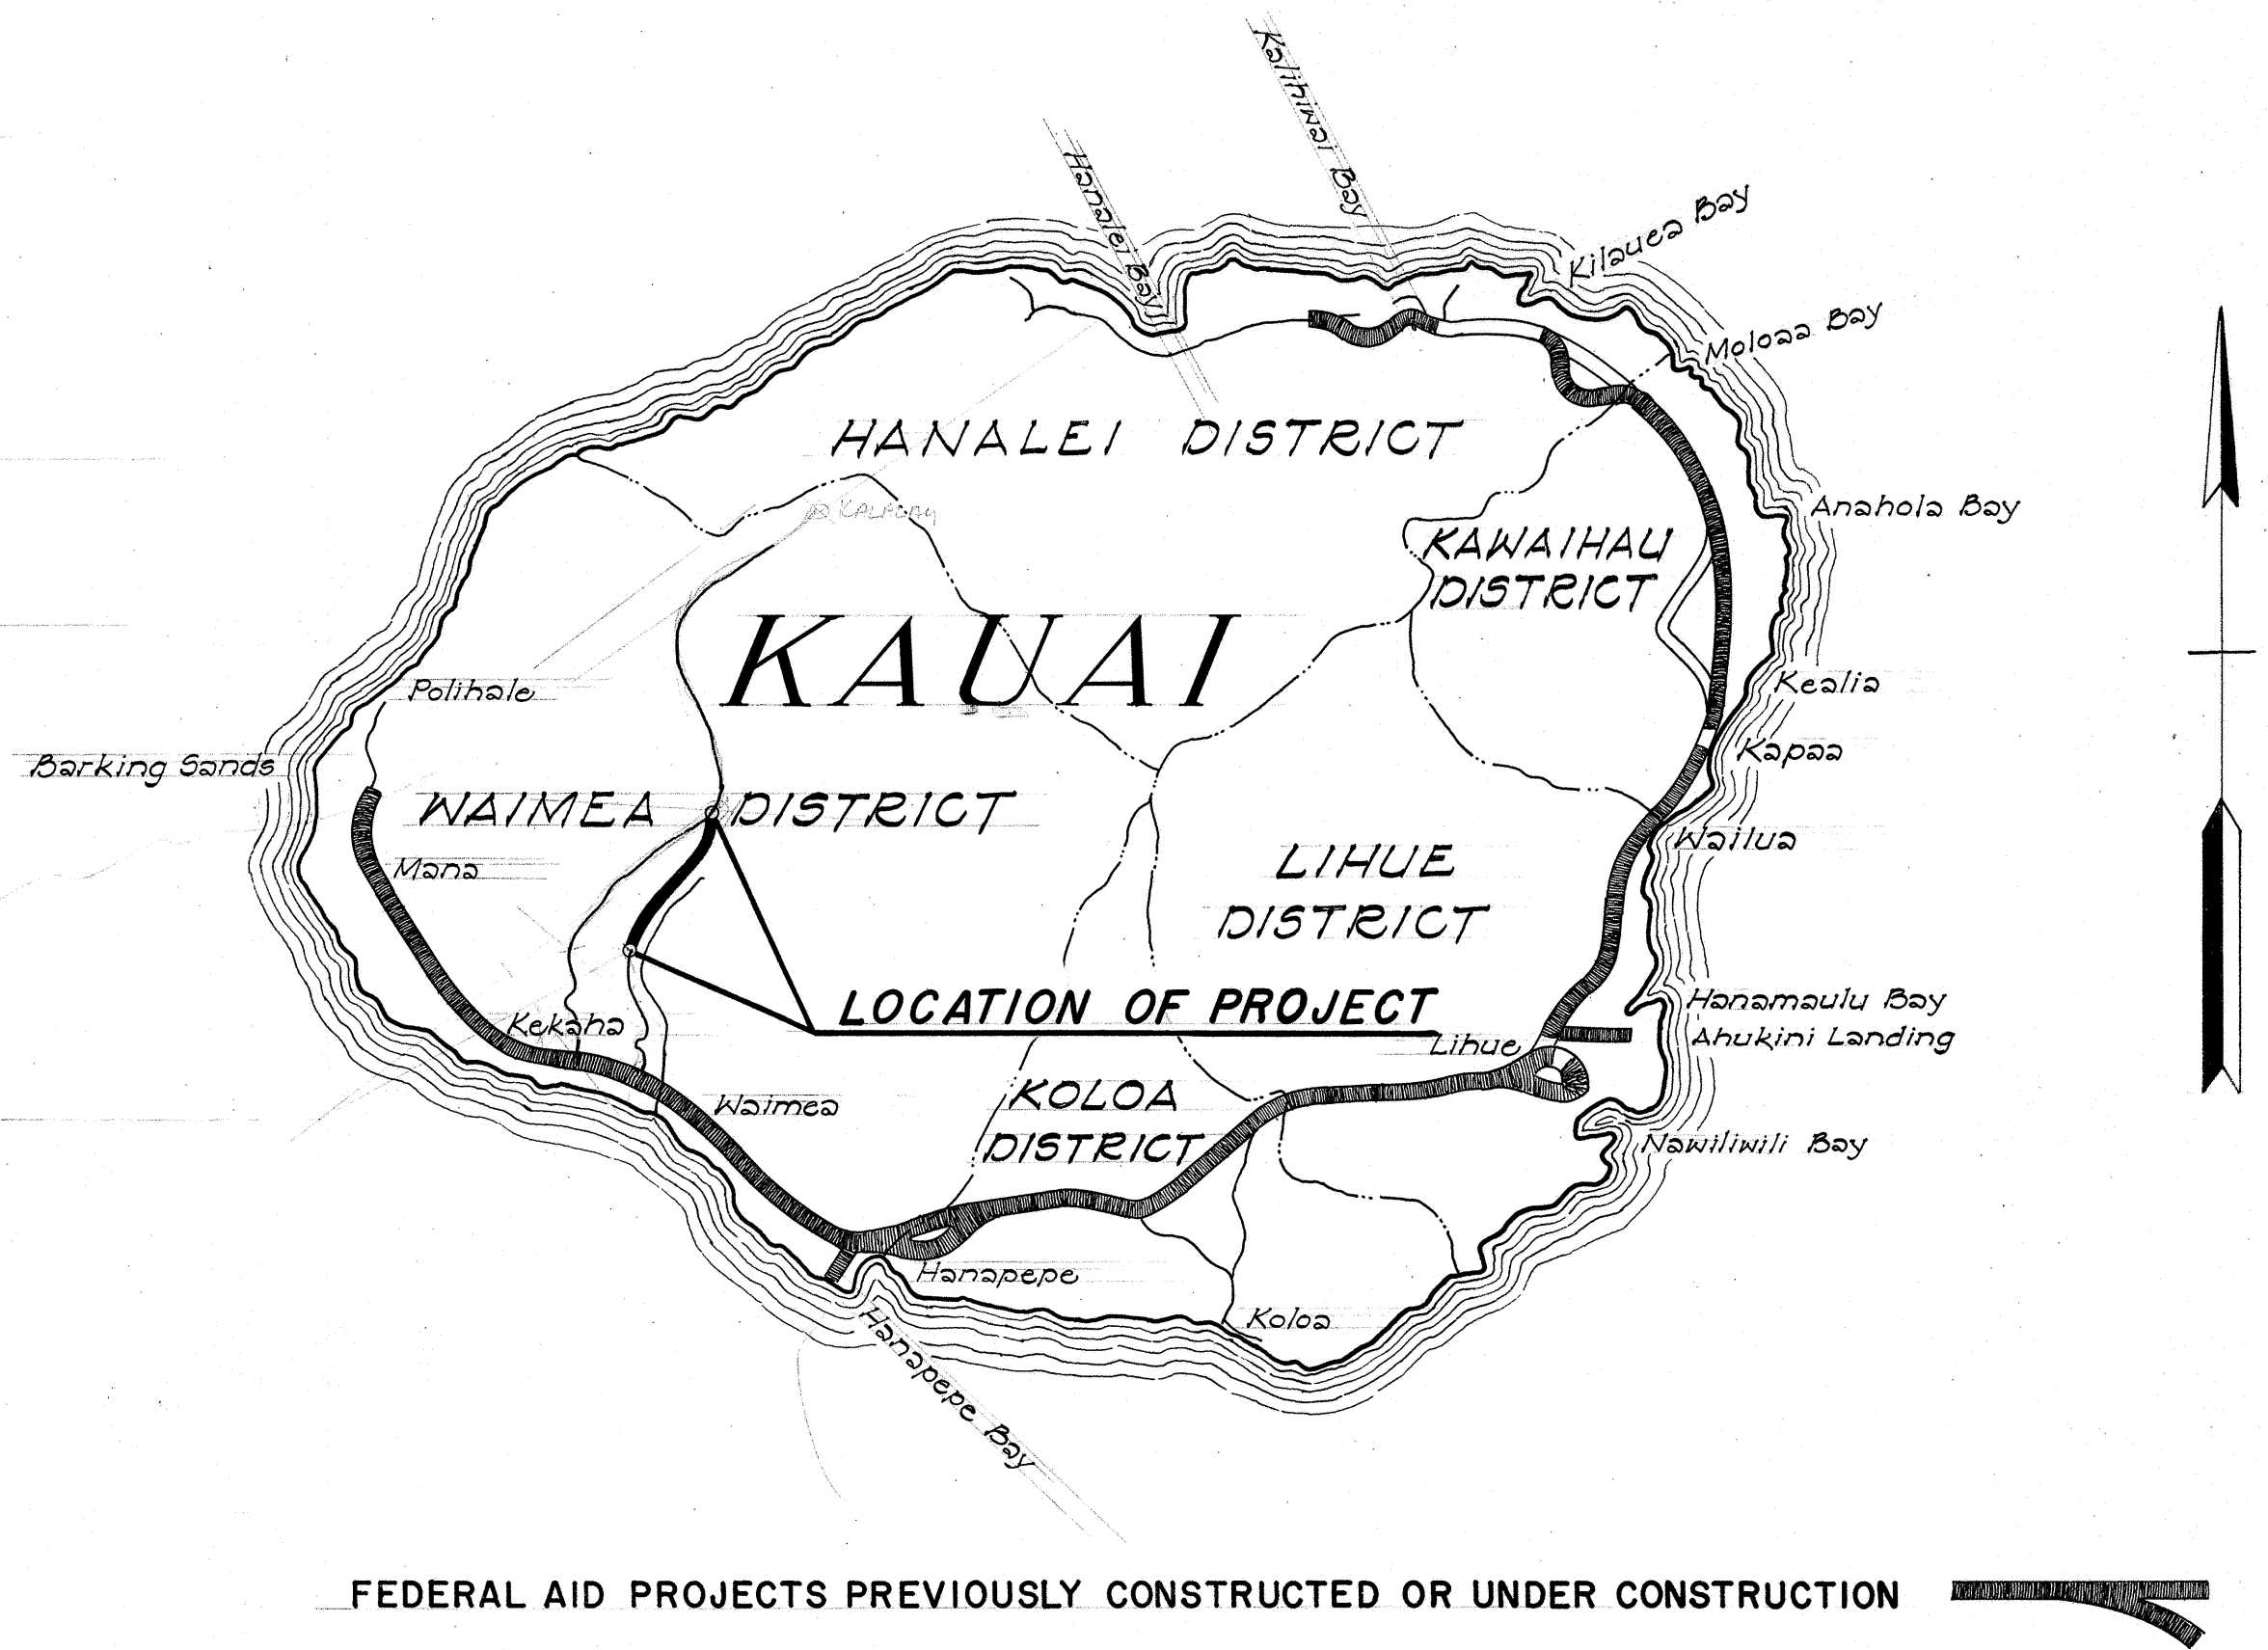

CONVENTIONAL	SIGNS
Baseline	75
Boundary Line	
Fences (Named)	
Existing Roadway	
Pipe Culvert	
Box Culvert	
Telephone Line & Pole	T - T
Electric Line & Pole	E - E
Water Main	W ₁ - W ₁

SCALES	
PLAN	1 INCH = 100 FT.
PROFILE	HOR. 1 INCH = 100 FT.
	VER. 1 INCH = 20 FT.

