


FED. ROAD DIST. NO.	STATE	PROJ. NO.	FISCAL YEAR	SHEET NO.	TOTAL SHEETS
HAWAII	HAW.	550A-01-01M	2002	12	20

BEGIN PROJECT
Project No. 550A-01-01M
@ P.C. Sta. 259+20.91

Sta. 260+05 to Sta. 262+05 o/s Lt.
Install 125 L.F. of Strong Post
W-Beam Guardrail and FLEAT-350
at Approach and Trailing Ends.

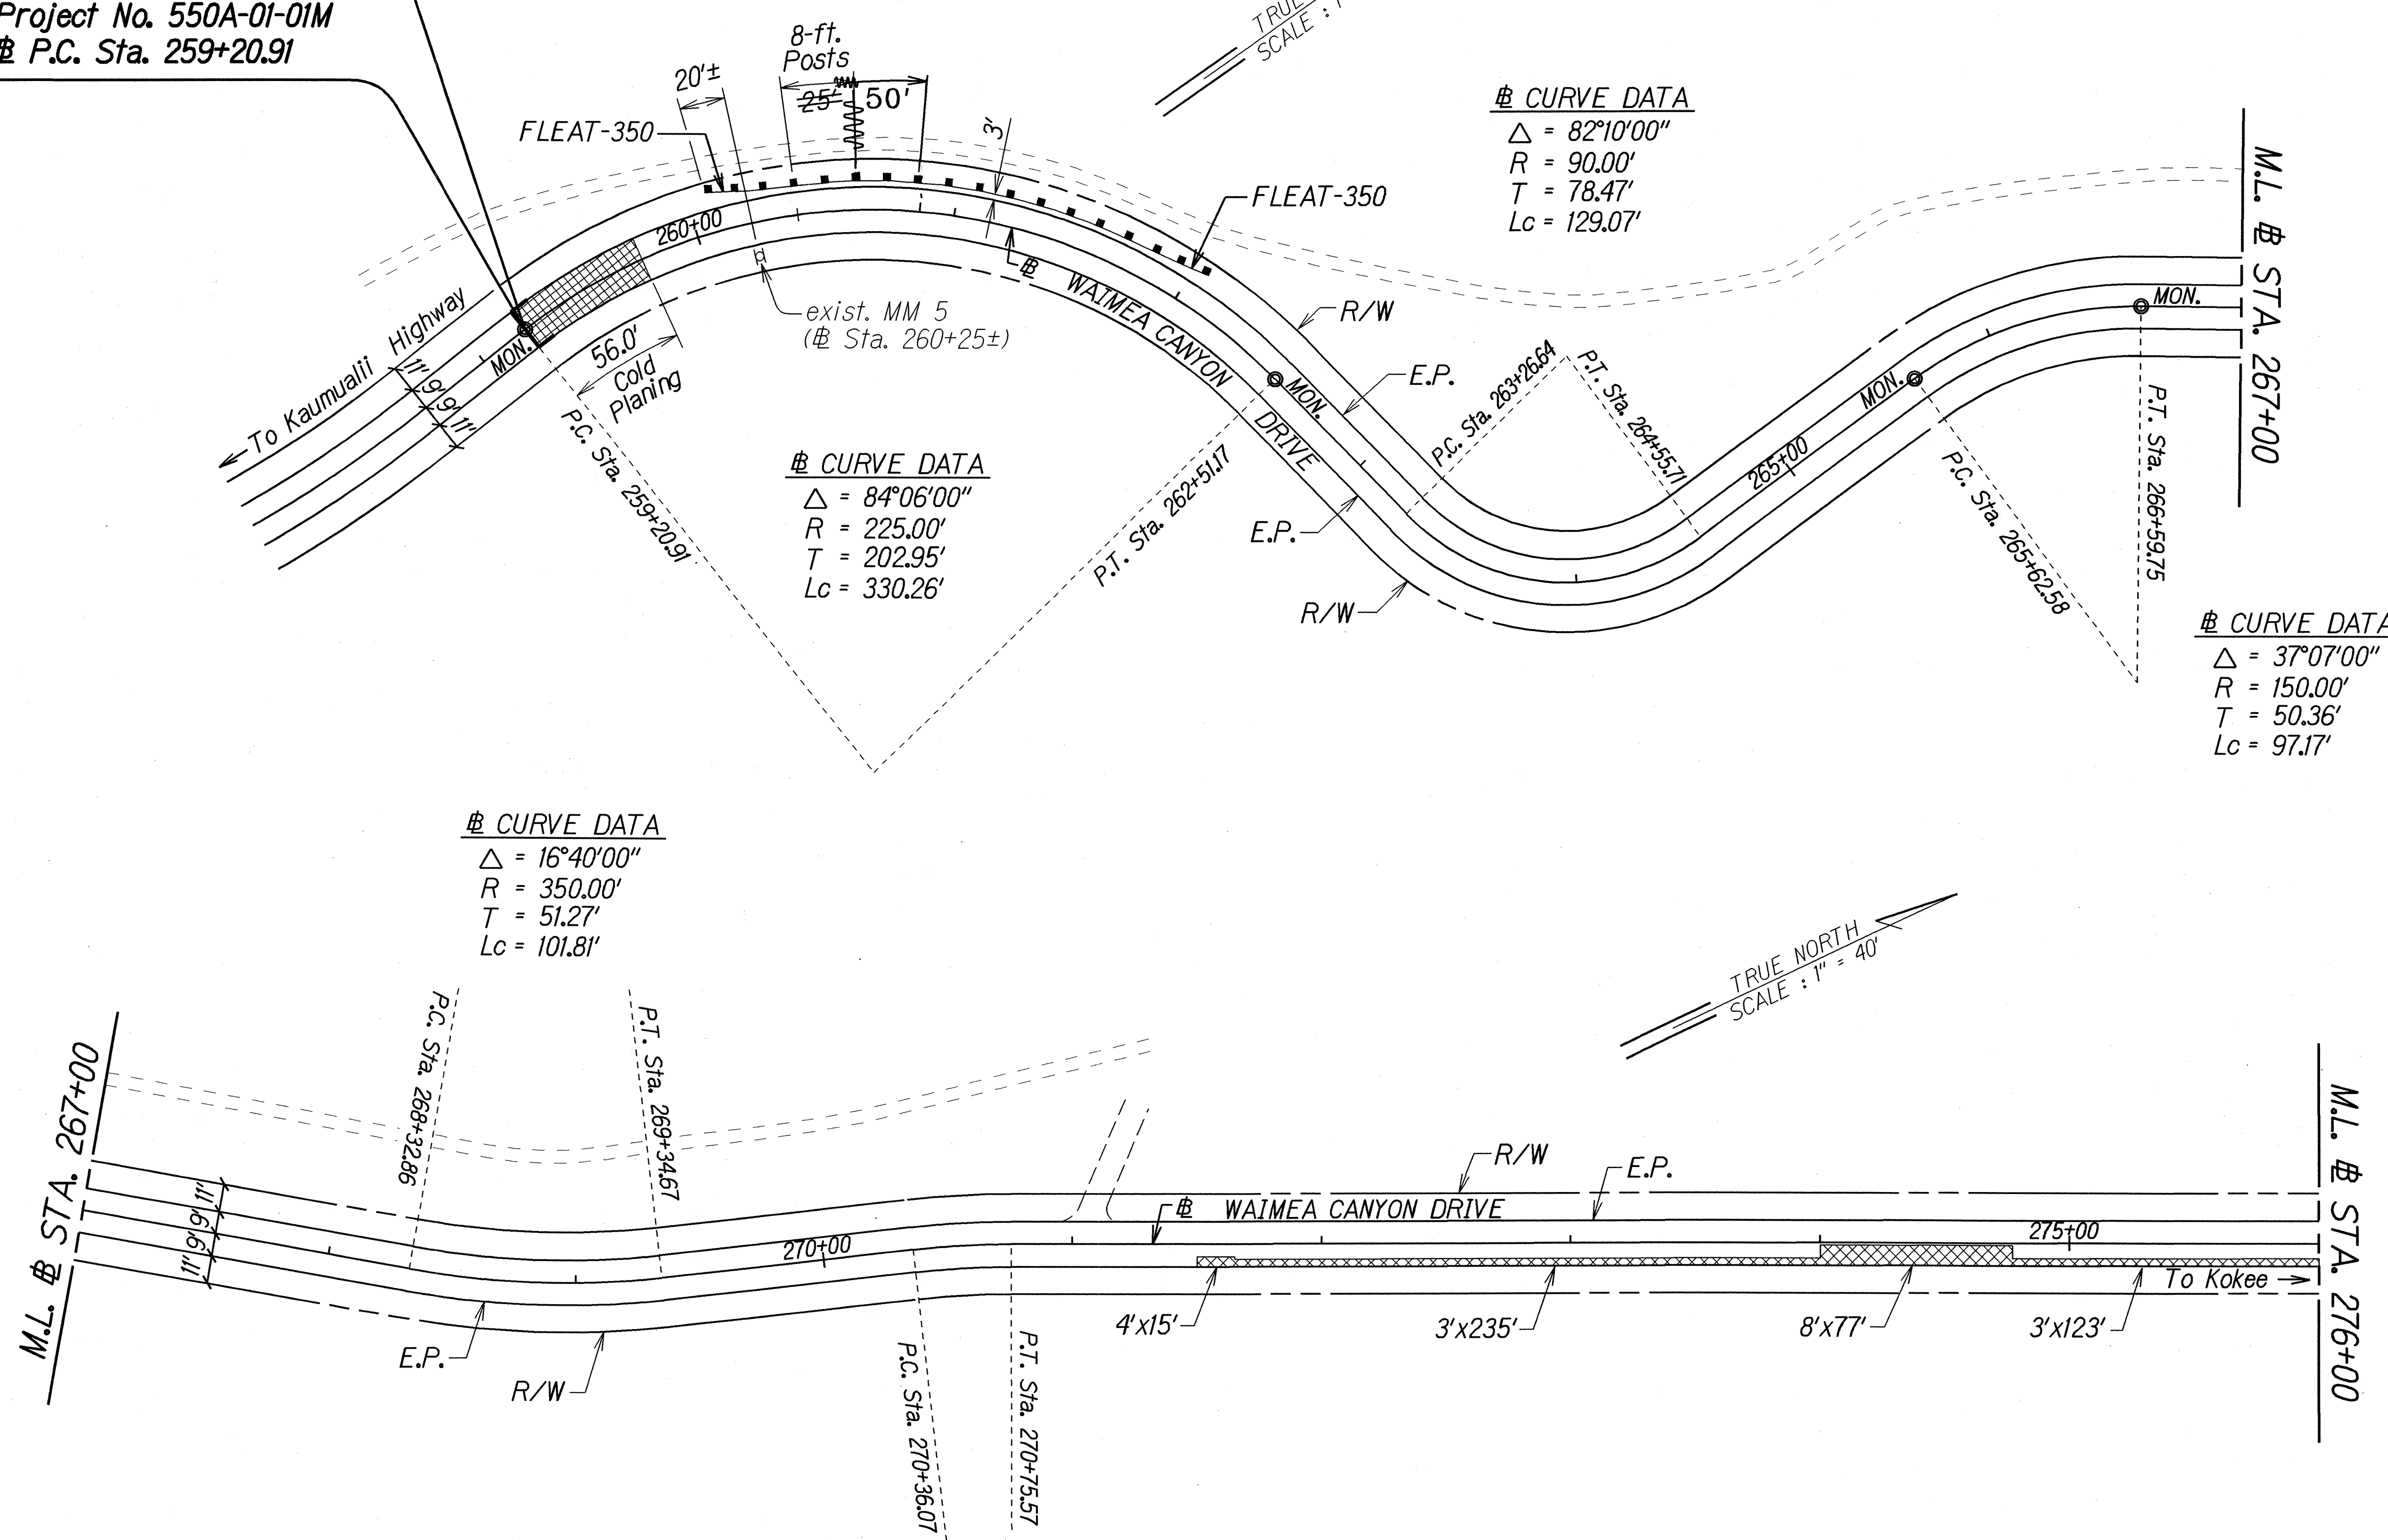

SURVEY PLOTTED BY	DATE
DESIGNED BY	6-21-00
CHECKED BY	
NOTE BOOK	
QUANTITIES BY	
CHECKED BY	

LEGEND FOR AS-BUILT POSTINGS	
	Squiggly line for as-built deletion
	Double line for as-built deletion
Roadway	Text for as-built posting

STATE OF HAWAII
DEPARTMENT OF TRANSPORTATION
HIGHWAYS DIVISION

ROADWAY PLAN

WAIMEA CANYON DRIVE RESURFACING
Vicinity of Kokee Road Intersection
Project No. 550A-01-01M

Scale: 1" = 40' Date: June 2001


SHEET No. 1 OF 3 SHEETS

"AS-BUILT"

FED. ROAD DIST. NO.	STATE	PROJ. NO.	FISCAL YEAR	SHEET NO.	TOTAL SHEETS
HAWAII	HAW.	550A-01-01M	2002	13	20


CURVE DATA

$\Delta = 36^{\circ}49'00''$
 $R = 400.00'$
 $T = 133.13'$
 $Lc = 257.03'$

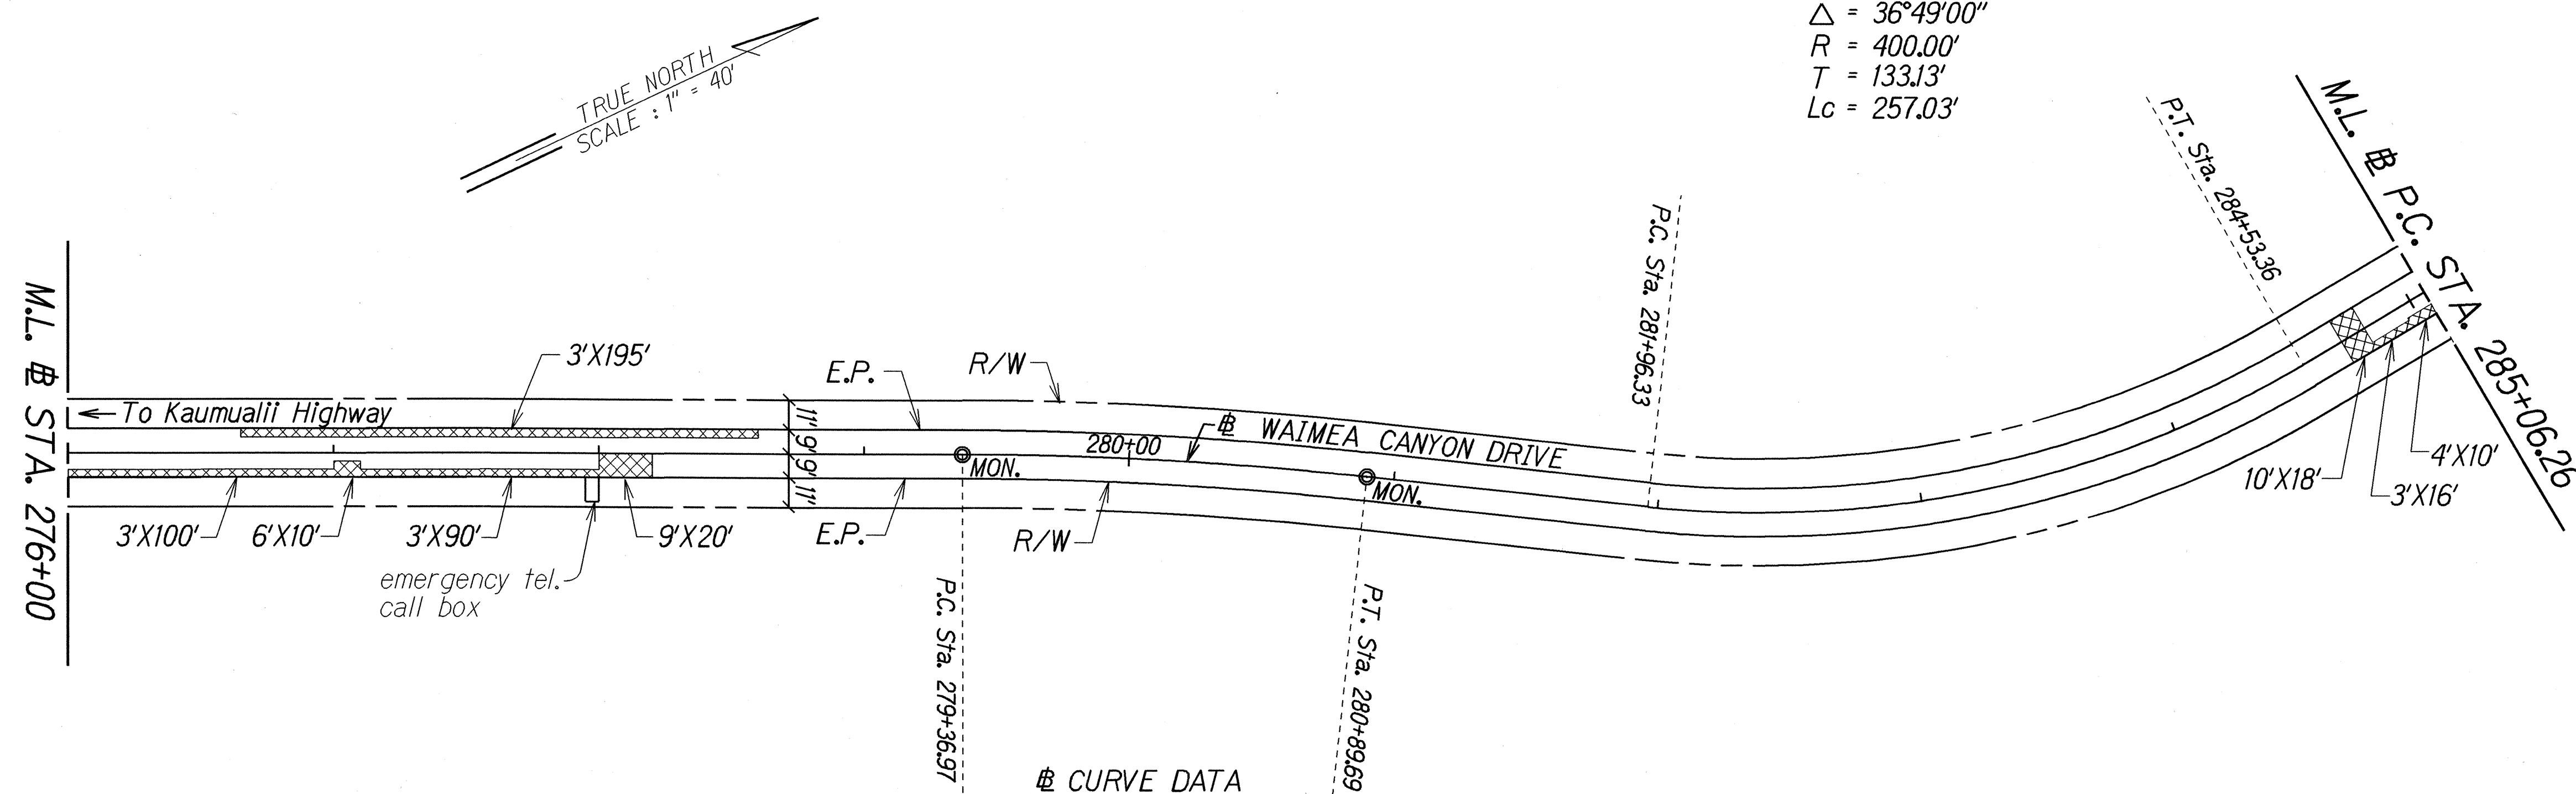

CURVE DATA

$\Delta = 6^{\circ}15'00''$
 $R = 1,400.00'$
 $T = 76.43'$
 $Lc = 152.72'$

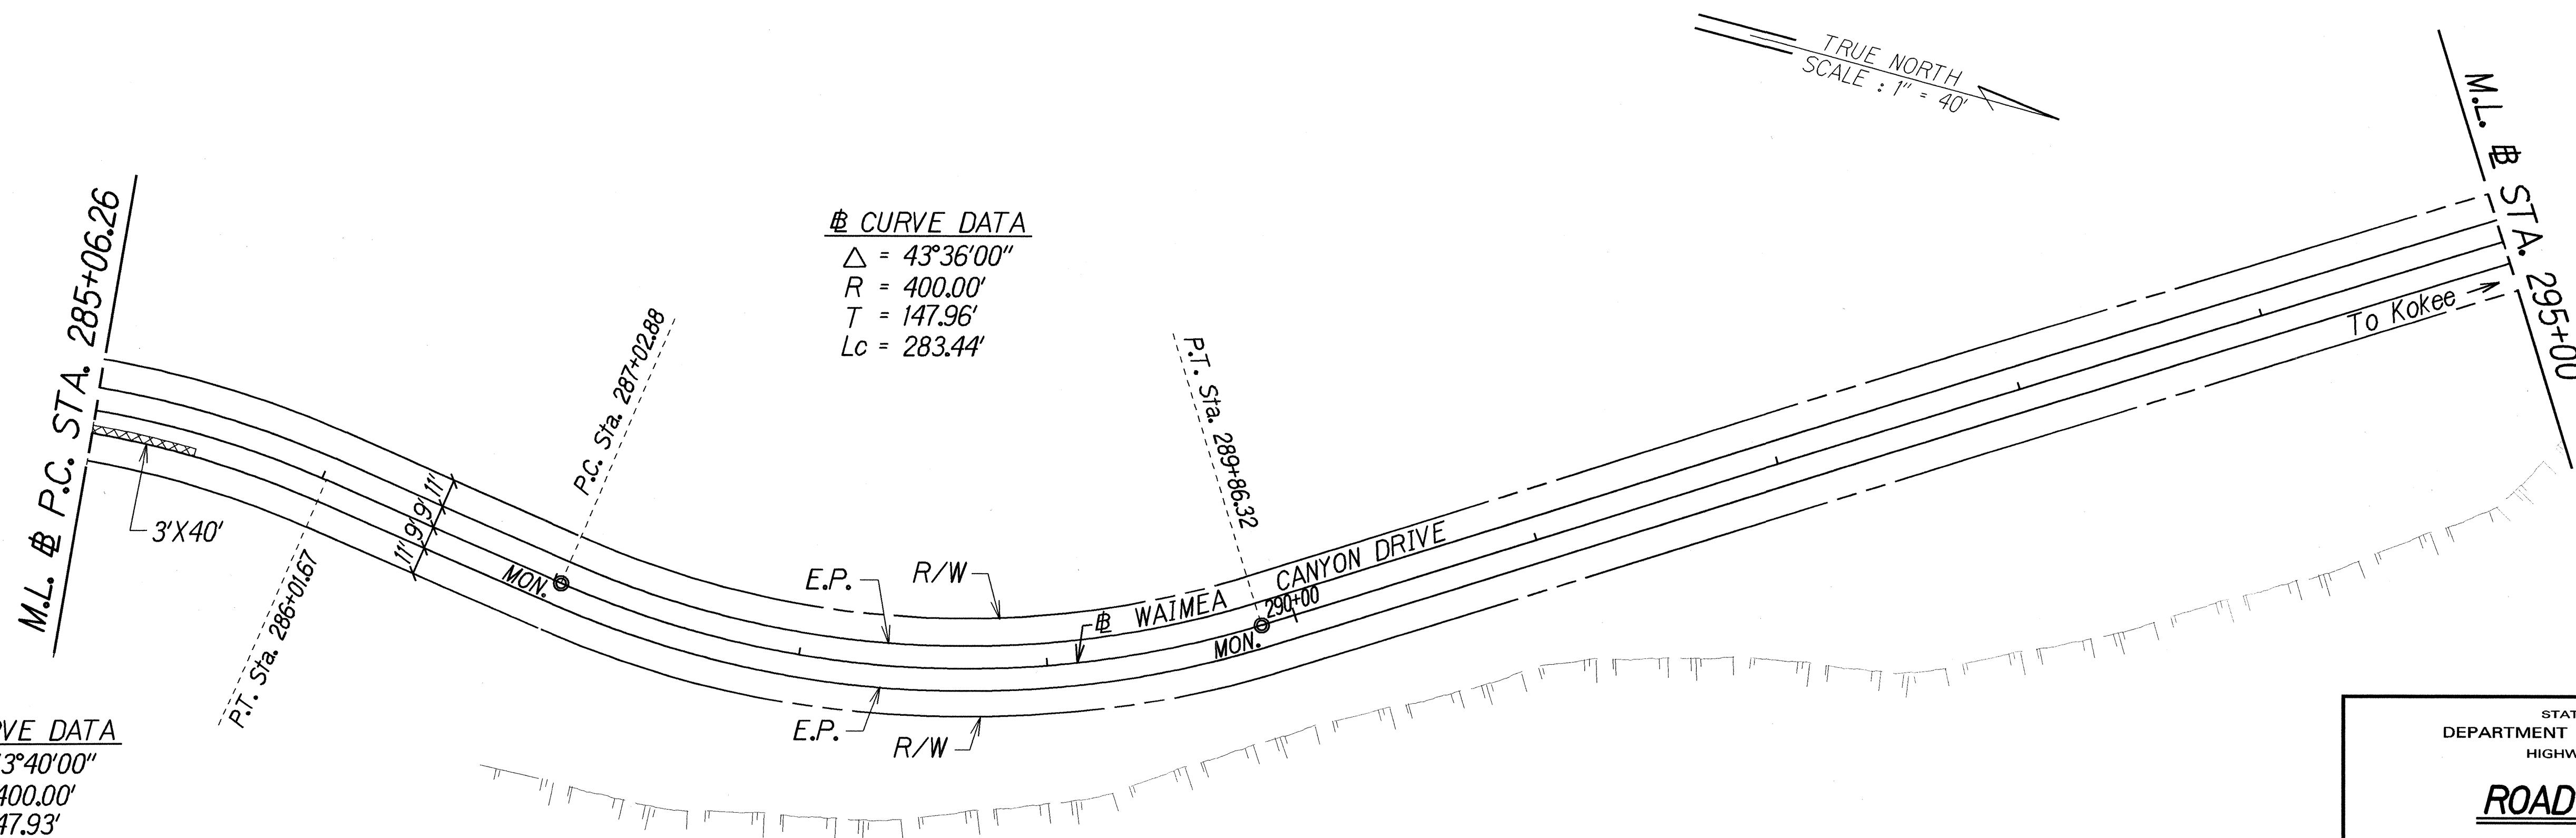

CURVE DATA

$\Delta = 13^{\circ}40'00''$
 $R = 400.00'$
 $T = 47.93'$
 $Lc = 95.41'$

ORIGINAL PLAN	SURVEY PLOTTED BY	DATE
NOTE BOOK	DRAWN BY	6/21/01
REFERENCE	CHECKED BY	
NO. 1000000000		

STATE OF HAWAII
DEPARTMENT OF TRANSPORTATION
HIGHWAYS DIVISION



ROADWAY PLAN

WAIMEA CANYON DRIVE RESURFACING
Vicinity of Kokee Road Intersection
Project No. 550A-01-01M

Scale: 1" = 40' Date: June 2001

SHEET No. 2 OF 3 SHEETS

FED. ROAD DIST. NO.	STATE	PROJ. NO.	FISCAL YEAR	SHEET NO.	TOTAL SHEETS
HAWAII	HAW.	550A-01-01M	2002	14	20

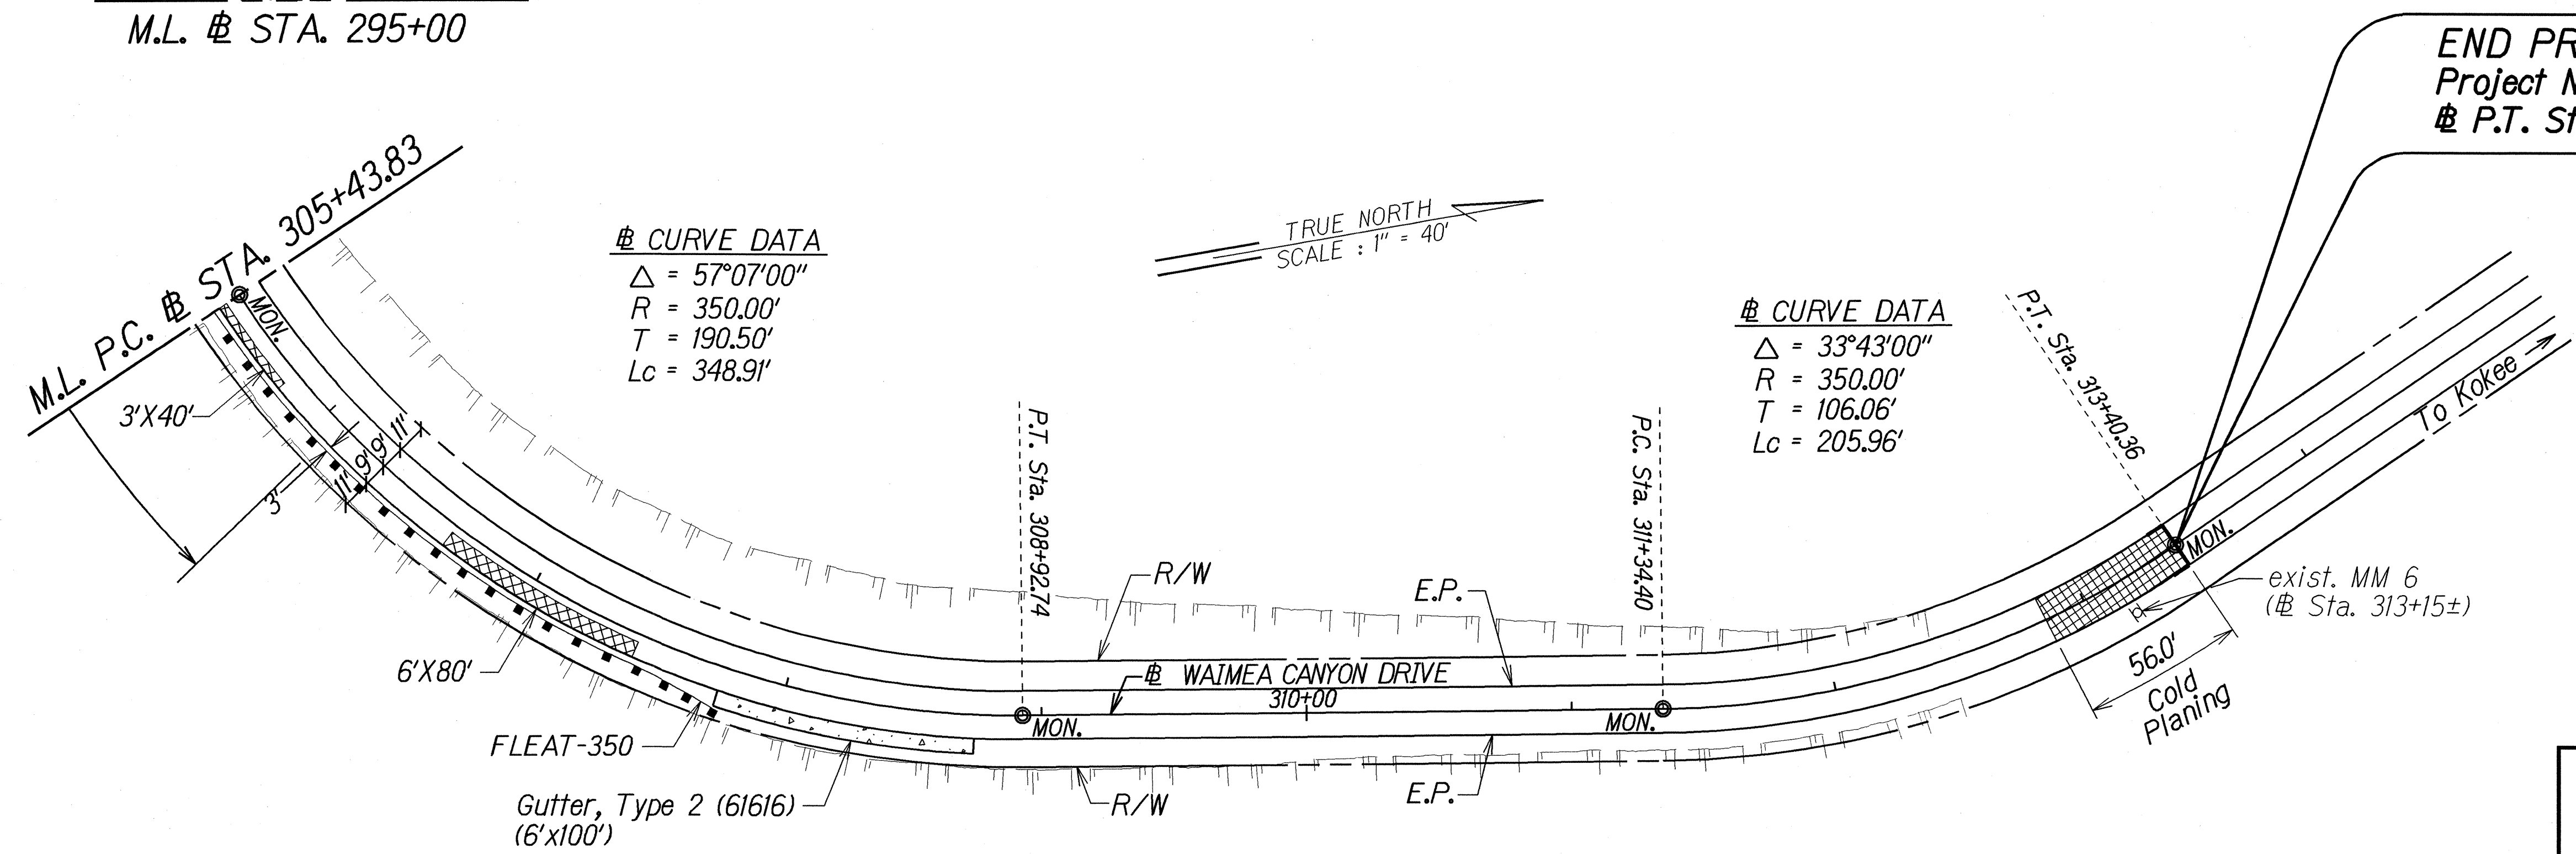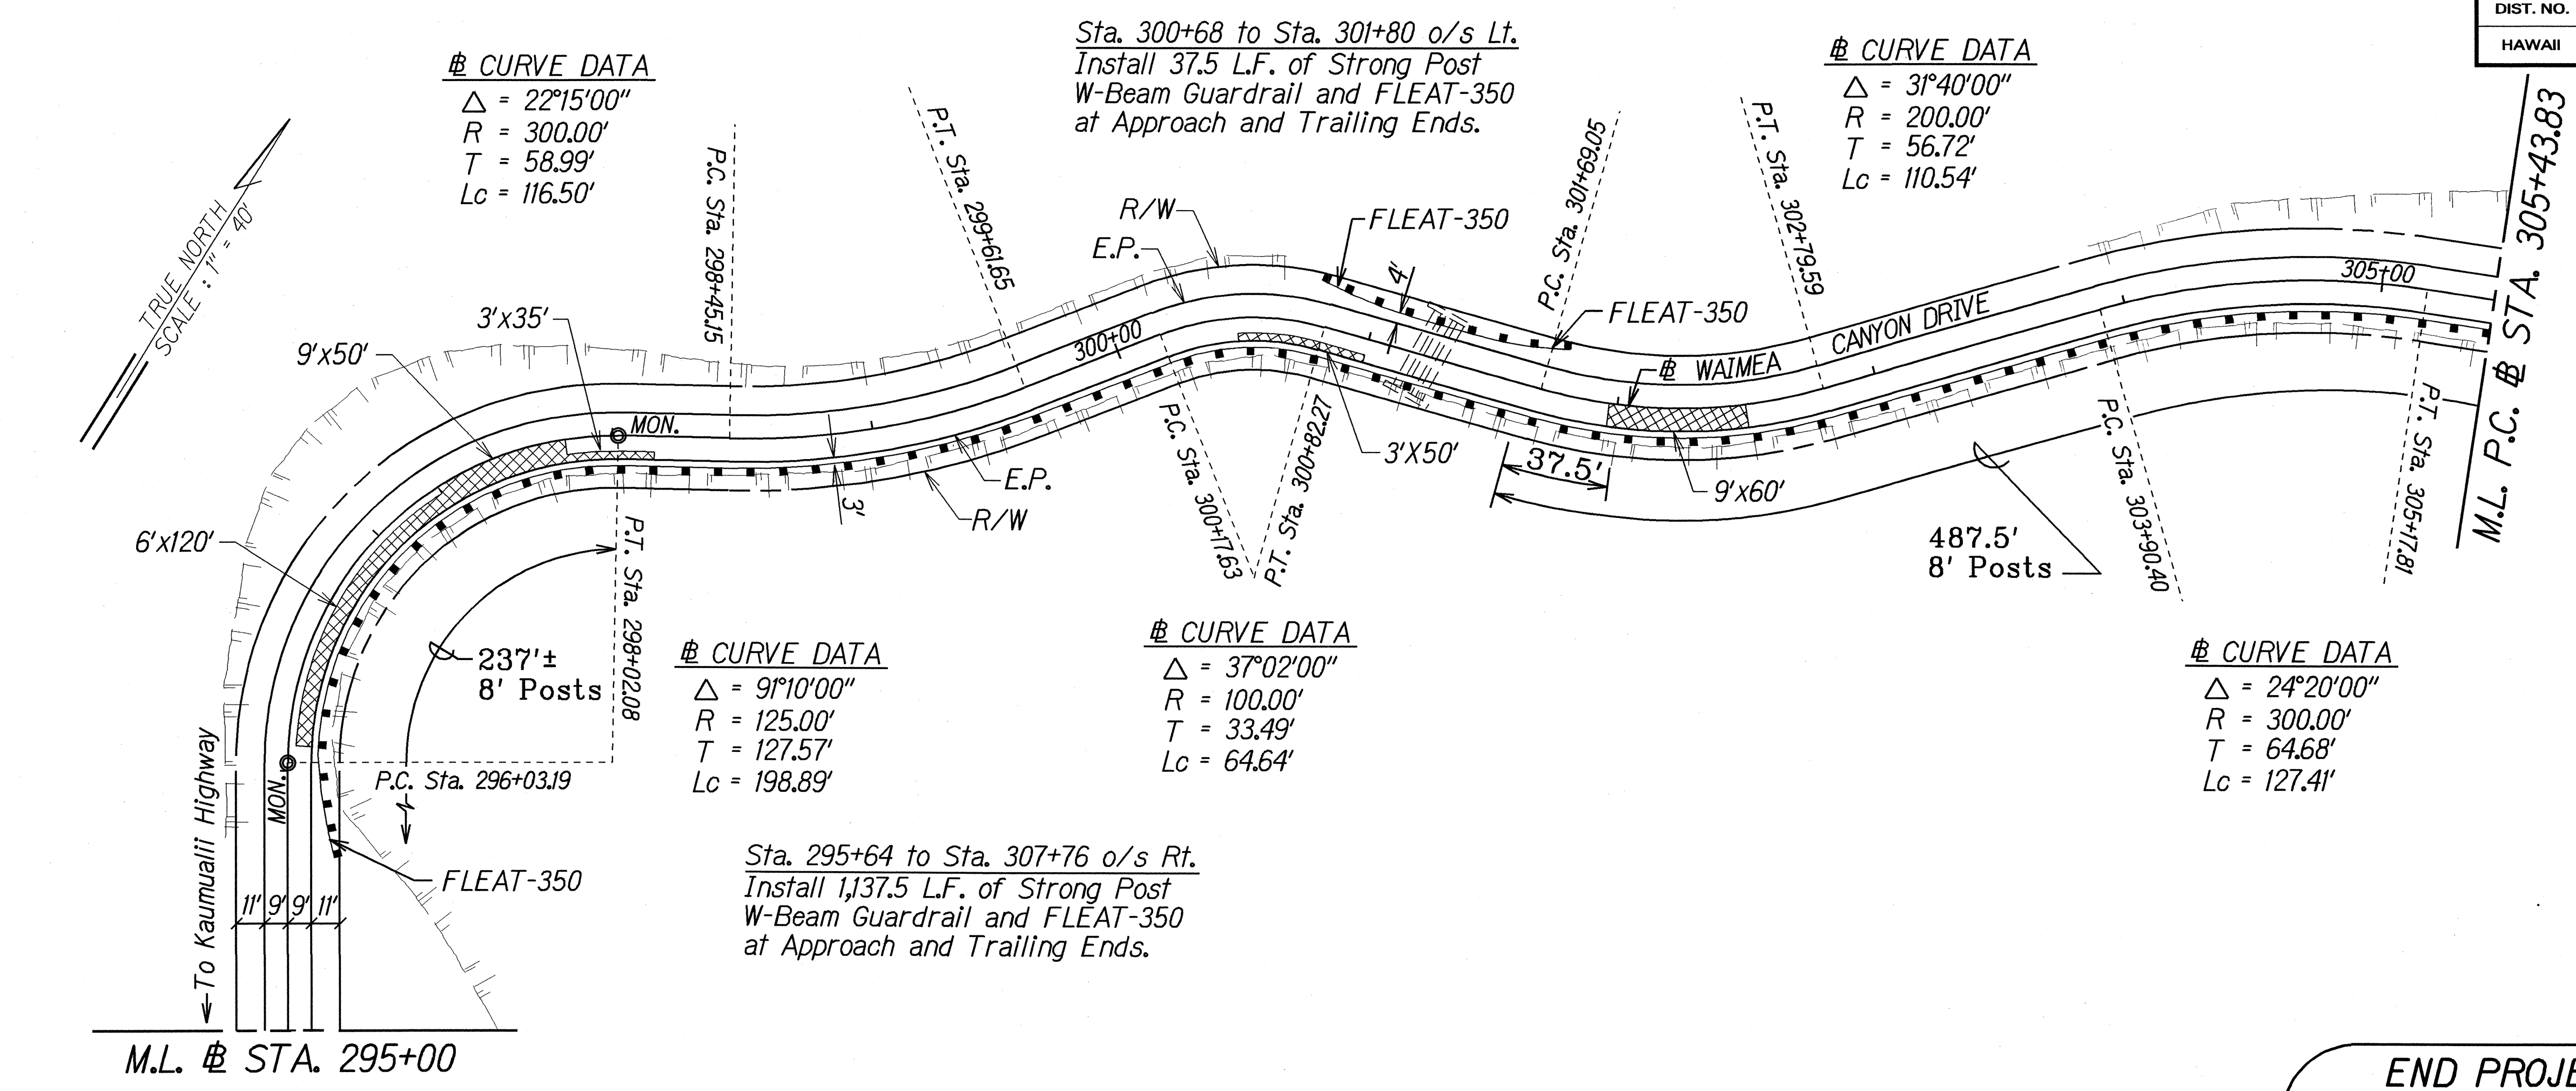

END PROJECT
Project No. 550A-01-01M
P.T. Sta. 313+40.36

ORIGINAL PLAN
DATE 6/21/01
DRAWN BY R. Arch
CHECKED BY R. Arch
NOTE: SEE PLAN FOR QUANTITIES BY STATIONING
DATE 6/21/01

LEGEND FOR AS-BUILT POSTINGS	
	Squiggly line for as-built deletion
	Double line for as-built deletion
Roadway	Text for as-built posting

STATE OF HAWAII
DEPARTMENT OF TRANSPORTATION
HIGHWAYS DIVISION

ROADWAY PLAN

WAIMEA CANYON DRIVE RESURFACING
Vicinity of Kokee Road Intersection
Project No. 550A-01-01M

Scale: 1" = 40' Date: June 2001

SHEET No. 3 OF 3 SHEETS

"AS-BUILT"