

INDEX TO DRAWINGS	
SHEET NO.	DESCRIPTION
1	TITLE SHEET
2	STANDARD PLANS SUMMARY
3	GENERAL NOTES AND LEGENDS
4 - 5	WATER POLLUTION AND EROSION CONTROL NOTES
6 - 8	TYPICAL SECTIONS AND DETAILS
9	GUARDRAIL DETAILS AND NOTES
10	STRONG POST W-BEAM GUARDRAIL
11	FLEAT-350
12 - 14	ROADWAY PLAN
15	PAVEMENT MARKING LEGEND, DETAILS AND NOTES
16 - 18	PAVEMENT MARKING AND TRAFFIC SIGNING PLAN
19	TRAFFIC SUMMARIES
20	PAVEMENT MARKING SUMMARY AND SIGN DETAILS

STATE OF HAWAII

DEPARTMENT OF TRANSPORTATION

HIGHWAYS DIVISION

HONOLULU, HAWAII

"AS-BUILT"

PLANS FOR

WAIMEA CANYON DRIVE RESURFACING




VICINITY OF KOKEE ROAD INTERSECTION

PROJECT NO. 550A-01-01M

DISTRICT OF WAIMEA

ISLAND OF KAUAI

FED. ROAD DIST. NO.	STATE	PROJ. NO.	FISCAL YEAR	SHEET NO.	TOTAL SHEETS
HAWAII	HAW.	550A-01-01M	2002	1	20

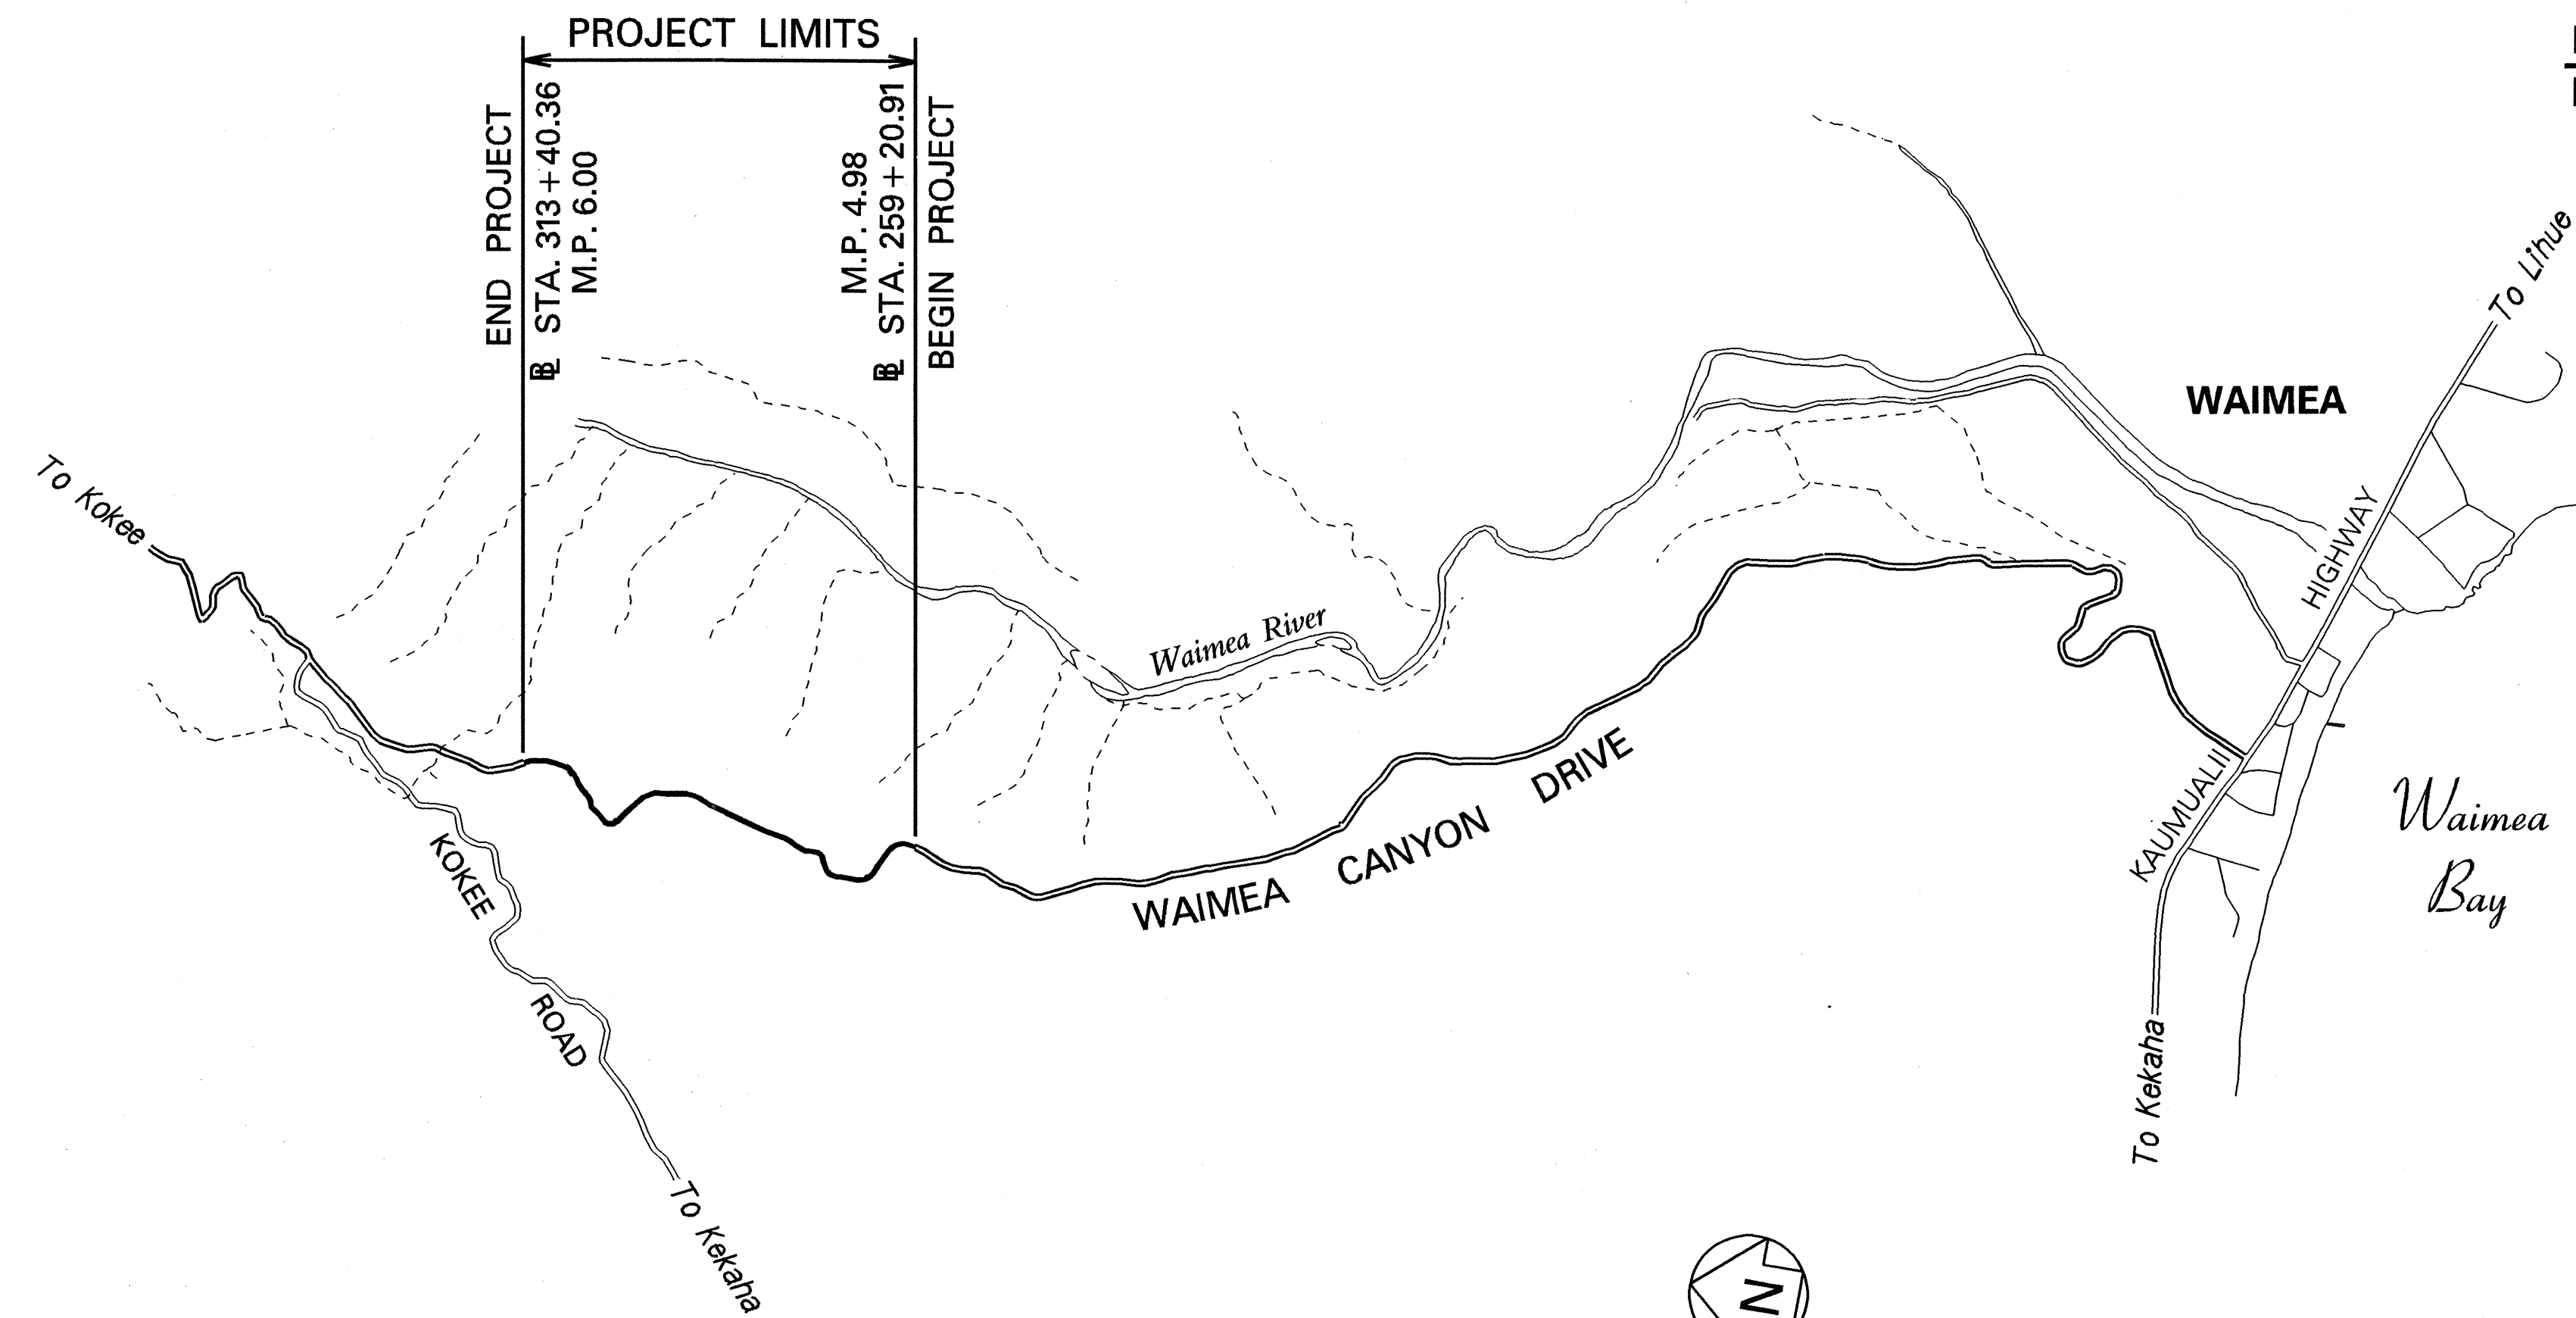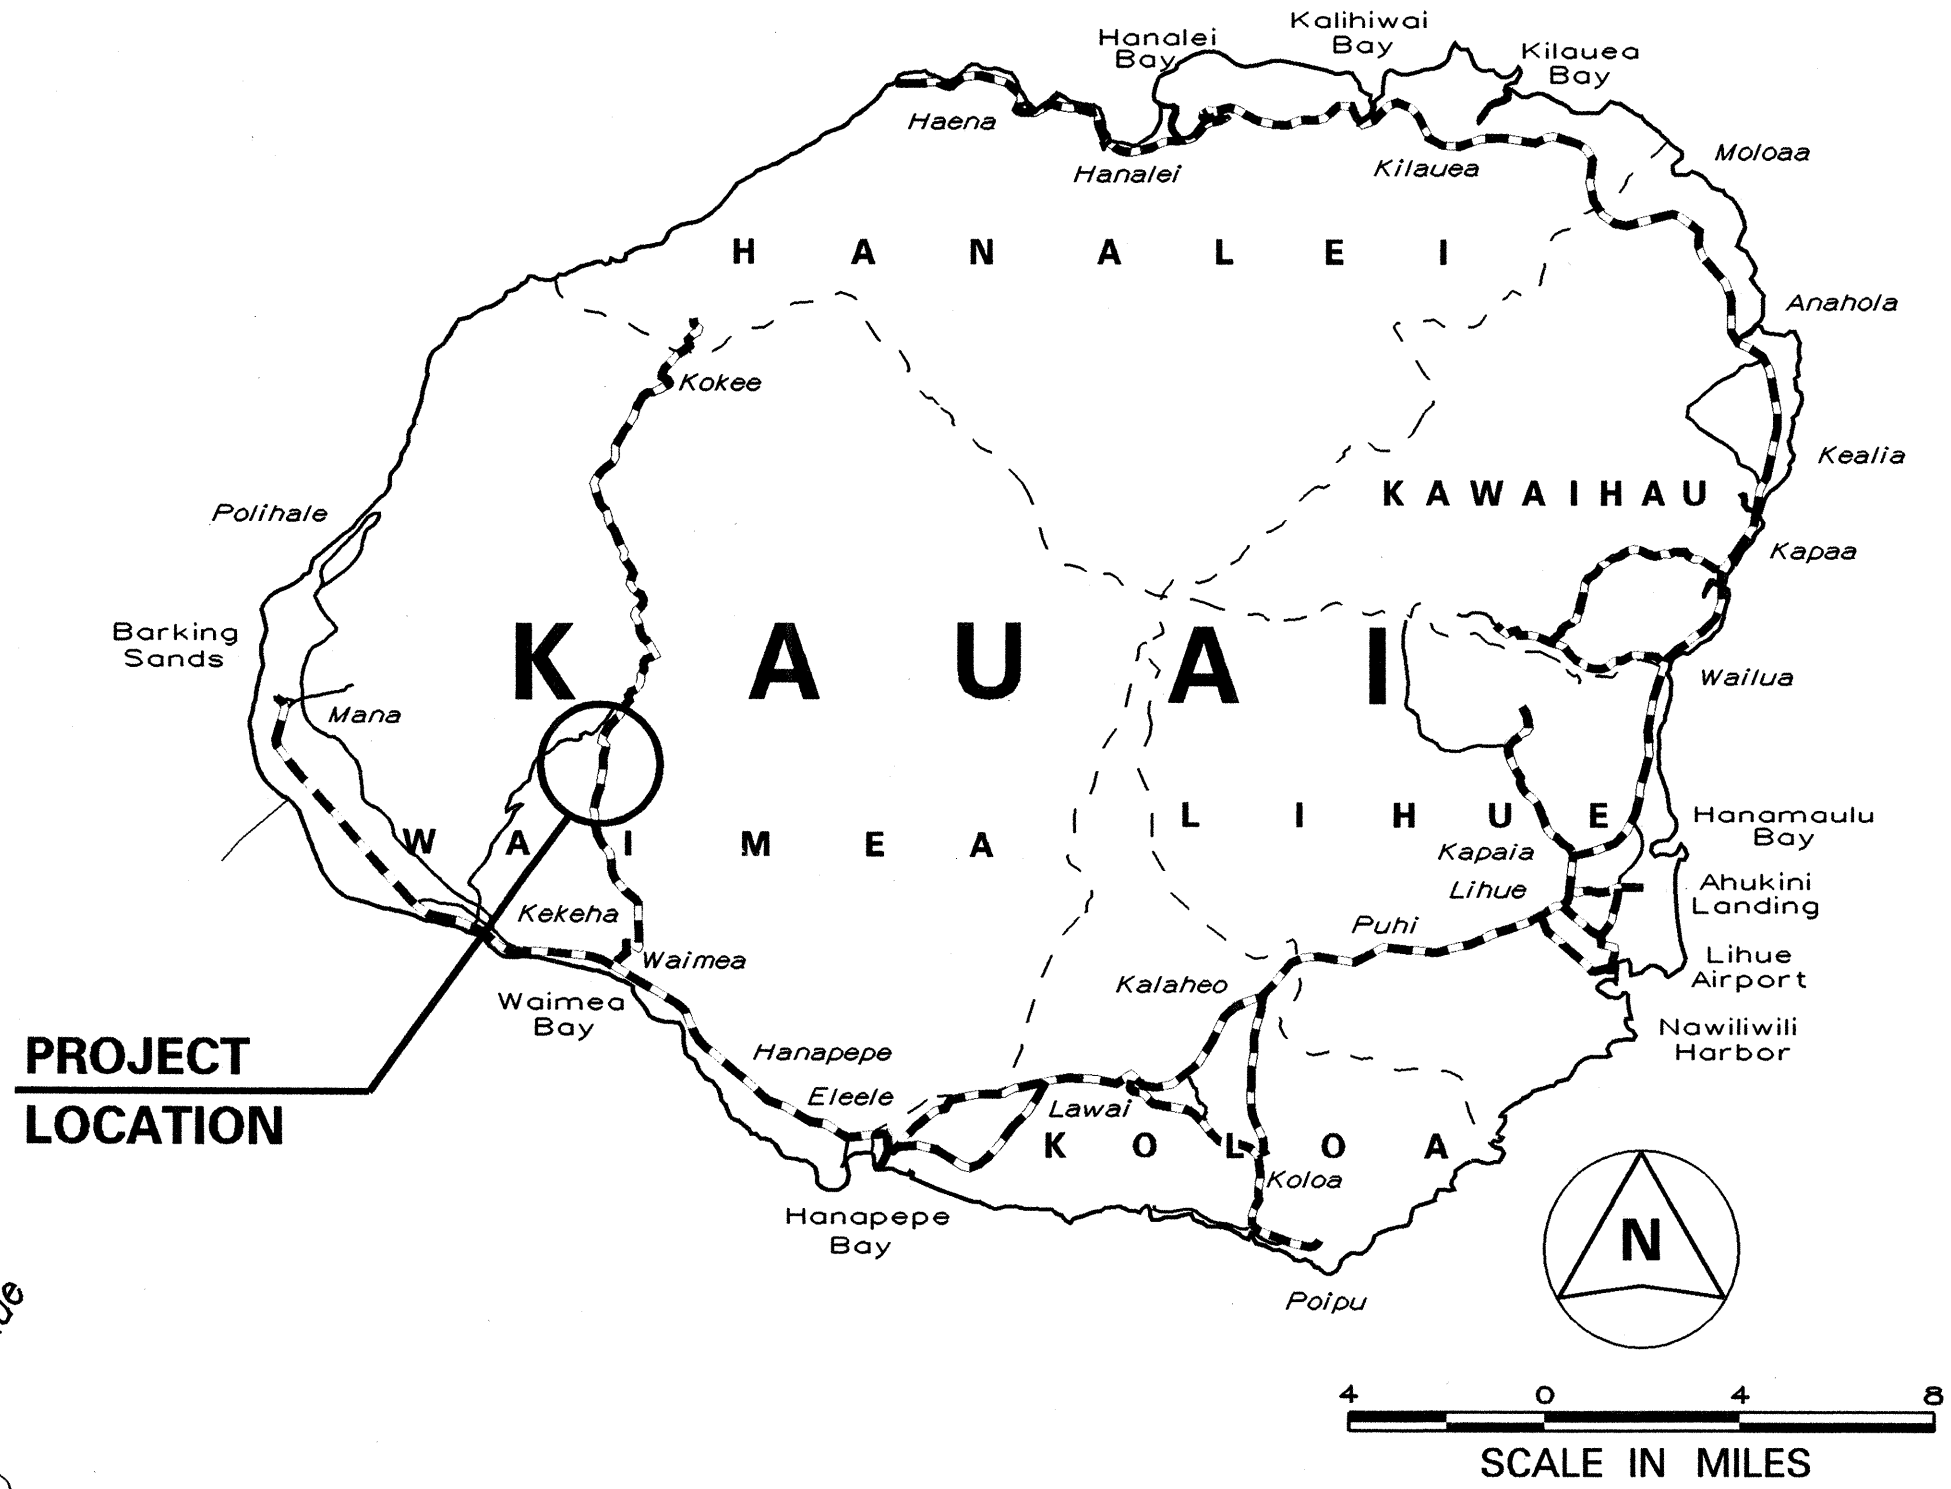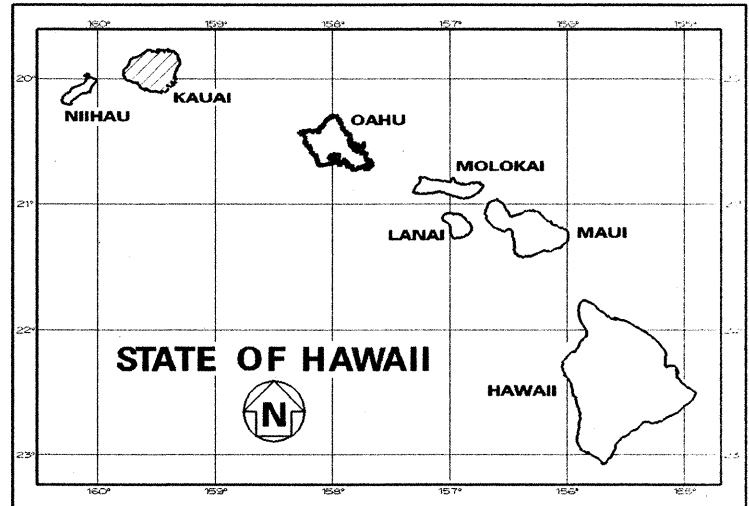

DESIGNED BY

STEVE MORIKAWA


274-3118

AUG. 2001

P. S. & E. BY

PHONE

DATE

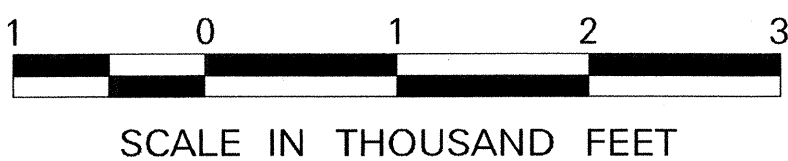

LAYOUT PLAN

GROSS LENGTH OF PROJECT.....1.02 MILES

NET LENGTH OF PROJECT.....1.02 MILES

FEDERAL AID PROJECTS PREVIOUSLY CONSTRUCTED OR UNDER CONSTRUCTION

MILE POST 4.98 TO MILE POST 6.00

CHANGES MADE DURING CONSTRUCTION HAVE BEEN INCORPORATED ON THESE PLANS EXCEPT CHANGES IN THE ORIGINAL THEORETICAL QUANTITIES. FOR ACTUAL QUANTITIES, REFER TO PROJECT LEDGER AND A COMPARISON BOX.

8-21-03

DATE

DEPARTMENT OF TRANSPORTATION

STATE OF HAWAII

APPROVED:

8/1/01

DATE