


FED. ROAD DIST. NO.	STATE	PROJ. NO.	FISCAL YEAR	SHEET NO.	TOTAL SHEETS
HAWAII	HAW.	550AB-01-06	2009	24	34

True North
Scale: 1"=40'

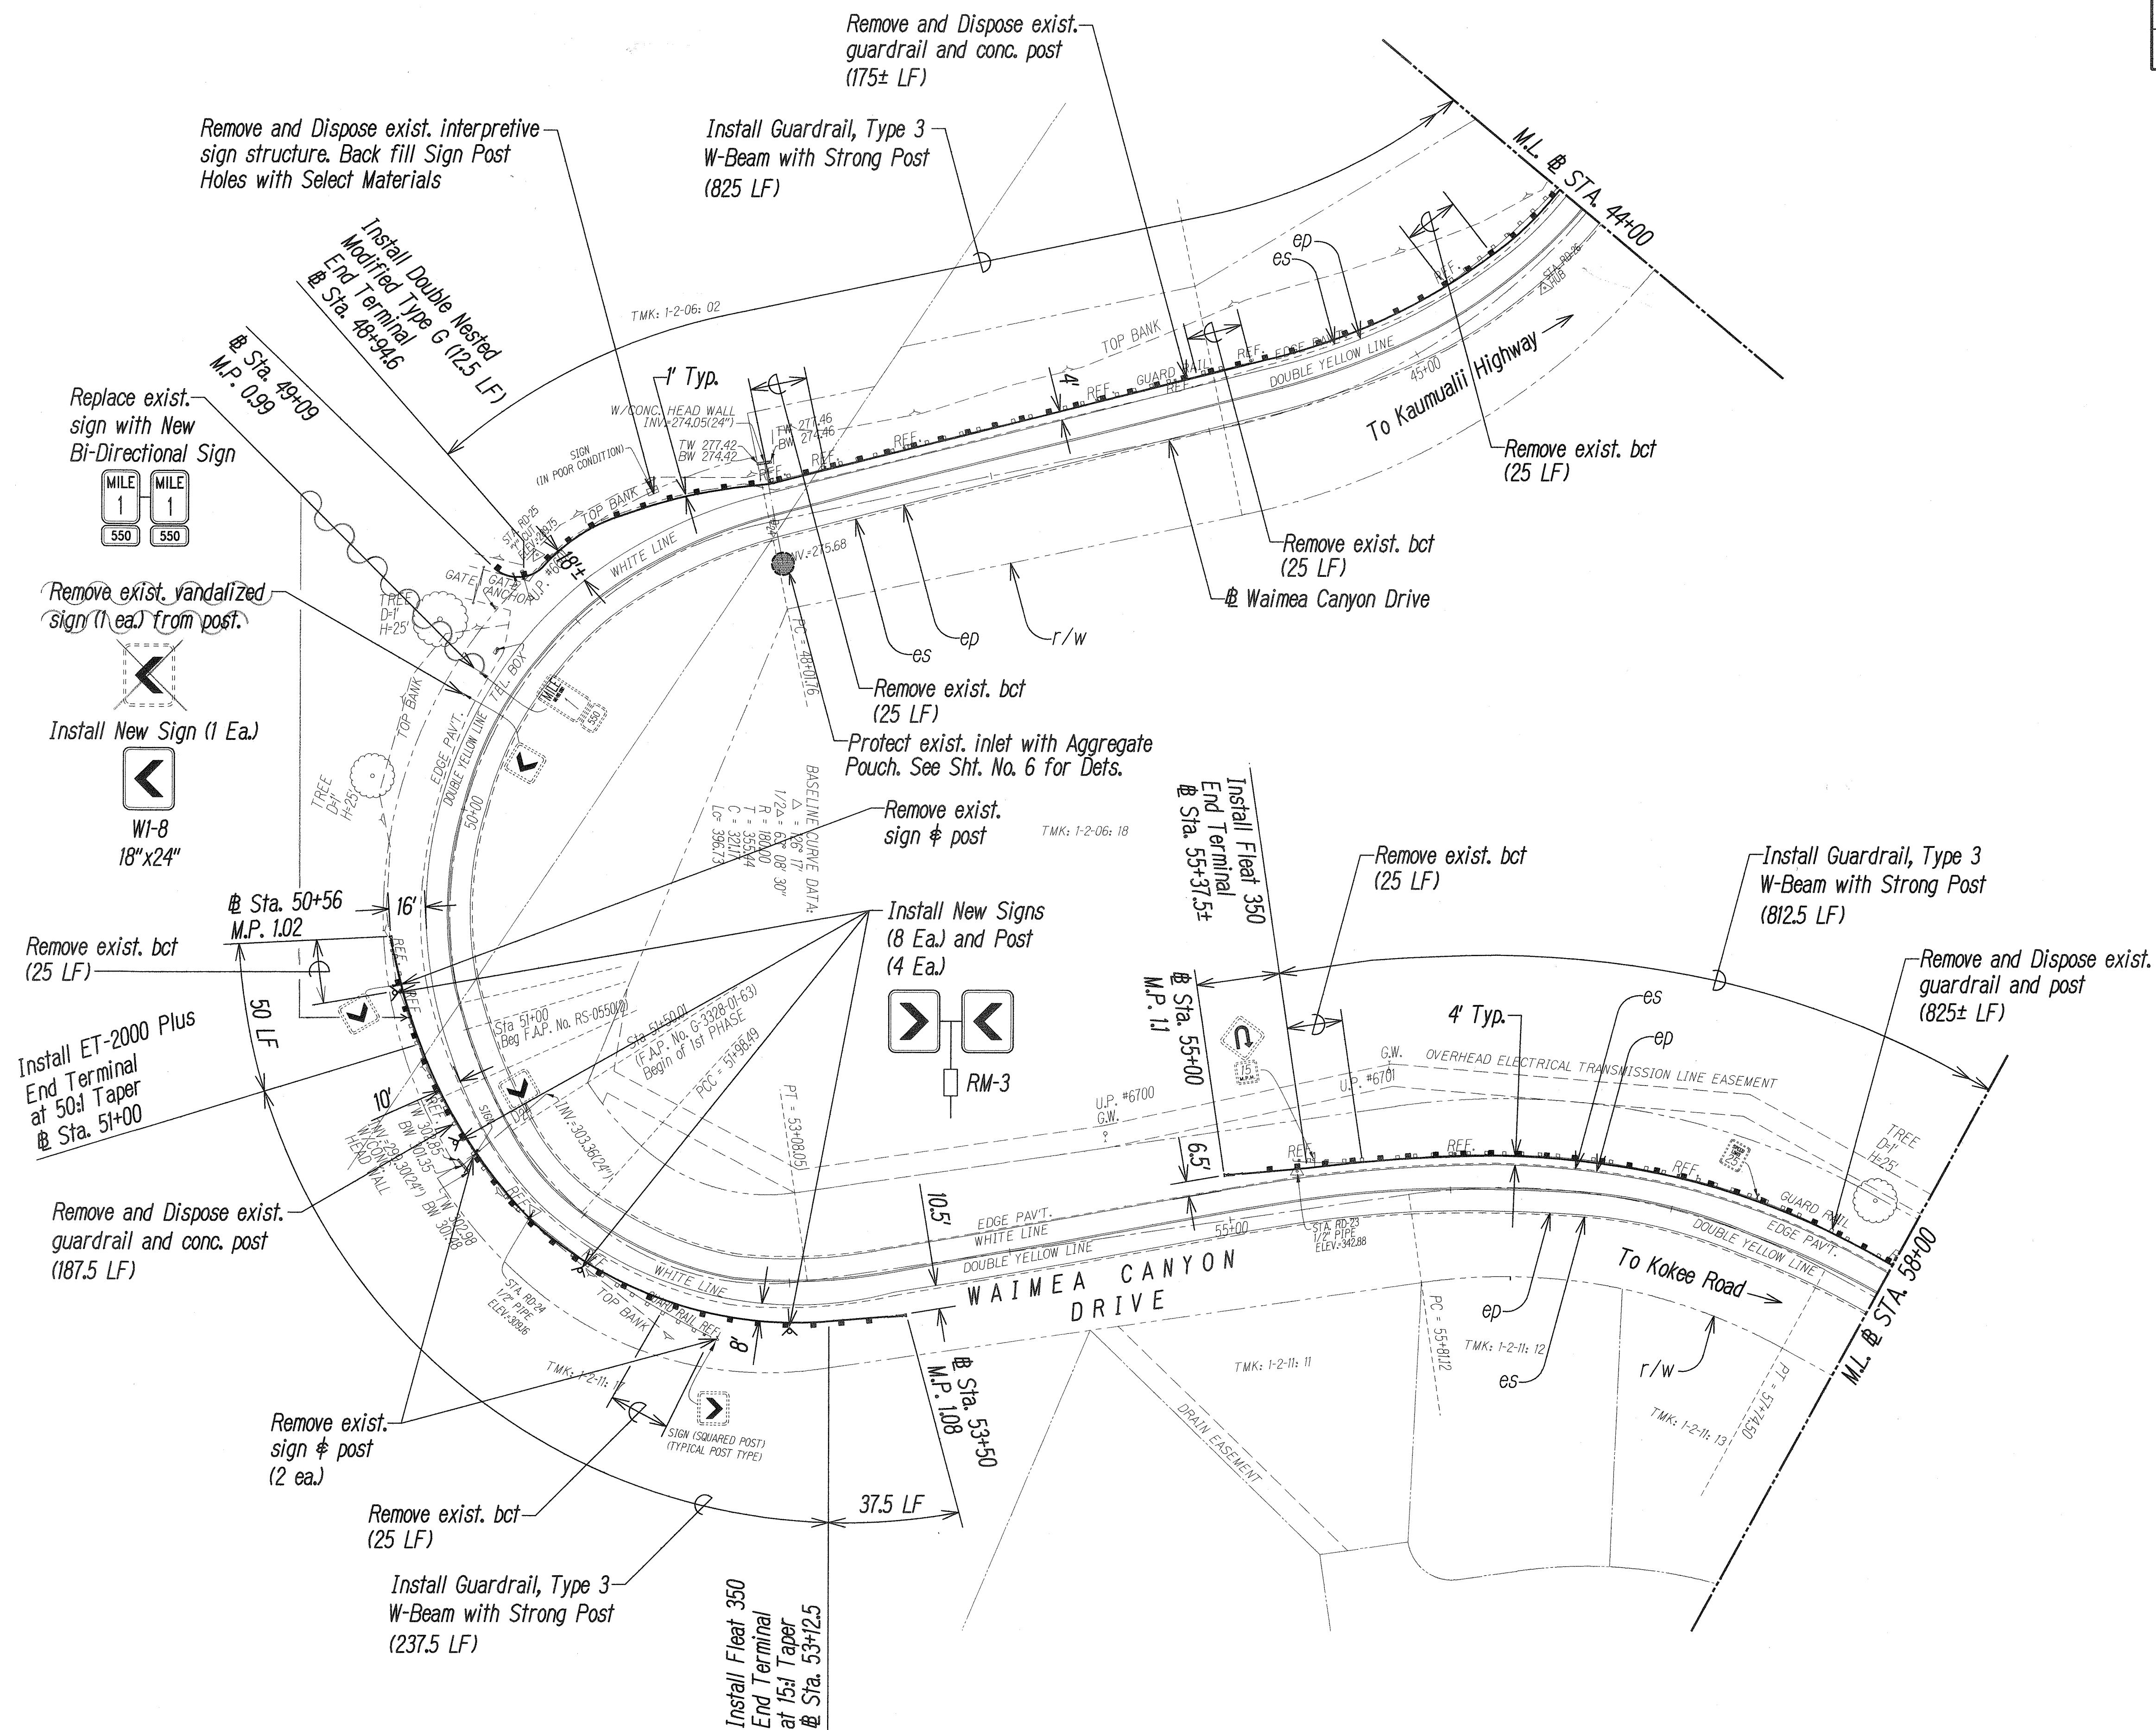

THIS WORK WAS PREPARED BY ME
OR UNDER MY SUPERVISION.

Mishkin

APRIL 30, 2010

WILSON OKAMOTO CORPORATION LIC. EXP. DATE

STATE OF HAWAII
DEPARTMENT OF TRANSPORTATION
HIGHWAYS DIVISION

ROADWAY PLAN

WAIMEA CANYON DRIVE/KOKEE ROAD
IMPROVEMENTS PHASE 1
MILE POST 0.80 TO MILE POST 4.60
Proj. No. 550AB-01-06

Scale: 1"=40'-0" Date: October 2008



SHEET No. 2 OF 10 SHEETS

"AS-BUILT"

24


ORIGINAL PLAN	SURVEY PLOTTED BY	DATE
	DRAWN BY	11
	TRACED BY	12
NOTE BOOK	DESIGNED BY	13
	QUANTITIES BY	14
	CHECKED BY	15

FED. ROAD DIST. NO.	STATE	PROJ. NO.	FISCAL YEAR	SHEET NO.	TOTAL SHEETS
HAWAII	HAW.	550AB-01-06	2009	27	34

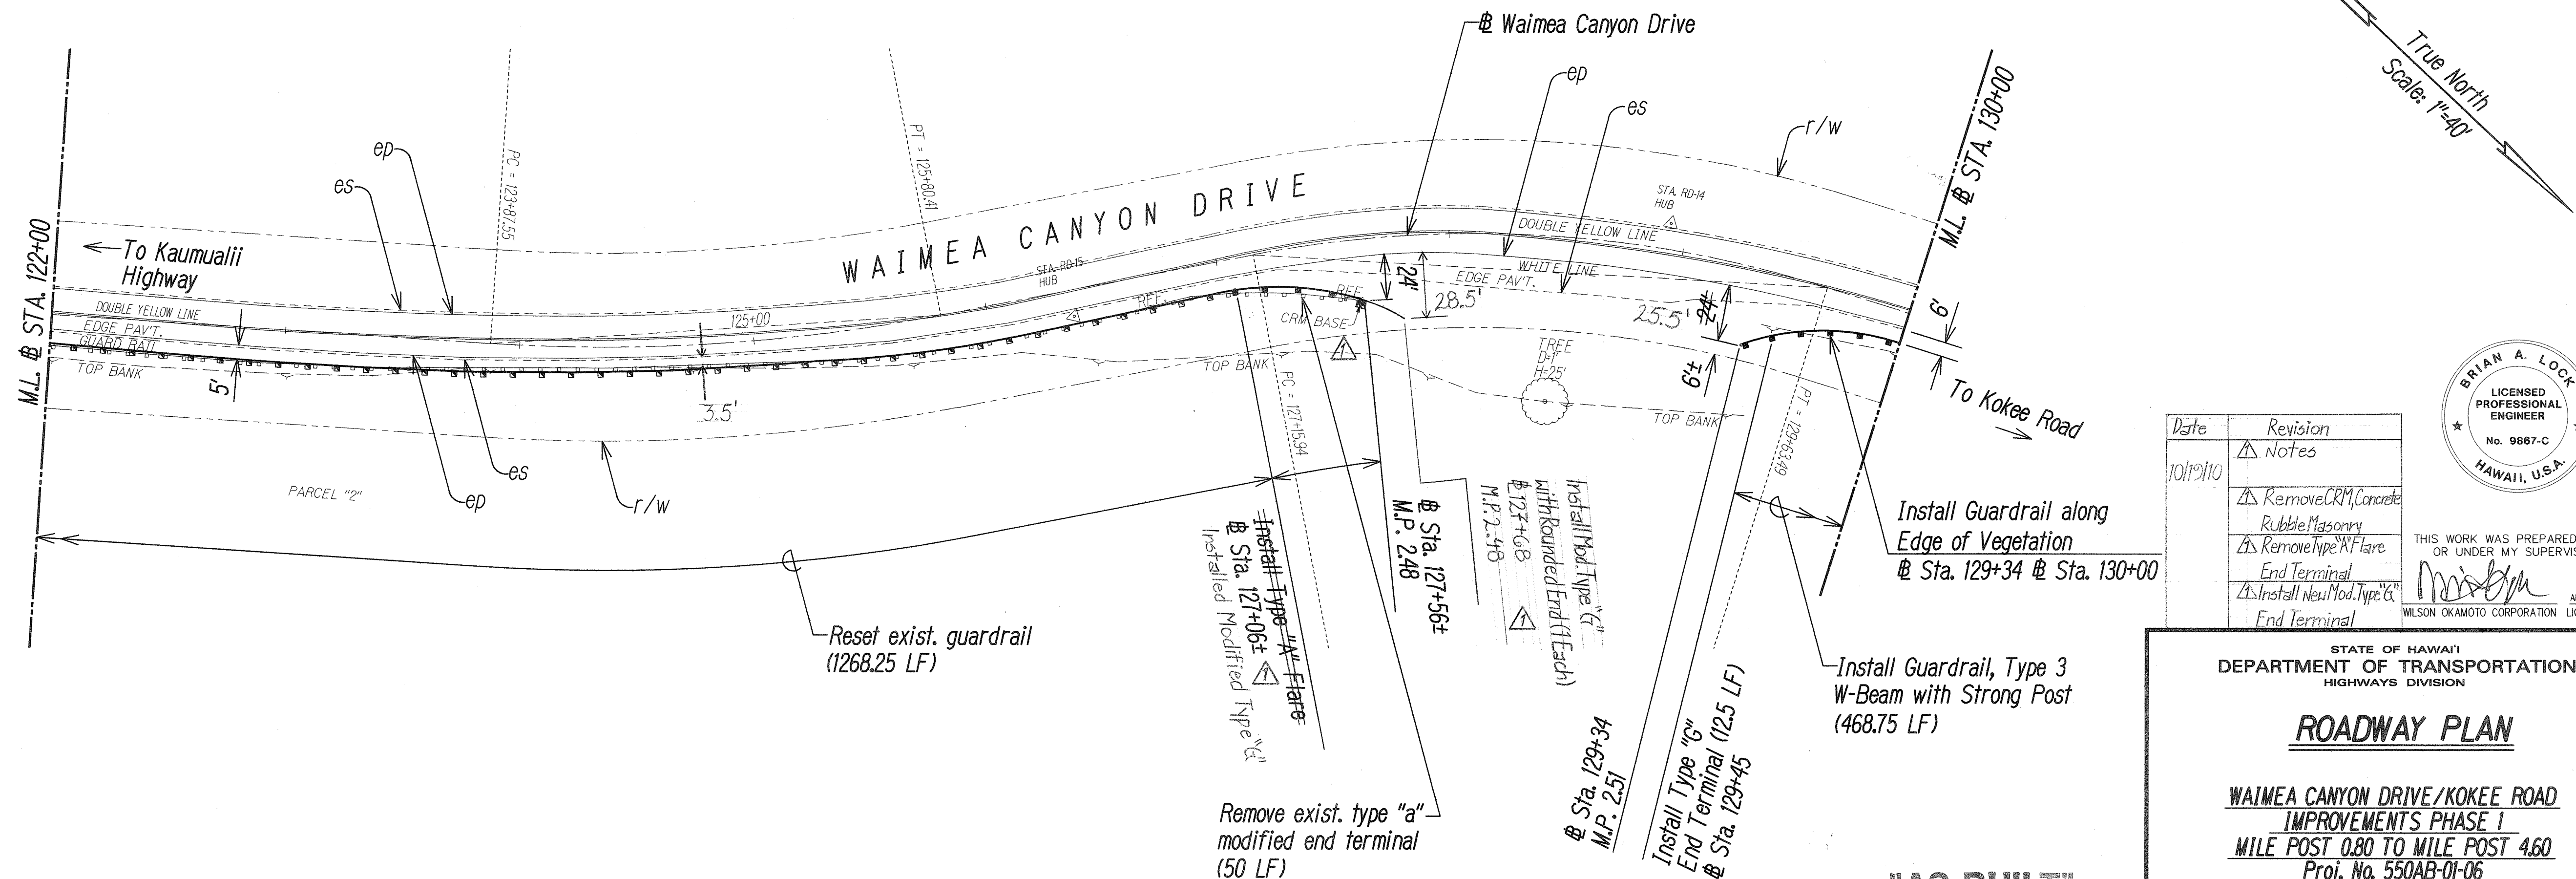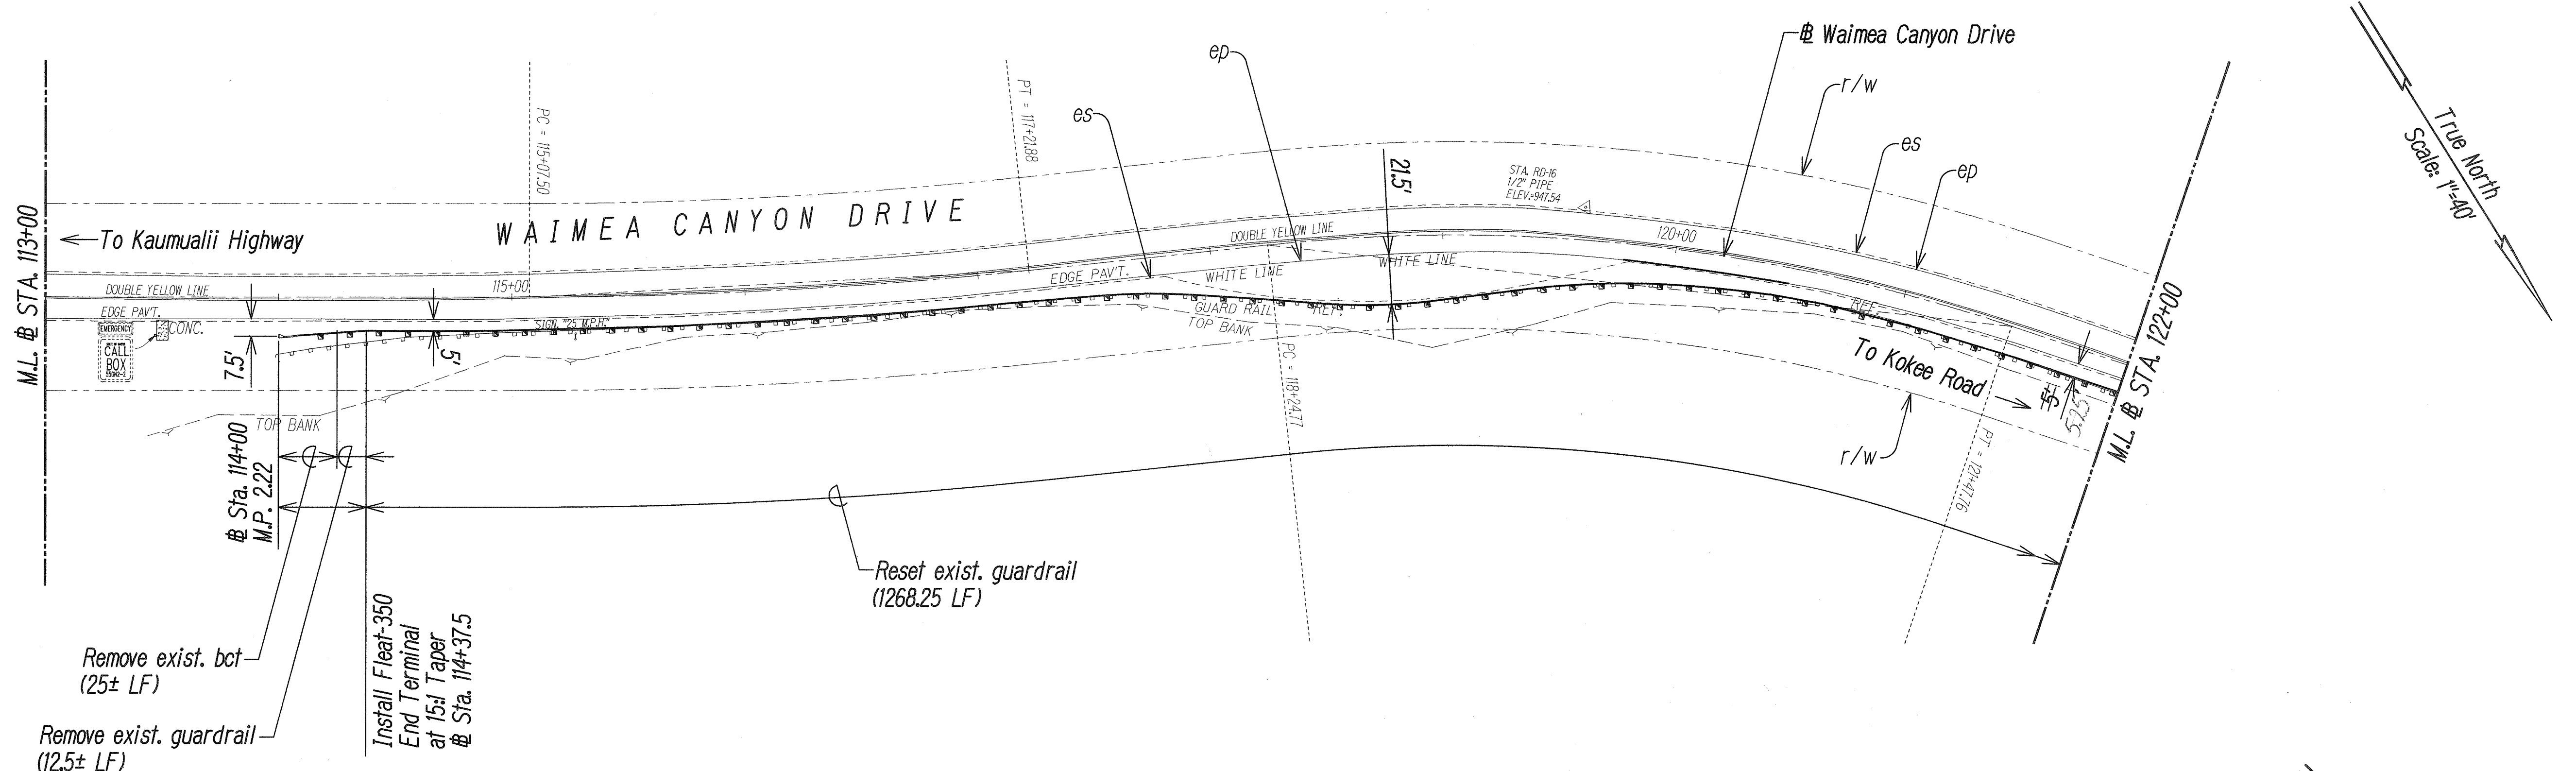

DATE	10/10/10
DESIGNED BY	WILSON OKAMOTO CORPORATION
CHECKED BY	WILSON OKAMOTO CORPORATION
QUANTITIES BY	WILSON OKAMOTO CORPORATION
NOTED BY	WILSON OKAMOTO CORPORATION
PLANNED BY	WILSON OKAMOTO CORPORATION
ORIGINAL PLAN	WILSON OKAMOTO CORPORATION

Date	Revision
10/10/10	Notes
	Remove CRM Concrete
	Rubble Masonry
	Remove Type A Flare
	End Terminal
	Install New Modified Type A
	End Terminal

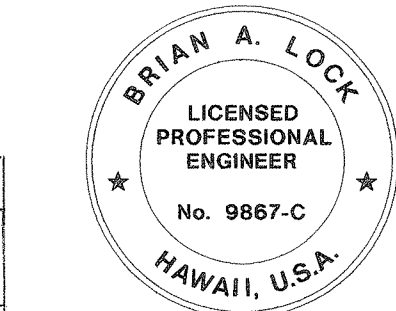

THIS WORK WAS PREPARED BY ME OR UNDER MY SUPERVISION.

Brian A. Lock

WILSON OKAMOTO CORPORATION LIC. EXP. DATE

STATE OF HAWAII
DEPARTMENT OF TRANSPORTATION
HIGHWAYS DIVISION



ROADWAY PLAN

WAIMEA CANYON DRIVE/KOKEE ROAD
IMPROVEMENTS PHASE I
MILE POST 0.80 TO MILE POST 4.60
Proj. No. 550AB-01-06

Scale: 1"=40'-0" Date: October 2008

SHEET No. 5 OF 10 SHEETS

FED. ROAD DIST. NO.	STATE	PROJ. NO.	FISCAL YEAR	SHEET NO.	TOTAL SHEETS
HAWAII	HAW.	550AB-01-06	2009	28	34

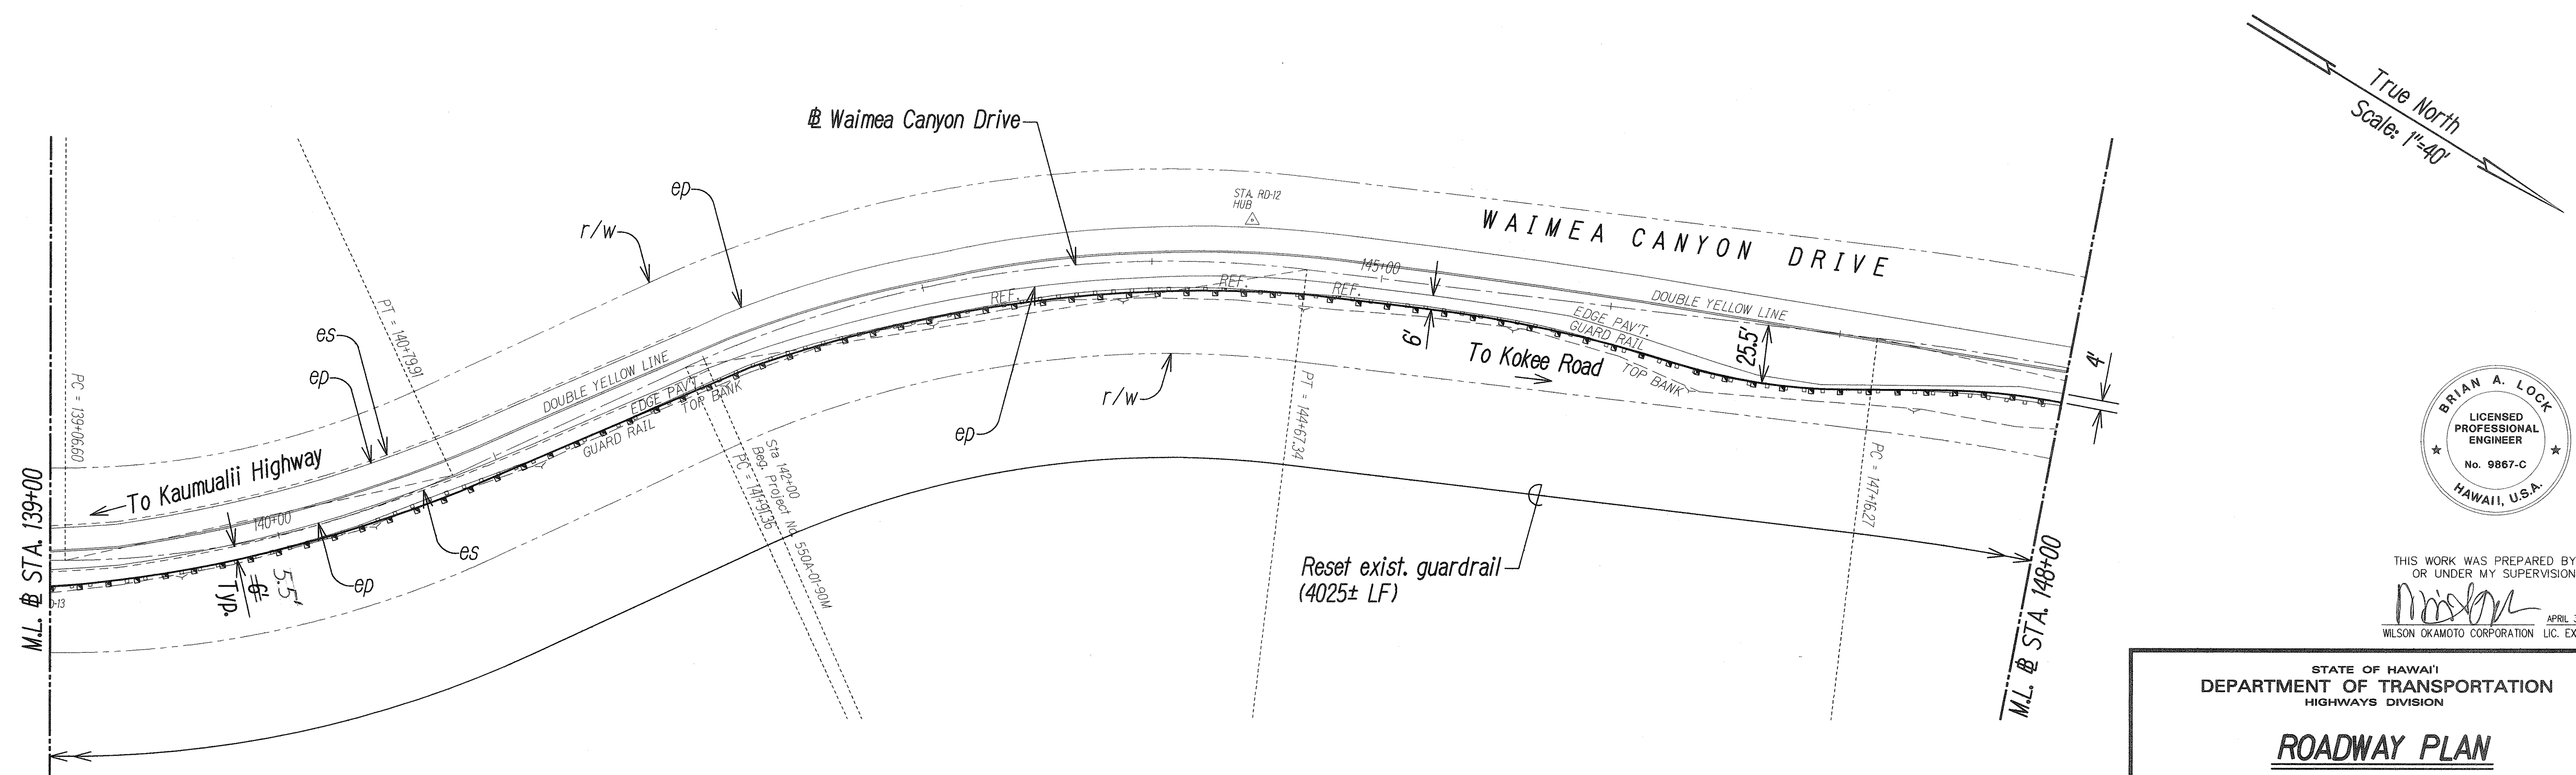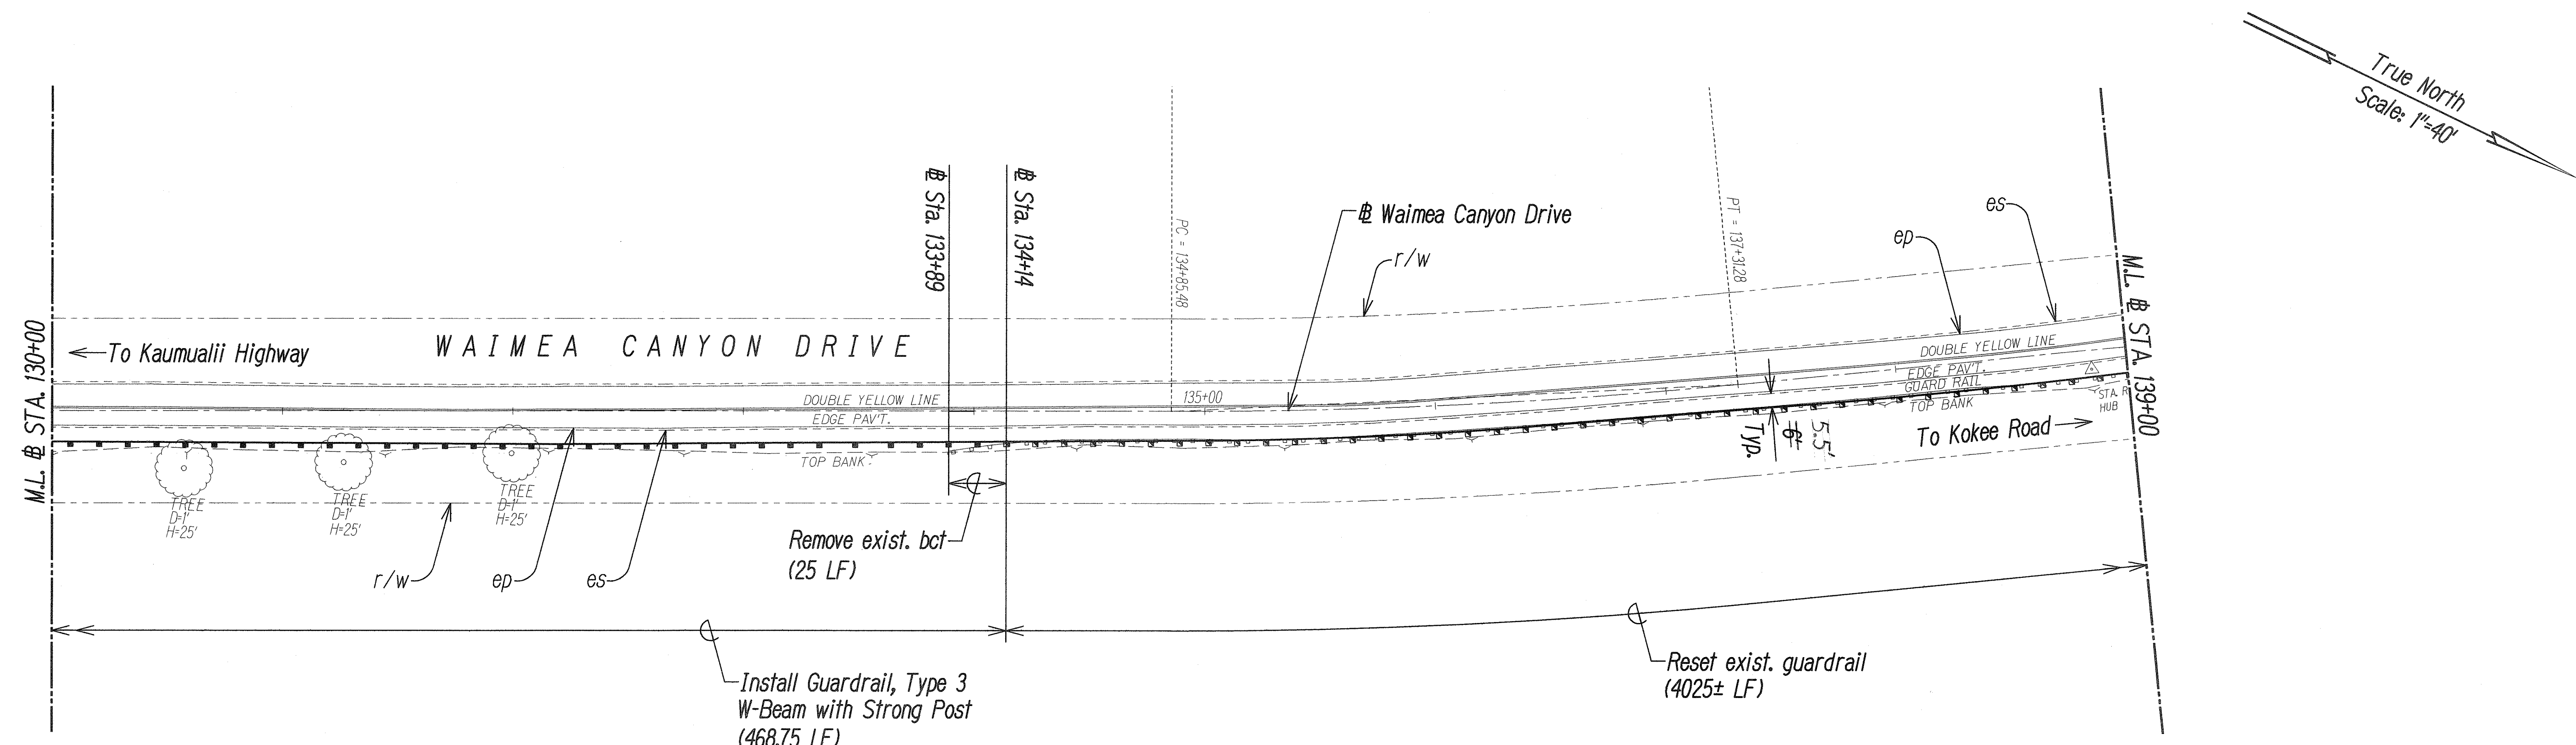

DATE	10/10/08
DESIGNED BY	WILSON OKAMOTO CORPORATION
CHECKED BY	WILSON OKAMOTO CORPORATION
NOTED BY	WILSON OKAMOTO CORPORATION
PLANNED BY	WILSON OKAMOTO CORPORATION
APPROVED BY	WILSON OKAMOTO CORPORATION



THIS WORK WAS PREPARED BY ME OR UNDER MY SUPERVISION.

Wilson

APRIL 30, 2010

WILSON OKAMOTO CORPORATION LIC. EXP. DATE

STATE OF HAWAII
DEPARTMENT OF TRANSPORTATION
HIGHWAYS DIVISION

ROADWAY PLAN

WAIMEA CANYON DRIVE/KOKEE ROAD
IMPROVEMENTS PHASE I
MILE POST 0.80 TO MILE POST 4.60
Proj. No. 550AB-01-06

Scale: 1"=40'-0" Date: October 2008



SHEET No. 6 OF 10 SHEETS

"AS-BUILT"

FED. ROAD DIST. NO.	STATE	PROJ. NO.	FISCAL YEAR	SHEET NO.	TOTAL SHEETS
HAWAII	HAW.	550AB-01-06	2009	29	34


Protect exist. inlet with Aggregate Pouch. See Sht. No. 6 for Dets.

True North
Scale: 1"=40'

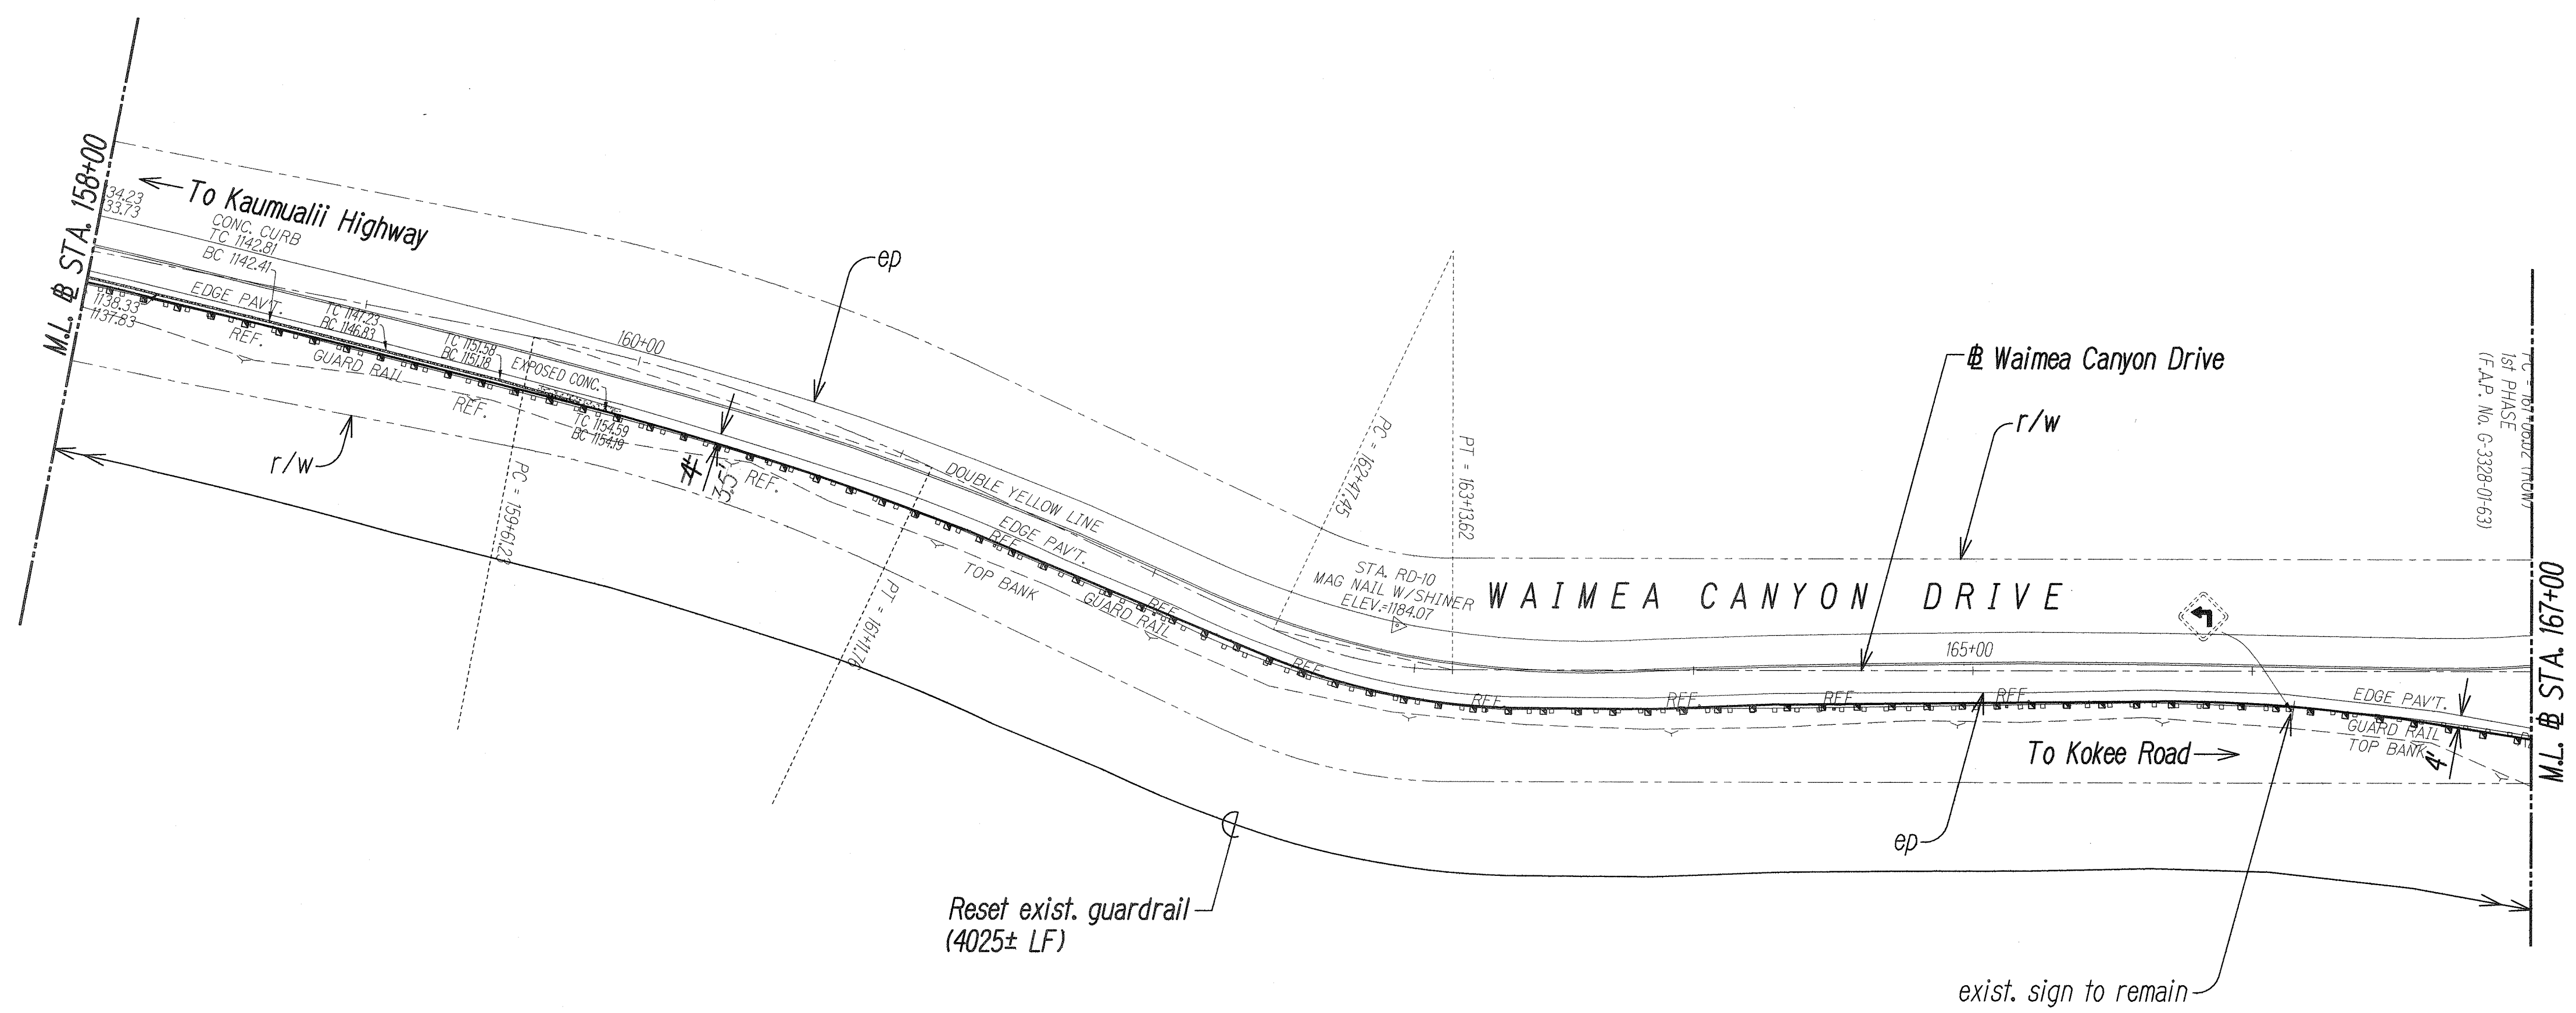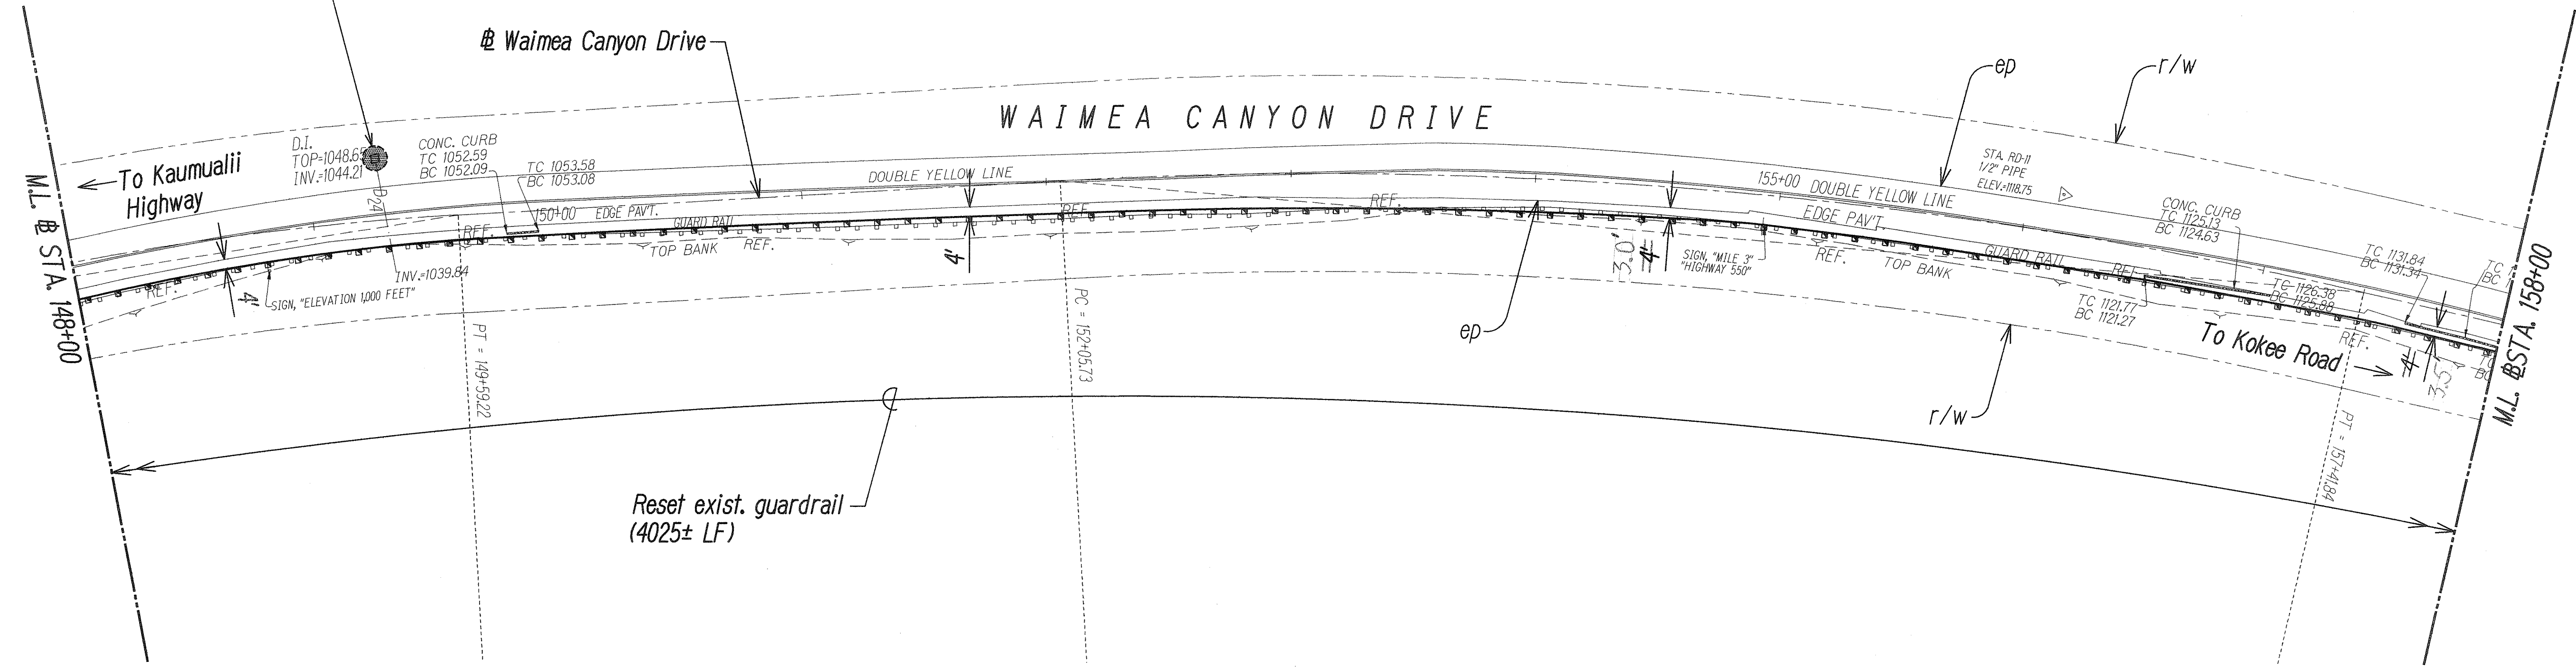

True North
Scale: 1"=40'

DATE	DESIGNED BY	CHECKED BY
	REVIEWED BY	
	NOTED BY	
	QUANTITIES BY	
	CHECKED BY	

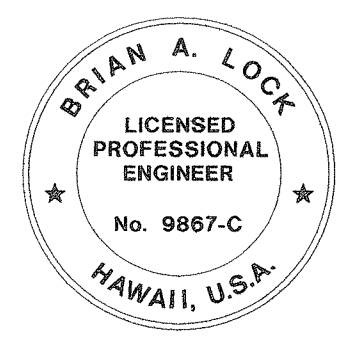

THIS WORK WAS PREPARED BY ME OR UNDER MY SUPERVISION.
WILSON OKAMOTO CORPORATION
APRIL 30, 2010
LIC. EXP. DATE



STATE OF HAWAII
DEPARTMENT OF TRANSPORTATION
HIGHWAYS DIVISION

ROADWAY PLAN


**WAIMEA CANYON DRIVE/KOKEE ROAD
IMPROVEMENTS PHASE I
MILE POST 0.80 TO MILE POST 4.60
Proj. No. 550AB-01-06**
Scale: 1"=40'-0" Date: October 2008
SHEET No. 7 OF 10 SHEETS

"AS-BUILT"

FED. ROAD DIST. NO.	STATE	PROJ. NO.	FISCAL YEAR	SHEET NO.	TOTAL SHEETS
HAWAII	HAW.	550AB-01-06	2009	30	34

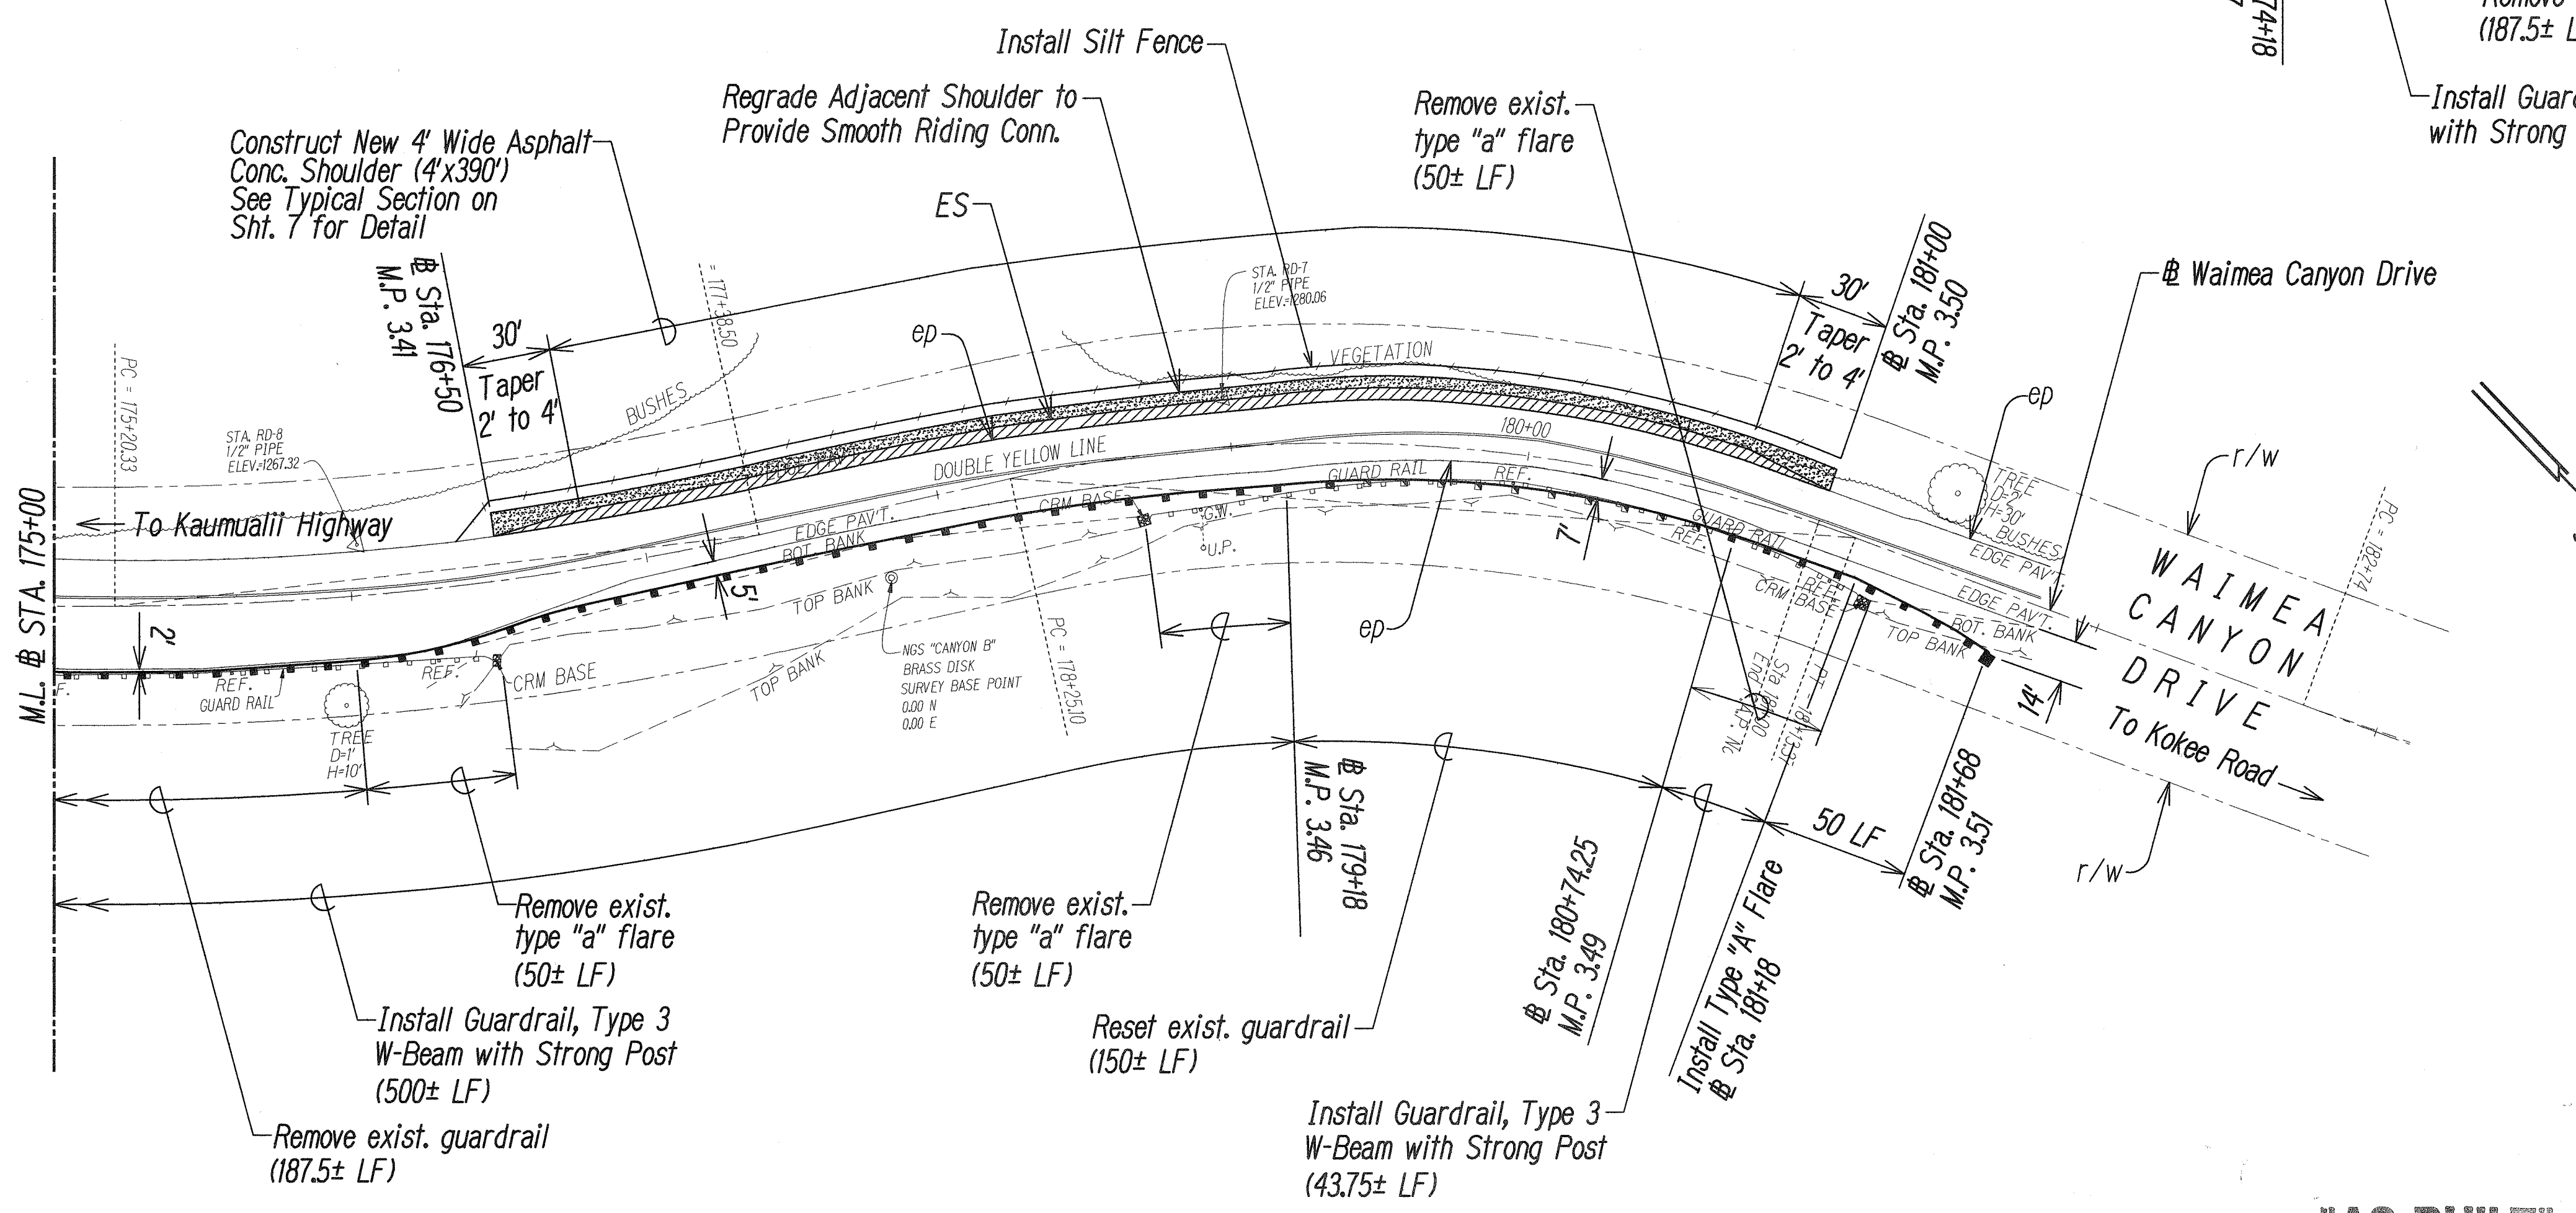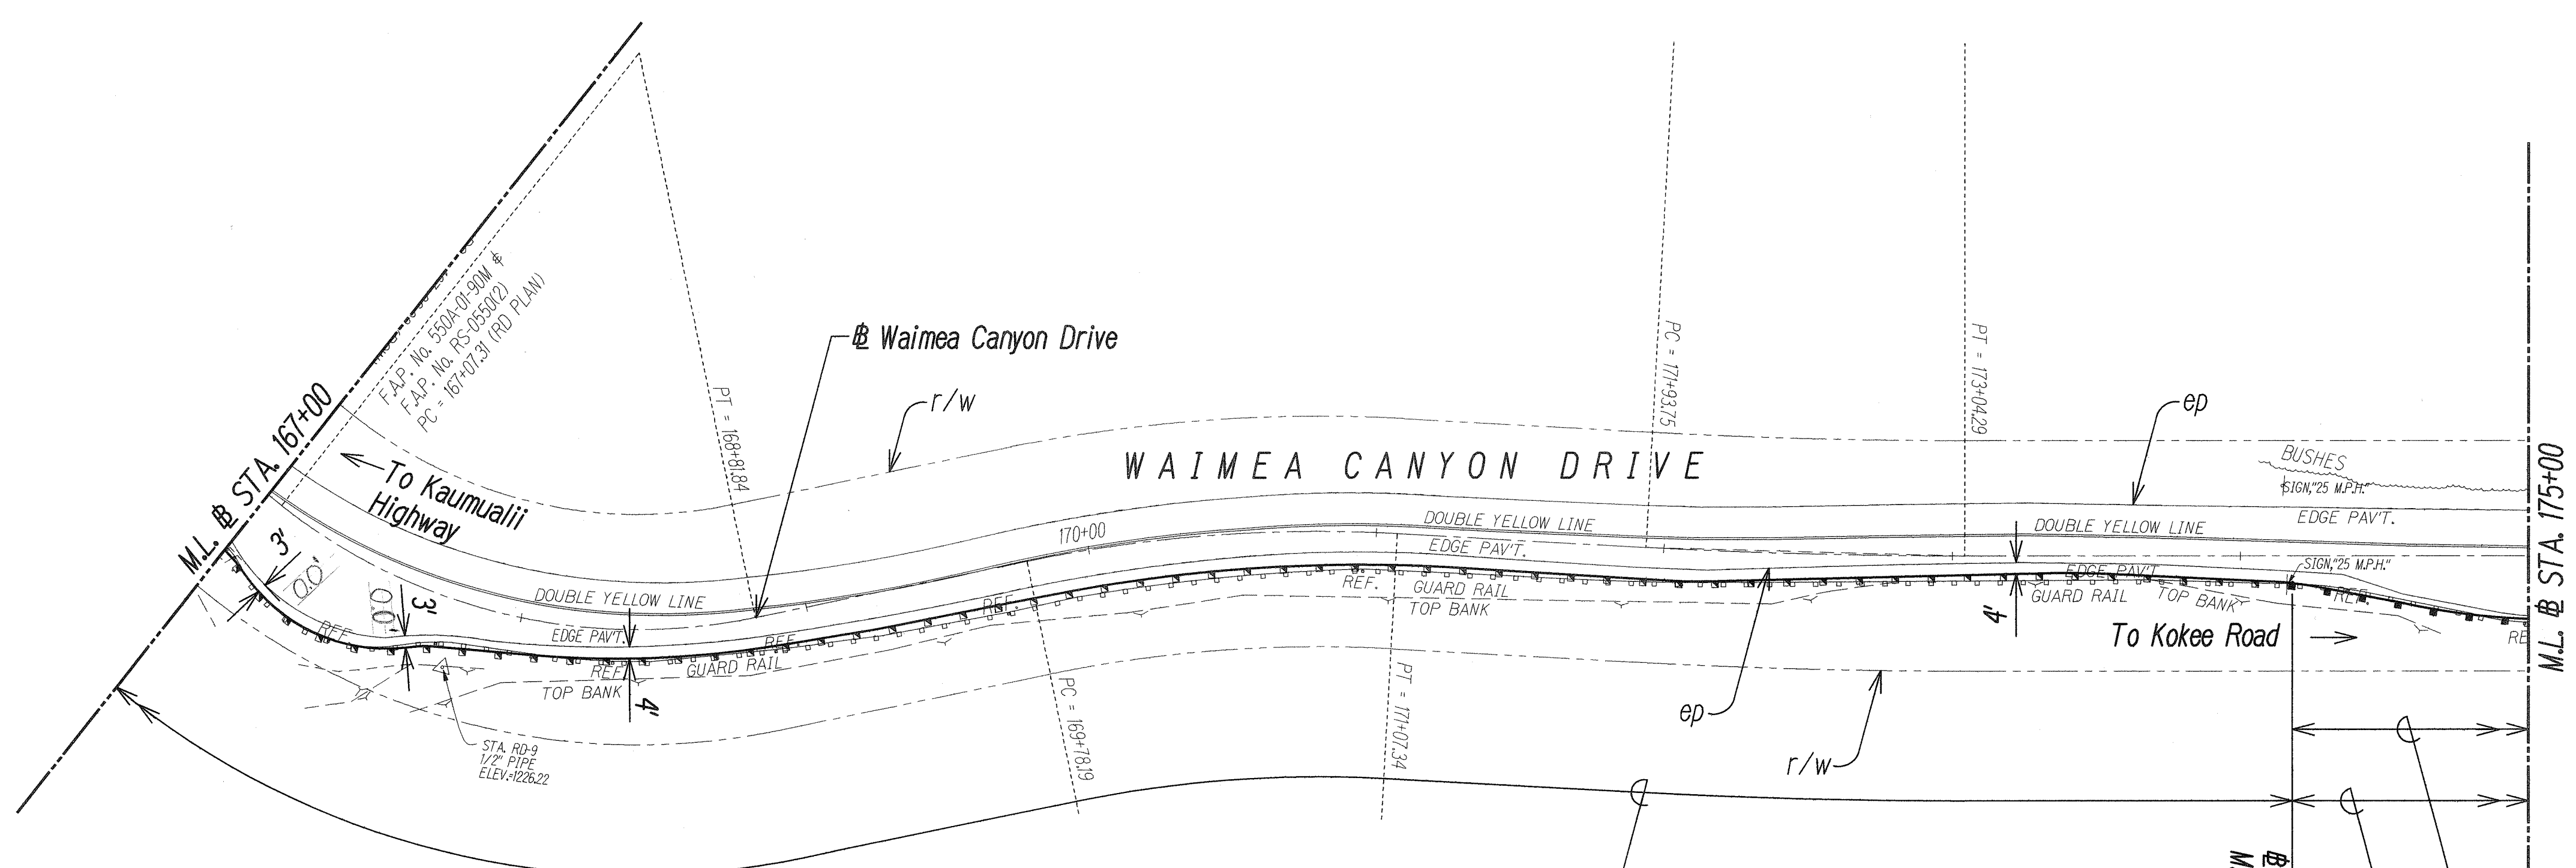

SURVEY PLOTTED BY	DATE
DESIGNED BY	
FLALED BY	
QUANTITIES BY	
CHECKED BY	
ORIGINAL PLAN	
NOTE BOOK	
No.	500/01/02/00

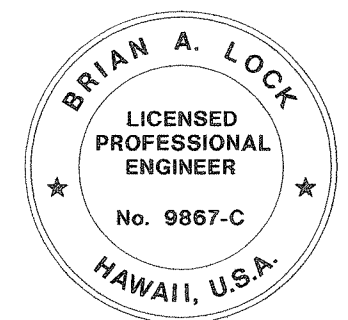

THIS WORK WAS PREPARED BY ME OR UNDER MY SUPERVISION.
Brian A. Lock
 WILSON OKAMOTO CORPORATION APRIL 30, 2010 LIC. EXP. DATE

STATE OF HAWAII
DEPARTMENT OF TRANSPORTATION
HIGHWAYS DIVISION

ROADWAY PLAN

WAIMEA CANYON DRIVE/KOKEE ROAD
IMPROVEMENTS PHASE 1
MILE POST 0.80 TO MILE POST 4.60
Proj. No. 550AB-01-06


Scale: 1"=40'-0" Date: October 2008

SHEET No. 8 OF 10 SHEETS

"AS-BUILT"


FED. ROAD DIST. NO.	STATE	PROJ. NO.	FISCAL YEAR	SHEET NO.	TOTAL SHEETS
HAWAII	HAW.	550AB-01-06	2009	31	34

True North
Scale: 1"=40'

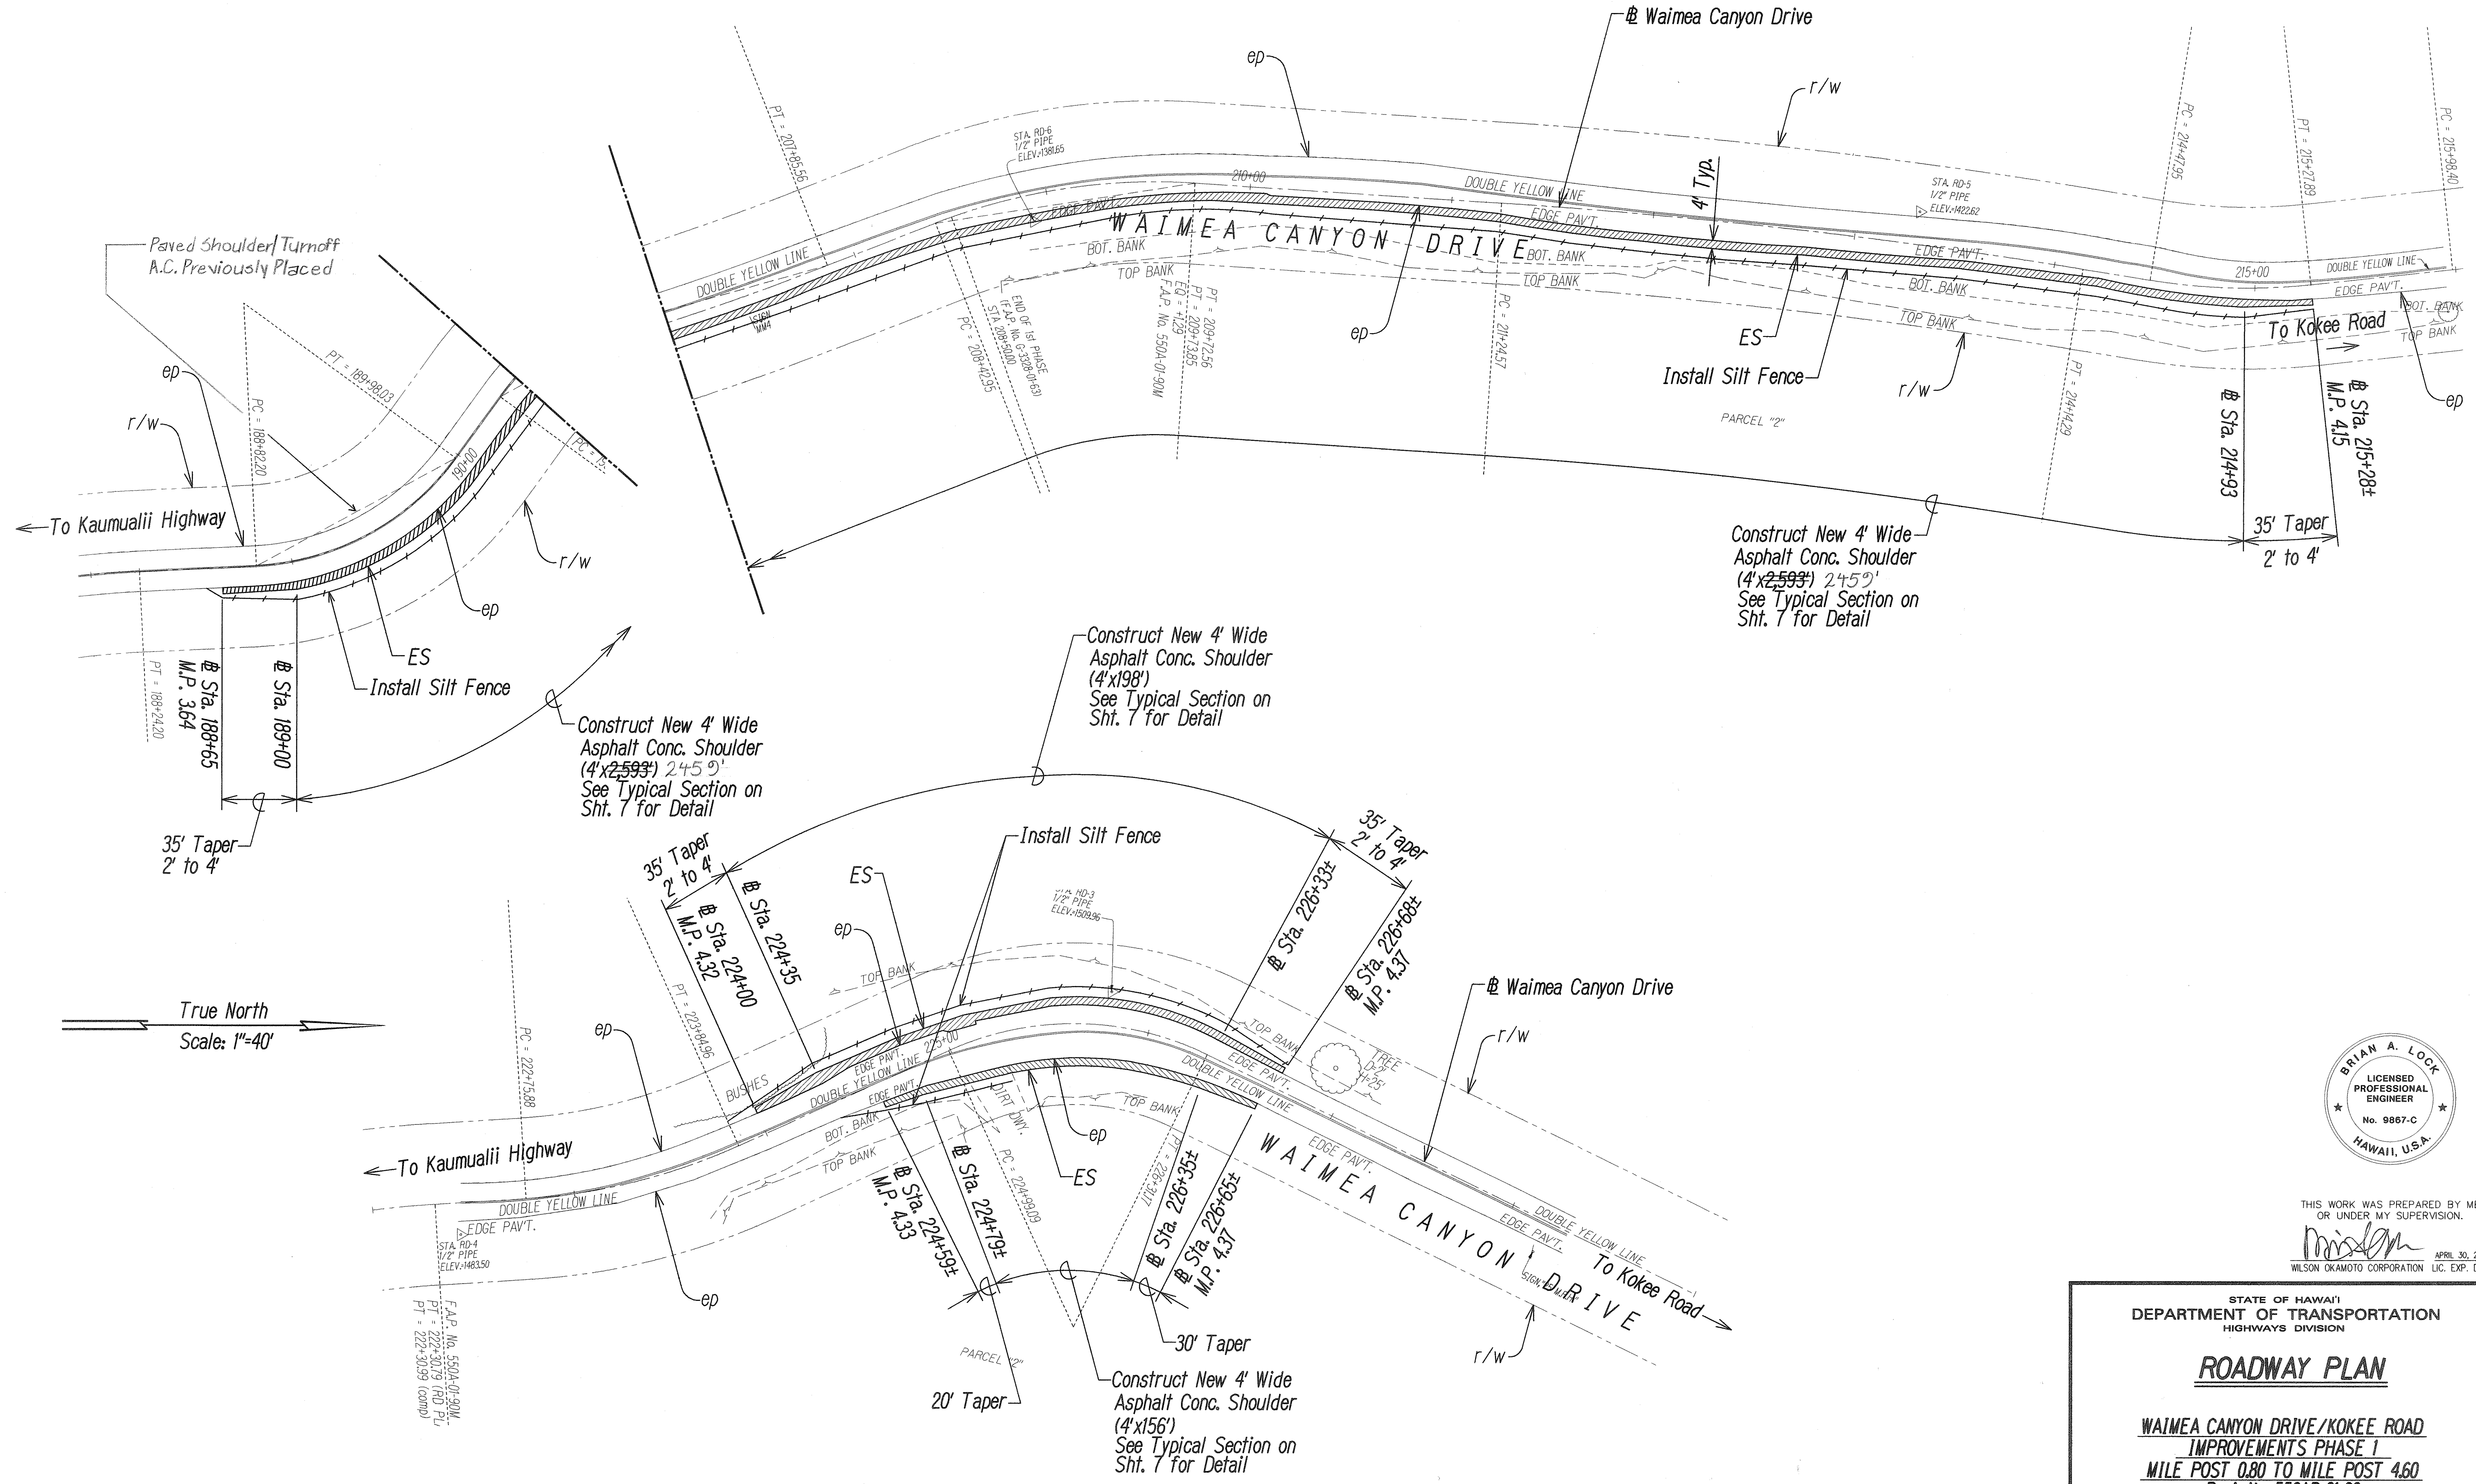

True North
Scale: 1"=40'

DESIGNED BY	DATE
CHECKED BY	
QUANTITIES BY	
NOTED BY	
ORIGINAL PLAN	

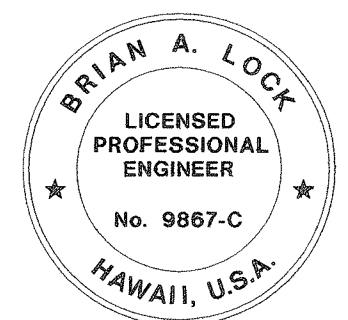

THIS WORK WAS PREPARED BY ME
OR UNDER MY SUPERVISION.
Wilson
WILSON OKAMOTO CORPORATION LIC. EXP. DATE

STATE OF HAWAII
DEPARTMENT OF TRANSPORTATION
HIGHWAYS DIVISION

ROADWAY PLAN


WAIMEA CANYON DRIVE/KOKEE ROAD
IMPROVEMENTS PHASE 1
MILE POST 0.80 TO MILE POST 4.60
Proj. No. 550AB-01-06

Scale: 1"=40'-0" Date: October 2008


SHEET No. 9 OF 10 SHEETS

"AS-BUILT"

FED. ROAD DIST. NO.	STATE	PROJ. NO.	FISCAL YEAR	SHEET NO.	TOTAL SHEETS
HAWAII	HAW.	550AB-01-06	2009	32	34

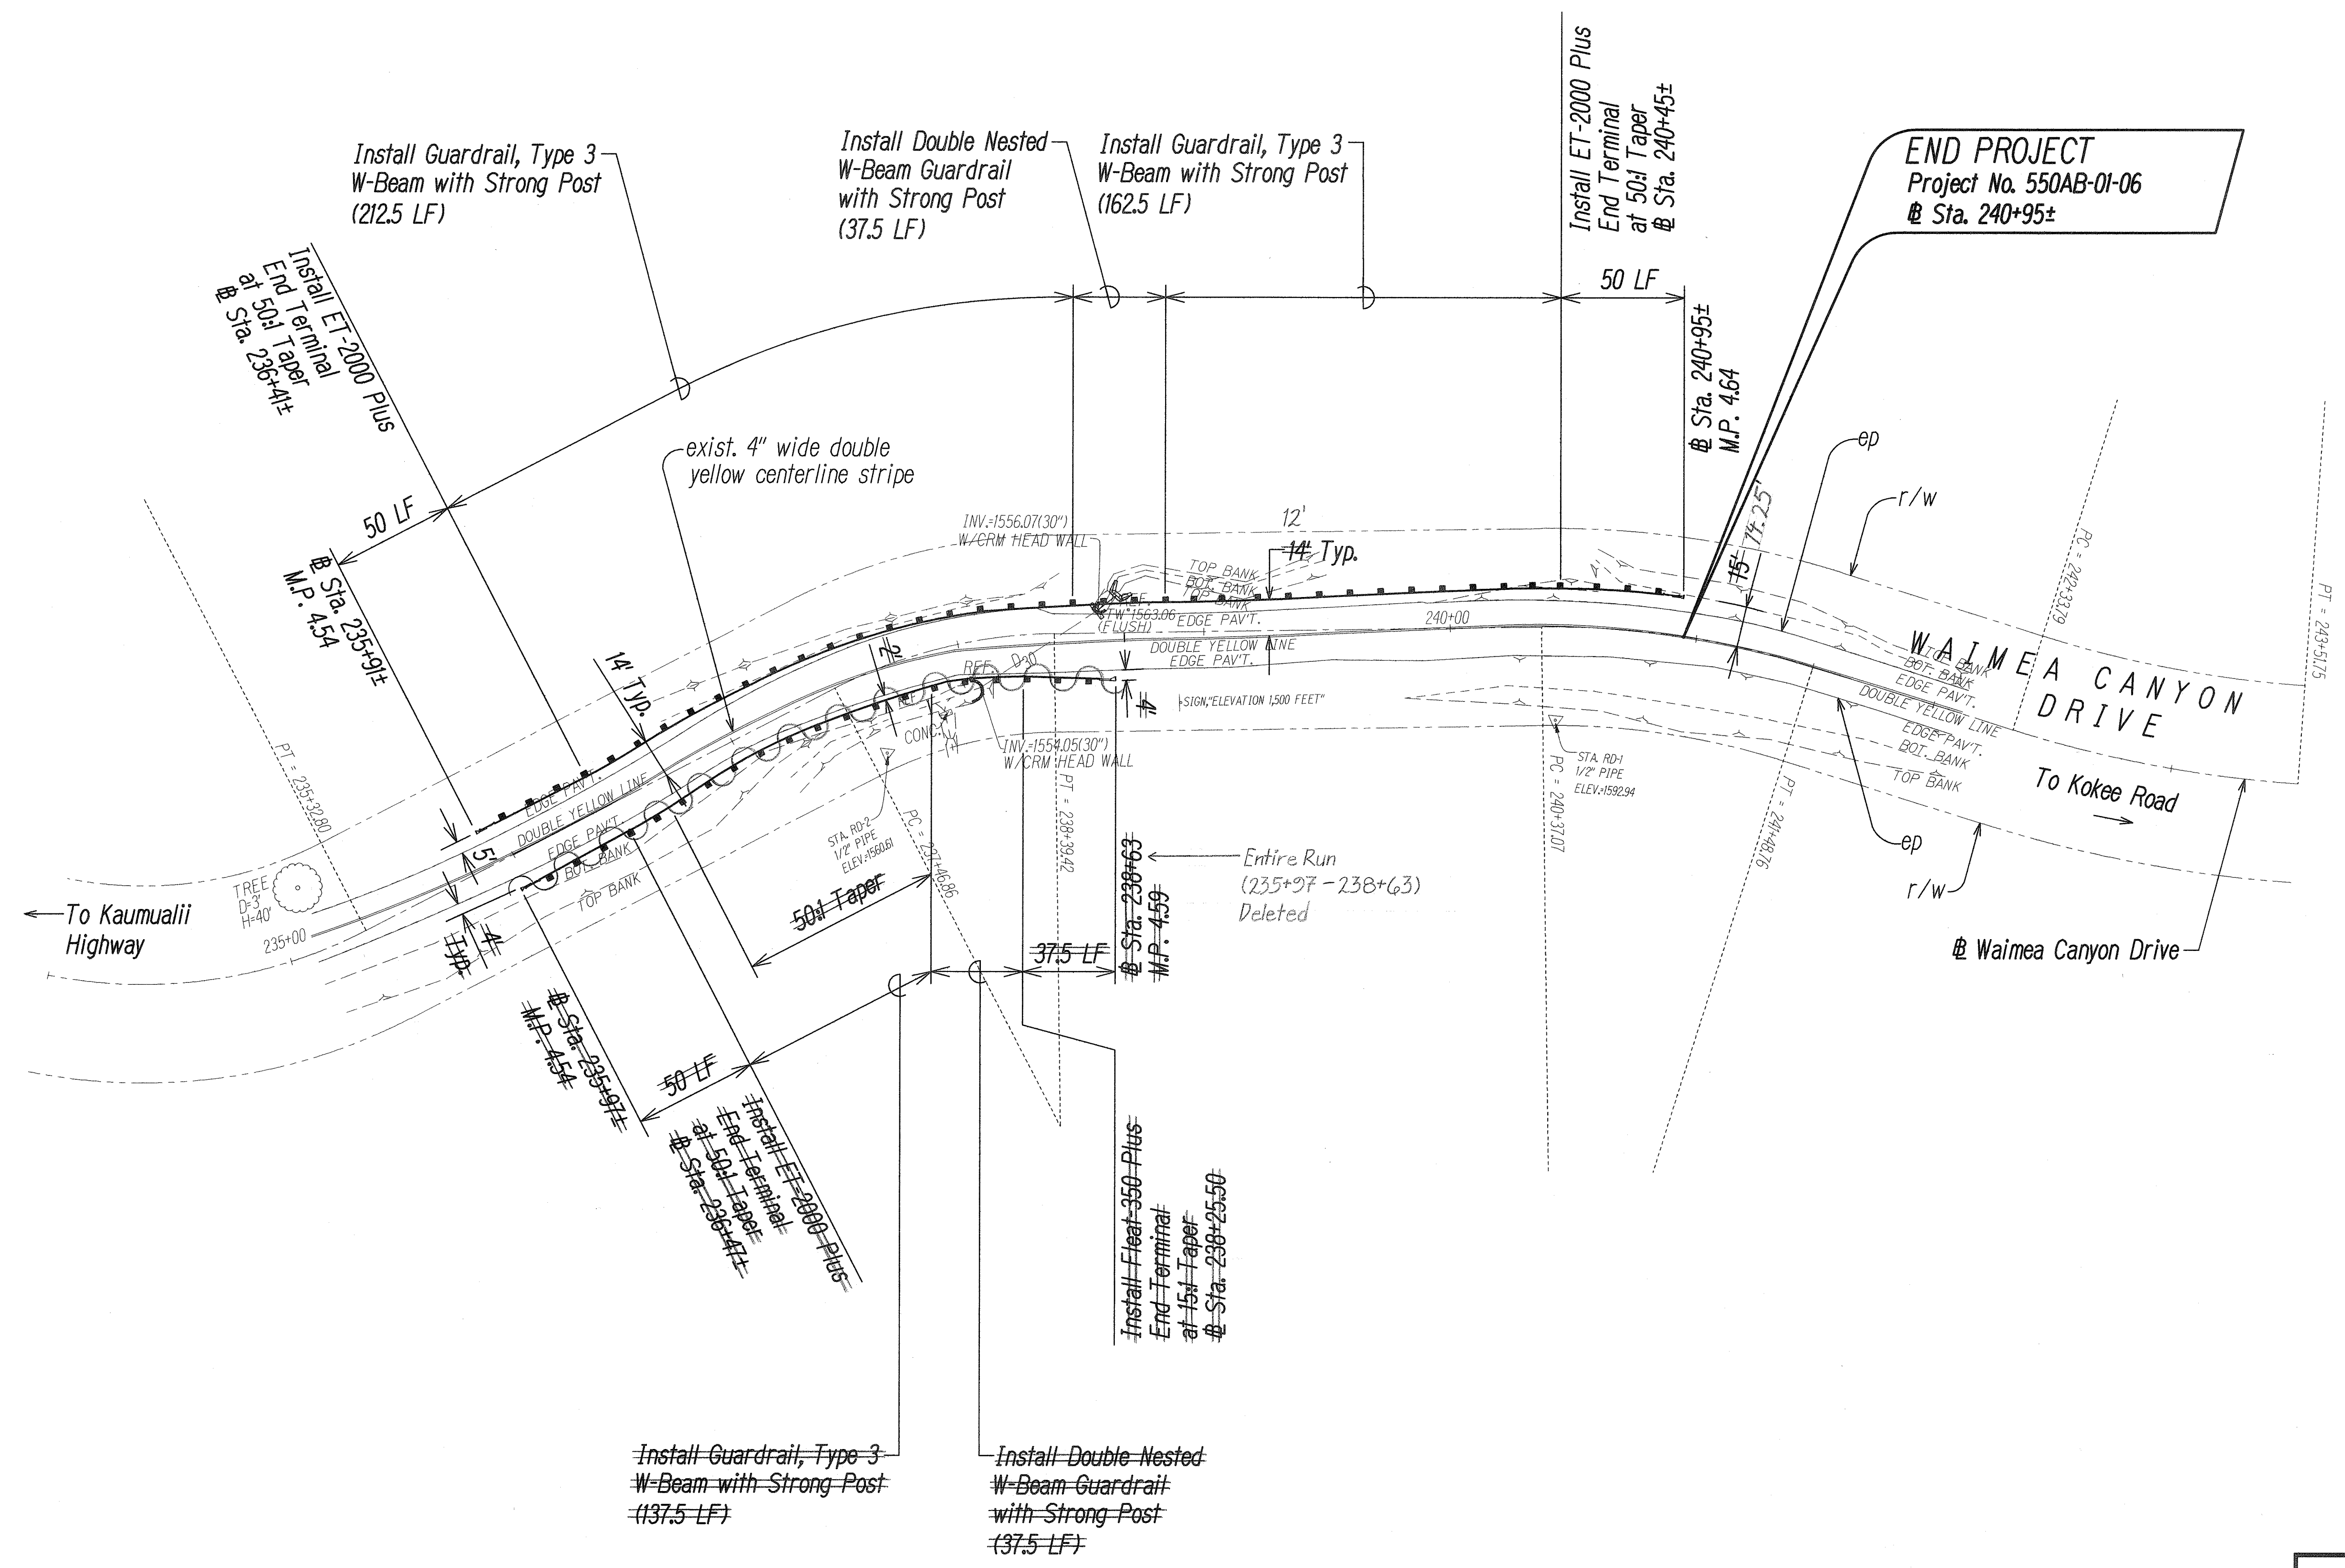

DESIGNED BY	DATE
DRAWN BY	
CHECKED BY	
IN CHARGE	
NOTED BY	
QUANTITIES BY	
CHECKED BY	

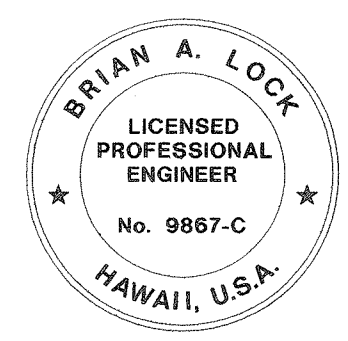

THIS WORK WAS PREPARED BY ME
OR UNDER MY SUPERVISION.

Wilson Okamoto APRIL 30, 2010
WILSON OKAMOTO CORPORATION LIC. EXP. DATE

STATE OF HAWAII
DEPARTMENT OF TRANSPORTATION
HIGHWAYS DIVISION

ROADWAY PLAN

WAIMEA CANYON DRIVE/KOKEE ROAD
IMPROVEMENTS PHASE I
MILE POST 0.80 TO MILE POST 4.60
Proj. No. 550AB-01-06

Scale: 1"=40'-0" Date: October 2008

SHEET No. 10 OF 10 SHEETS

"AS-BUILT"