

INDEX TO DRAWINGS	
SHT. NO.	DESCRIPTION
1	TITLE SHEET
2	STANDARD PLANS SUMMARY
3-4	GENERAL NOTES, LEGENDS & ABBREVIATIONS
5-6	WATER POLLUTION AND EROSION CONTROL NOTES
⑦ 7	TYPICAL ROADWAY SECTIONS & DETAILS
8	GUARDRAIL DETAILS AND NOTES
9	STRONG POST W-BEAM GUARDRAIL
10	PORTABLE CONCRETE BARRIER
11	TERMINAL CONNECTORS & END SECTIONS
12-13	ET-2000 PLUS
14	FLEAT 350
⑫ ⑬ ⑭ ⑮ 15-17	TYPE "A" FLARE DETAILS
18	TYPE "G" TERMINAL END
19-20	MODIFIED TYPE "G" TERMINAL END
21	GUARDRAIL MOUNTING DETAILS
22	GENERAL PLAN
23-32	ROADWAY PLAN
33	TRAFFIC CONTROL NOTES
34	TRAFFIC CONTROL PLANS

Sheet Nos. ⑦ 75-1, ⑫ ⑬ ⑭ ⑮ 175-1 to 175-3 are supplementary sheets to this project. Total sheet count after "As-Built" posting 38 sheets.

DATE OCT 2008
PHONE 241-3000
MANAGED BY HWY-KE
DESIGNED BY WILSON OKAMOTO CORPORATION


STATE OF HAWAII
DEPARTMENT OF TRANSPORTATION
HIGHWAYS DIVISION
HONOLULU, HAWAII
"AS-BUILT"
PLANS FOR

WAIMEA CANYON DRIVE/KOKEE ROAD
IMPROVEMENTS, PHASE 1

MILE POST 0.80 TO MILE POST 4.60

PROJECT NO. 550AB-01-06



DISTRICT OF WAIMEA
ISLAND OF KAUAI

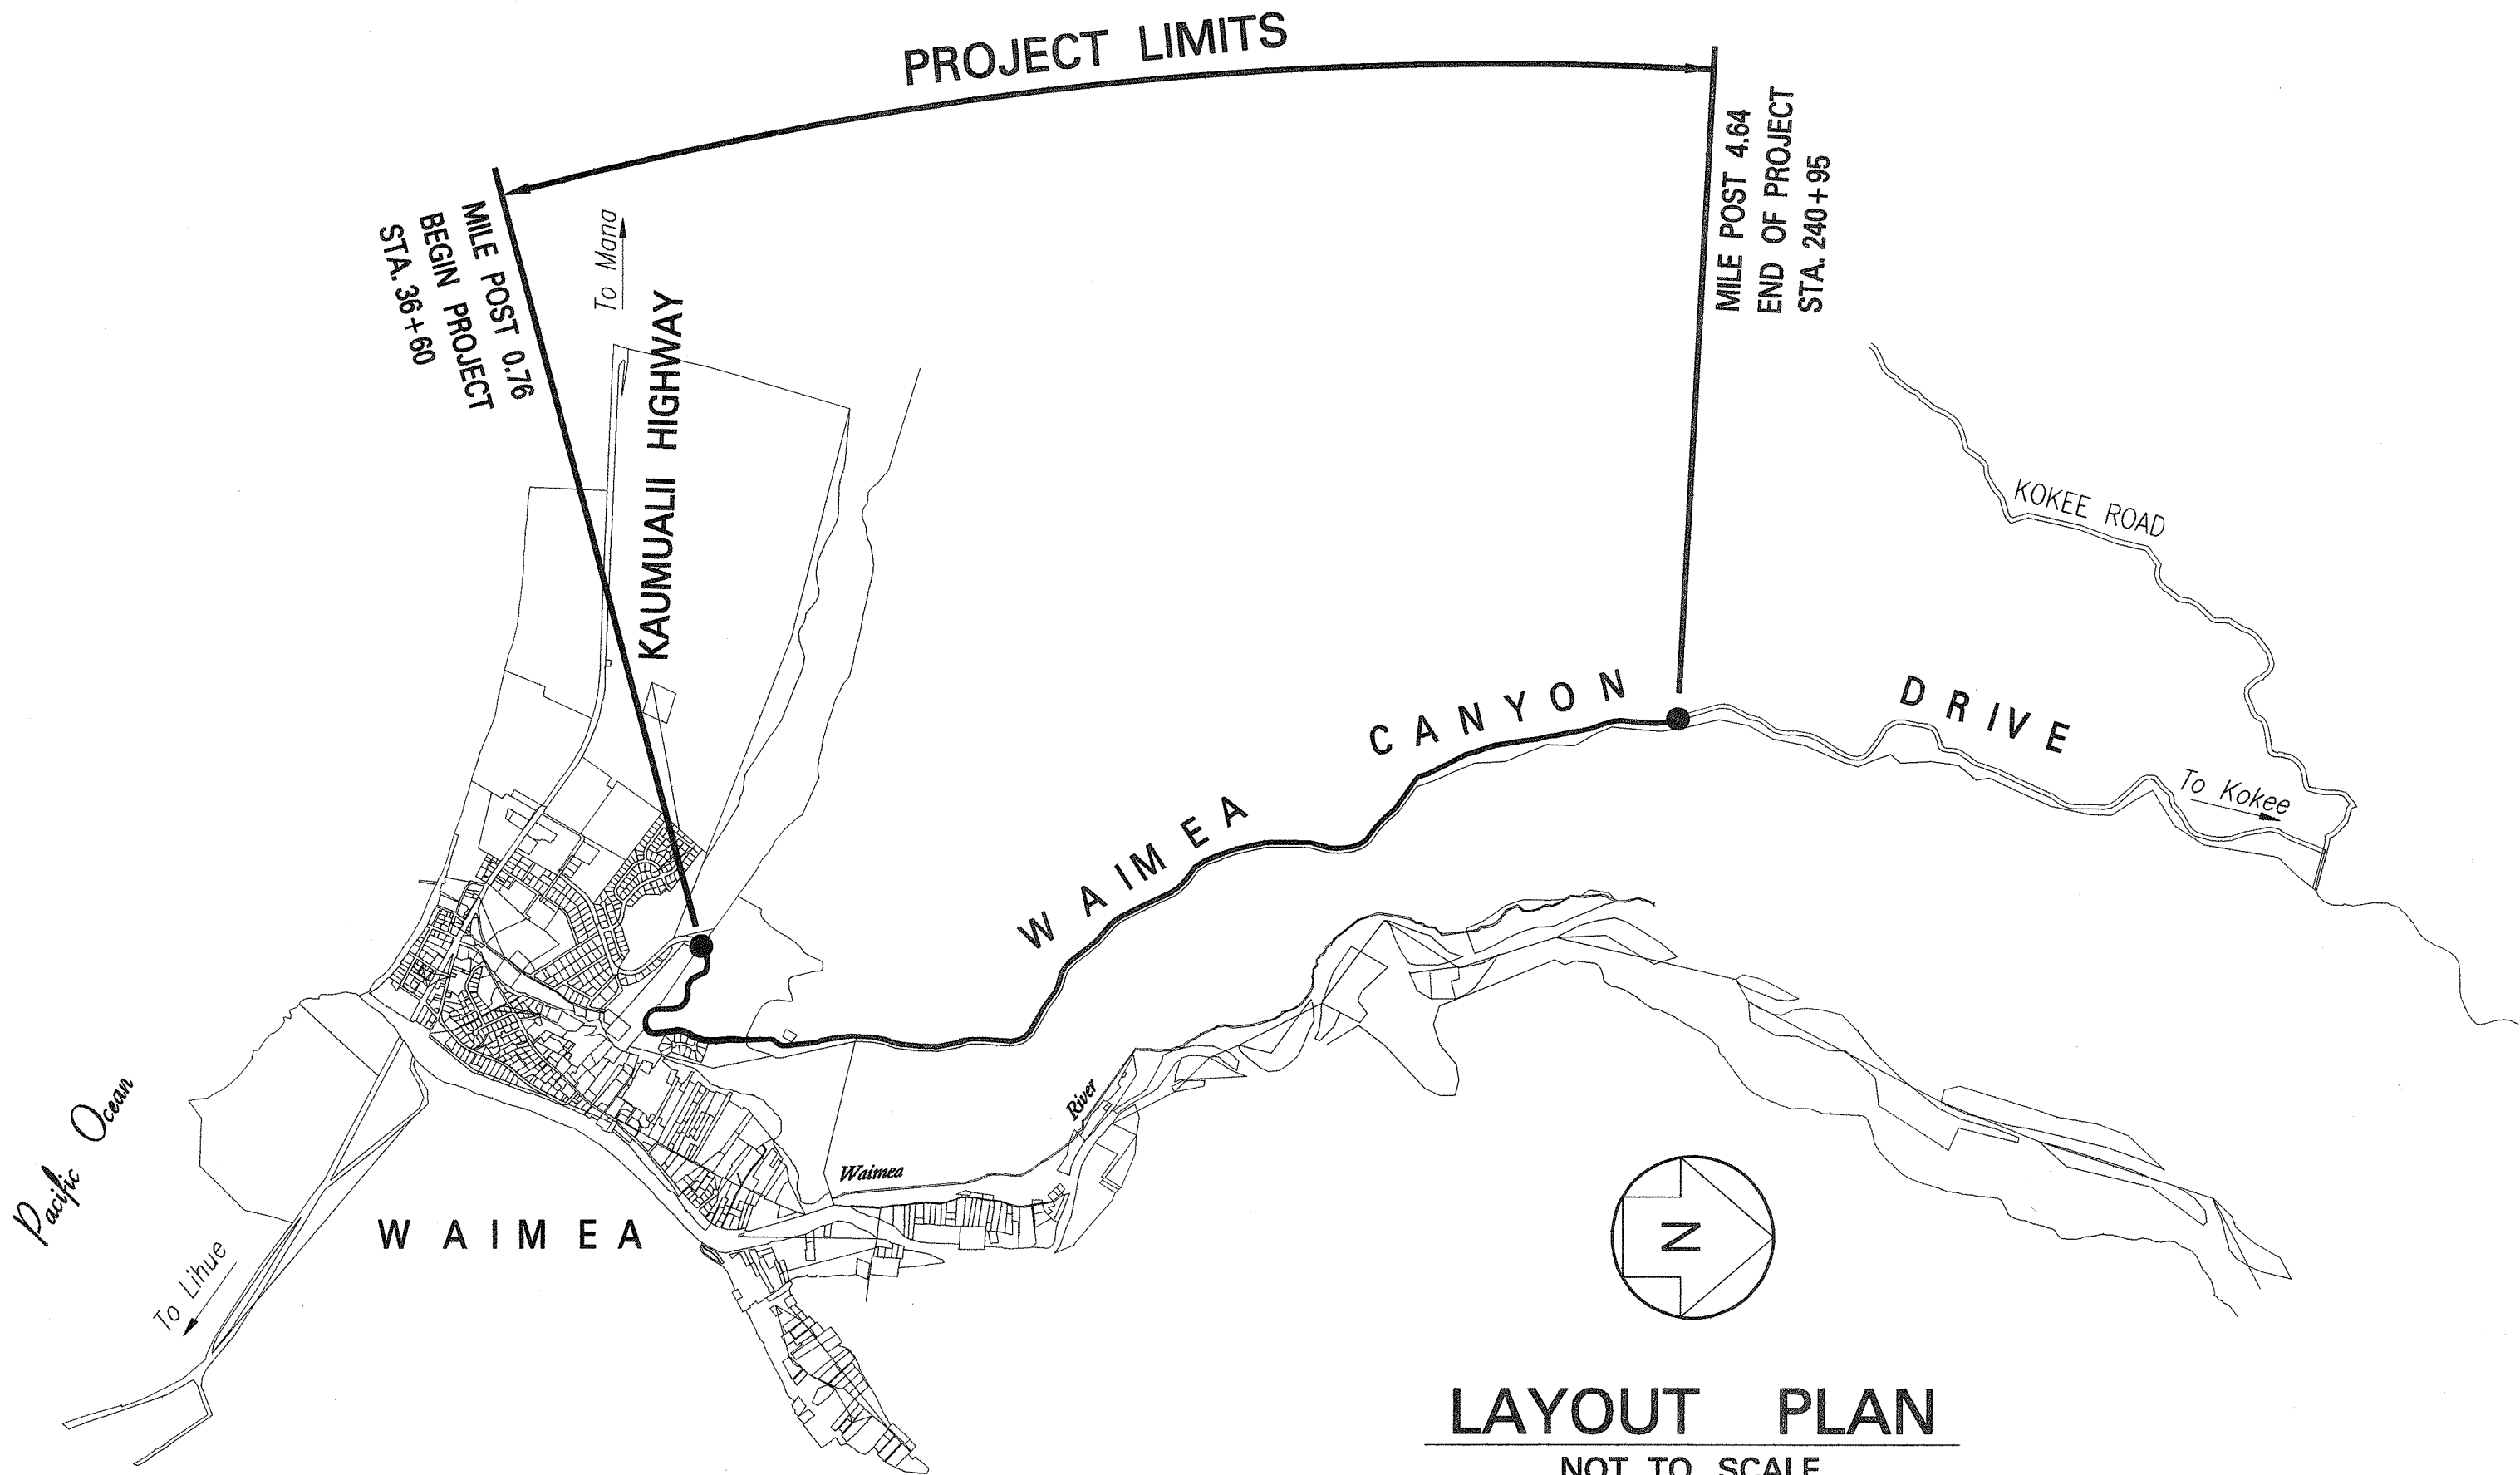

LAYOUT PLAN
NOT TO SCALE

GROSS LENGTH OF PROJECT3.80 MILE
NET LENGTH OF PROJECT2.97 MILE

FED. ROAD DIST. NO.	STATE	PROJ. NO.	FISCAL YEAR	SHEET NO.	TOTAL SHEETS
KAUA 'I	HAW.	550AB-01-06	2009	1	34

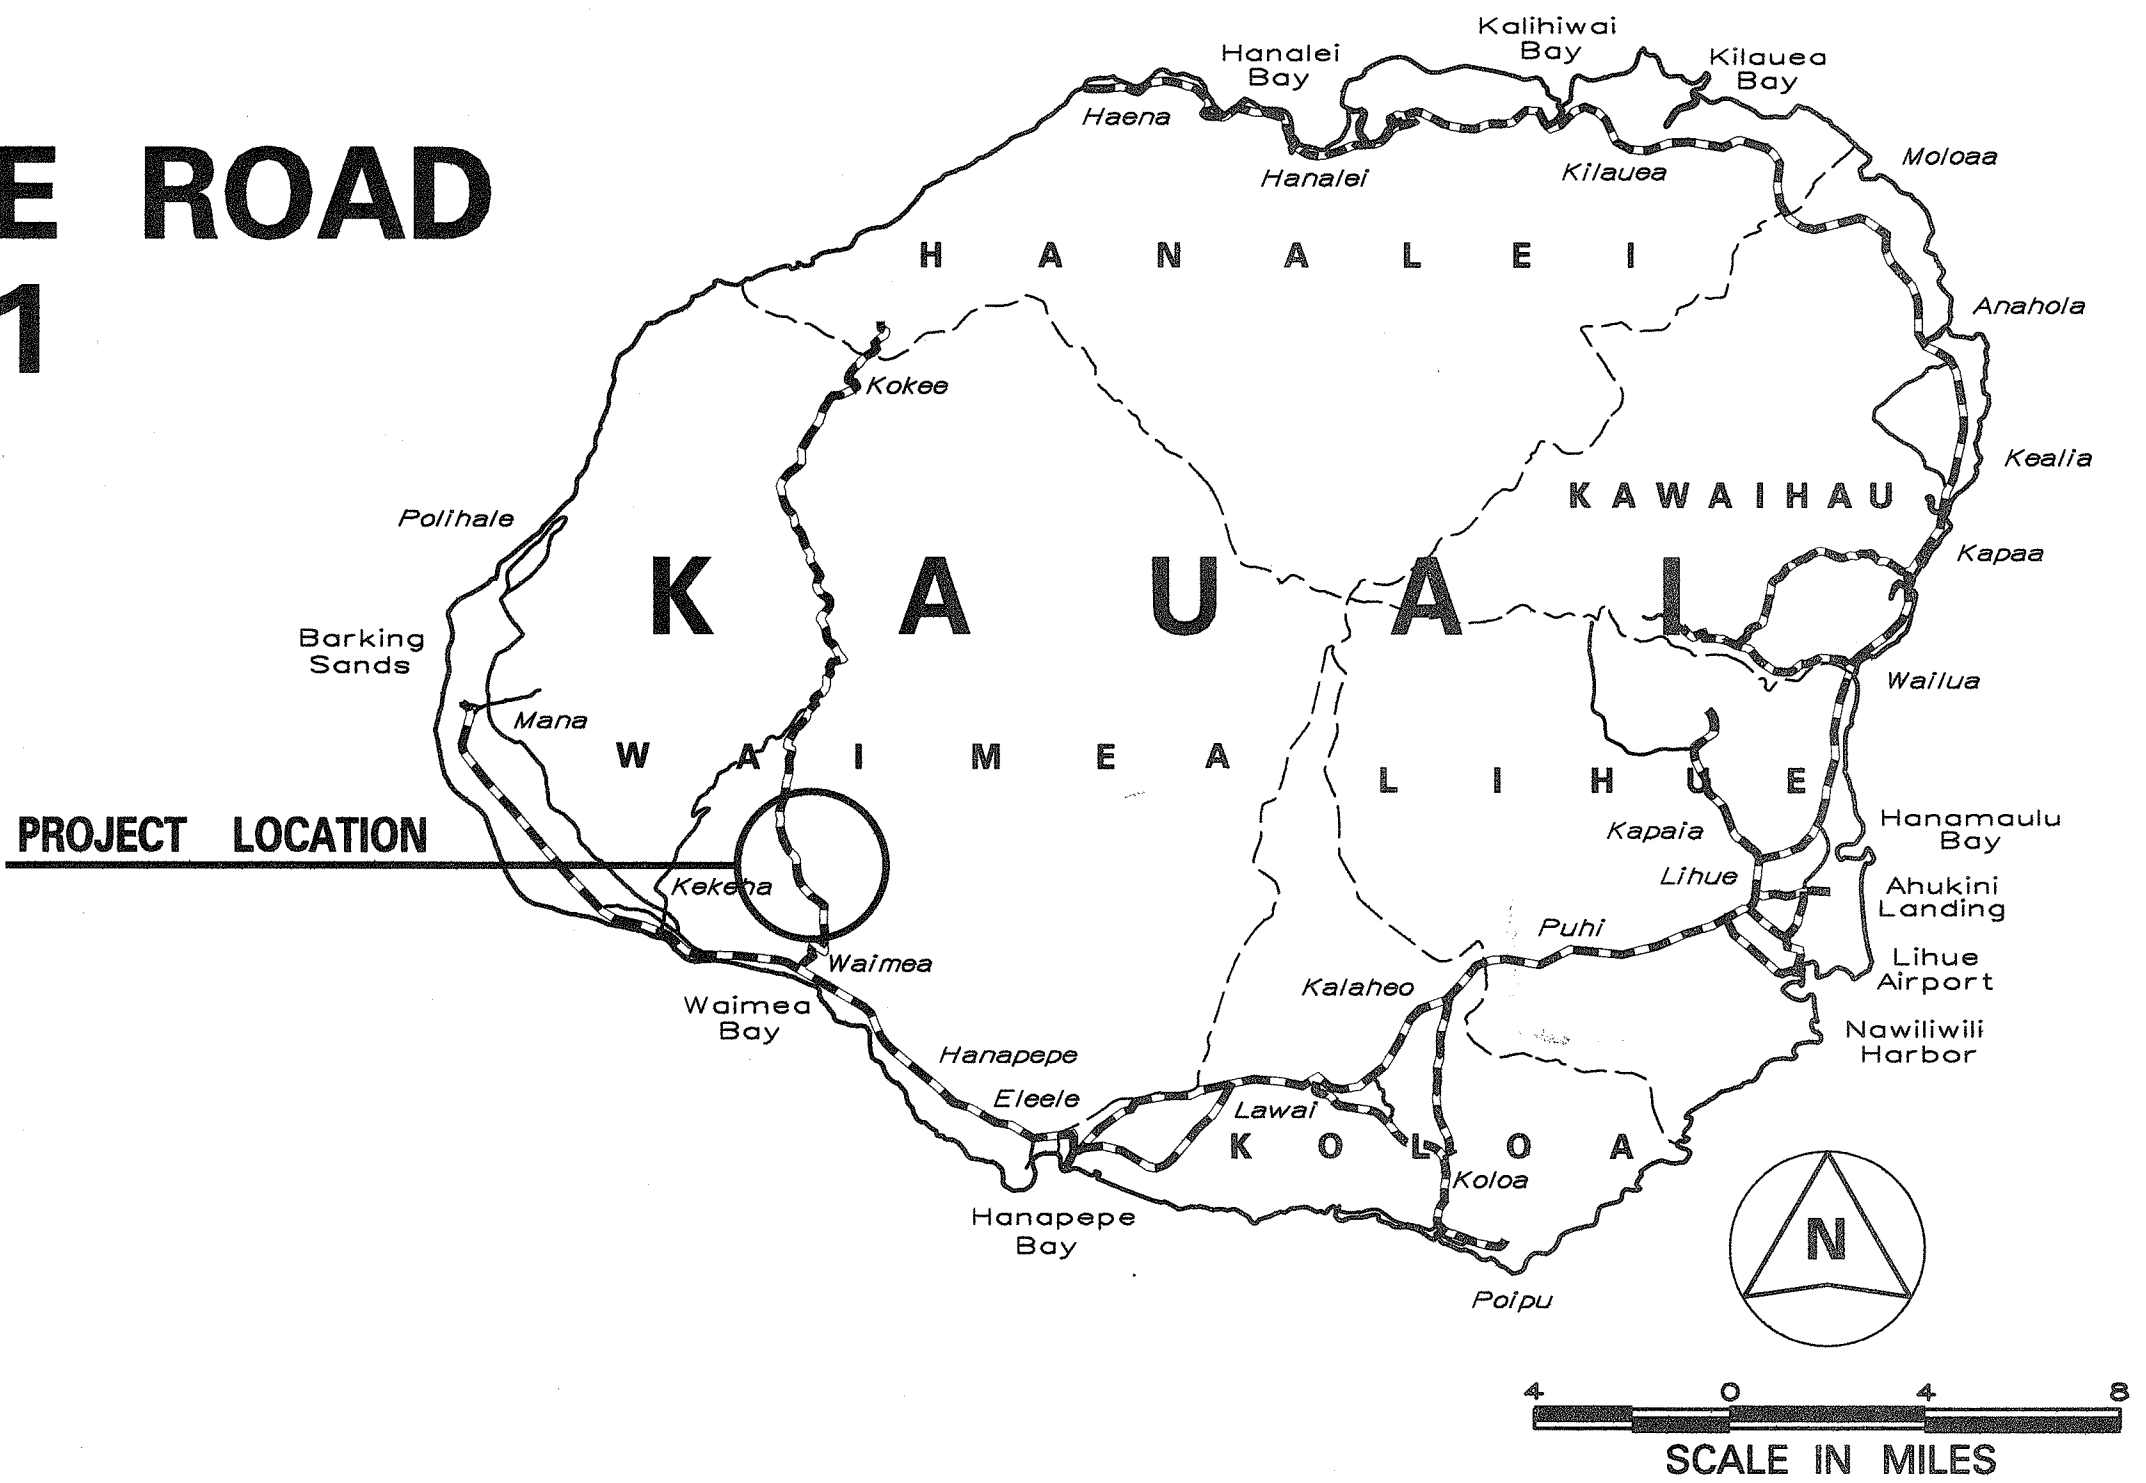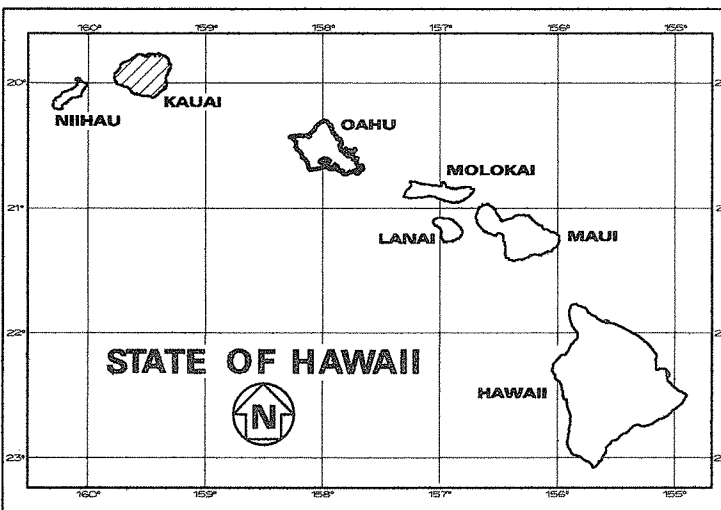

----- FEDERAL AID PROJECTS PREVIOUSLY CONSTRUCTED OR UNDER CONSTRUCTION

MILE POST 0.76 TO MILE POST 1.35
MILE POST 1.51 TO MILE POST 1.76
MILE POST 2.04 TO MILE POST 3.51
MILE POST 3.64 TO MILE POST 4.15
MILE POST 4.32 TO MILE POST 4.37
MILE POST 4.54 TO MILE POST 4.64

CHANGES MADE DURING CONSTRUCTION HAVE BEEN INCORPORATED ON THESE PLANS EXCEPT CHANGES IN THE ORIGINAL THEORETICAL QUANTITIES. FOR ACTUAL QUANTITIES, REFER TO PROJECT LEDGER AND/OR COMPUTATION BOOK.
RESIDENT ENGINEER 9/12/11 DATE

DEPARTMENT OF TRANSPORTATION
STATE OF HAWAII
APPROVED: 10-10-08
DIR. OF TRANSPORTATION DATE